




HEALTH & SAFETY FILE

BMS EQUIPMENT UPGRADE


EXCHEQUER COURT
33 ST MARY AXE
LONDON
EC3A 8AA

FILE 2 OF 2

0 1 2 3 4 5 6 7 8 9

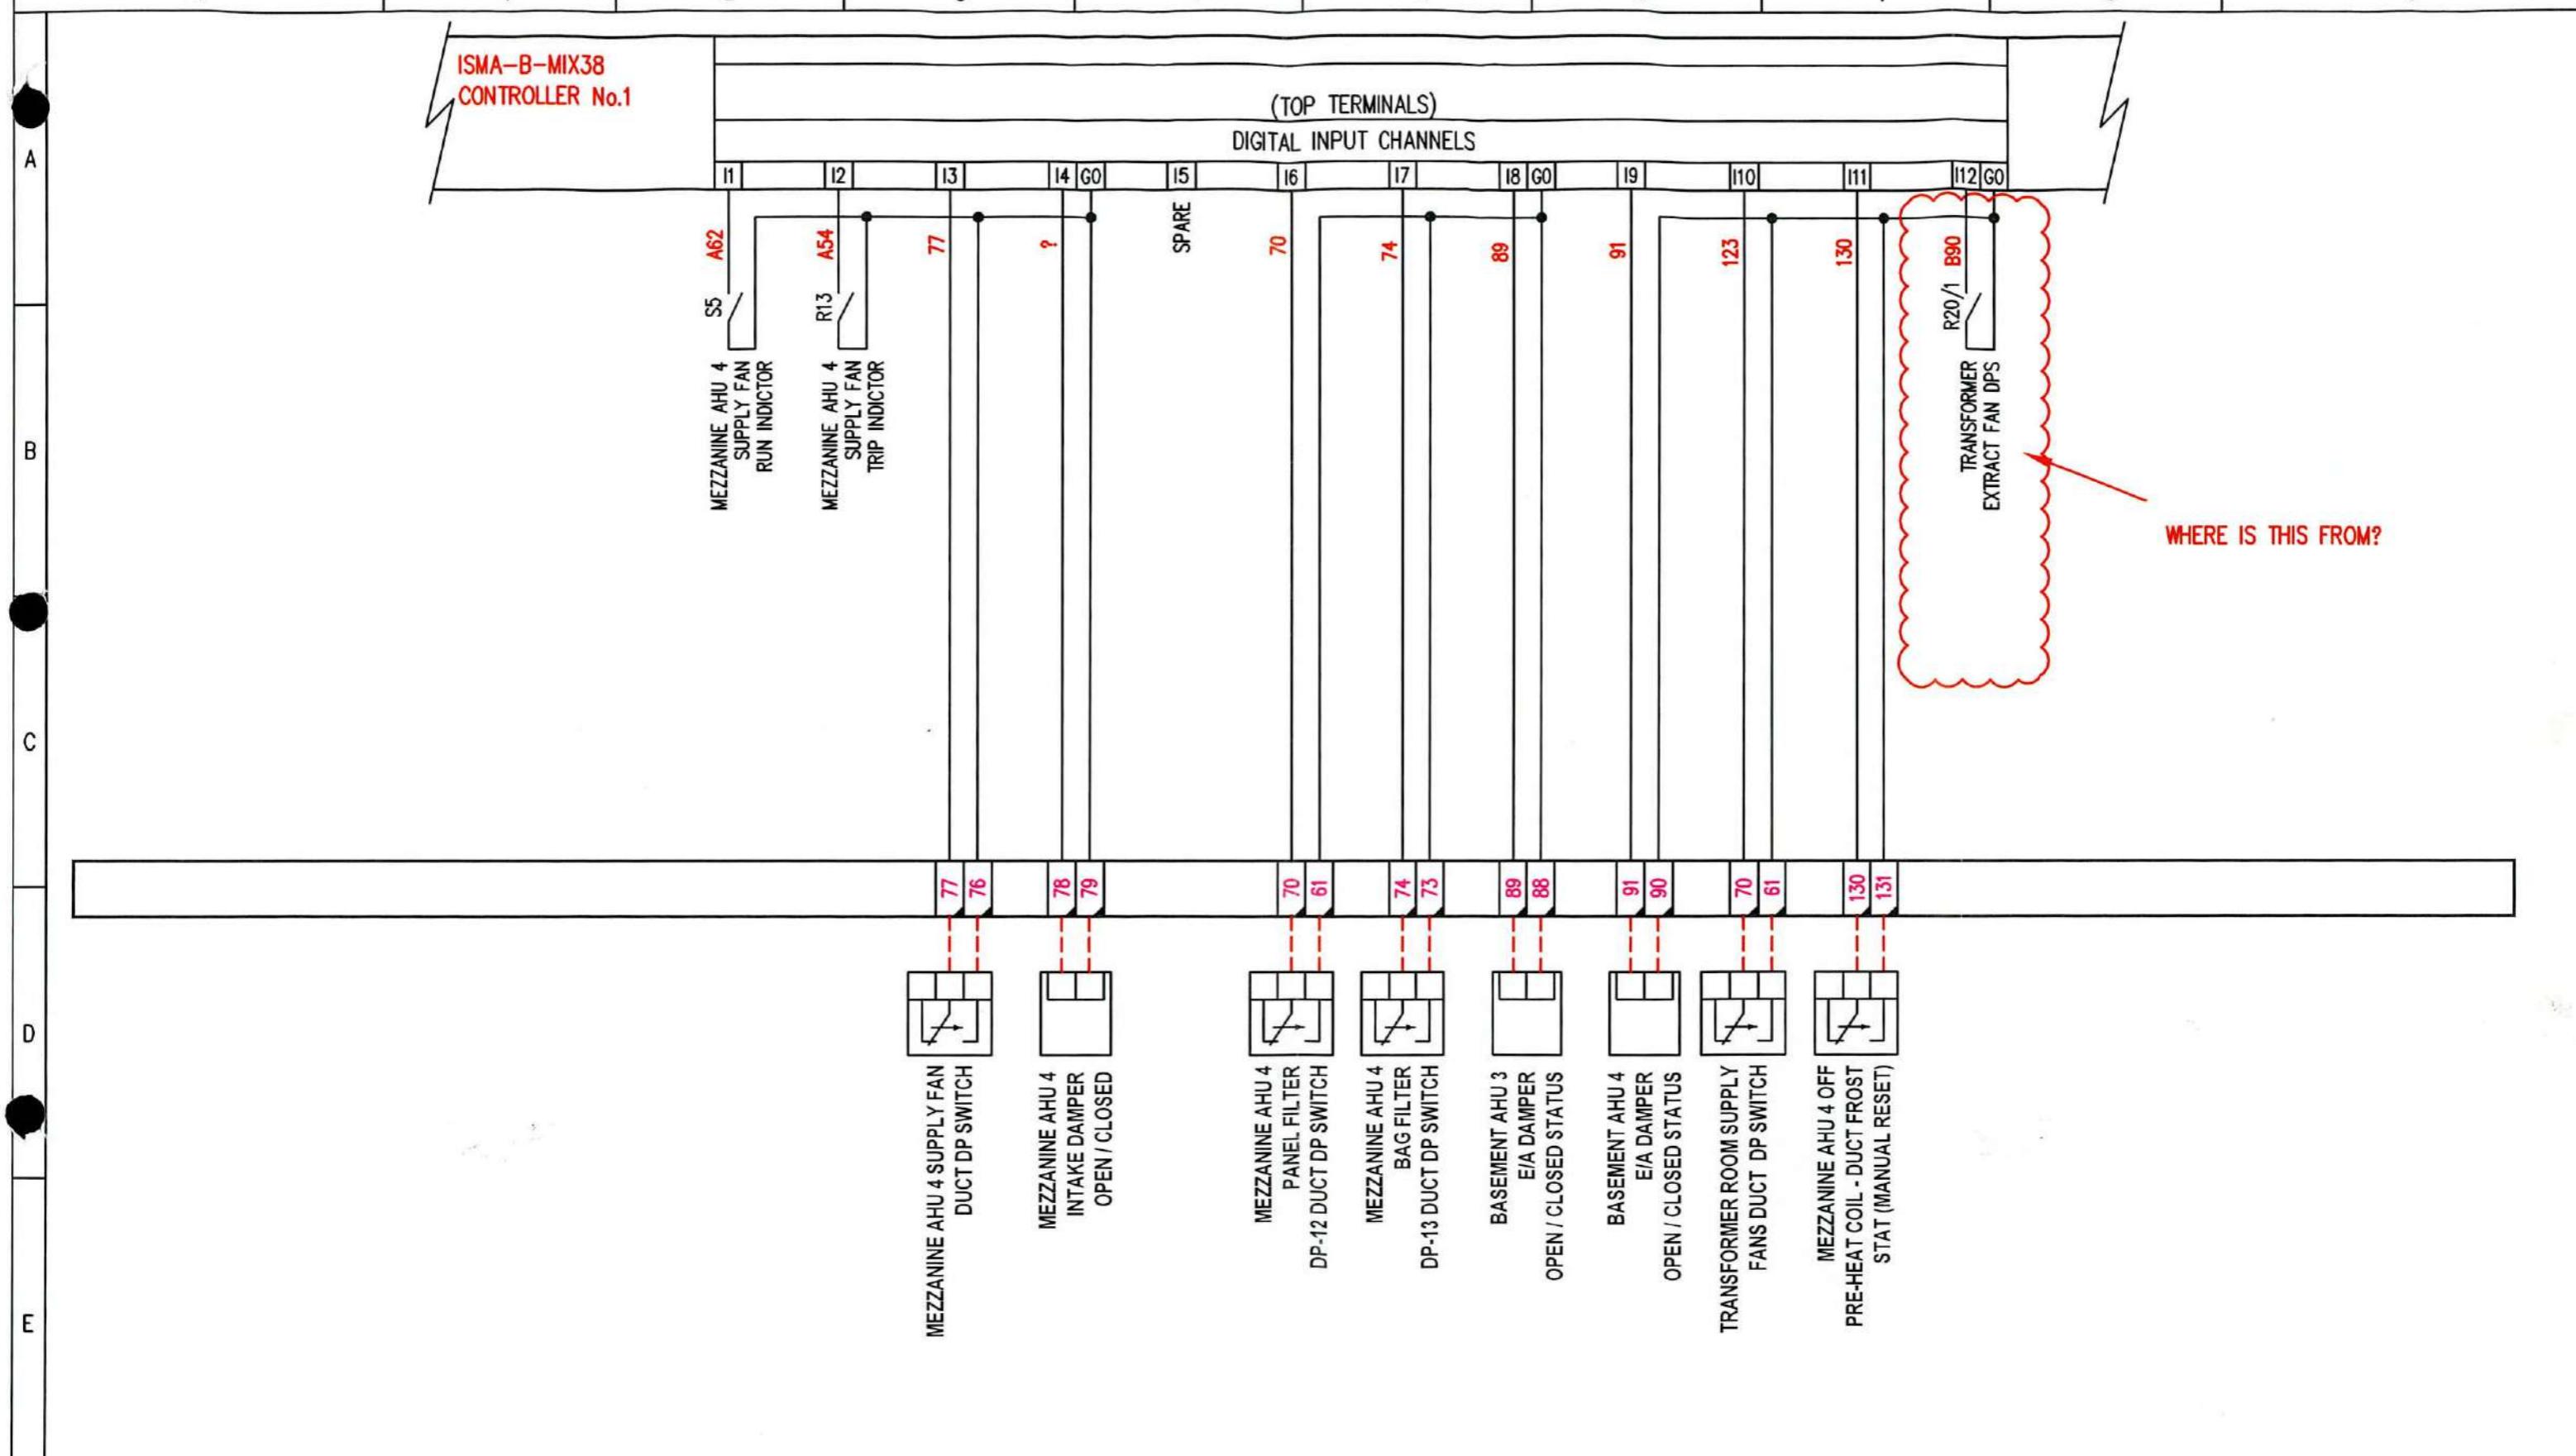


● PROVISIONAL ● FOR APPROVAL ○ ISSUED FOR CONSTRUCTION	○ AS BUILT ○ AS FITTED	REVISION No	DESCRIPTION OF REVISION	DRAWN BY DATE	CHECKED BY DATE	REVISION No	DESCRIPTION OF REVISION	STATUS	DRAWN BY DATE	CHECKED BY DATE	DRG No.6082-11 PROJECT No.6083	SHT. 10 of 19	REV 1 ©
		0	PROVISIONAL	RFD 08/04/21		4					TITLE	EXCHEQUER COURT	
		1	ISSUED FOR APPROVAL AFTER COMMENTS	RFD 09/05/21		5					PANEL TITLE	BASEMENT EXTRACT NO.1 FAN CONTROL PANEL AP3	
		2				6					CLIENT		
		3				7							

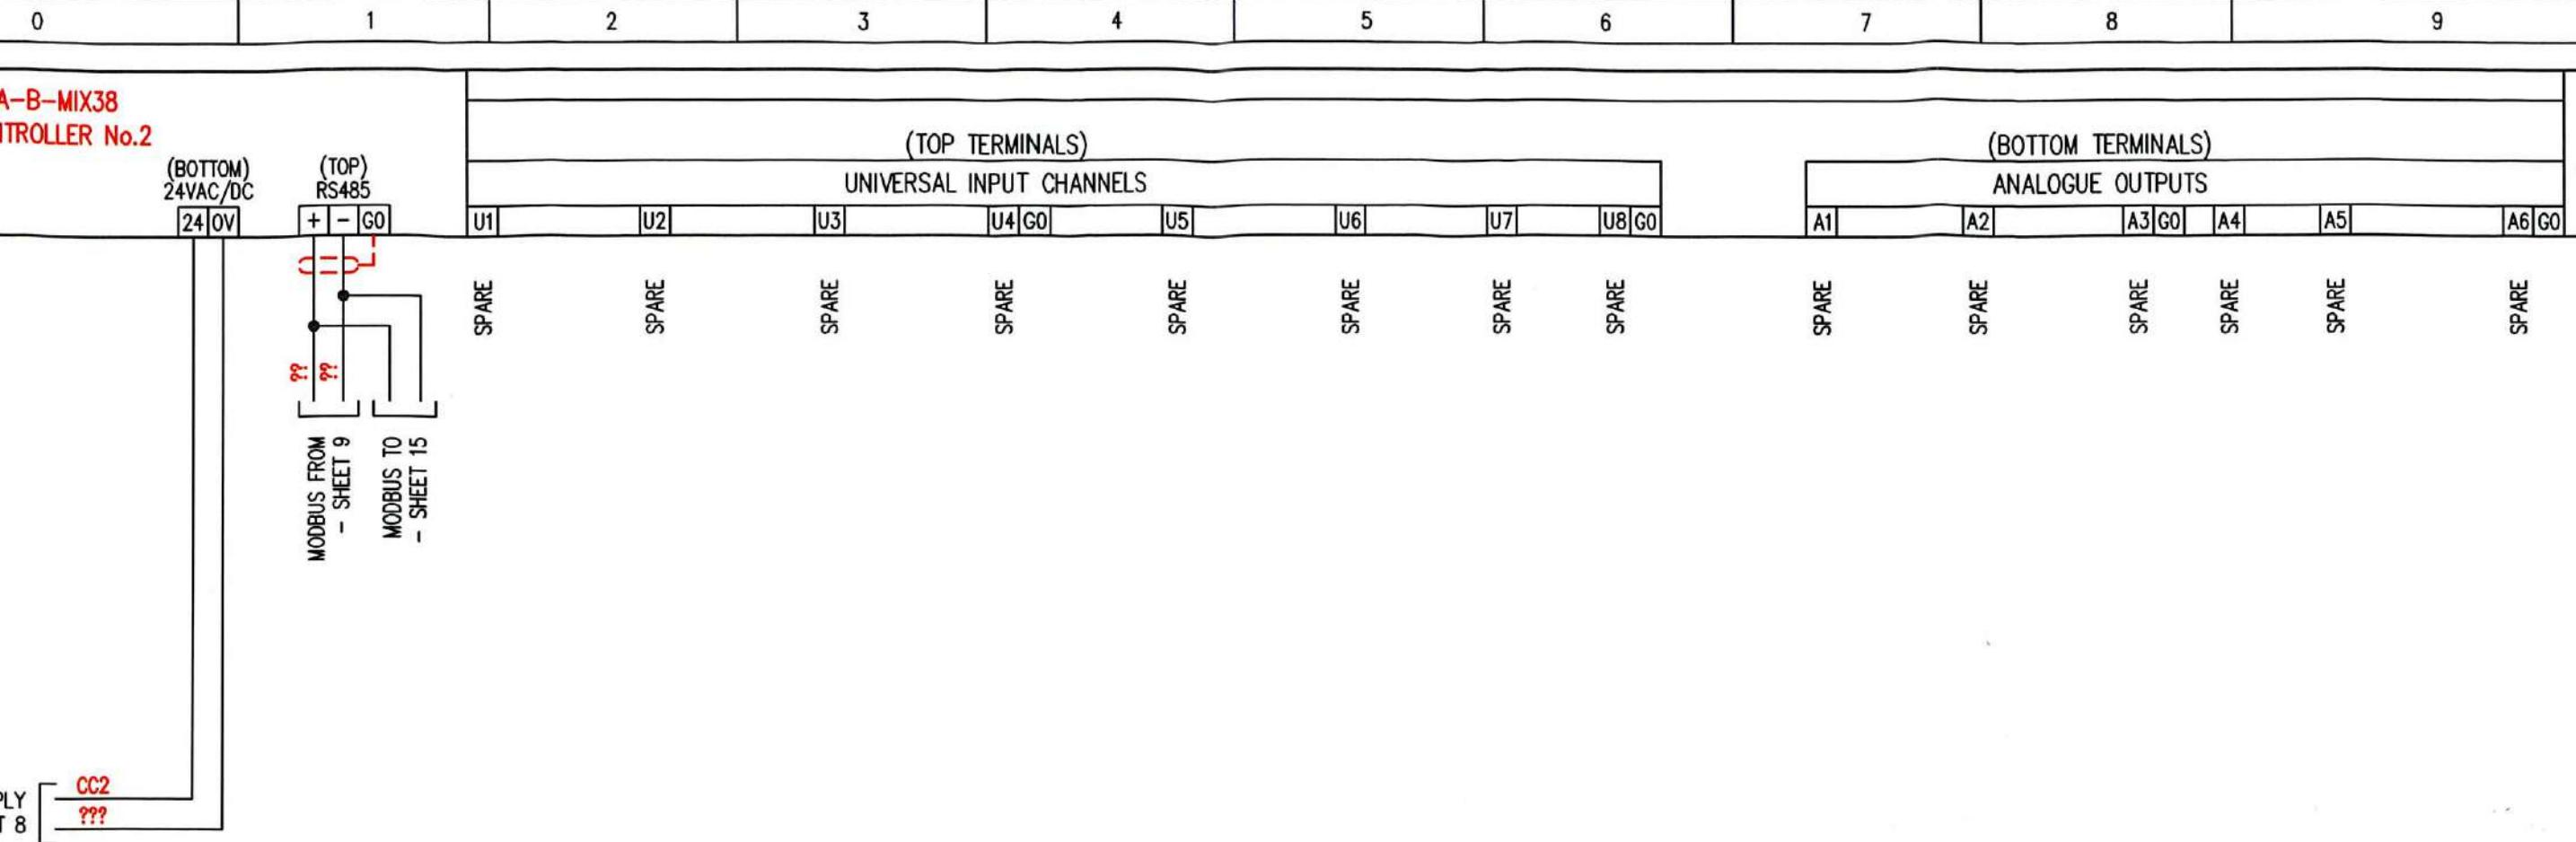

<input checked="" type="radio"/> PROVISIONAL <input checked="" type="radio"/> FOR APPROVAL <input type="radio"/> ISSUED FOR CONSTRUCTION	<input type="radio"/> AS BUILT <input type="radio"/> AS FITTED	REVISION No	DESCRIPTION OF REVISION	DRAWN BY DATE	CHECKED BY DATE	REVISION No	DESCRIPTION OF REVISION	STATUS	DRAWN BY DATE	CHECKED BY DATE	DRG No.6082-11 PROJECT No.6083	SHT. 12 of 19	REV 1 ©
		0	PROVISIONAL	RFD 08/04/21		4					TITLE	EXCHEQUER COURT	
		1	ISSUED FOR APPROVAL AFTER COMMENTS	RFD 09/05/21		5					PANEL TITLE	BASEMENT EXTRACT NO.1 FAN CONTROL PANEL AP3	
		2				6					CLIENT		
		3				7							

0 1 2 3 4 5 6 7 8 9

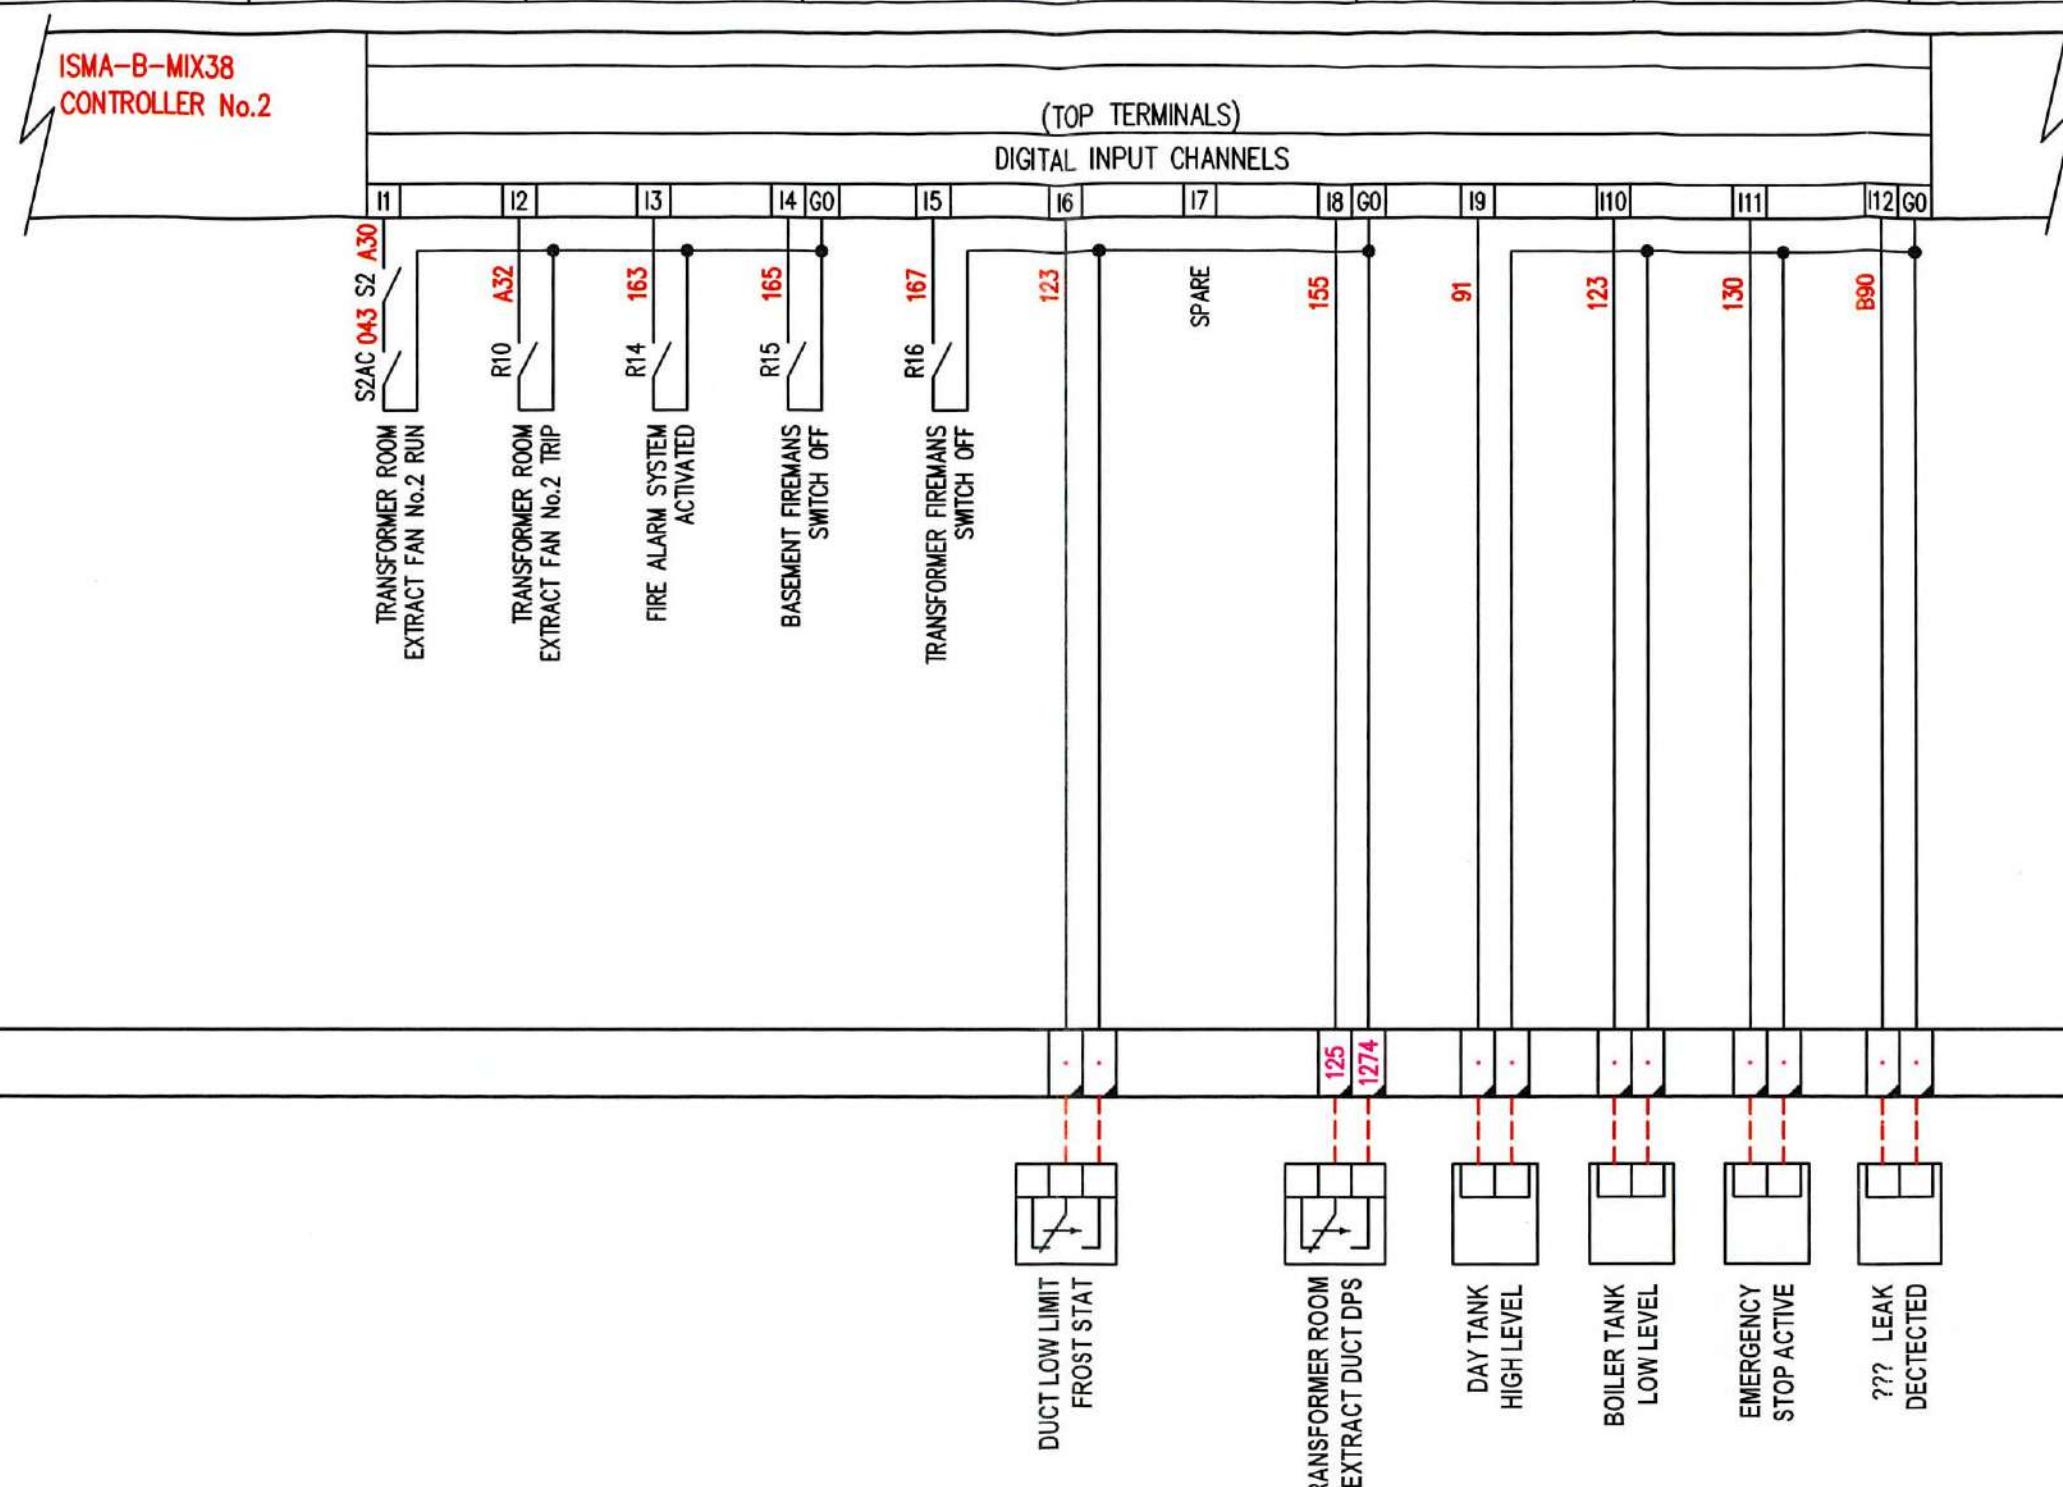

A

B

C


D

E

● PROVISIONAL ○ AS BUILT
 ● FOR APPROVAL ○ AS FITTED
 ○ ISSUED FOR CONSTRUCTION


REVISION No	DESCRIPTION OF REVISION	DRAWN BY DATE	CHECKED BY DATE	REVISION No	DESCRIPTION OF REVISION	STATUS	DRAWN BY DATE	CHECKED BY DATE	DRG No.6082-11 SHT. 13 of 19 PROJECT No.6083	REV 1 ©
0	PROVISIONAL	RFD 08/04/21		4					TITLE	EXCHEQUER COURT
1	ISSUED FOR APPROVAL AFTER COMMENTS	RFD 09/05/21		5					PANEL TITLE	BASEMENT EXTRACT NO.1 FAN CONTROL PANEL AP3
2				6					CLIENT	
3				7						

0 1 2 3 4 5 6 7 8 9

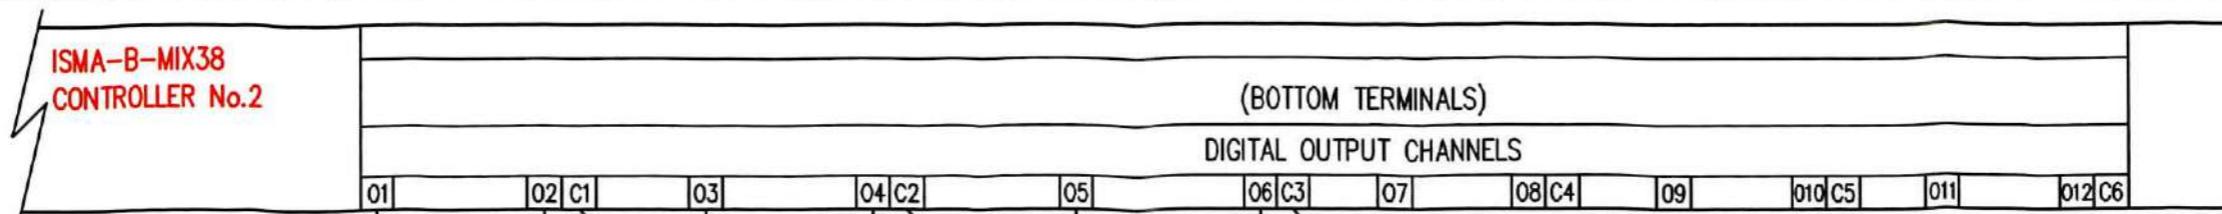


01 02 03 04 05 06 07 08 09 010 011 012

SPARE SPARE SPARE SPARE SPARE SPARE

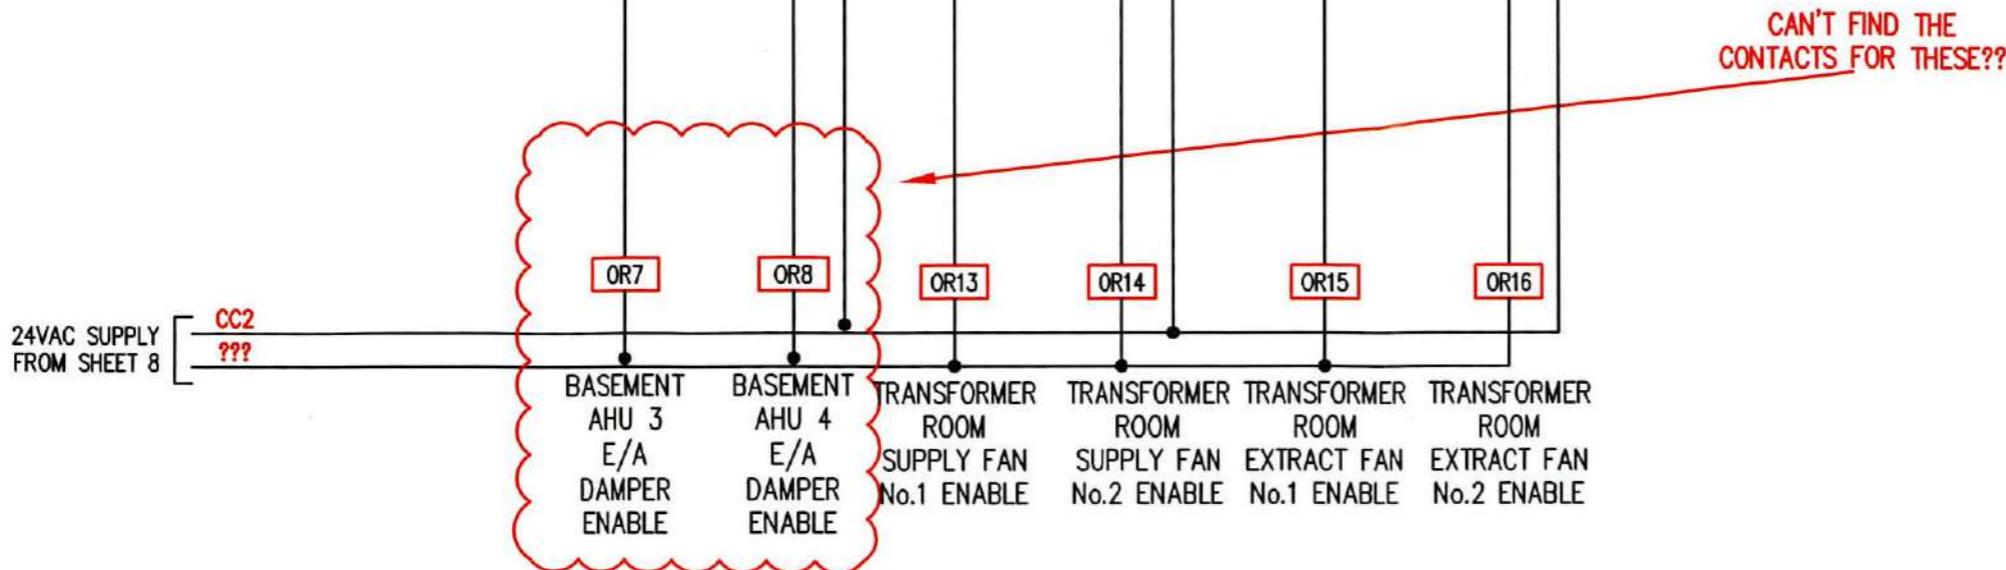

PROVISIONAL FOR APPROVAL ISSUED FOR CONSTRUCTION	AS BUILT AS FITTED	REVISION No	DESCRIPTION OF REVISION	DRAWN BY DATE	CHECKED BY DATE	REVISION No	DESCRIPTION OF REVISION	STATUS	DRAWN BY DATE	CHECKED BY DATE	DRG No.6082-11 PROJECT No.6083	SHT. 14 of 19	REV 1 ©
		0	PROVISIONAL	RFD 08/04/21		4					TITLE	EXCHEQUER COURT	
		1	ISSUED FOR APPROVAL AFTER COMMENTS	RFD 09/05/21		5					PANEL TITLE	BASEMENT EXTRACT NO.1 FAN CONTROL PANEL AP3	
		2				6					CLIENT		
		3				7							


0 1 2 3 4 5 6 7 8 9

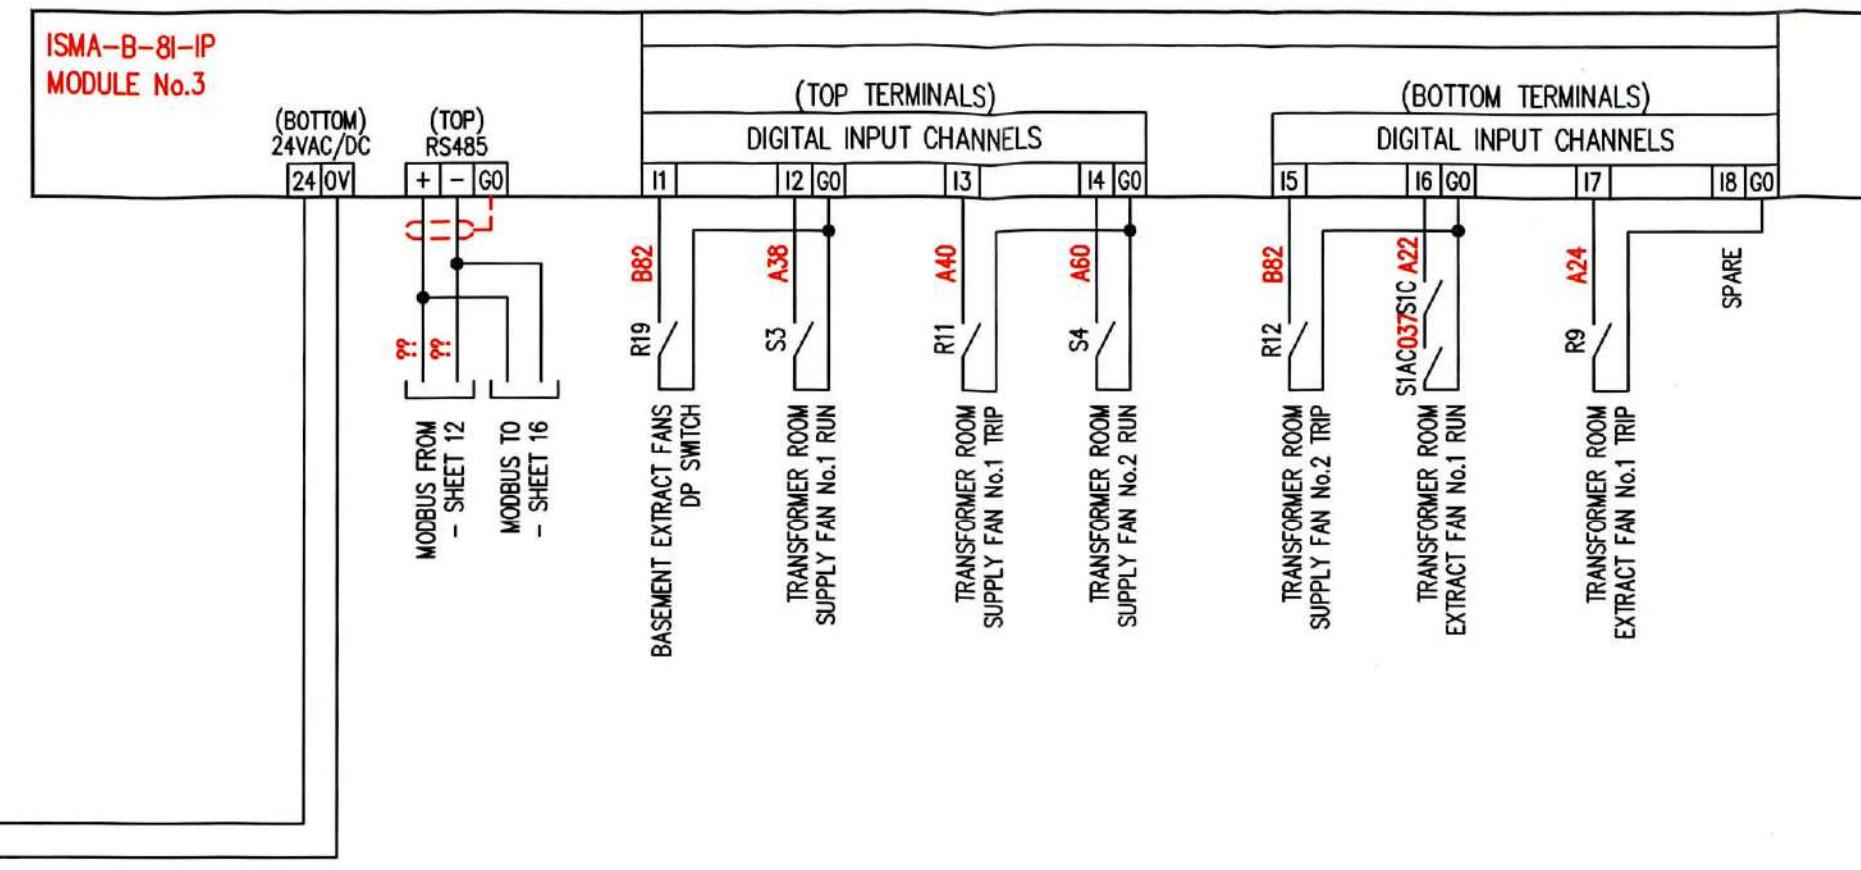

● PROVISIONAL ○ AS BUILT
 ● FOR APPROVAL ○ AS FITTED
 ○ ISSUED FOR CONSTRUCTION

REVISION No	DESCRIPTION OF REVISION	DRAWN BY DATE	CHECKED BY DATE	REVISION No	DESCRIPTION OF REVISION	STATUS	DRAWN BY DATE	CHECKED BY DATE	DRG No.6082-11 PROJECT No.6083	SHT. 15 of 19	REV 1 ©
0	PROVISIONAL	RFD 08/04/21		4							
1	ISSUED FOR APPROVAL AFTER COMMENTS	RFD 09/05/21		5							
2				6							
3				7							
									TITLE	EXCHEQUER COURT	
									PANEL TITLE	BASEMENT EXTRACT NO.1 FAN CONTROL PANEL AP3	
									CLIENT		

0 1 2 3 4 5 6 7 8 9

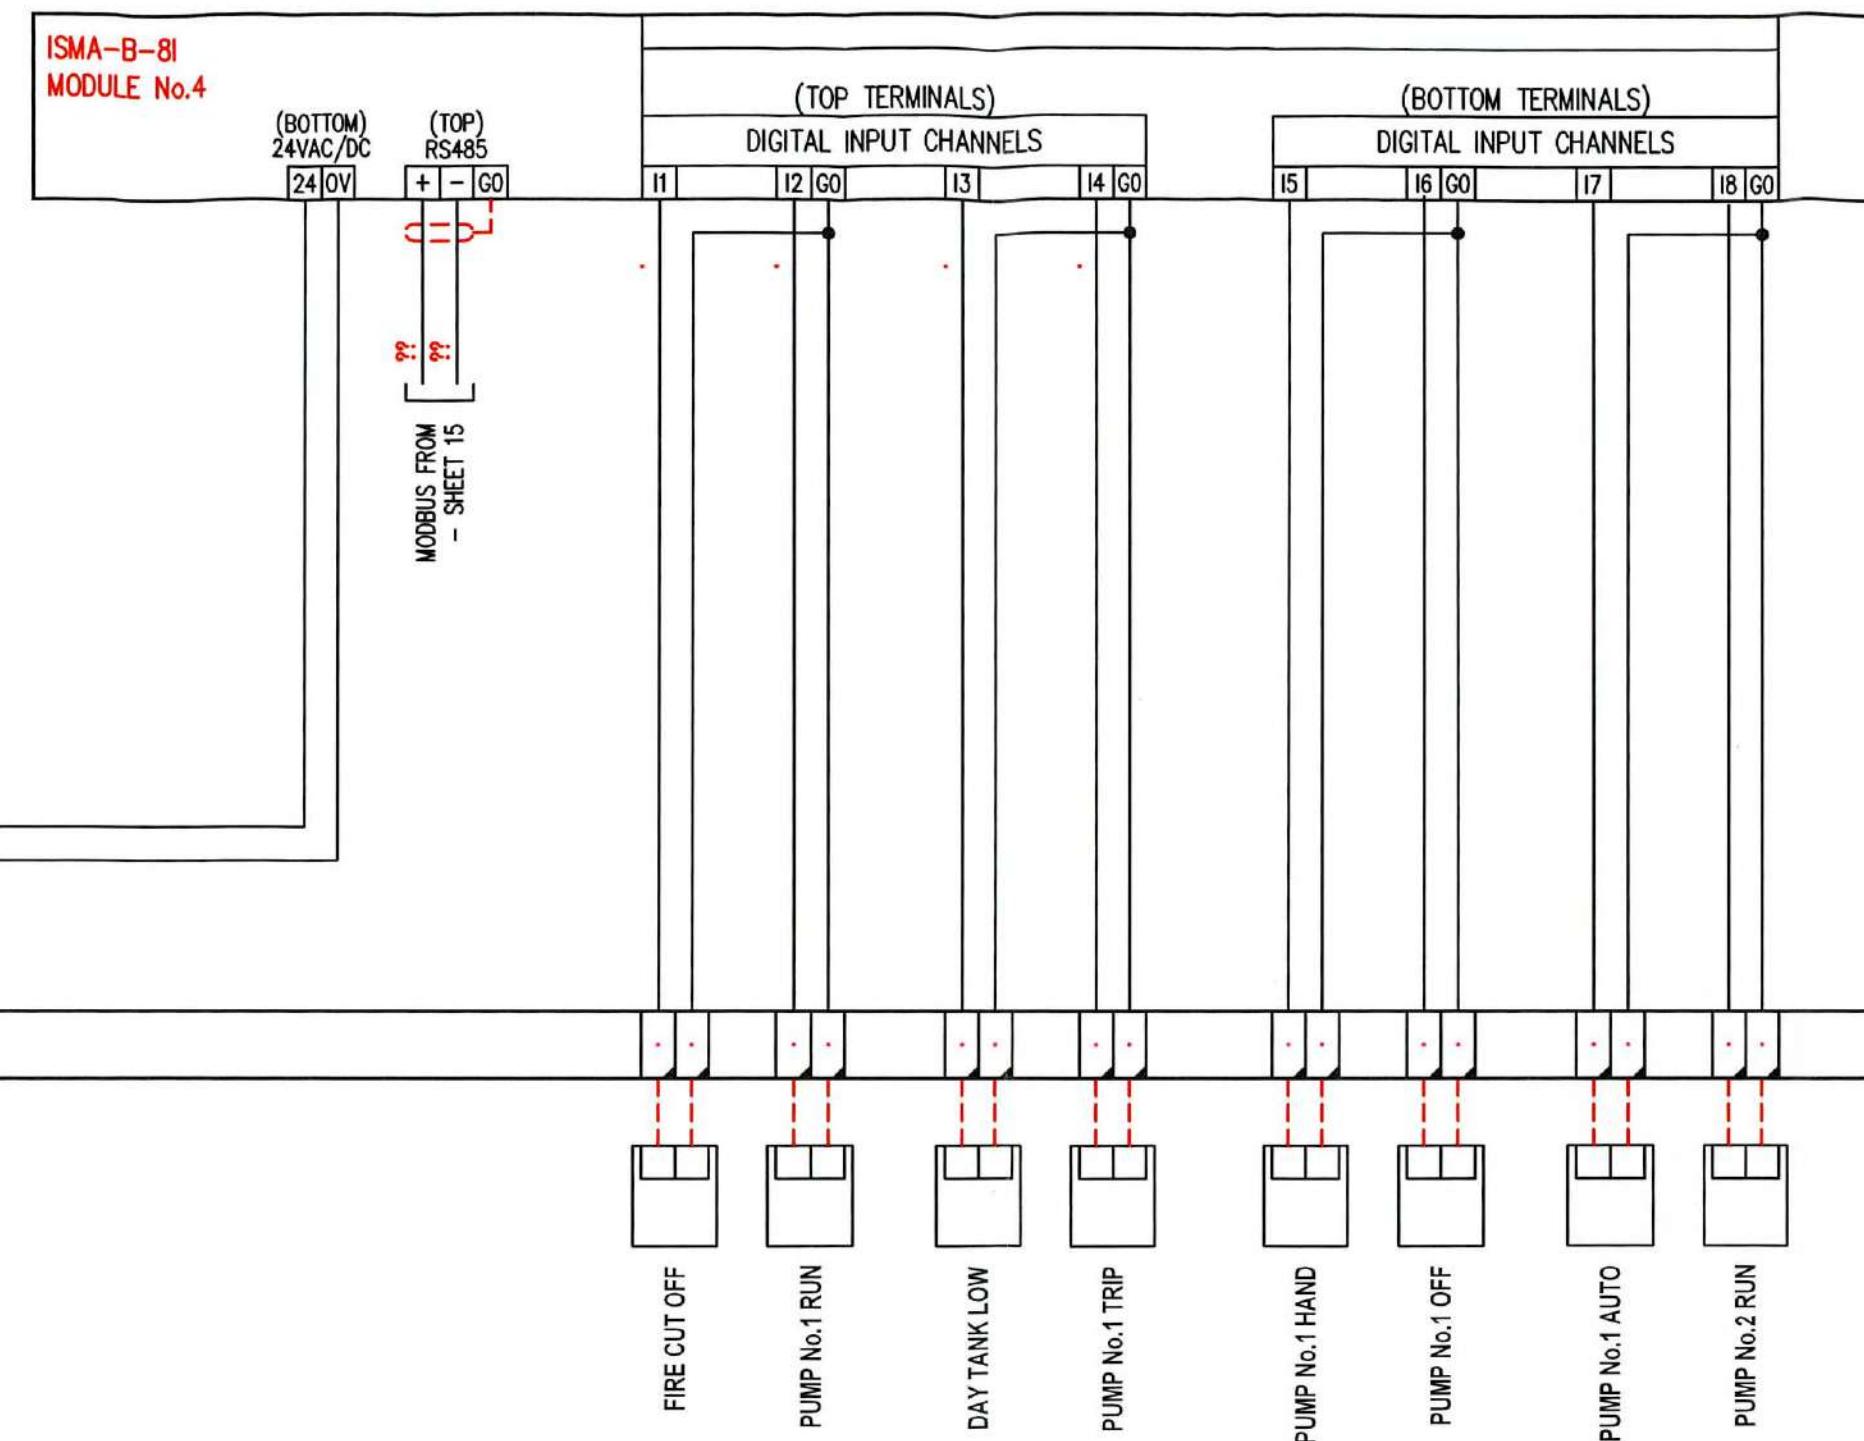

● PROVISIONAL ○ AS BUILT
 ● FOR APPROVAL ○ AS FITTED
 ○ ISSUED FOR CONSTRUCTION



REVISION No	DESCRIPTION OF REVISION	DRAWN BY DATE	CHECKED BY DATE	REVISION No	DESCRIPTION OF REVISION	STATUS	DRAWN BY DATE	CHECKED BY DATE	DRG No.6082-11 SHT. 16 of 19 PROJECT No.6083
0	PROVISIONAL	RFD 08/04/21		4					TITLE EXCHEQUER COURT
1	ISSUED FOR APPROVAL AFTER COMMENTS	RFD 09/05/21		5					PANEL TITLE BASEMENT EXTRACT NO.1 FAN CONTROL PANEL AP3
2				6					CLIENT
3				7					

REV 1
©

SPARE PAGE
ANTICIPATED USE

A

B

C

D

E

PROVISIONAL AS BUILT
 FOR APPROVAL AS FITTED
 ISSUED FOR CONSTRUCTION

REVISION No

DESCRIPTION OF REVISION

DRAWN BY

DATE

CHECKED BY

DATE

REVISION No

DESCRIPTION OF REVISION

STATUS

DRAWN BY

DATE

CHECKED BY

DATE

DRG No.6082-11
PROJECT No.6083

SHT. 17 of 19

REV 1
©

0

PROVISIONAL

RFD

08/04/21

4

1

ISSUED FOR APPROVAL AFTER COMMENTS

RFD

09/05/21

5

2

6

3



7

TITLE
EXCHEQUER COURTPANEL TITLE
BASEMENT EXTRACT NO.1 FAN CONTROL PANEL AP3

CLIENT



A



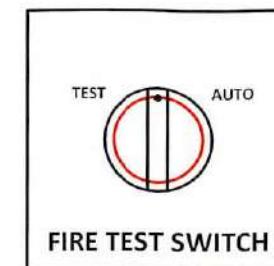
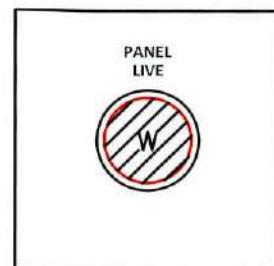


DANGER
COMPONENTS
ARE LIVE WHEN
DOOR IS OPEN



DANGER
COMPONENTS
ARE LIVE WHEN
DOOR IS OPEN

DANGER
COMPONENTS
ARE LIVE WHEN
DOOR IS OPEN

B

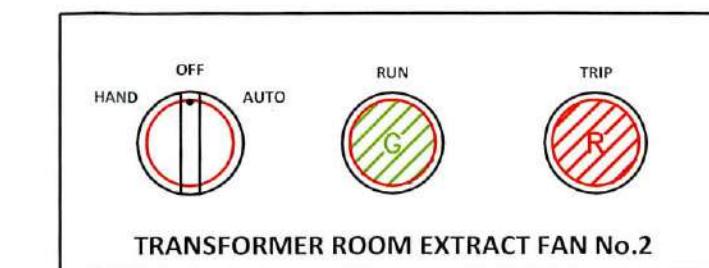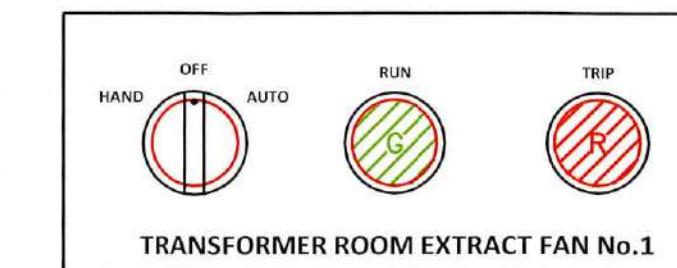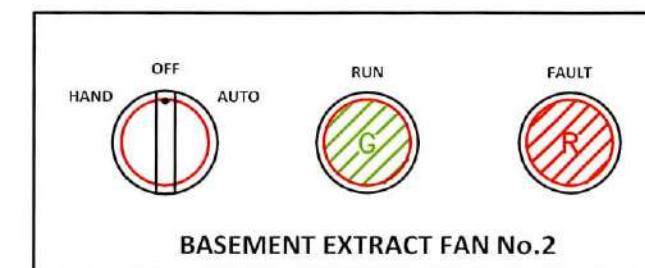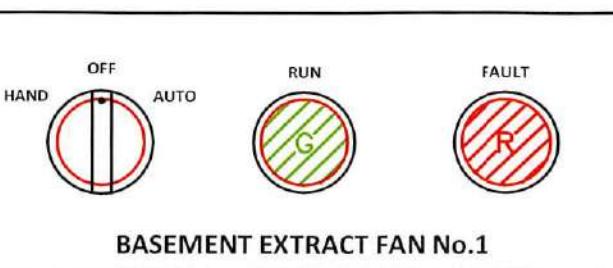

C

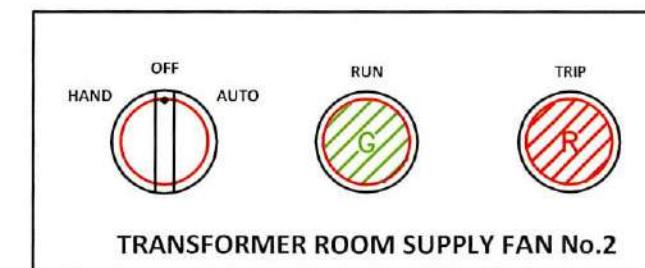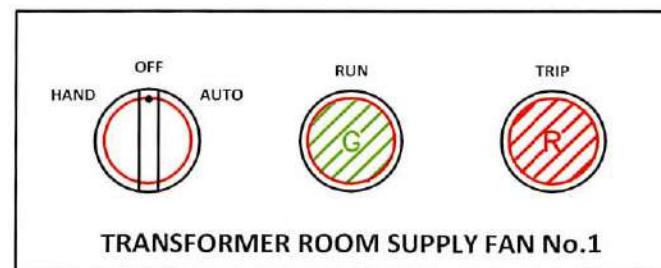

D

E

● PROVISIONAL ○ AS BUILT
 ● FOR APPROVAL ○ AS FITTED
 ○ ISSUED FOR CONSTRUCTION



REVISION No	DESCRIPTION OF REVISION			DRAWN BY DATE	CHECKED BY DATE	REVISION No	DESCRIPTION OF REVISION			STATUS	DRAWN BY DATE	CHECKED BY DATE
0	PROVISIONAL			RFD 08/04/21		4						
1	ISSUED FOR APPROVAL AFTER COMMENTS			RFD 09/05/21		5						
2						6						
3						7						

DRG No.6082-11 SHT. 19 of 19
PROJECT No.6083 REV 1
©

TITLE EXCHEQUER COURT

PANEL TITLE BASEMENT EXTRACT NO.1 FAN
CONTROL PANEL AP3

CLIENT



Project : EXCHEQUER COURT

Title : BOILERHOUSE PLANTROOM
CONTROL PANEL

Client :

ENGINEER : RFD

DATE : 09/05/21

DRAWING No : 6082-13

SHEET : 20

REVISION : 1

PROJECT No. : 6082

0 1 2 3 4 5 6 7 8 9

L3
L2
L1
N


A

B

C

D

E

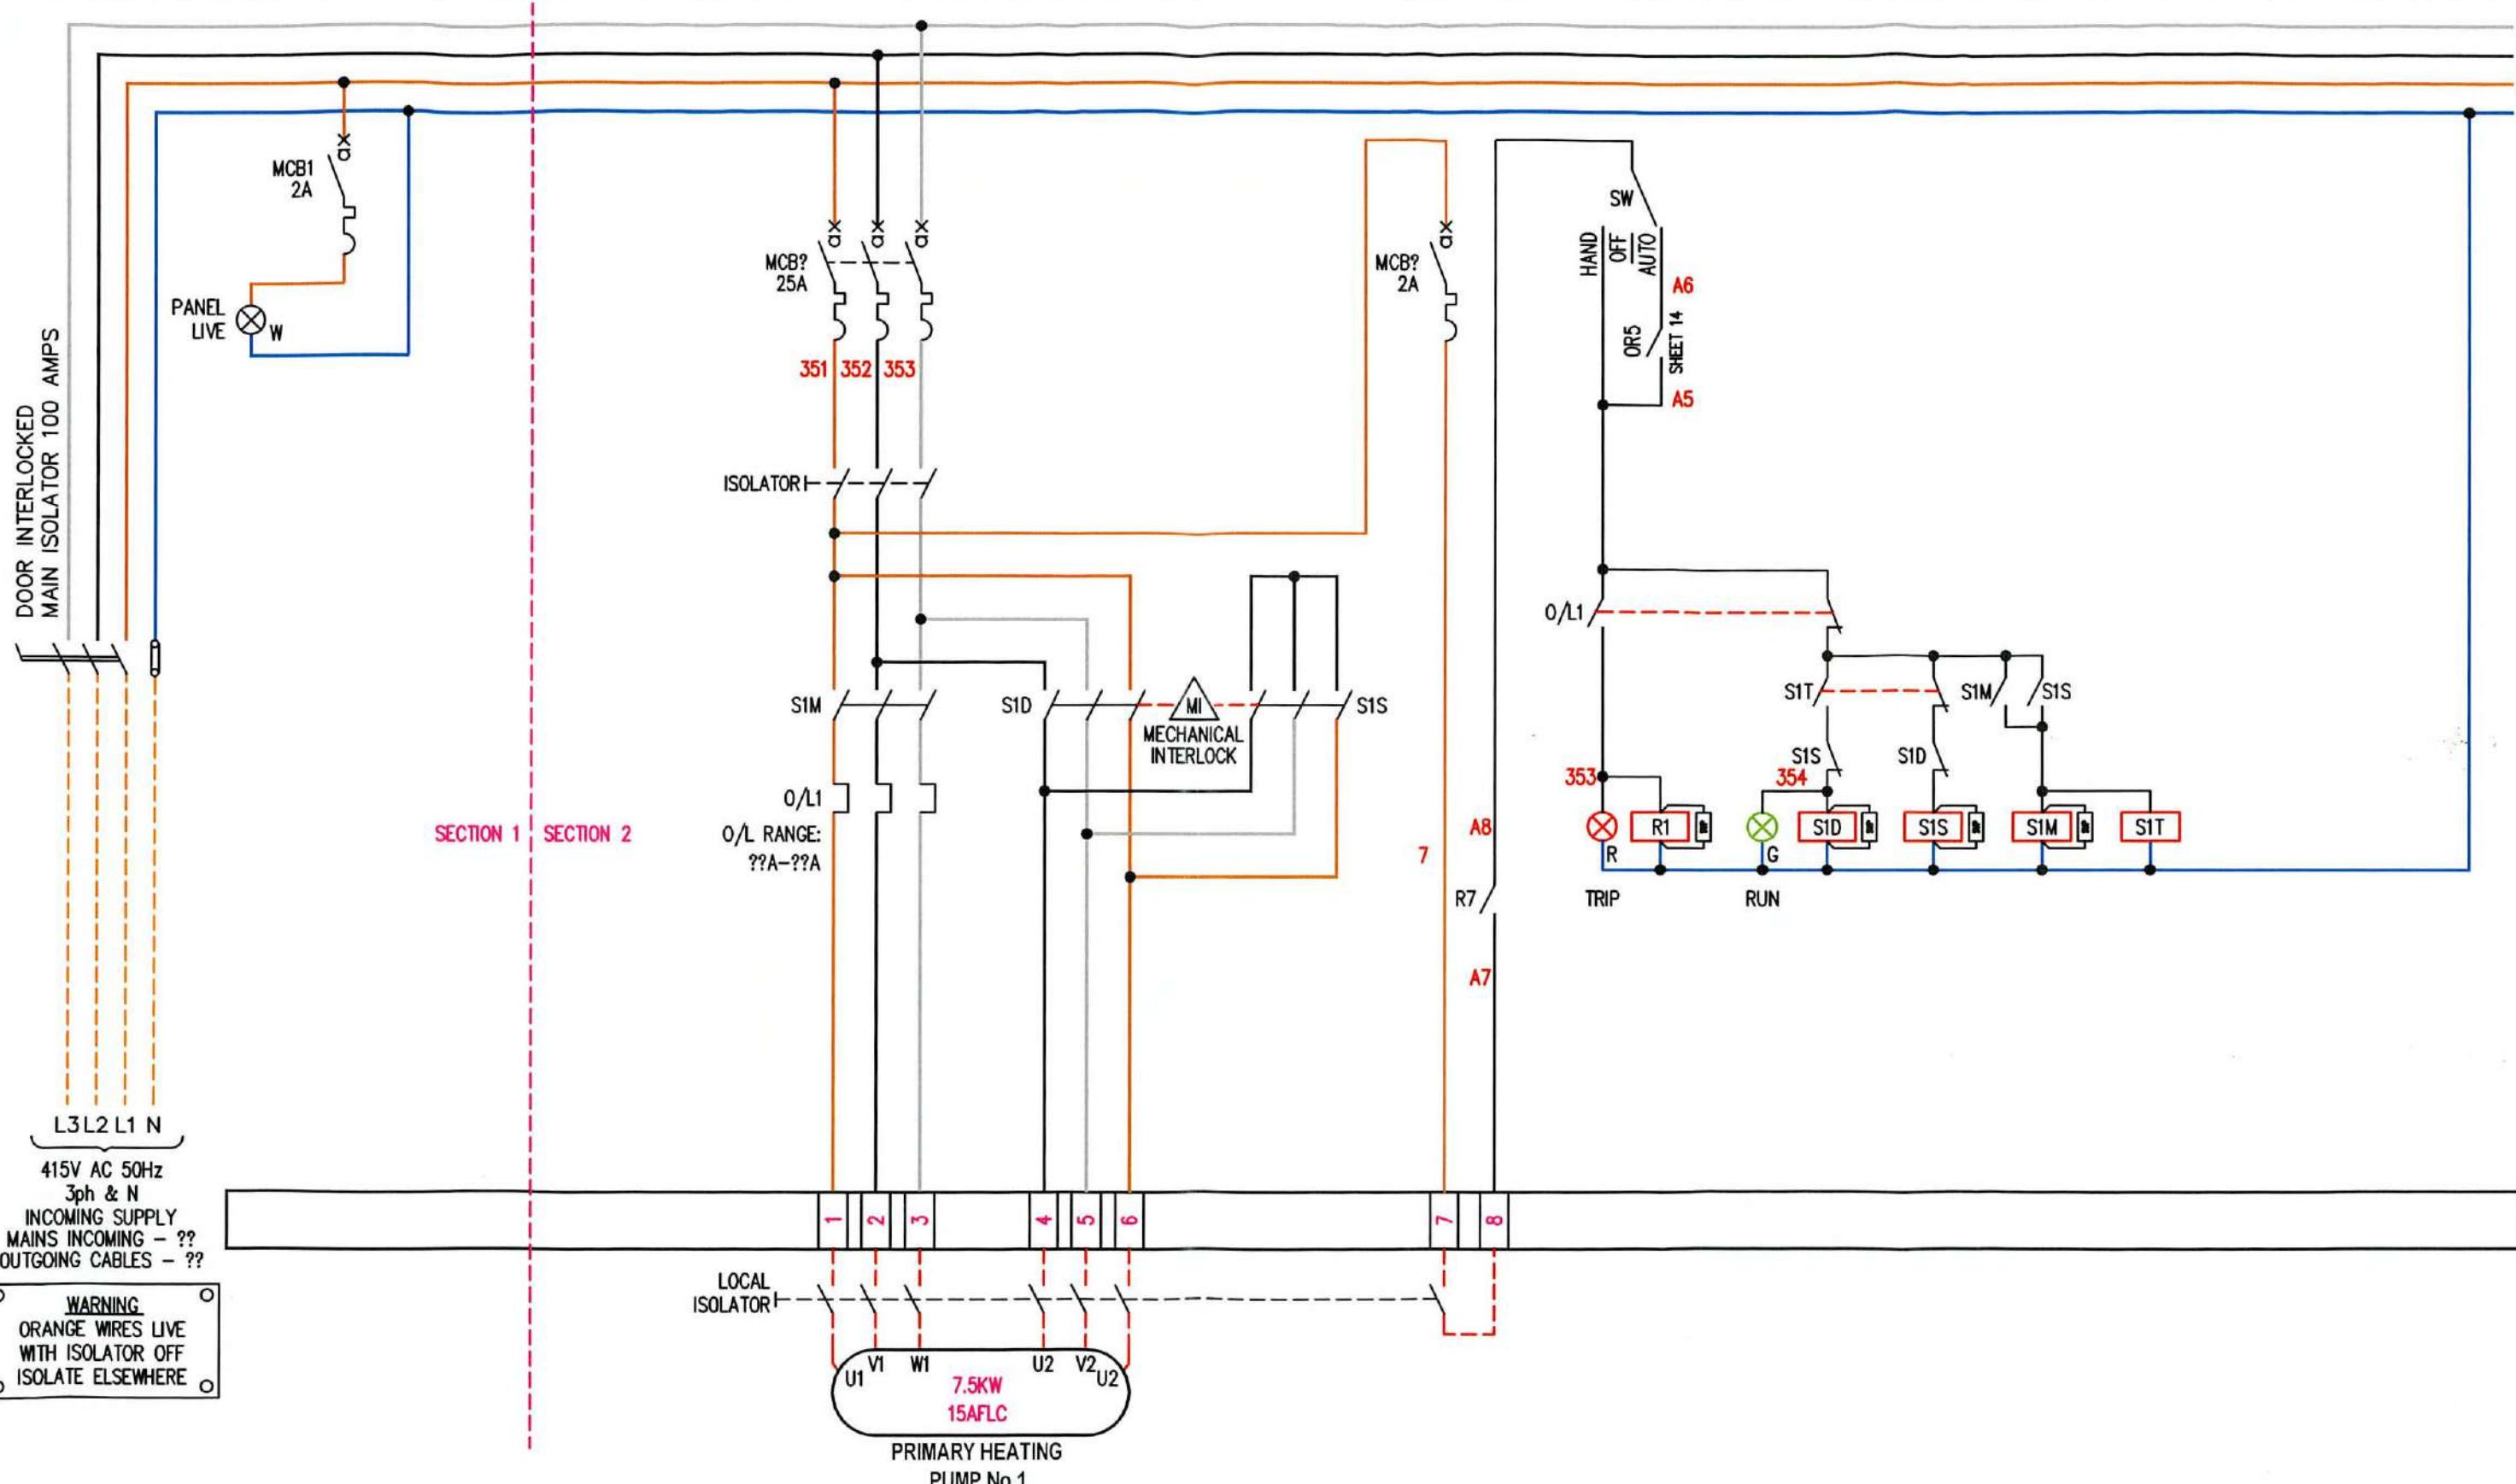


● PROVISIONAL
● FOR APPROVAL
○ AS BUILT
○ AS FITTED
○ ISSUED FOR
CONSTRUCTION





REVISION No	DESCRIPTION OF REVISION	DRAWN BY DATE	CHECKED BY DATE	REVISION No
0	PROVISIONAL	RFD 28/04/21		4
1	APPROVAL	RFD 09/05/21		5
2				6
3				7

DRG No.6082-13 PROJECT No.6082	SHT. 2 of 20	REV 1 ©
TITLE	EXCHEQUER COURT	
PANEL TITLE	BOILERHOUSE PLANTROOM CONTROL PANEL	
CLIENT		

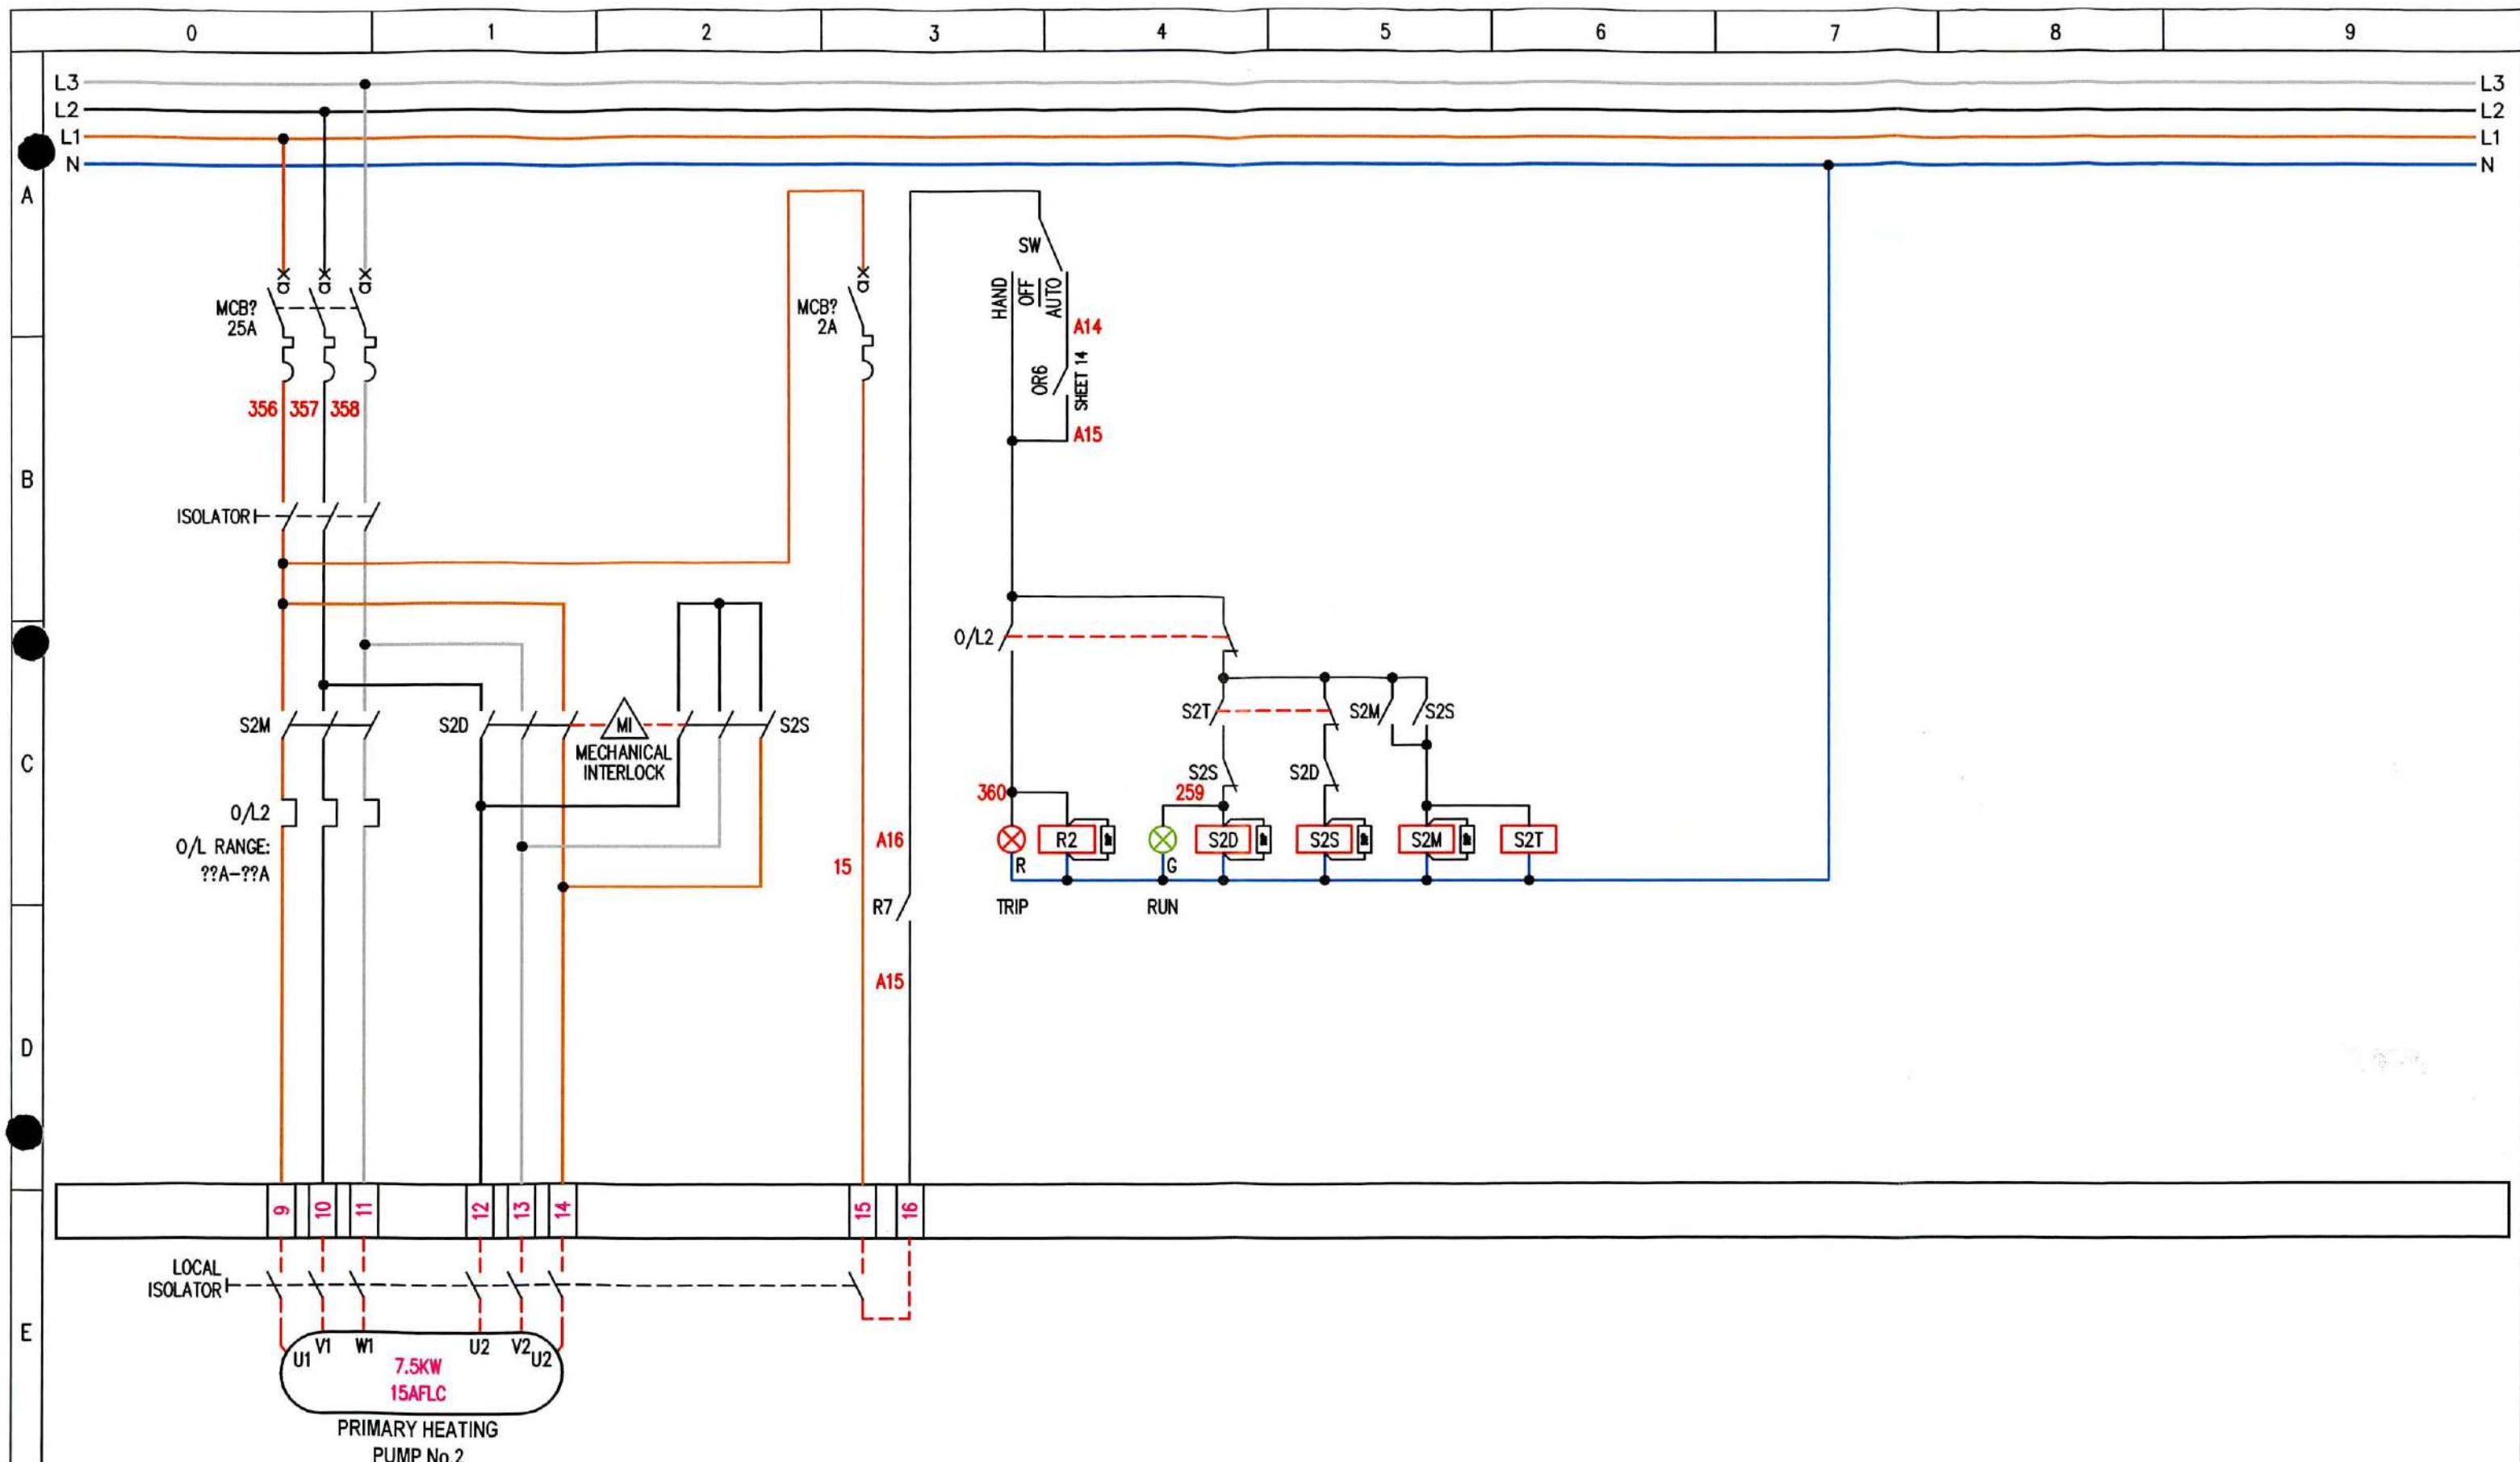


		REVISION No	DESCRIPTION OF REVISION			DRAWN BY DATE	CHECKED BY DATE	REVISION No	DESCRIPTION OF REVISION			STATUS	DRAWN BY DATE	CHECKED BY DATE	DRG No.6082-13 SHT. 3 of 20 PROJECT No.6082		
PROVISIONAL	AS BUILT		PROVISIONAL						APPROVAL						TITLE		REV 1 ©
FOR APPROVAL	AS FITTED	0	PROVISIONAL			RFD 28/04/21		4							EXCHEQUER COURT		
ISSUED FOR CONSTRUCTION		1	APPROVAL			RFD 09/05/21		5							PANEL TITLE		BOILERHOUSE PLANTROOM CONTROL PANEL
		2						6							CLIENT		
		3						7									

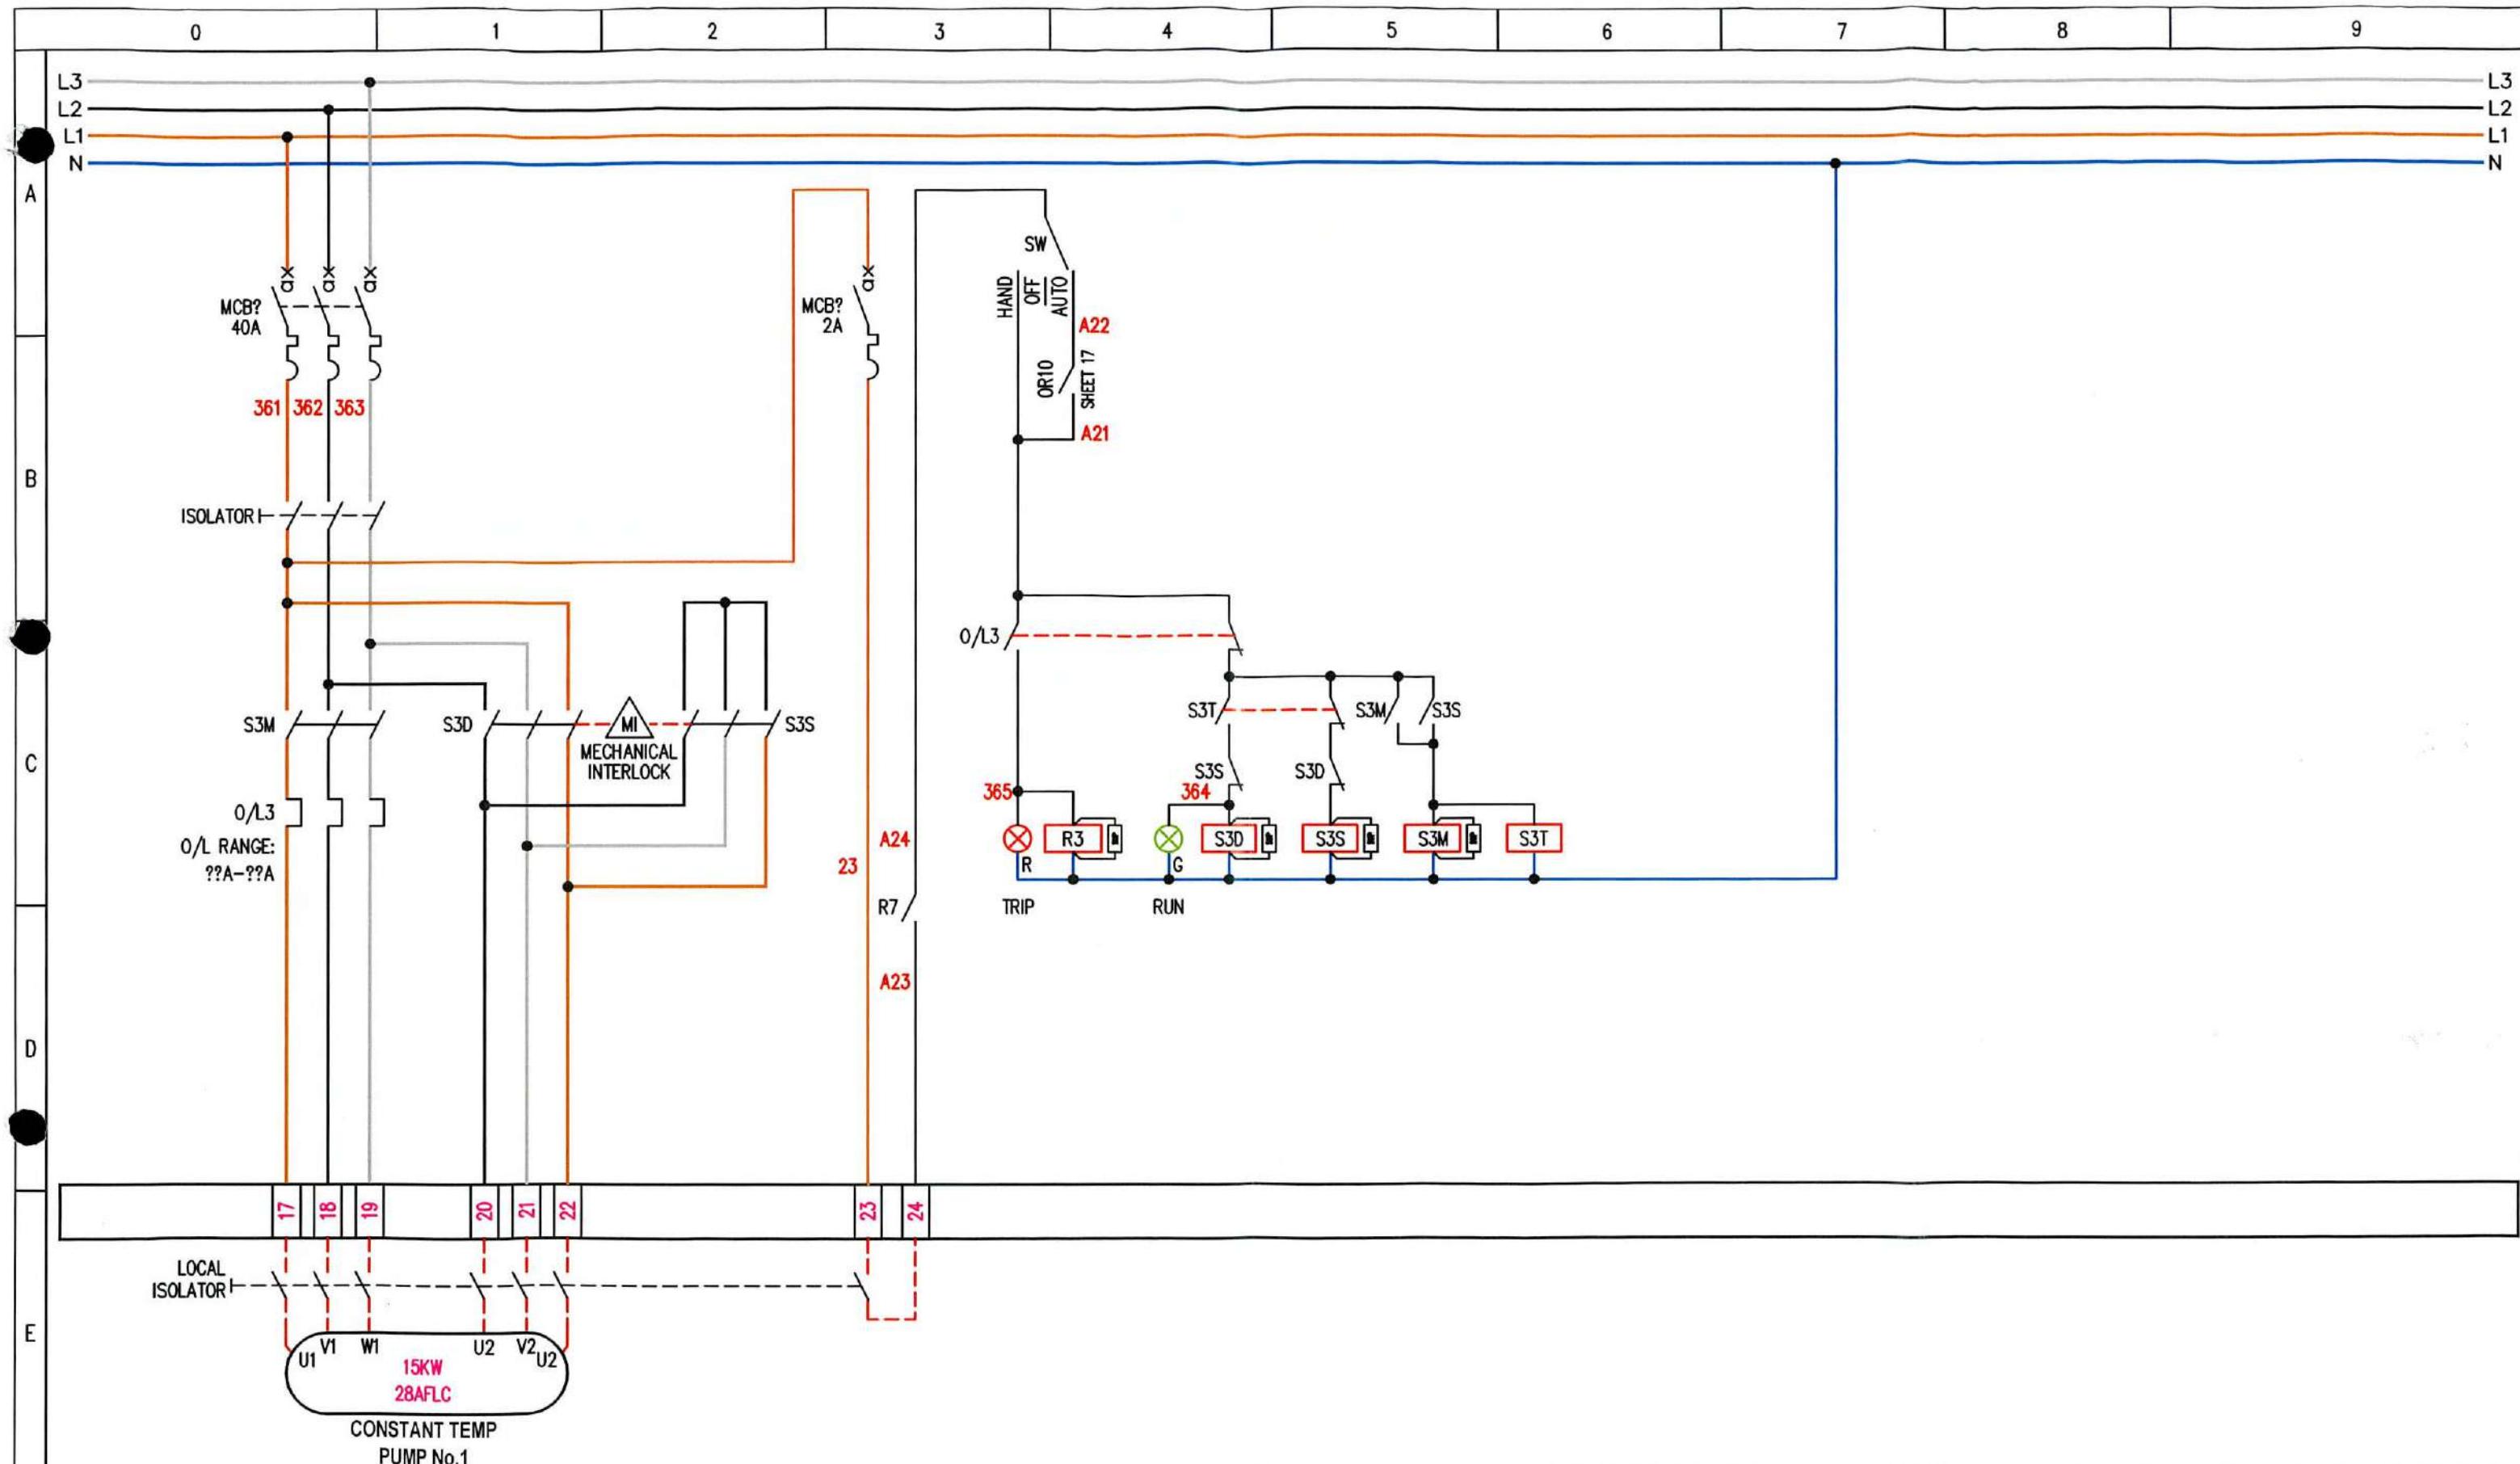


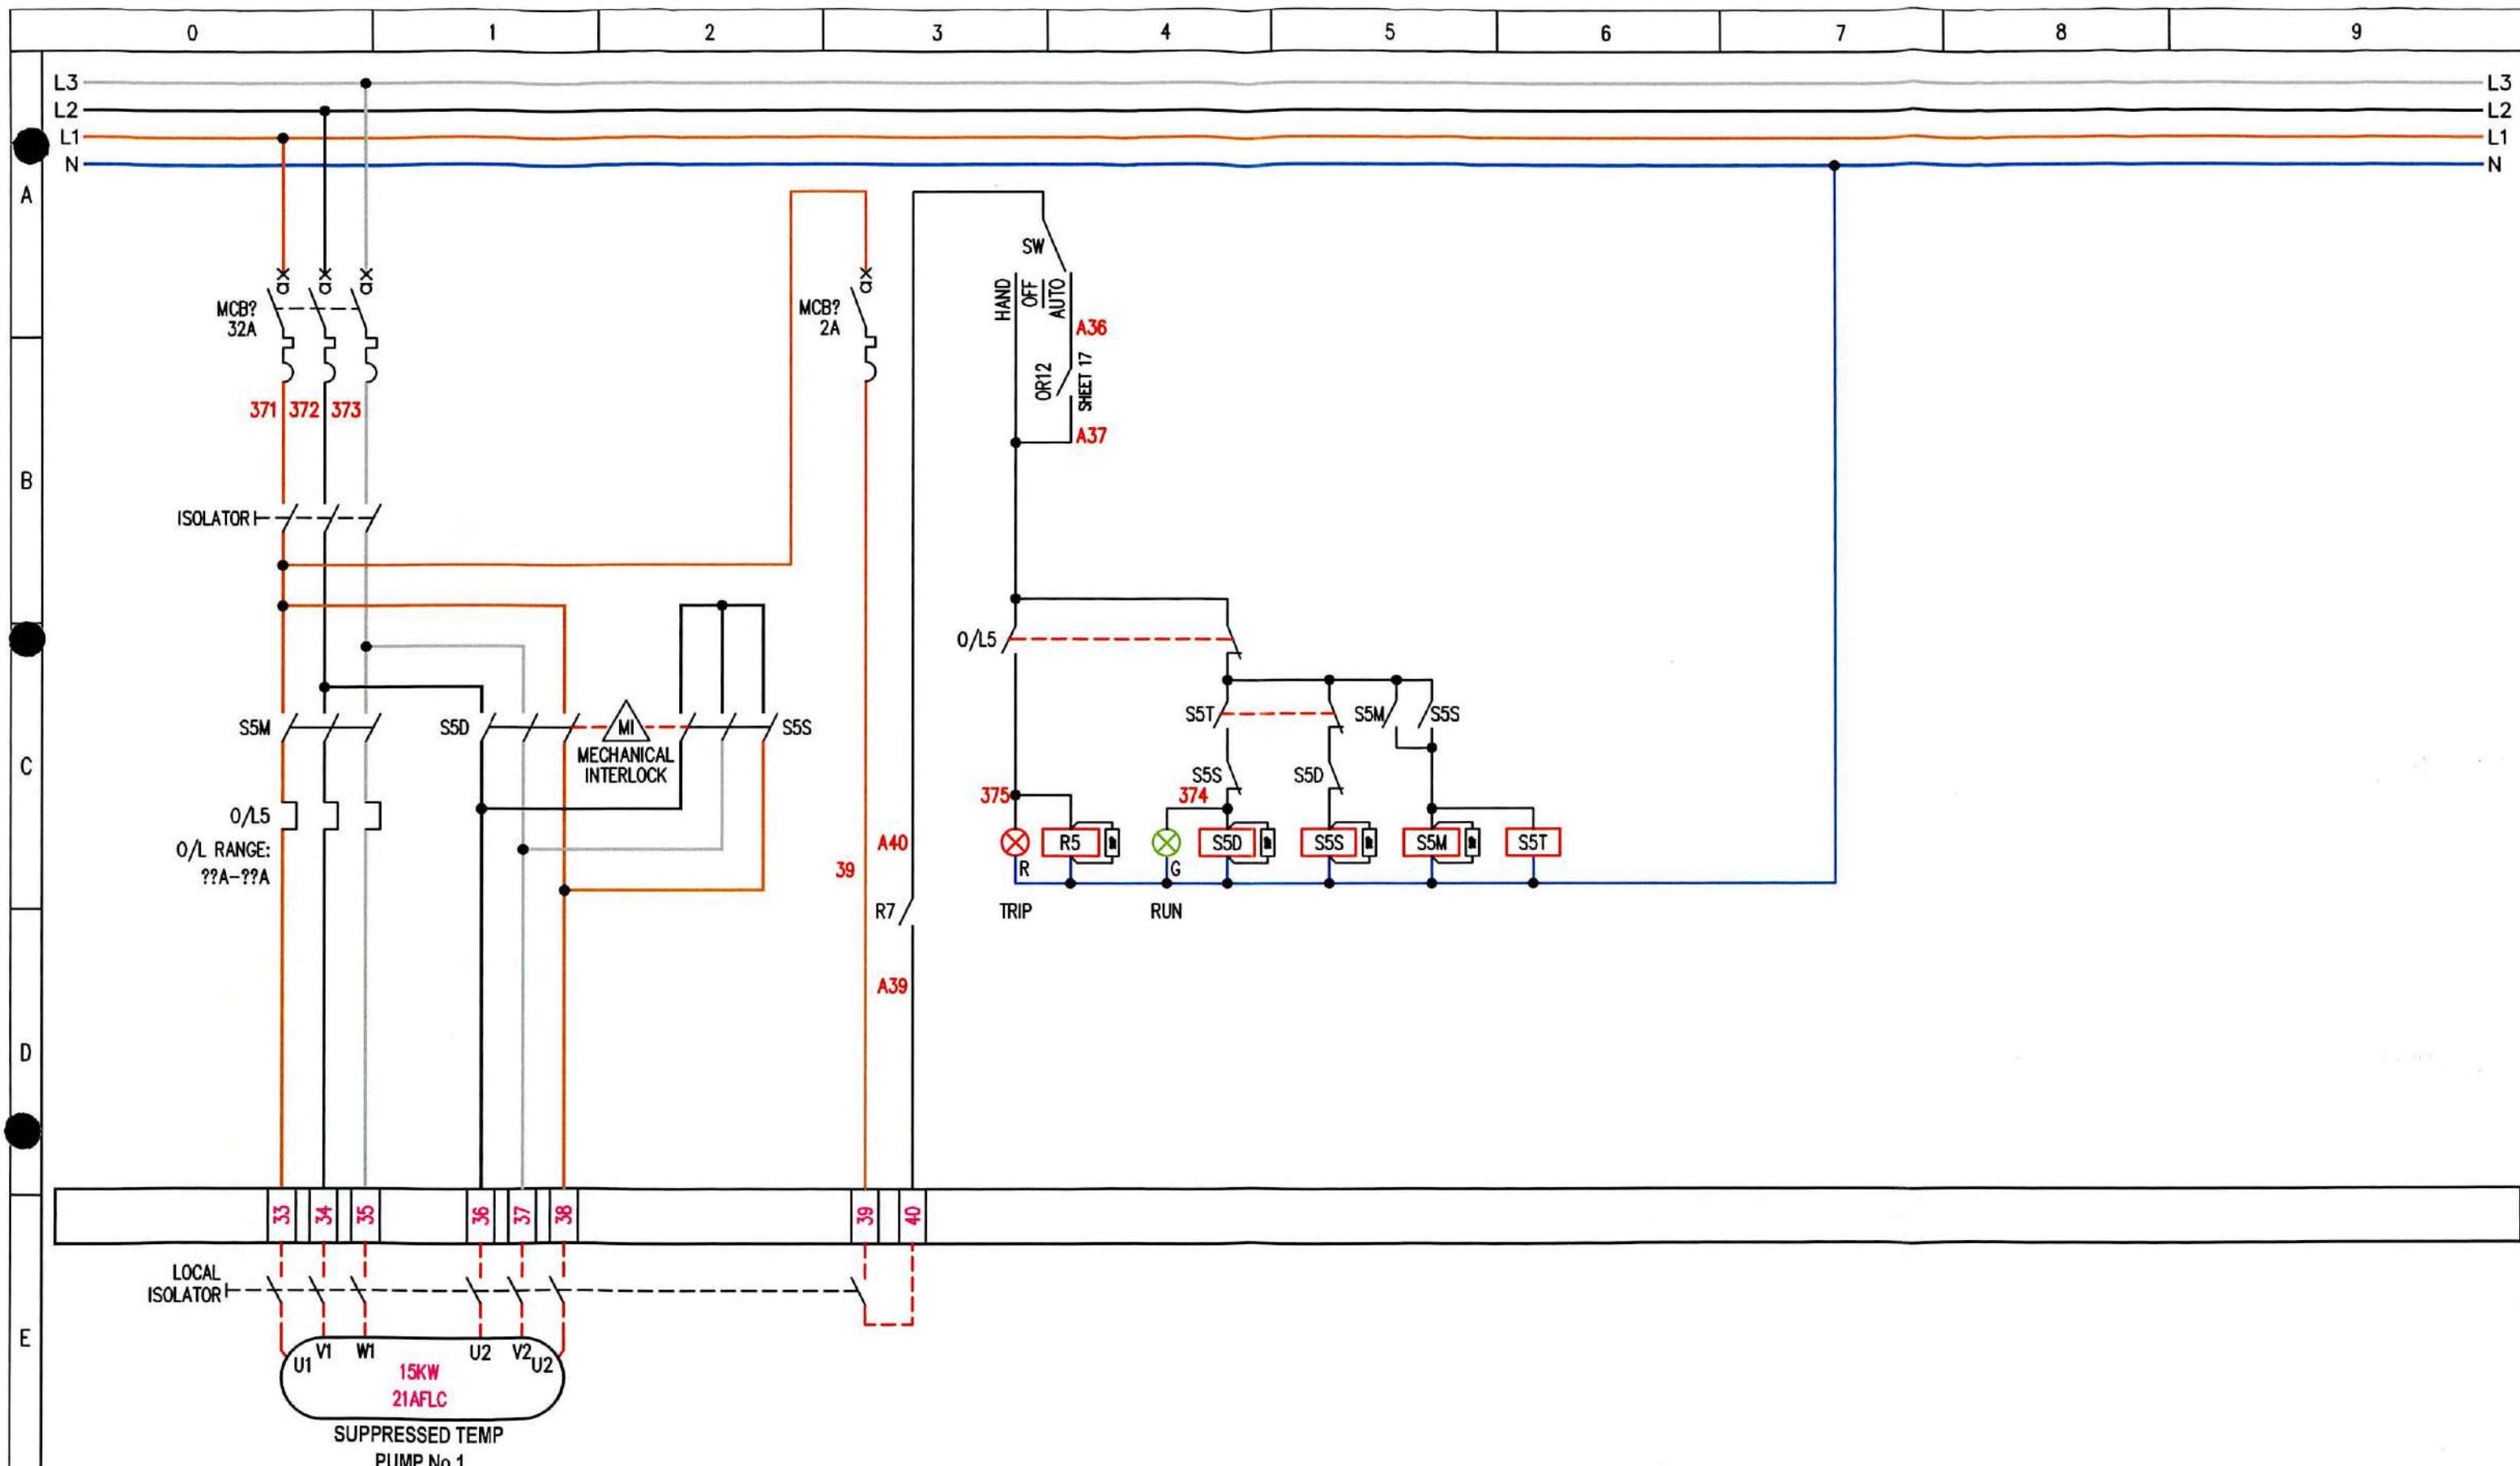


PROVISIONAL	AS BUILT	REVISION No	DESCRIPTION OF REVISION	DRAWN BY	CHECKED BY	REVISION No	DESCRIPTION OF REVISION	STATUS	DRAWN BY	CHECKED BY	DRG No.6082-13 SHT. 6 of 20 PROJECT No.6082	REV 1
● FOR APPROVAL	○ AS FITTED	0	PROVISIONAL	RFD 28/04/21		4						©
○ ISSUED FOR CONSTRUCTION		1	APPROVAL	RFD 09/05/21		5						
		2				6						
		3				7						
bges group			TITLE EXCHEQUER COURT		PANEL TITLE BOILERHOUSE PLANTROOM CONTROL PANEL		CLIENT					

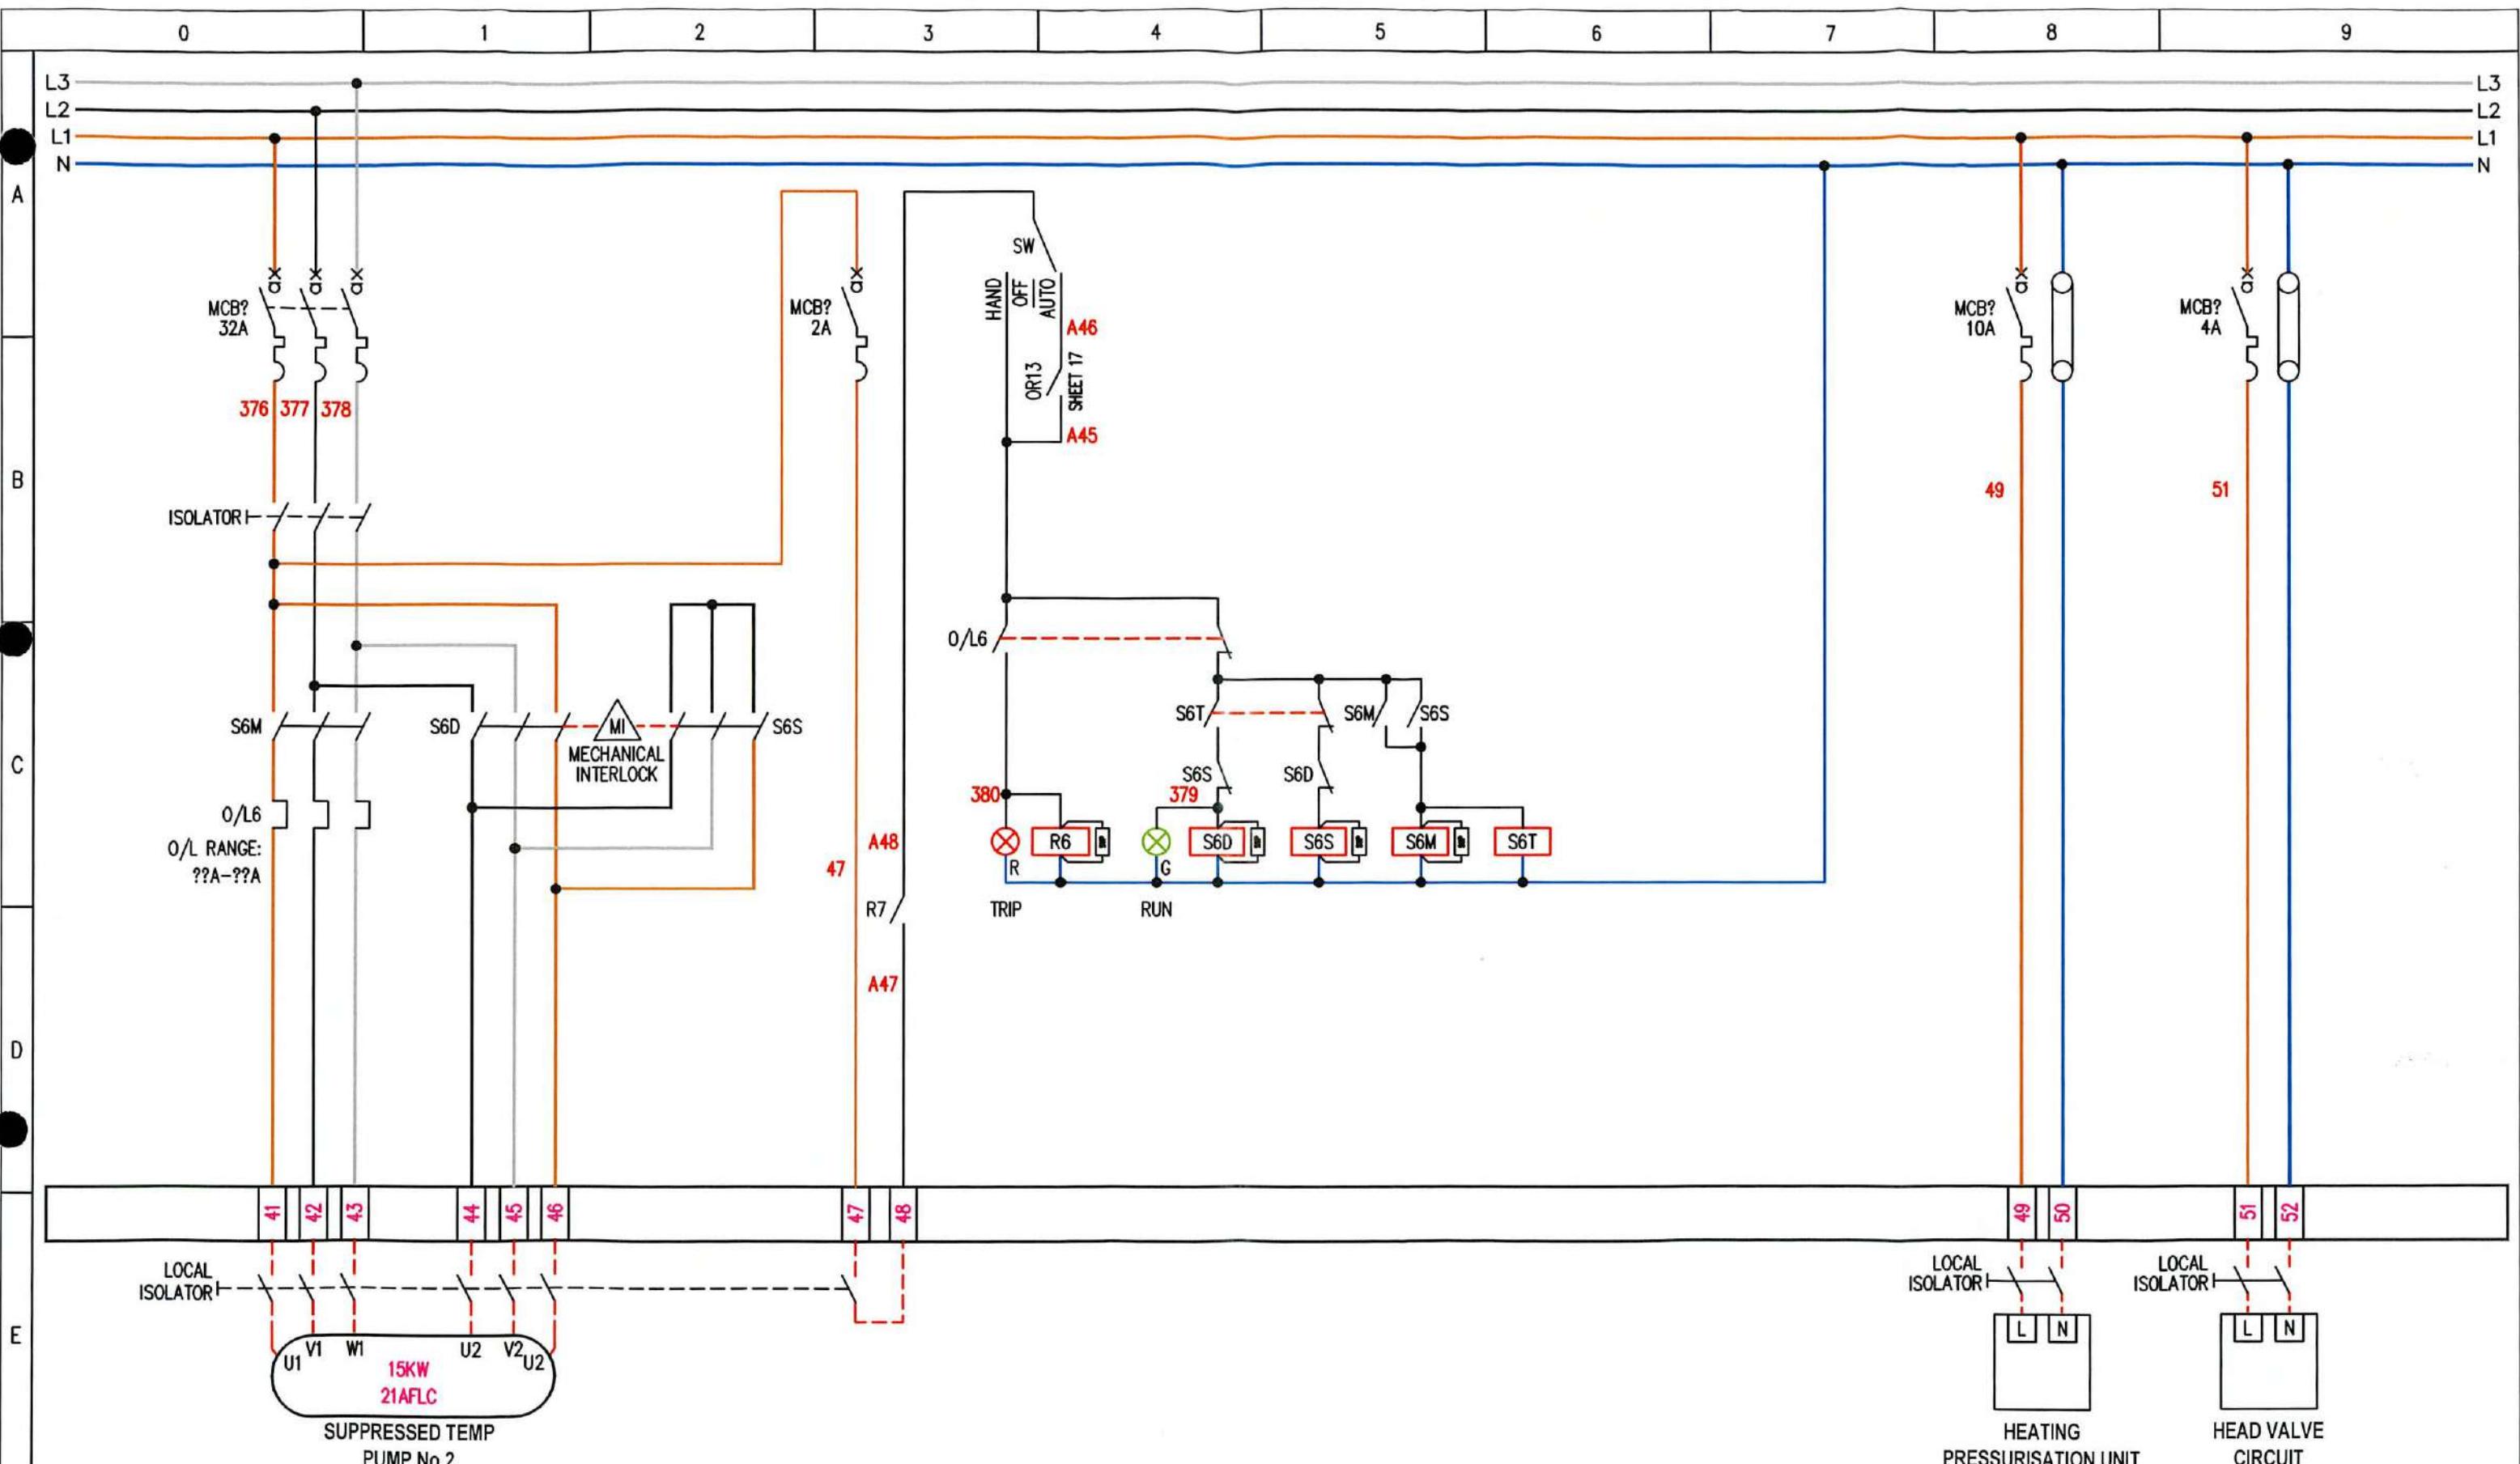

PROVISIONAL FOR APPROVAL ISSUED FOR CONSTRUCTION		AS BUILT	AS FITTED	REVISION No	DESCRIPTION OF REVISION			DRAWN BY DATE	CHECKED BY DATE	REVISION No	DESCRIPTION OF REVISION			STATUS	DRAWN BY DATE	CHECKED BY DATE	DRG No.6082-13 PROJECT No.6082	SHT. 7 of 20	REV 1 ©
0	PROVISIONAL				RFD 28/04/21					4									
1	APPROVAL				RFD 09/05/21					5									
2										6									
3										7									
bgesgroup				TITLE		EXCHEQUER COURT		PANEL TITLE		BOILERHOUSE PLANTROOM CONTROL PANEL		CLIENT							

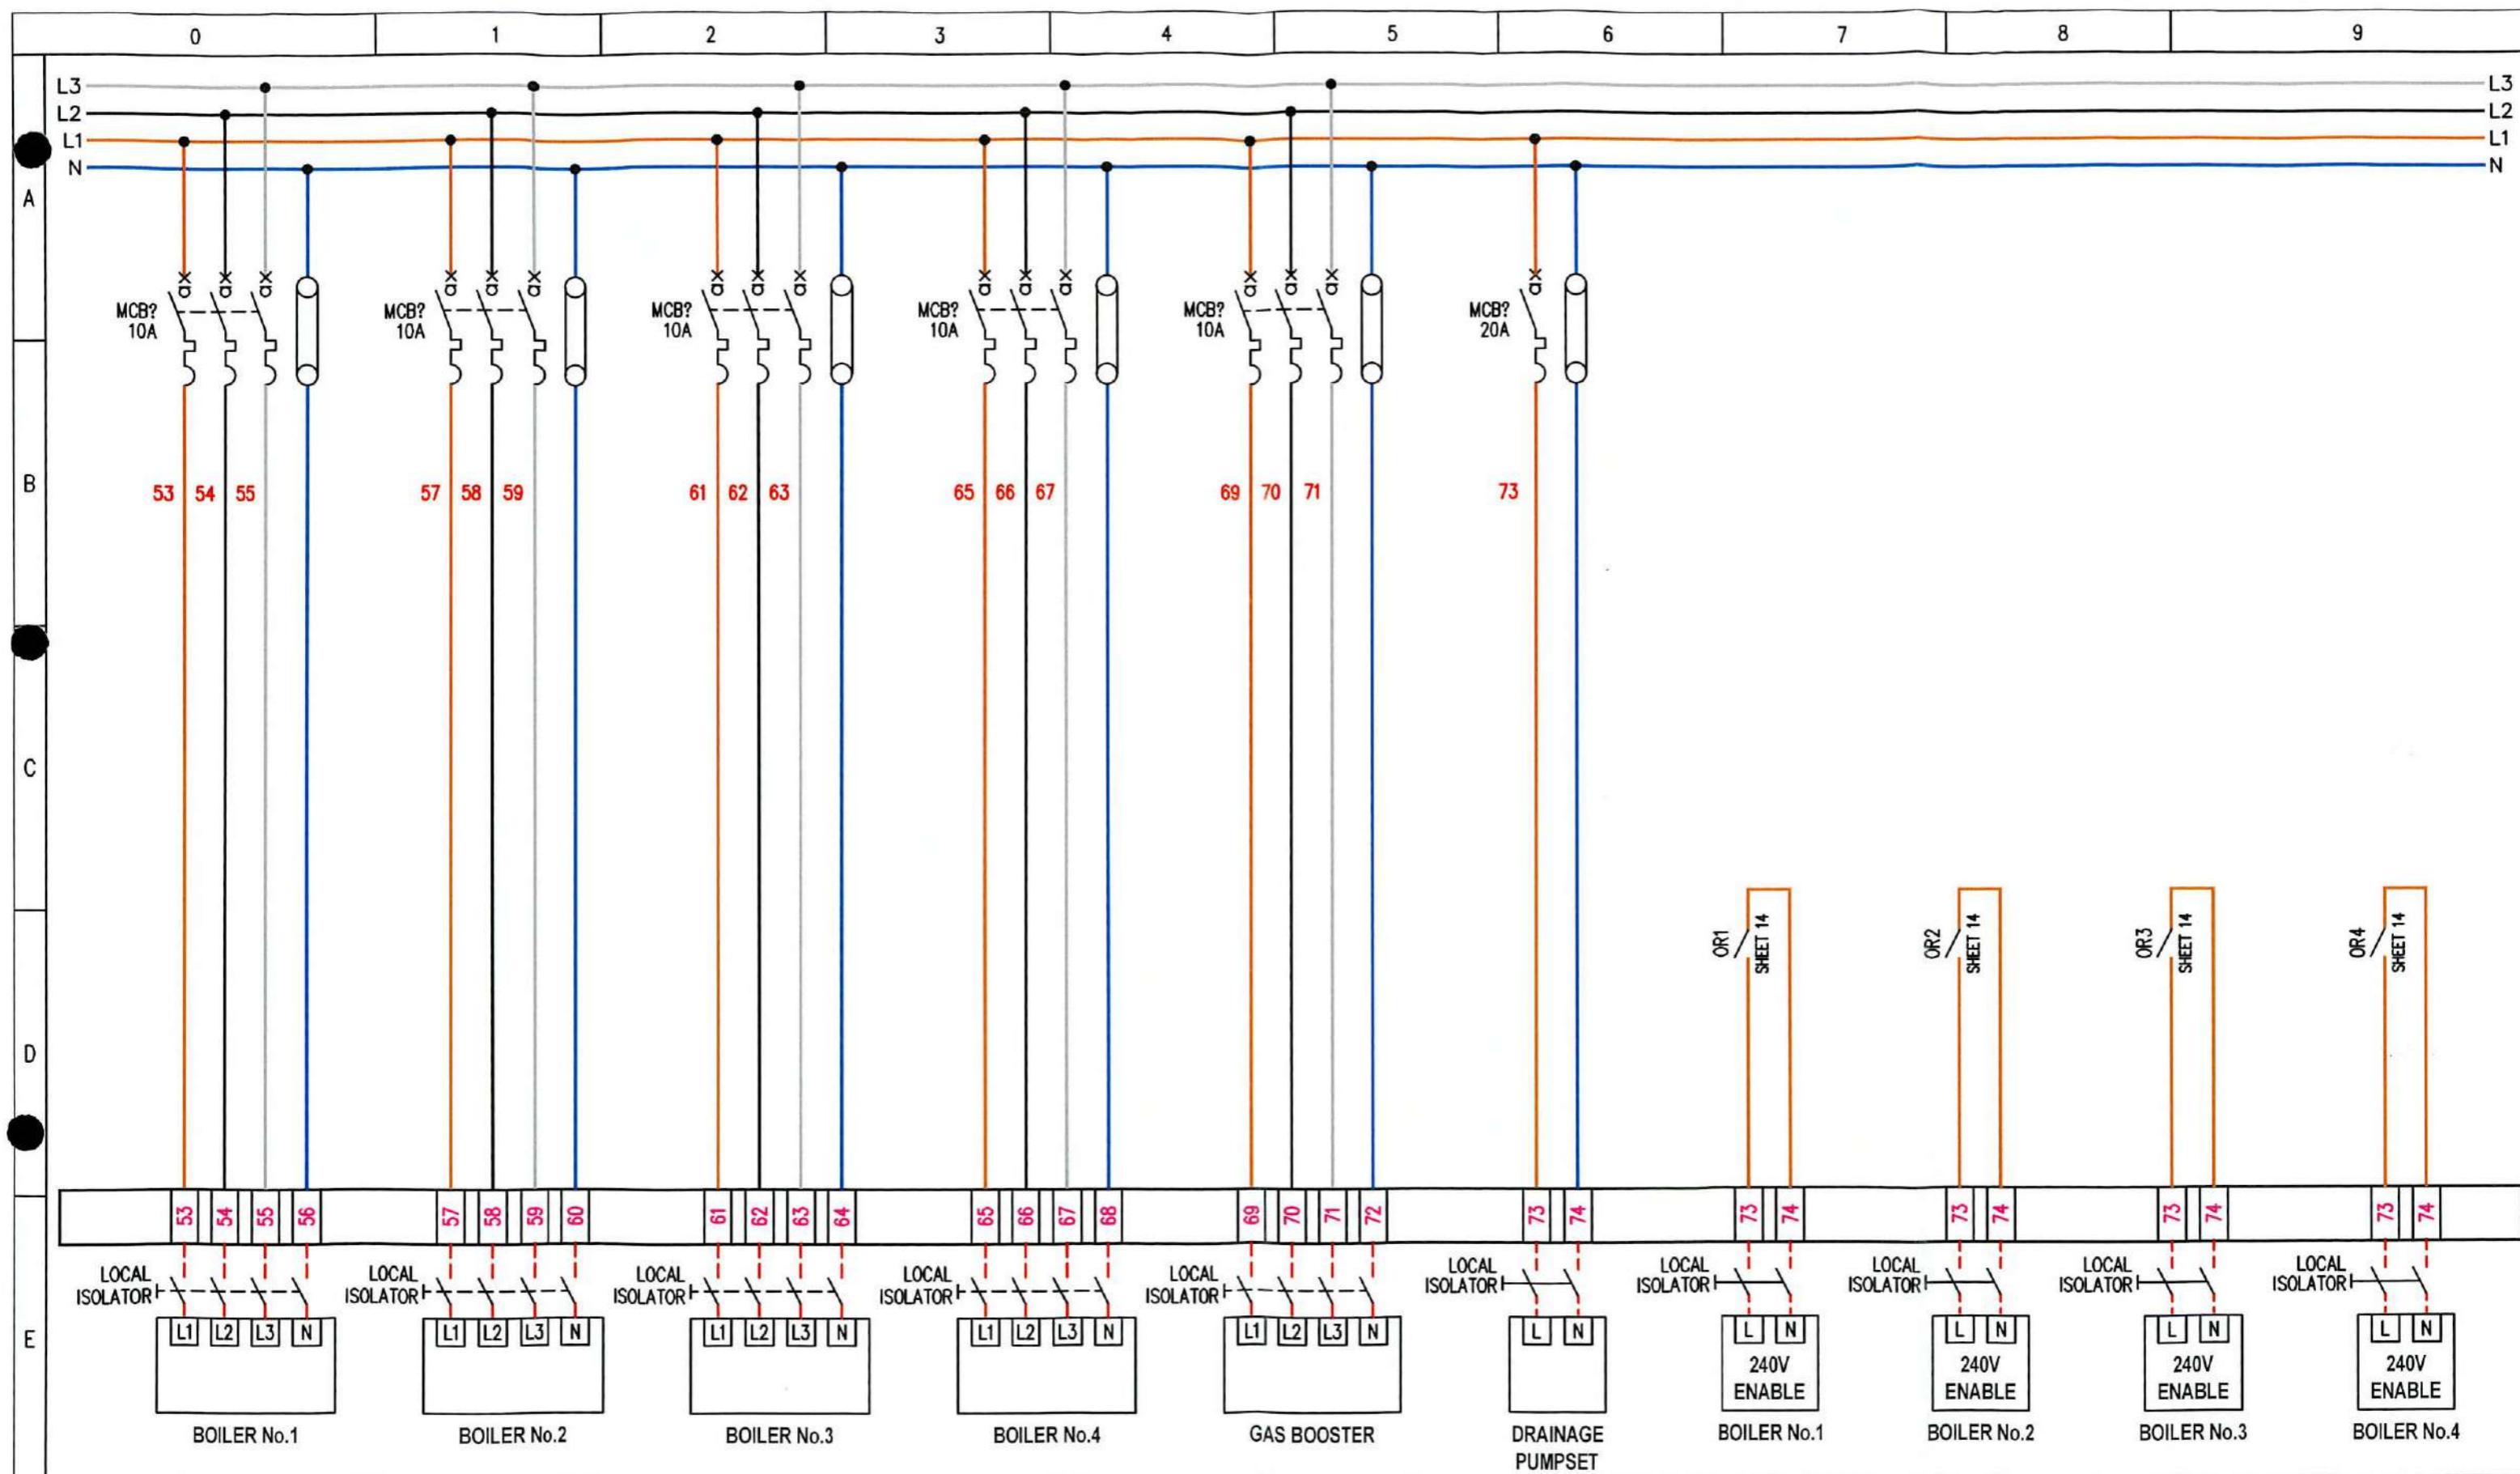

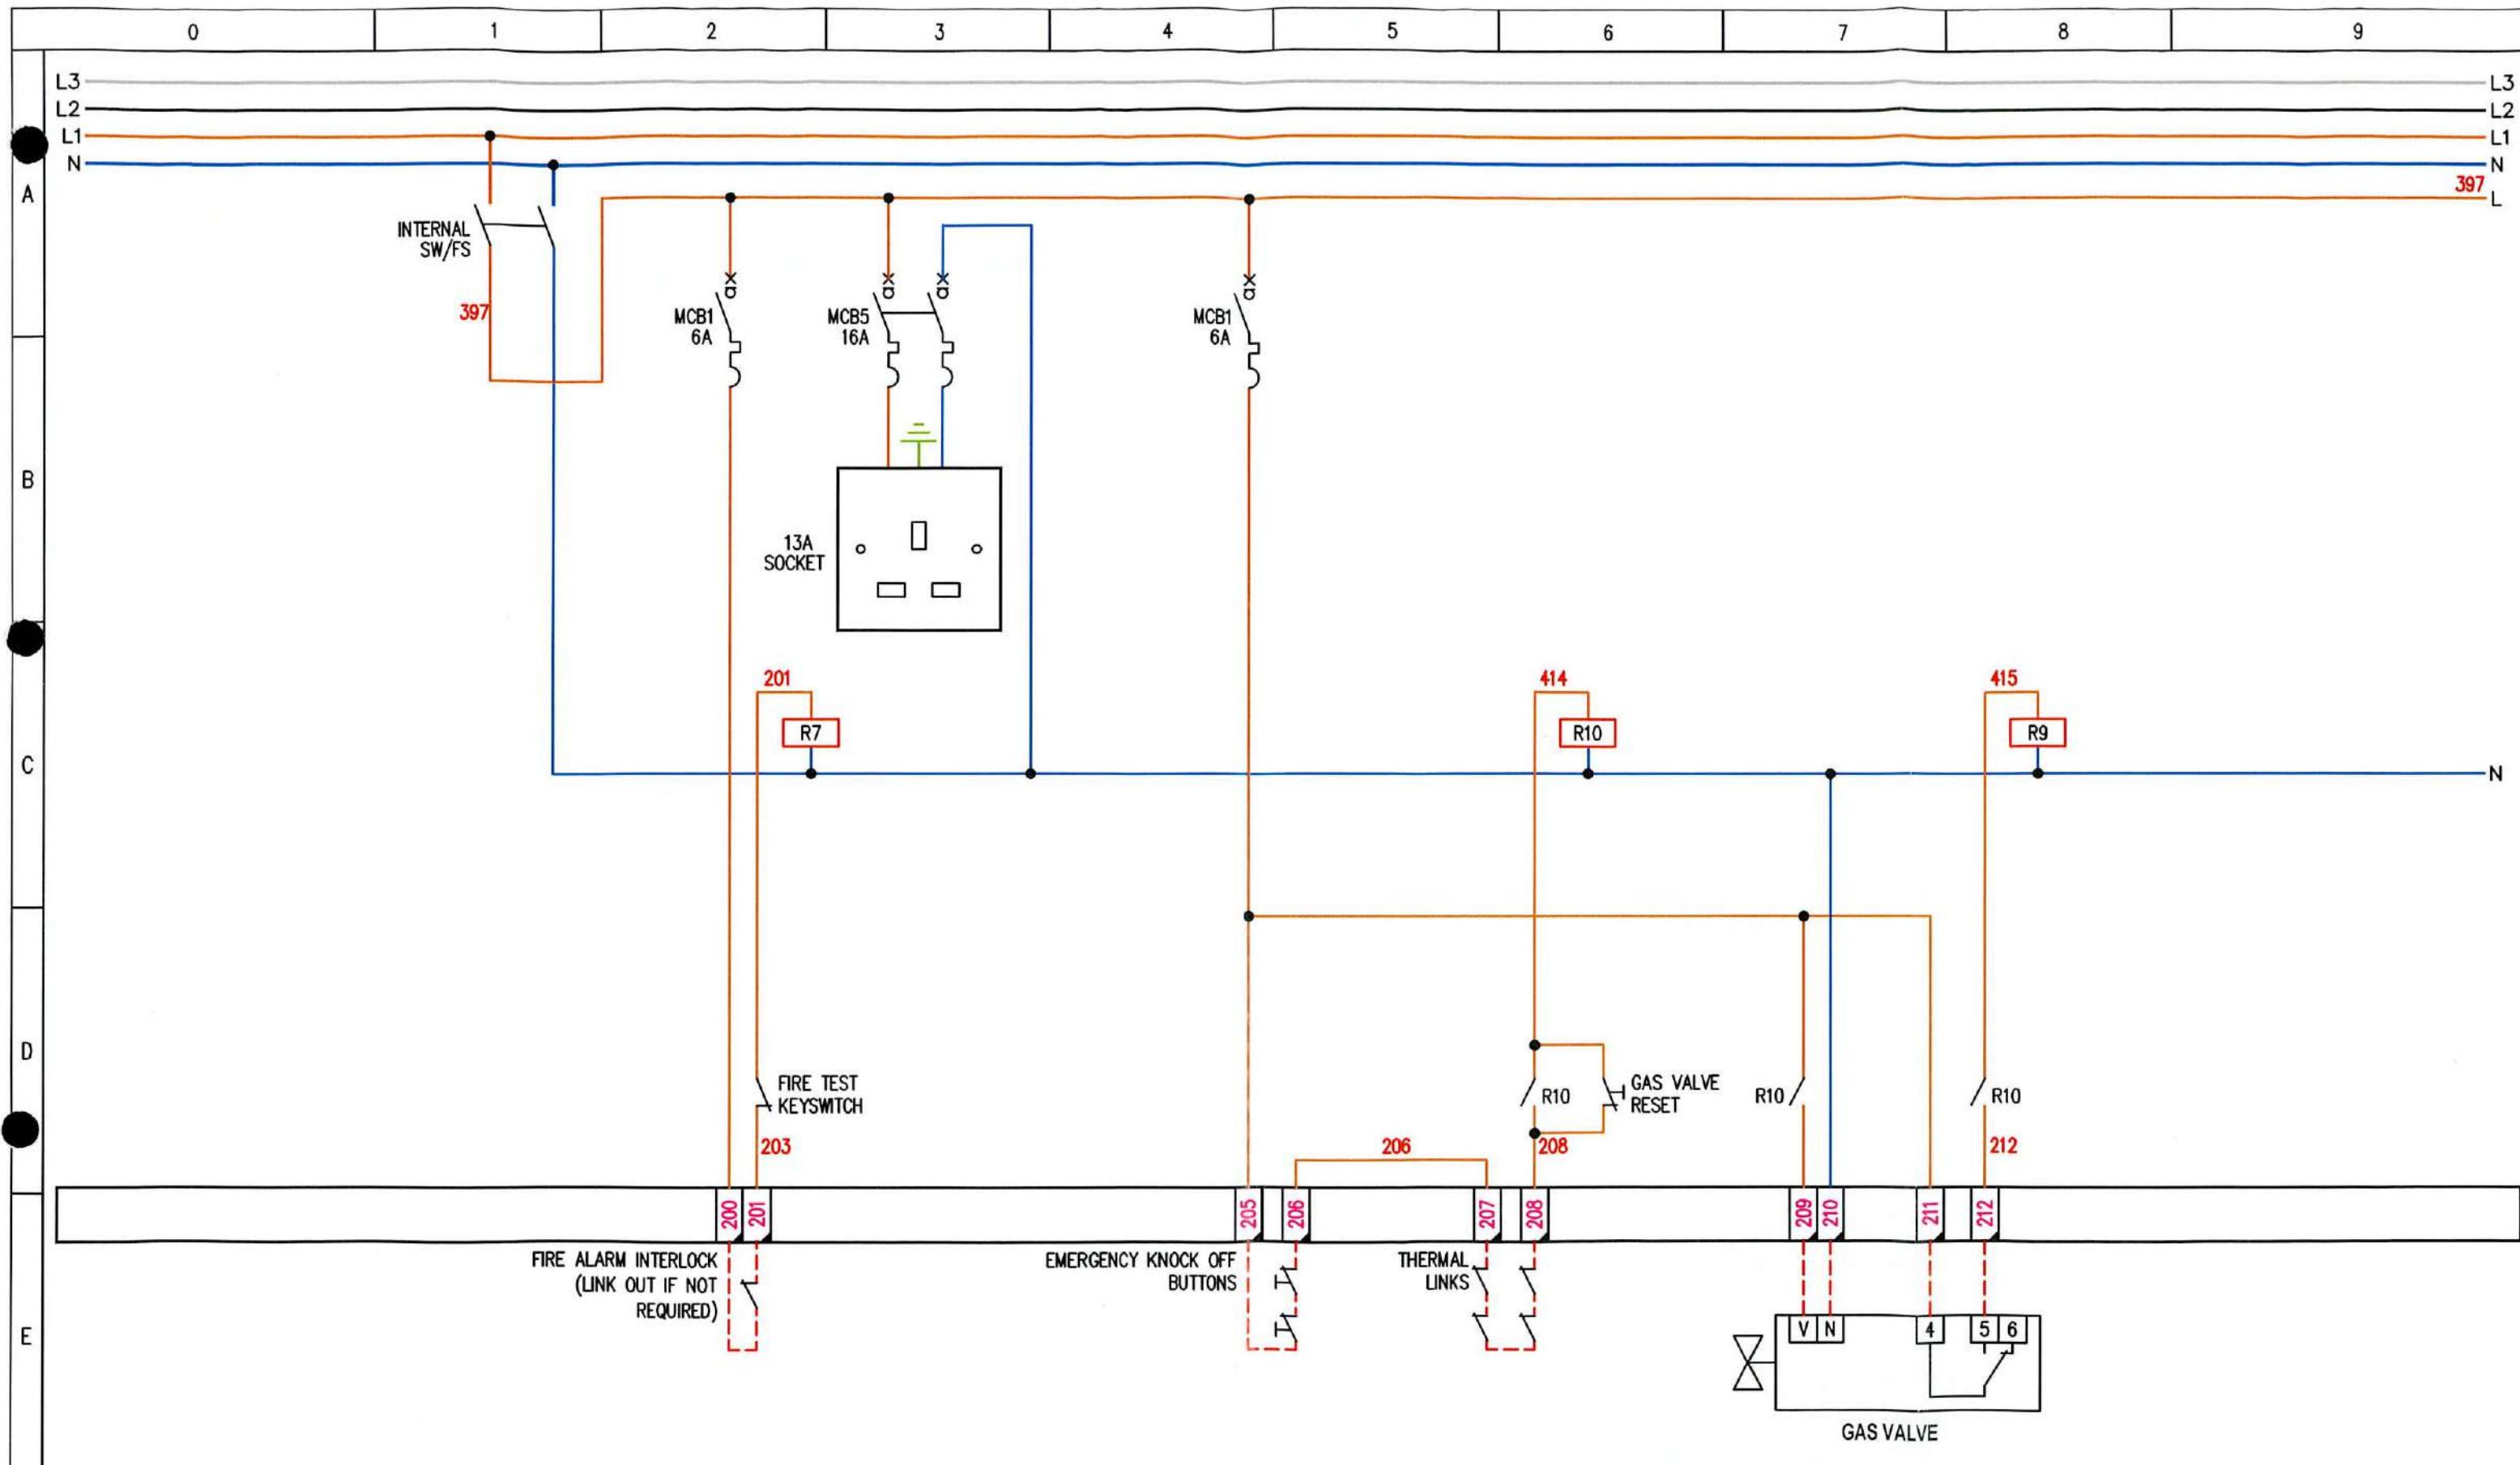

PROVISIONAL AS BUILT
 FOR APPROVAL AS FITTED
 ISSUED FOR CONSTRUCTION



REVISION No	DESCRIPTION OF REVISION	DRAWN BY	CHECKED BY	REVISION No
0	PROVISIONAL	RFD 28/04/21		4
1	APPROVAL	RFD 09/05/21		5
2				6
3				7

DESCRIPTION OF REVISION	STATUS	DRAWN BY	CHECKED BY


DRG No.6082-13 SHT. 9 of 20 REV 1
PROJECT No.6082

TITLE EXCHEQUER COURT

PANEL TITLE BOILERHOUSE PLANTROOM CONTROL PANEL

CLIENT

(C)

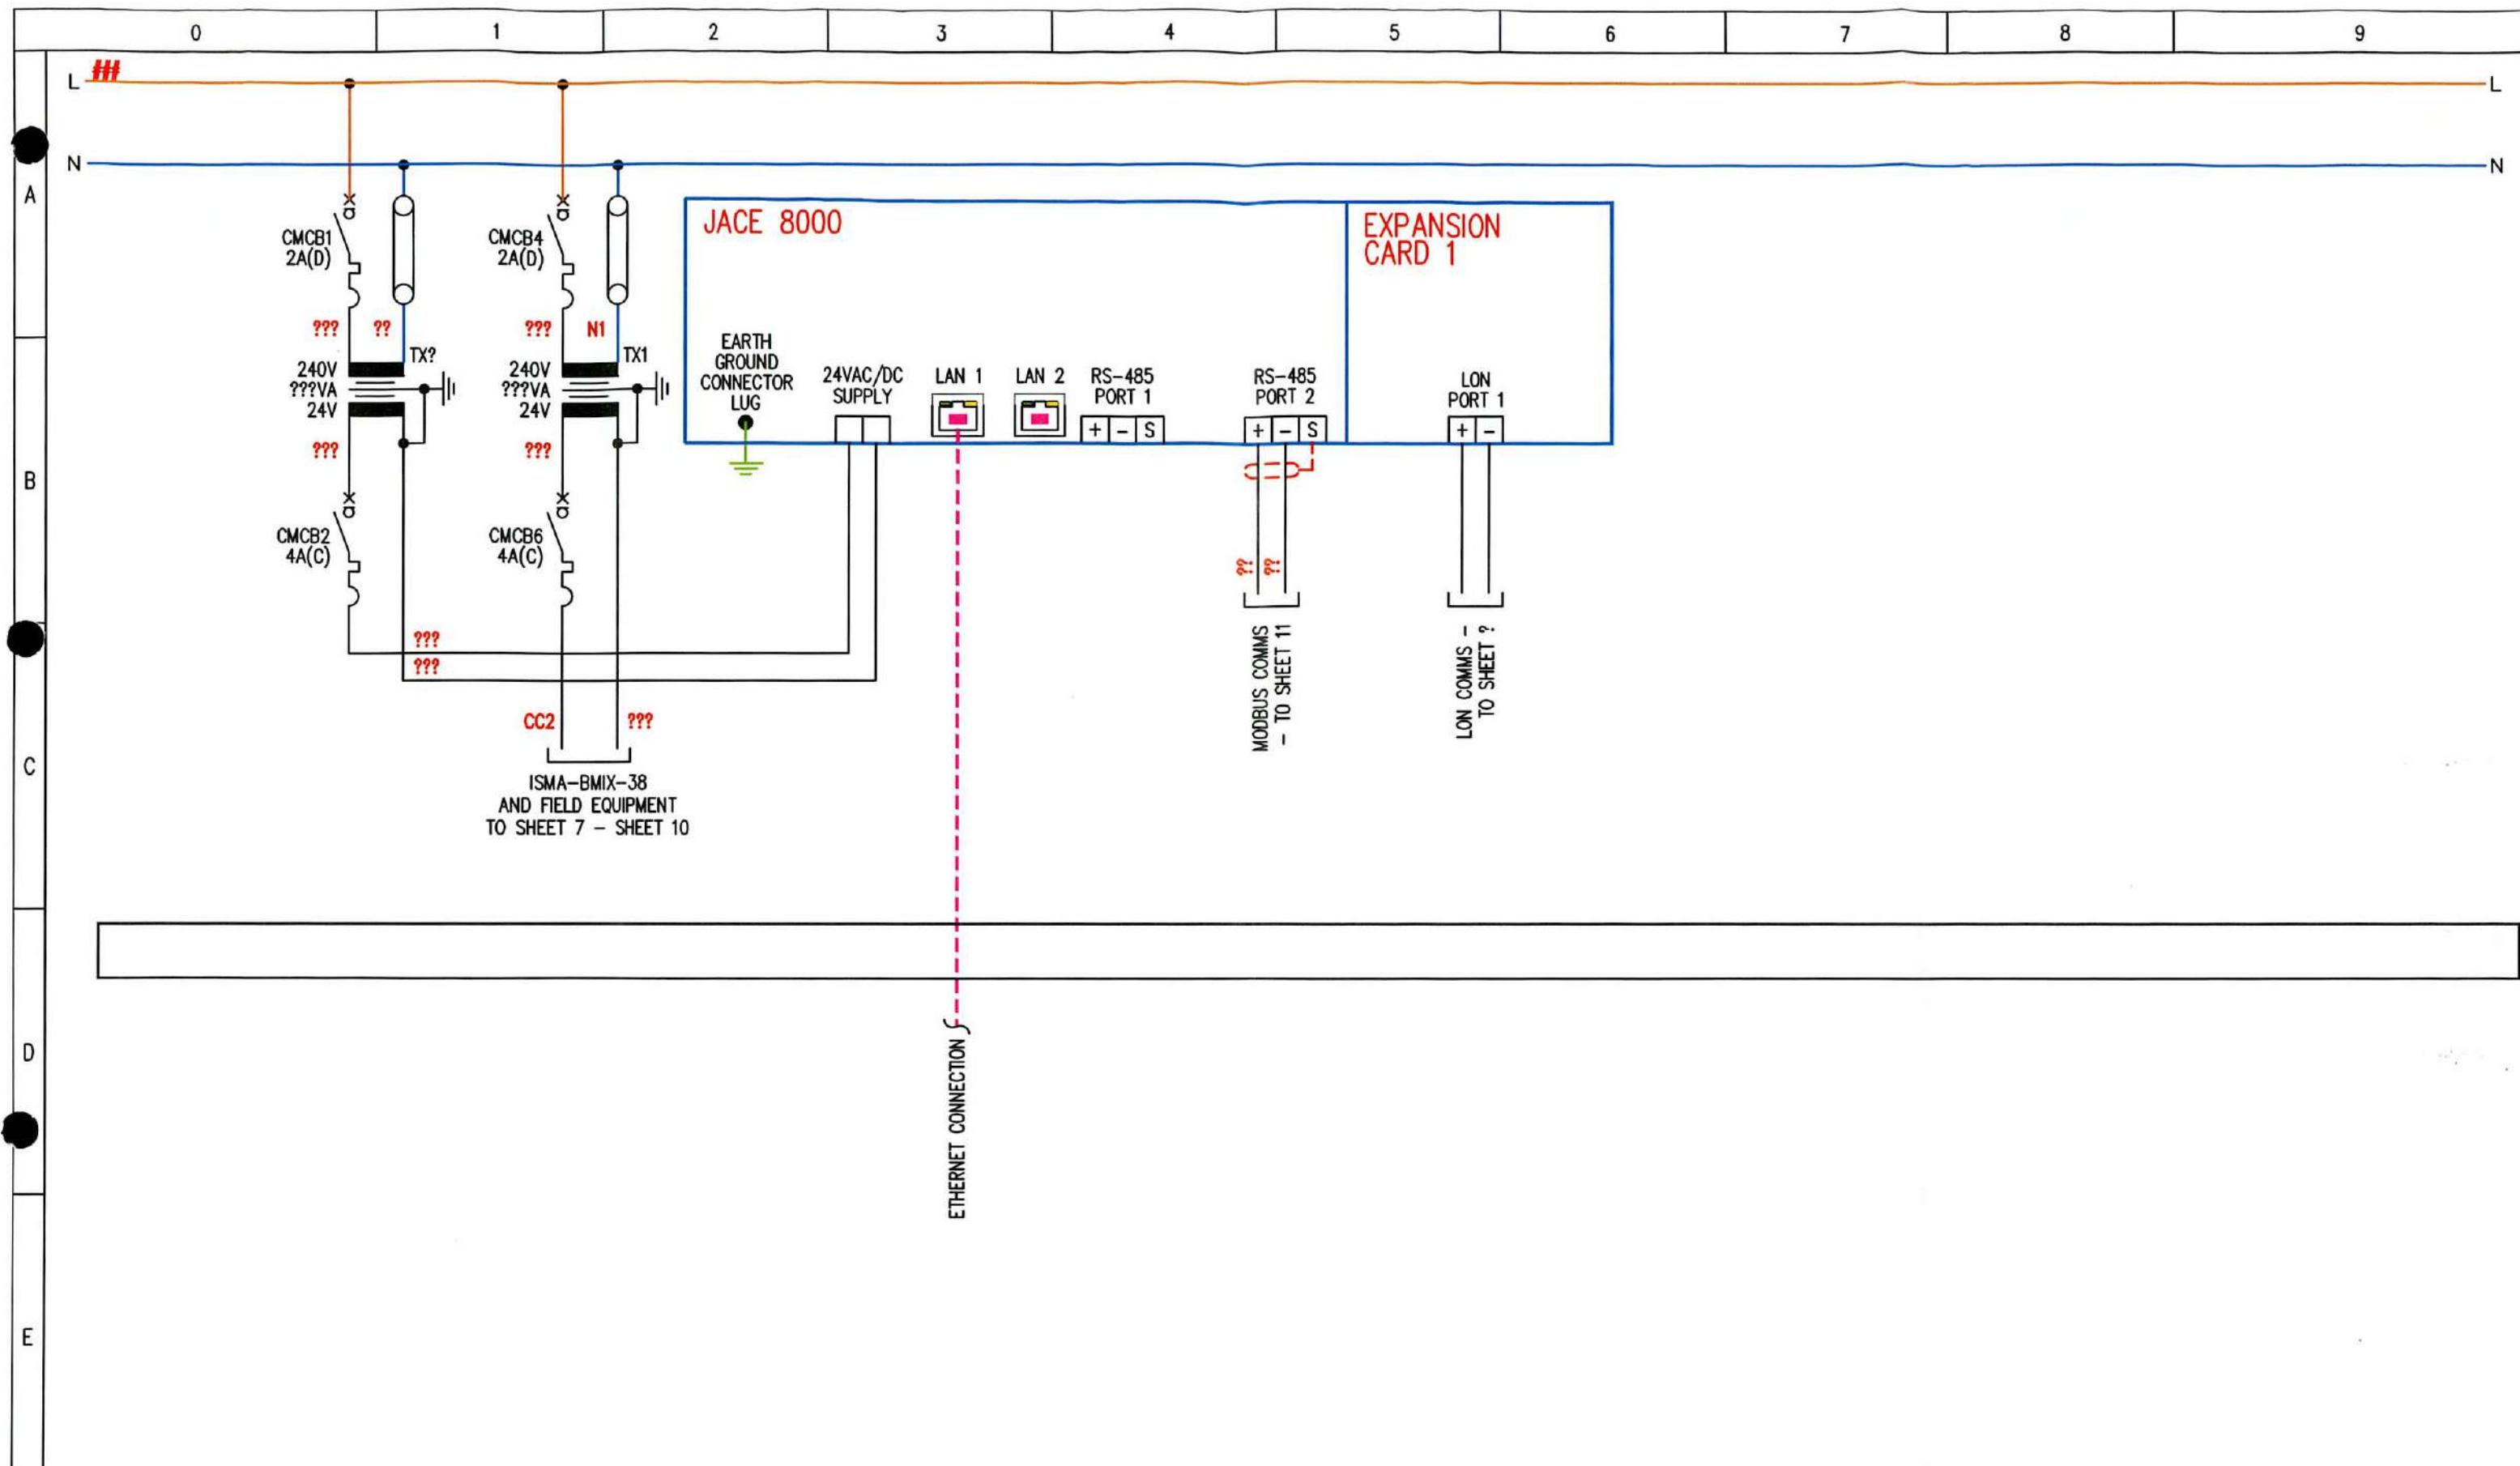

PROVISIONAL	AS BUILT	REVISION No	DESCRIPTION OF REVISION	DRAWN BY	CHECKED BY	REVISION No	DESCRIPTION OF REVISION	STATUS	DRAWN BY	CHECKED BY	DRG No.6082-13 SHT. 10 of 20 PROJECT No.6082	REV 1 ©
● FOR APPROVAL	○ AS FITTED	0	PROVISIONAL	RFD 28/04/21		4					TITLE EXCHEQUER COURT	
○ ISSUED FOR CONSTRUCTION		1	APPROVAL	RFD 09/05/21		5					PANEL TITLE BOILERHOUSE PLANTROOM CONTROL PANEL	
		2				6					CLIENT	
		3				7						

bgesgroup

SPARE PAGE
ANTICIPATED USE

A

B

C

D


E

PROVISIONAL AS BUILT
 FOR APPROVAL AS FITTED
 ISSUED FOR CONSTRUCTION



REVISION No	DESCRIPTION OF REVISION	DRAWN BY	CHECKED BY	REVISION No	DESCRIPTION OF REVISION	STATUS	DRAWN BY	CHECKED BY	DRG No.6082-13 SHT. 11 of 20 PROJECT No.6082	REV 1 ©
		DATE	DATE				DATE	DATE	TITLE	EXCHEQUER COURT
0	PROVISIONAL	RFD 28/04/21		4					PANEL TITLE	BOILERHOUSE PLANTROOM CONTROL PANEL
1	APPROVAL	RFD 09/05/21		5					CLIENT	
2				6						
3				7						

0 1 2 3 4 5 6 7 8 9

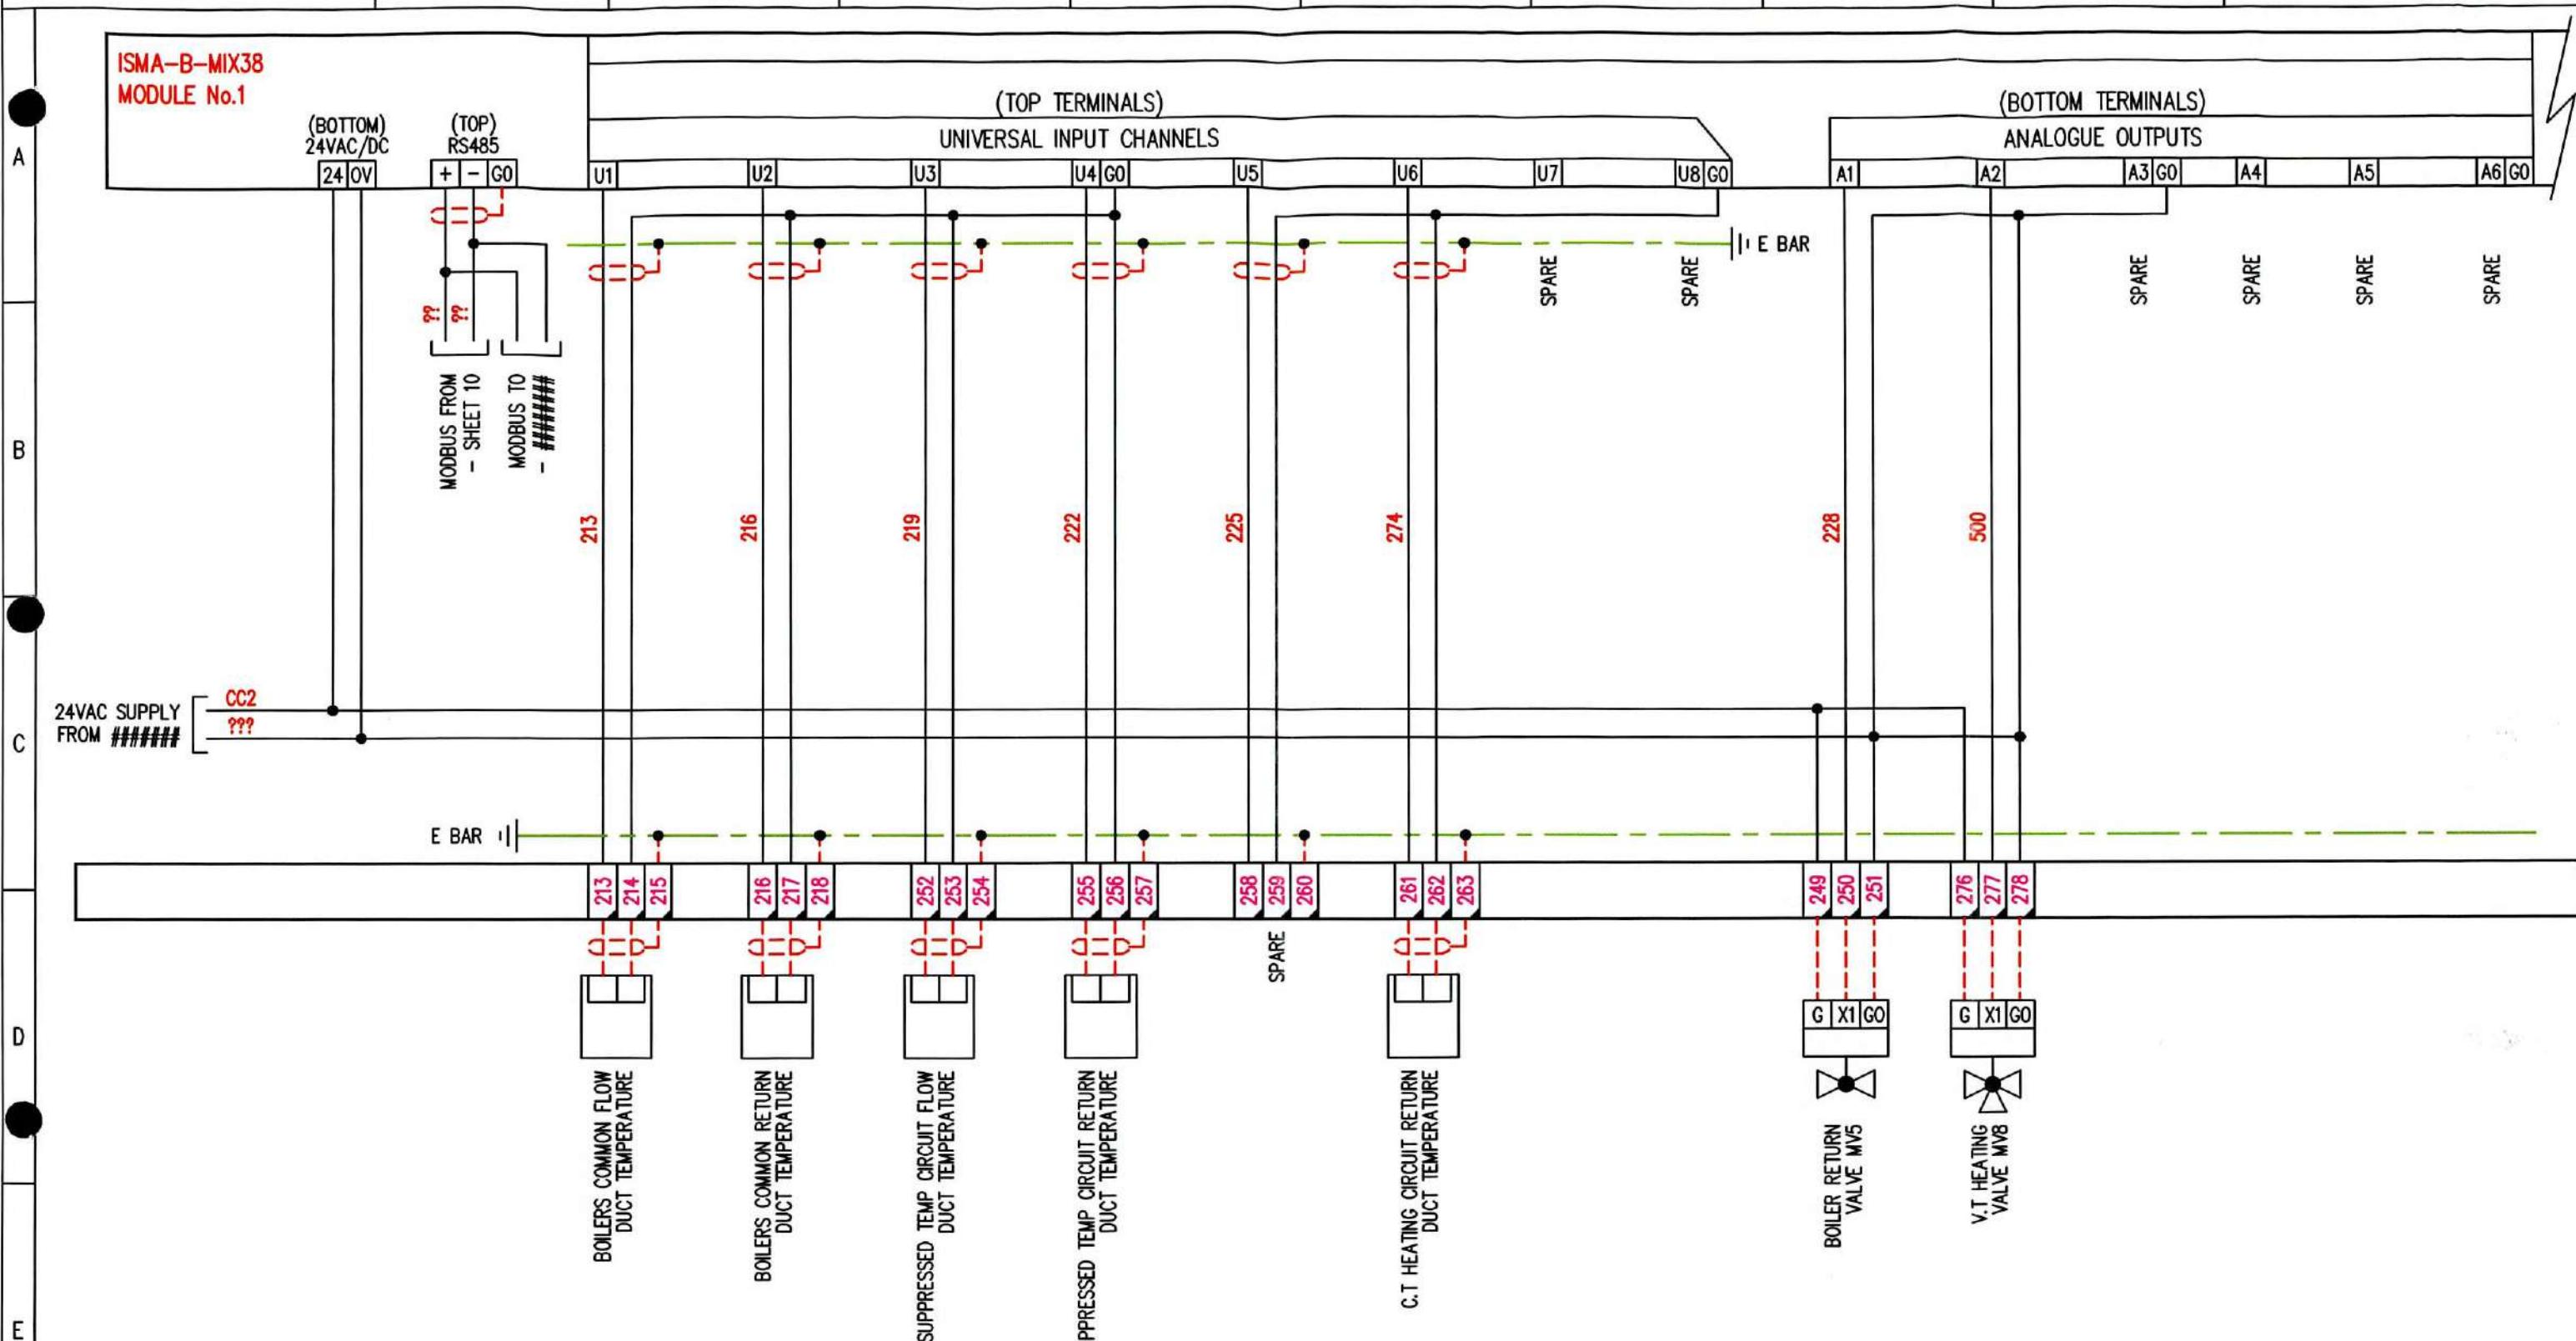

● PROVISIONAL ○ AS BUILT
● FOR APPROVAL ○ AS FITTED
○ ISSUED FOR CONSTRUCTION


REVISION No	DESCRIPTION OF REVISION	DRAWN BY DATE	CHECKED BY DATE	REVISION No	DESCRIPTION OF REVISION	STATUS	DRAWN BY DATE	CHECKED BY DATE	DRG No.6082-13 SHT. 12 of 20 PROJECT No.6082	REV 1 ©
0	PROVISIONAL	RFD 28/04/21		4					TITLE	EXCHEQUER COURT
1	APPROVAL	RFD 09/05/21		5					PANEL TITLE	BOILERHOUSE PLANTROOM CONTROL PANEL
2				6					CLIENT	
3				7						

0 1 2 3 4 5 6 7 8 9


ISMA-B-MIX38
MODULE No.1

(TOP TERMINALS)
DIGITAL INPUT CHANNELS


I1 I2 I3 I4 G0 I5 I6 I7 I8 G0 I9 I10 I11 I12 G0

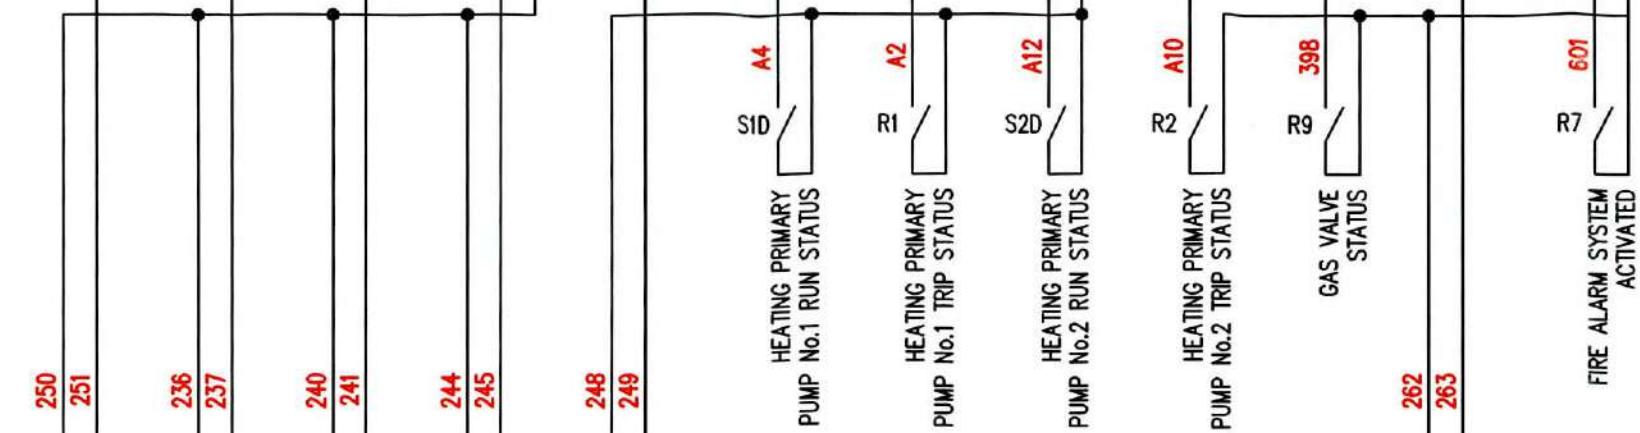


E BAR

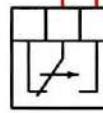


BOILER WATER
FLOW STATUS
DUCT DP
SWITCH

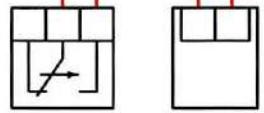


BOILER No.1
LOCKOUT

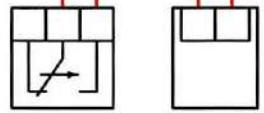


BOILER No.2
LOCKOUT

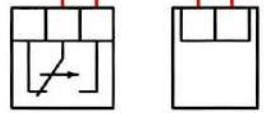

BOILER No.3
LOCKOUT

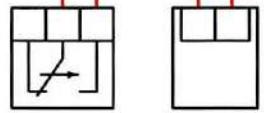

BOILER No.4
LOCKOUT

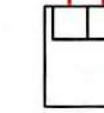

DRAINAGE PUMP
HIGH LEVEL

● PROVISIONAL ○ AS BUILT
● FOR APPROVAL ○ AS FITTED
○ ISSUED FOR
CONSTRUCTION




REVISION No	DESCRIPTION OF REVISION	DRAWN BY DATE	CHECKED BY DATE	REVISION No
0	PROVISIONAL	RFD 28/04/21		4
1	APPROVAL	RFD 09/05/21		5
2				6
3				7


DESCRIPTION OF REVISION	STATUS	DRAWN BY DATE	CHECKED BY DATE

DRG No.6082-13 PROJECT No.6082	SHT. 13 of 20
REV 1 ©	
TITLE	EXCHEQUER COURT
PANEL TITLE	BOILERHOUSE PLANTROOM CONTROL PANEL
CLIENT	

0 1 2 3 4 5 6 7 8 9

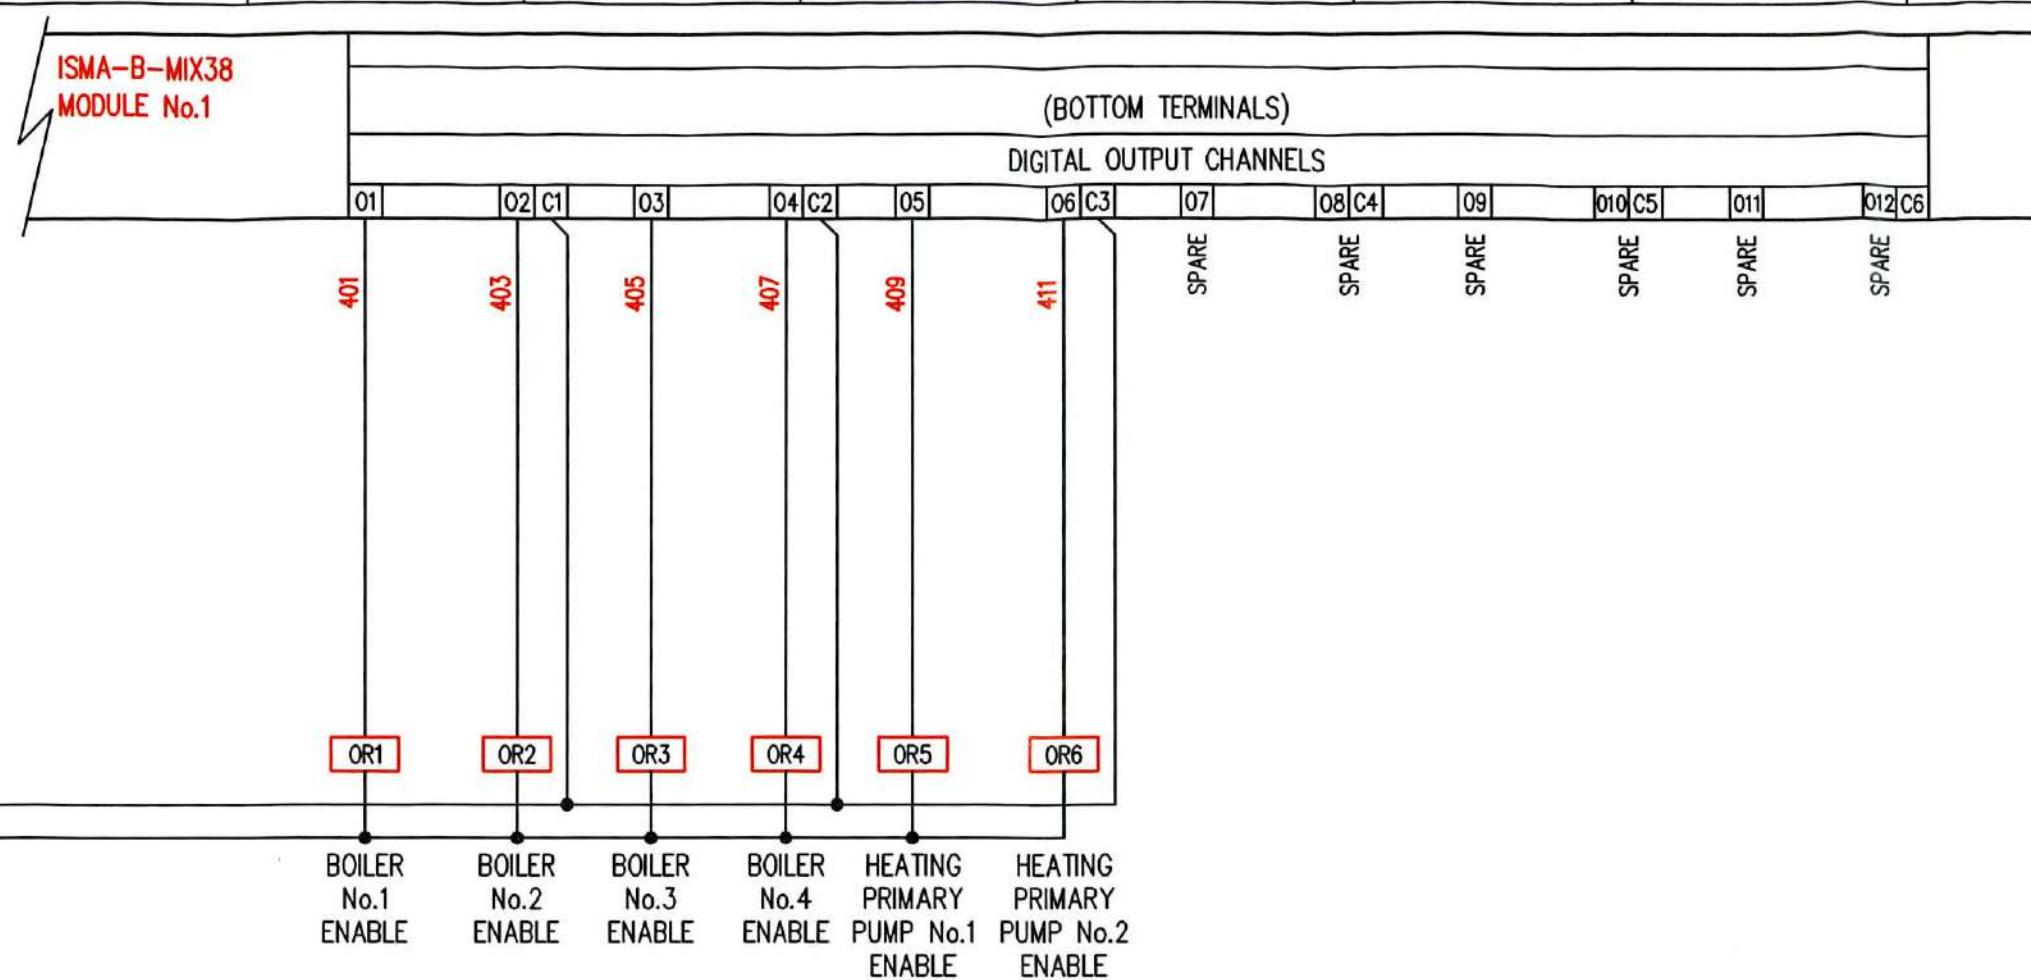


● PROVISIONAL ● FOR APPROVAL ● ISSUED FOR CONSTRUCTION	○ AS BUILT ○ AS FITTED	REVISION No	DESCRIPTION OF REVISION	DRAWN BY DATE	CHECKED BY DATE	REVISION No	DESCRIPTION OF REVISION	STATUS	DRAWN BY DATE	CHECKED BY DATE	DRG No.6082-13 PROJECT No.6082	SHT. 14 of 20	REV 1 ©
		0	PROVISIONAL	RFD 28/04/21		4					TITLE	EXCHEQUER COURT	
		1	APPROVAL	RFD 09/05/21		5					PANEL TITLE	BOILERHOUSE PLANTROOM CONTROL PANEL	
		2				6					CLIENT		
		3				7							

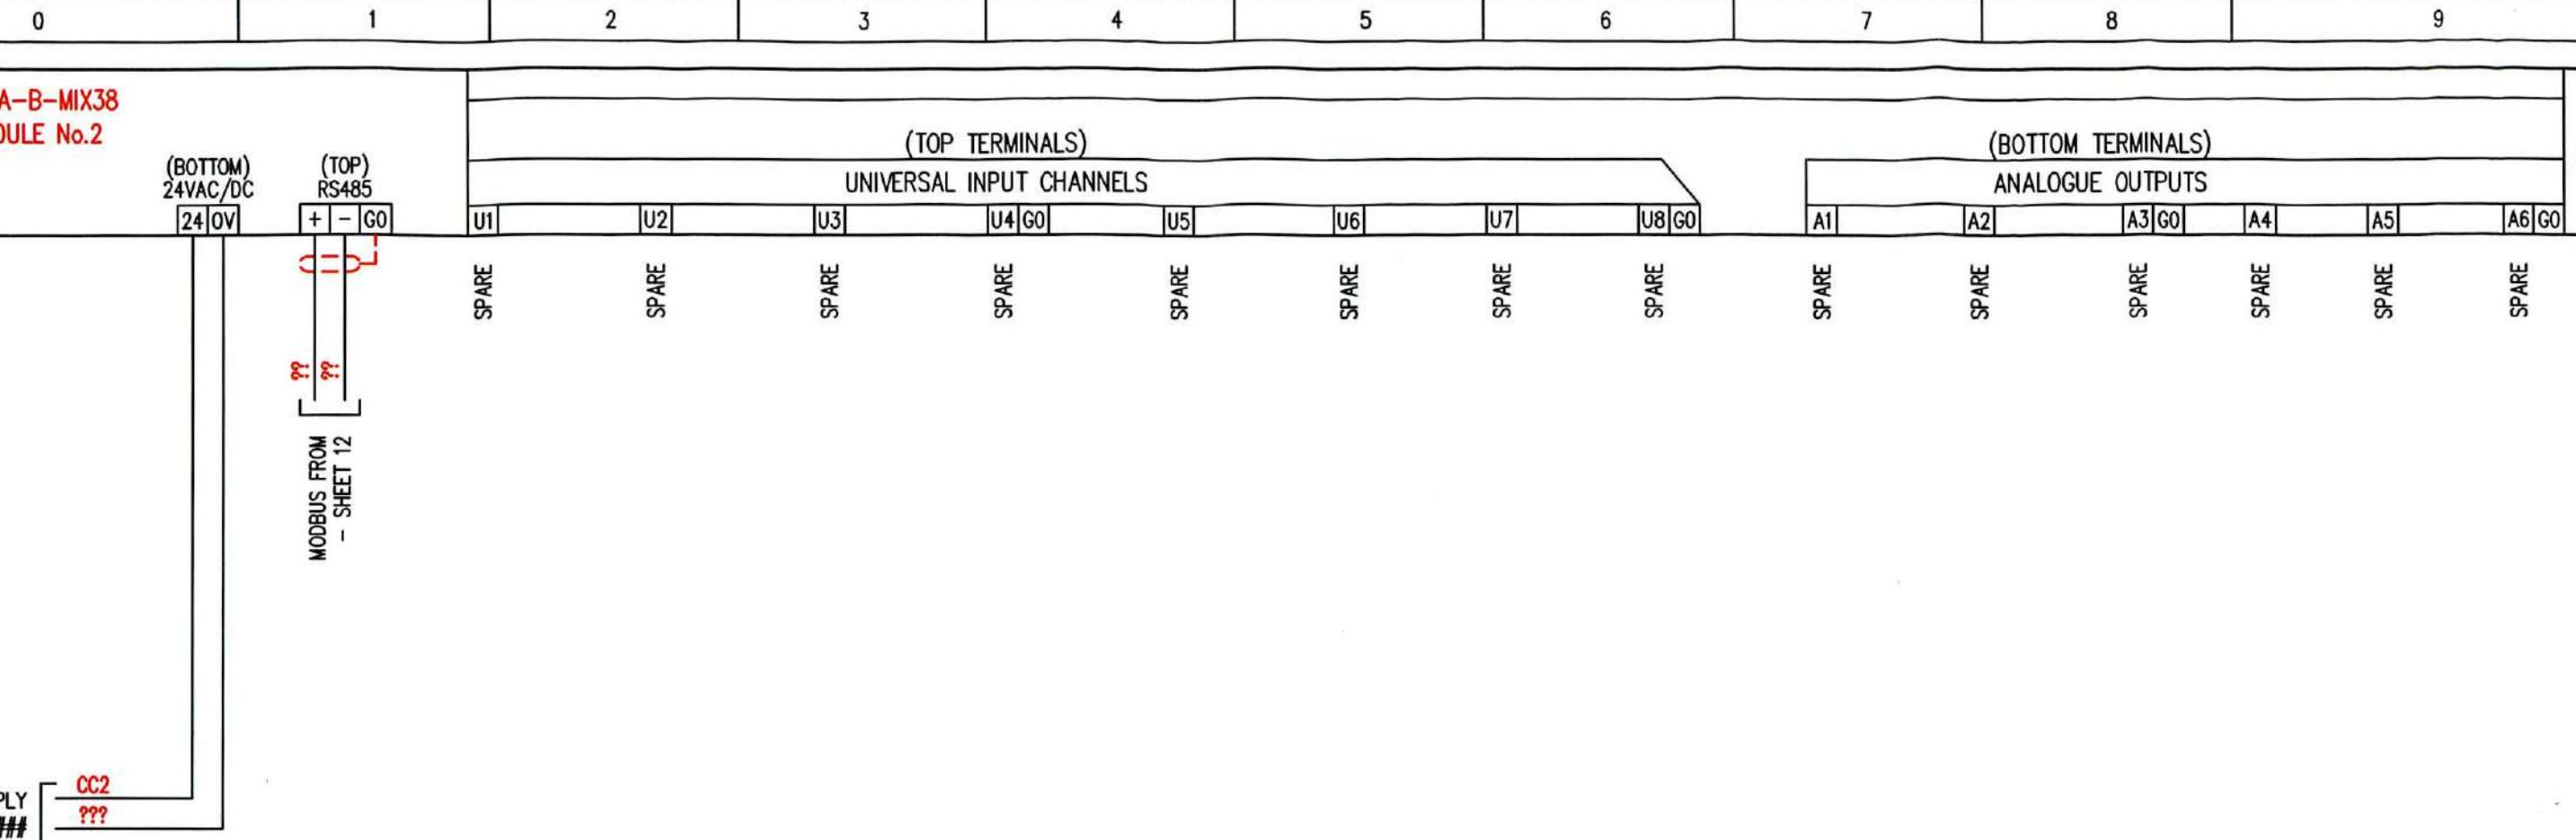

<input checked="" type="radio"/> PROVISIONAL <input checked="" type="radio"/> FOR APPROVAL <input type="radio"/> ISSUED FOR CONSTRUCTION		<input type="radio"/> AS BUILT <input type="radio"/> AS FITTED		REVISION No	DESCRIPTION OF REVISION		DRAWN BY DATE	CHECKED BY DATE	REVISION No	DESCRIPTION OF REVISION		STATUS	DRAWN BY DATE	CHECKED BY DATE	DRG No.6082-13 SHT. 15 of 20 PROJECT No.6082		
0	PROVISIONAL	RFD 28/04/21		4											TITLE	EXCHEQUER COURT	
1	APPROVAL	RFD 09/05/21		5											PANEL TITLE	BOILERHOUSE PLANTROOM CONTROL PANEL	
2				6											CLIENT		
3				7													




0 1 2 3 4 5 6 7 8 9

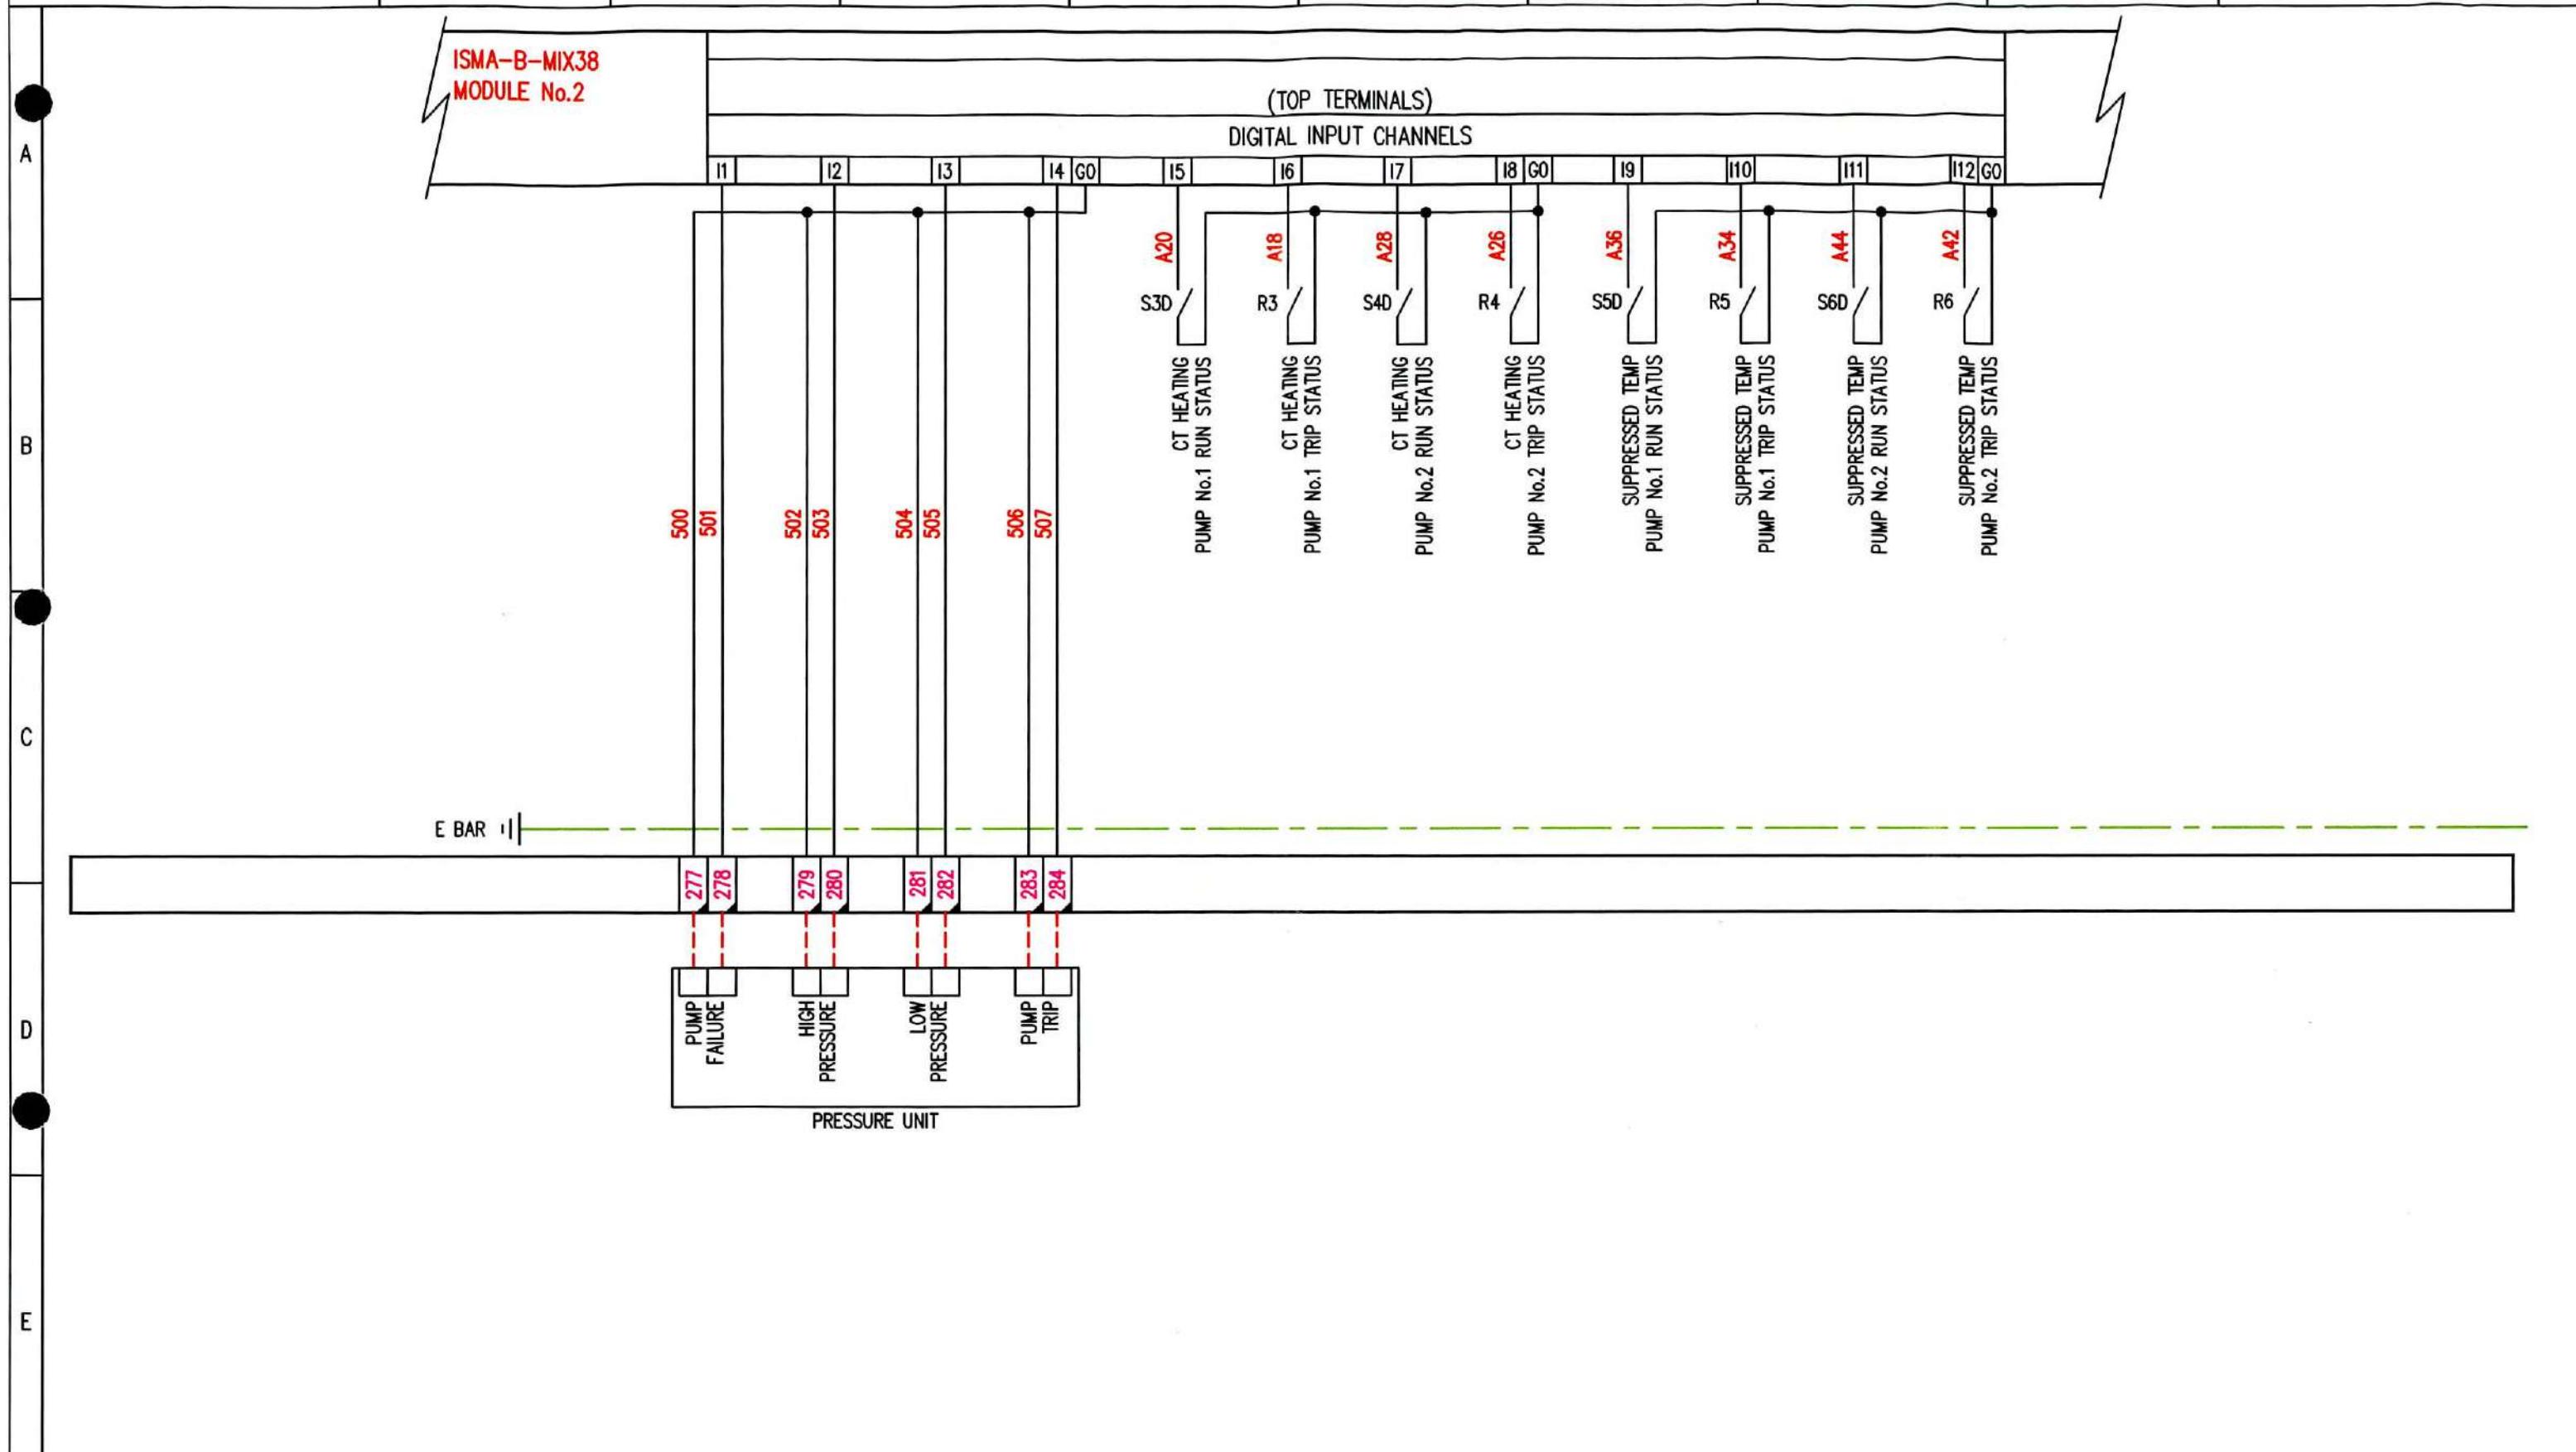

● PROVISIONAL ● FOR APPROVAL ○ ISSUED FOR CONSTRUCTION	○ AS BUILT ○ AS FITTED	REVISION No	DESCRIPTION OF REVISION	DRAWN BY DATE	CHECKED BY DATE	REVISION No	DESCRIPTION OF REVISION	STATUS	DRAWN BY DATE	CHECKED BY DATE	DRG No.6082-13 PROJECT No.6082	SHT. 16 of 20	REV 1 ©
		0	PROVISIONAL	RFD 28/04/21		4					TITLE	EXCHEQUER COURT	
		1	APPROVAL	RFD 09/05/21		5					PANEL TITLE	BOILERHOUSE PLANTROOM CONTROL PANEL	
		2				6					CLIENT		
		3				7							

0 1 2 3 4 5 6 7 8 9

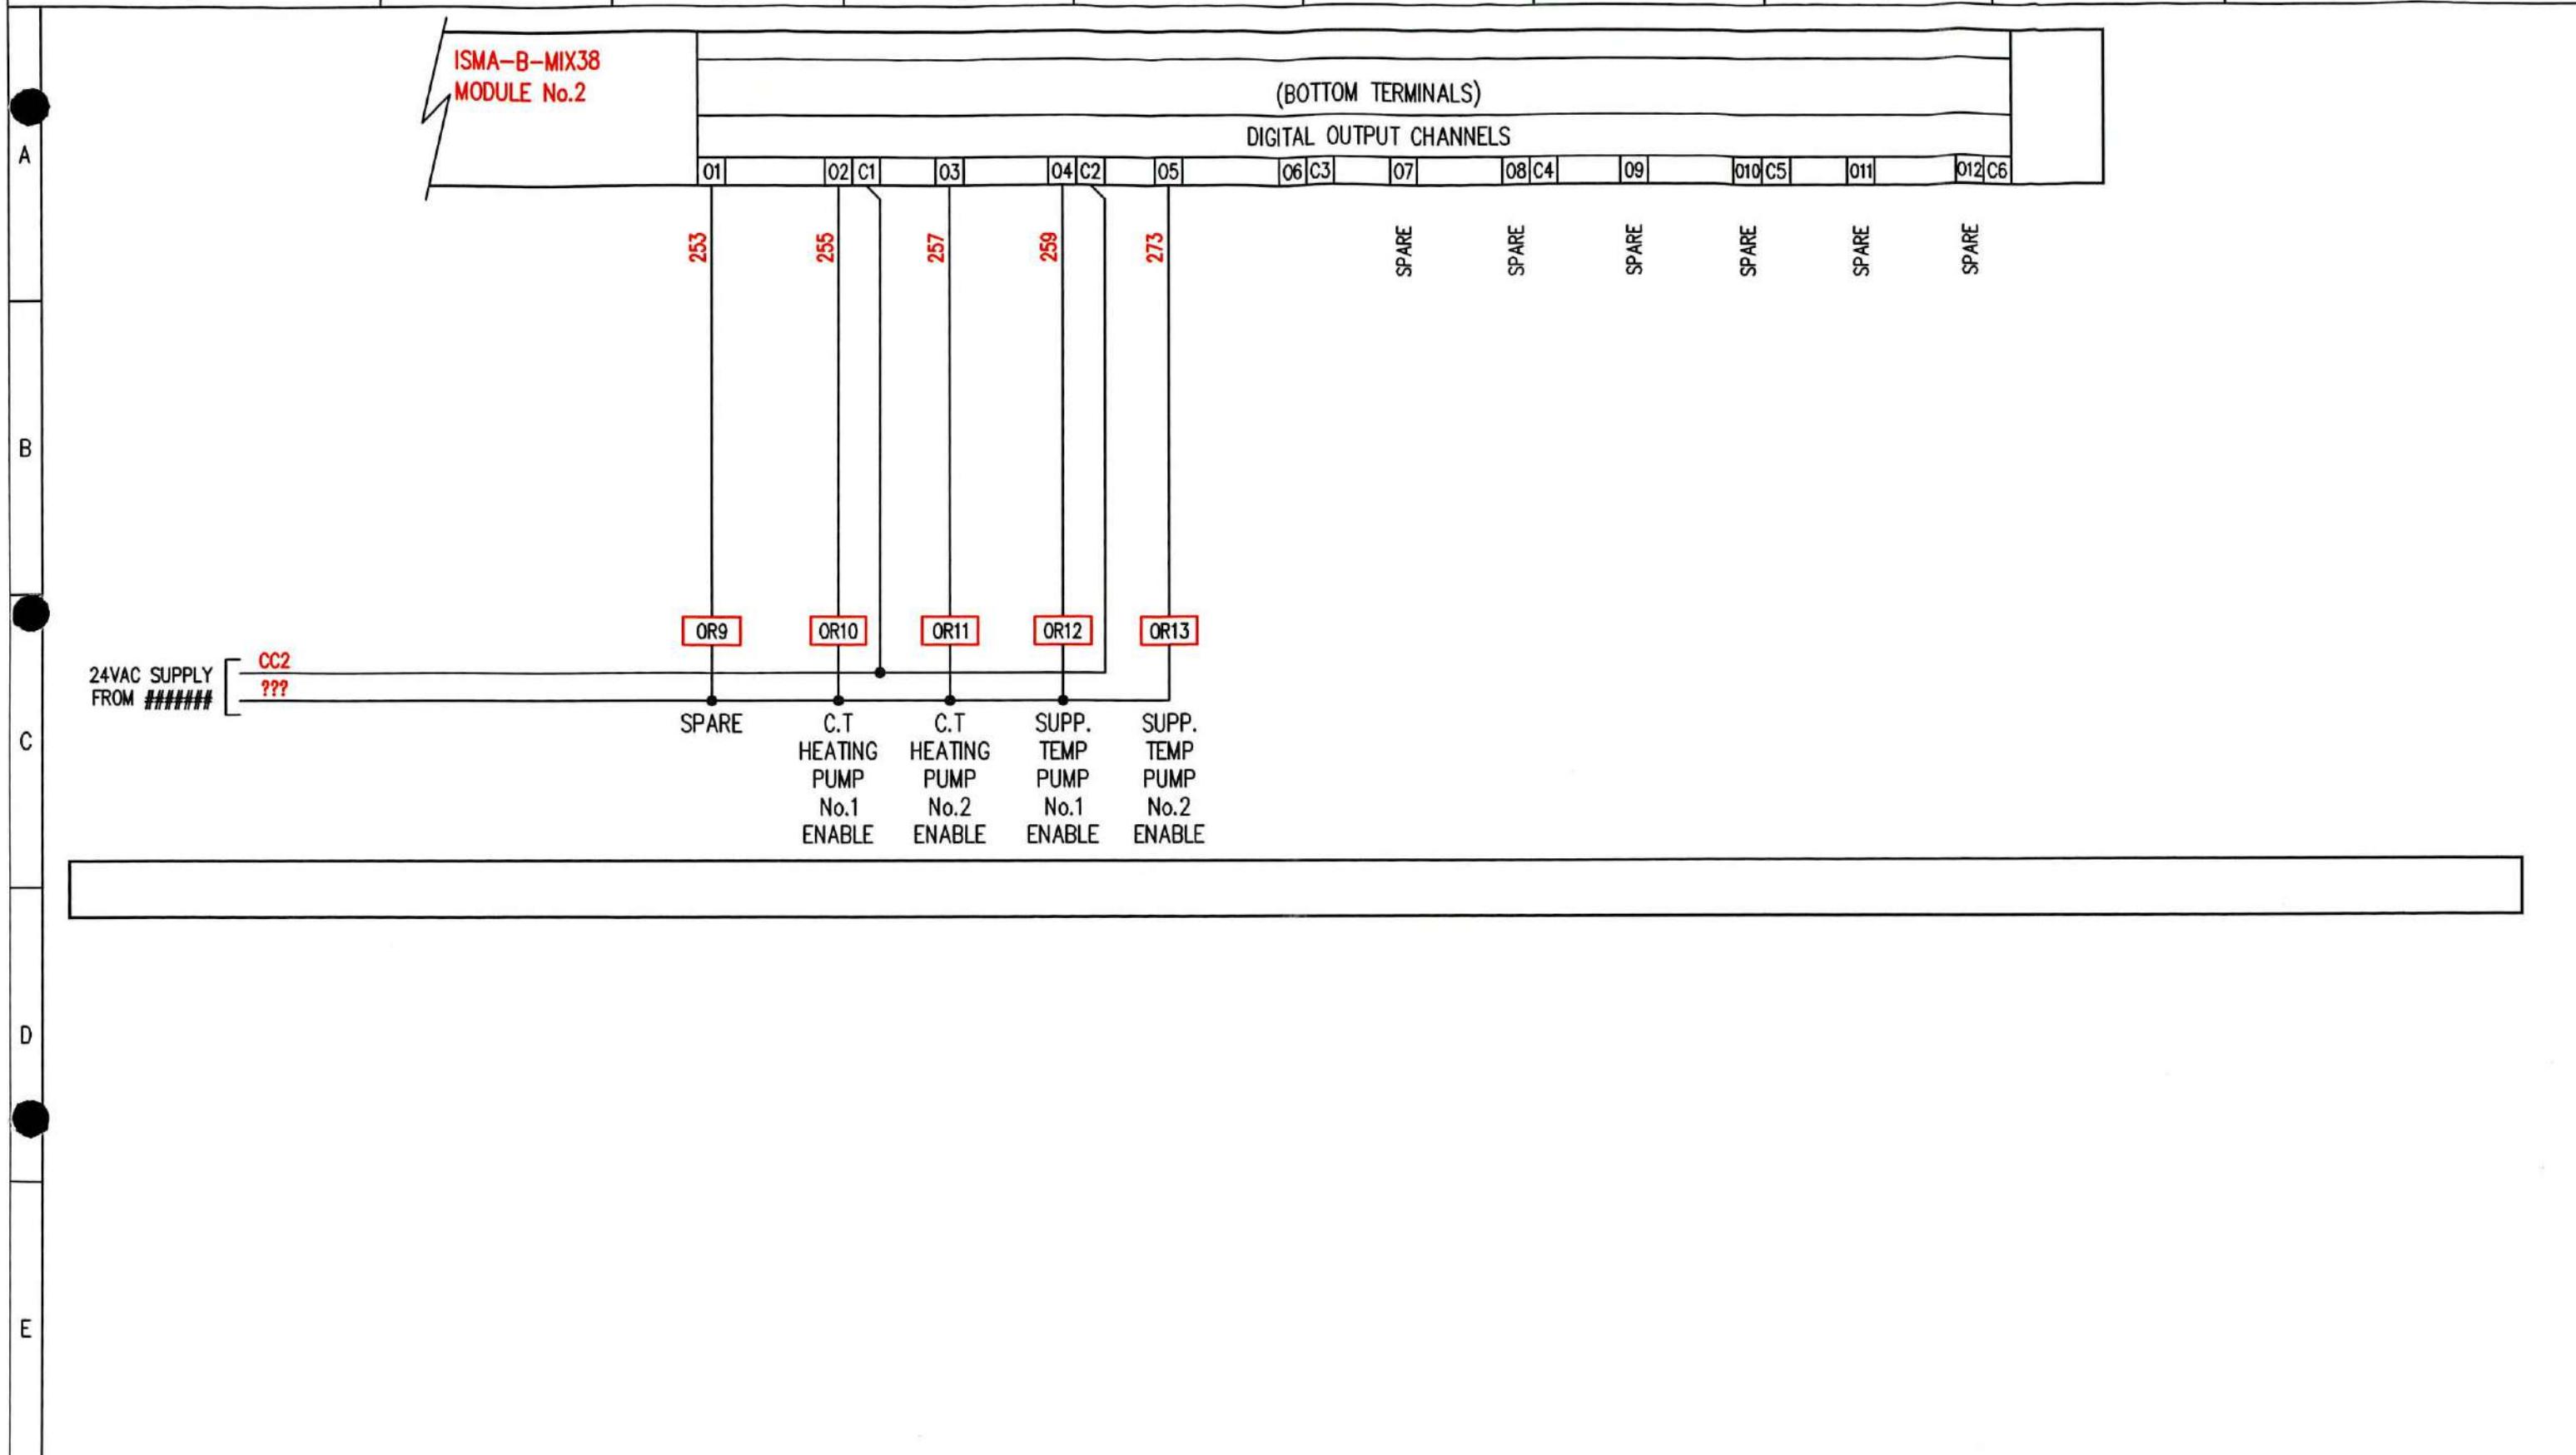

● PROVISIONAL ● FOR APPROVAL ○ ISSUED FOR CONSTRUCTION	○ AS BUILT ○ AS FITTED	REVISION No	DESCRIPTION OF REVISION	DRAWN BY DATE	CHECKED BY DATE	REVISION No	DESCRIPTION OF REVISION	STATUS	DRAWN BY DATE	CHECKED BY DATE	DRG No.6082-13 PROJECT No.6082	SHT. 17 of 20	REV 1 ©
		0	PROVISIONAL	RFD 28/04/21		4							
		1	APPROVAL	RFD 09/05/21		5							
		2				6							
		3				7							

bges group

SPARE PAGE ANTICIPATED USE

A

E


C

D

E

		DESCRIPTION OF REVISION				DESCRIPTION OF REVISION				DRG No.6082-13 SHT. 18 of 20 PROJECT No.6082			
		REVISION No	DESCRIPTION OF REVISION		DRAWN BY DATE	CHECKED BY DATE	REVISION No	DESCRIPTION OF REVISION		STATUS	DRAWN BY DATE	CHECKED BY DATE	REV 1 ©
<input checked="" type="radio"/>	PROVISIONAL	<input type="radio"/>	AS BUILT										
<input checked="" type="radio"/>	FOR APPROVAL	<input type="radio"/>	AS FITTED										
<input type="radio"/>	ISSUED FOR CONSTRUCTION												
		0	PROVISIONAL		RFD 28/04/21		4						TITLE EXCHEQUER COURT
		1	APPROVAL		RFD 09/05/21		5						PANEL TITLE BOILERHOUSE PLANTROOM CONTROL PANEL
		2					6						
		3					7						CLIENT

0	1	2	3	4	5	6	7	8	9
---	---	---	---	---	---	---	---	---	---

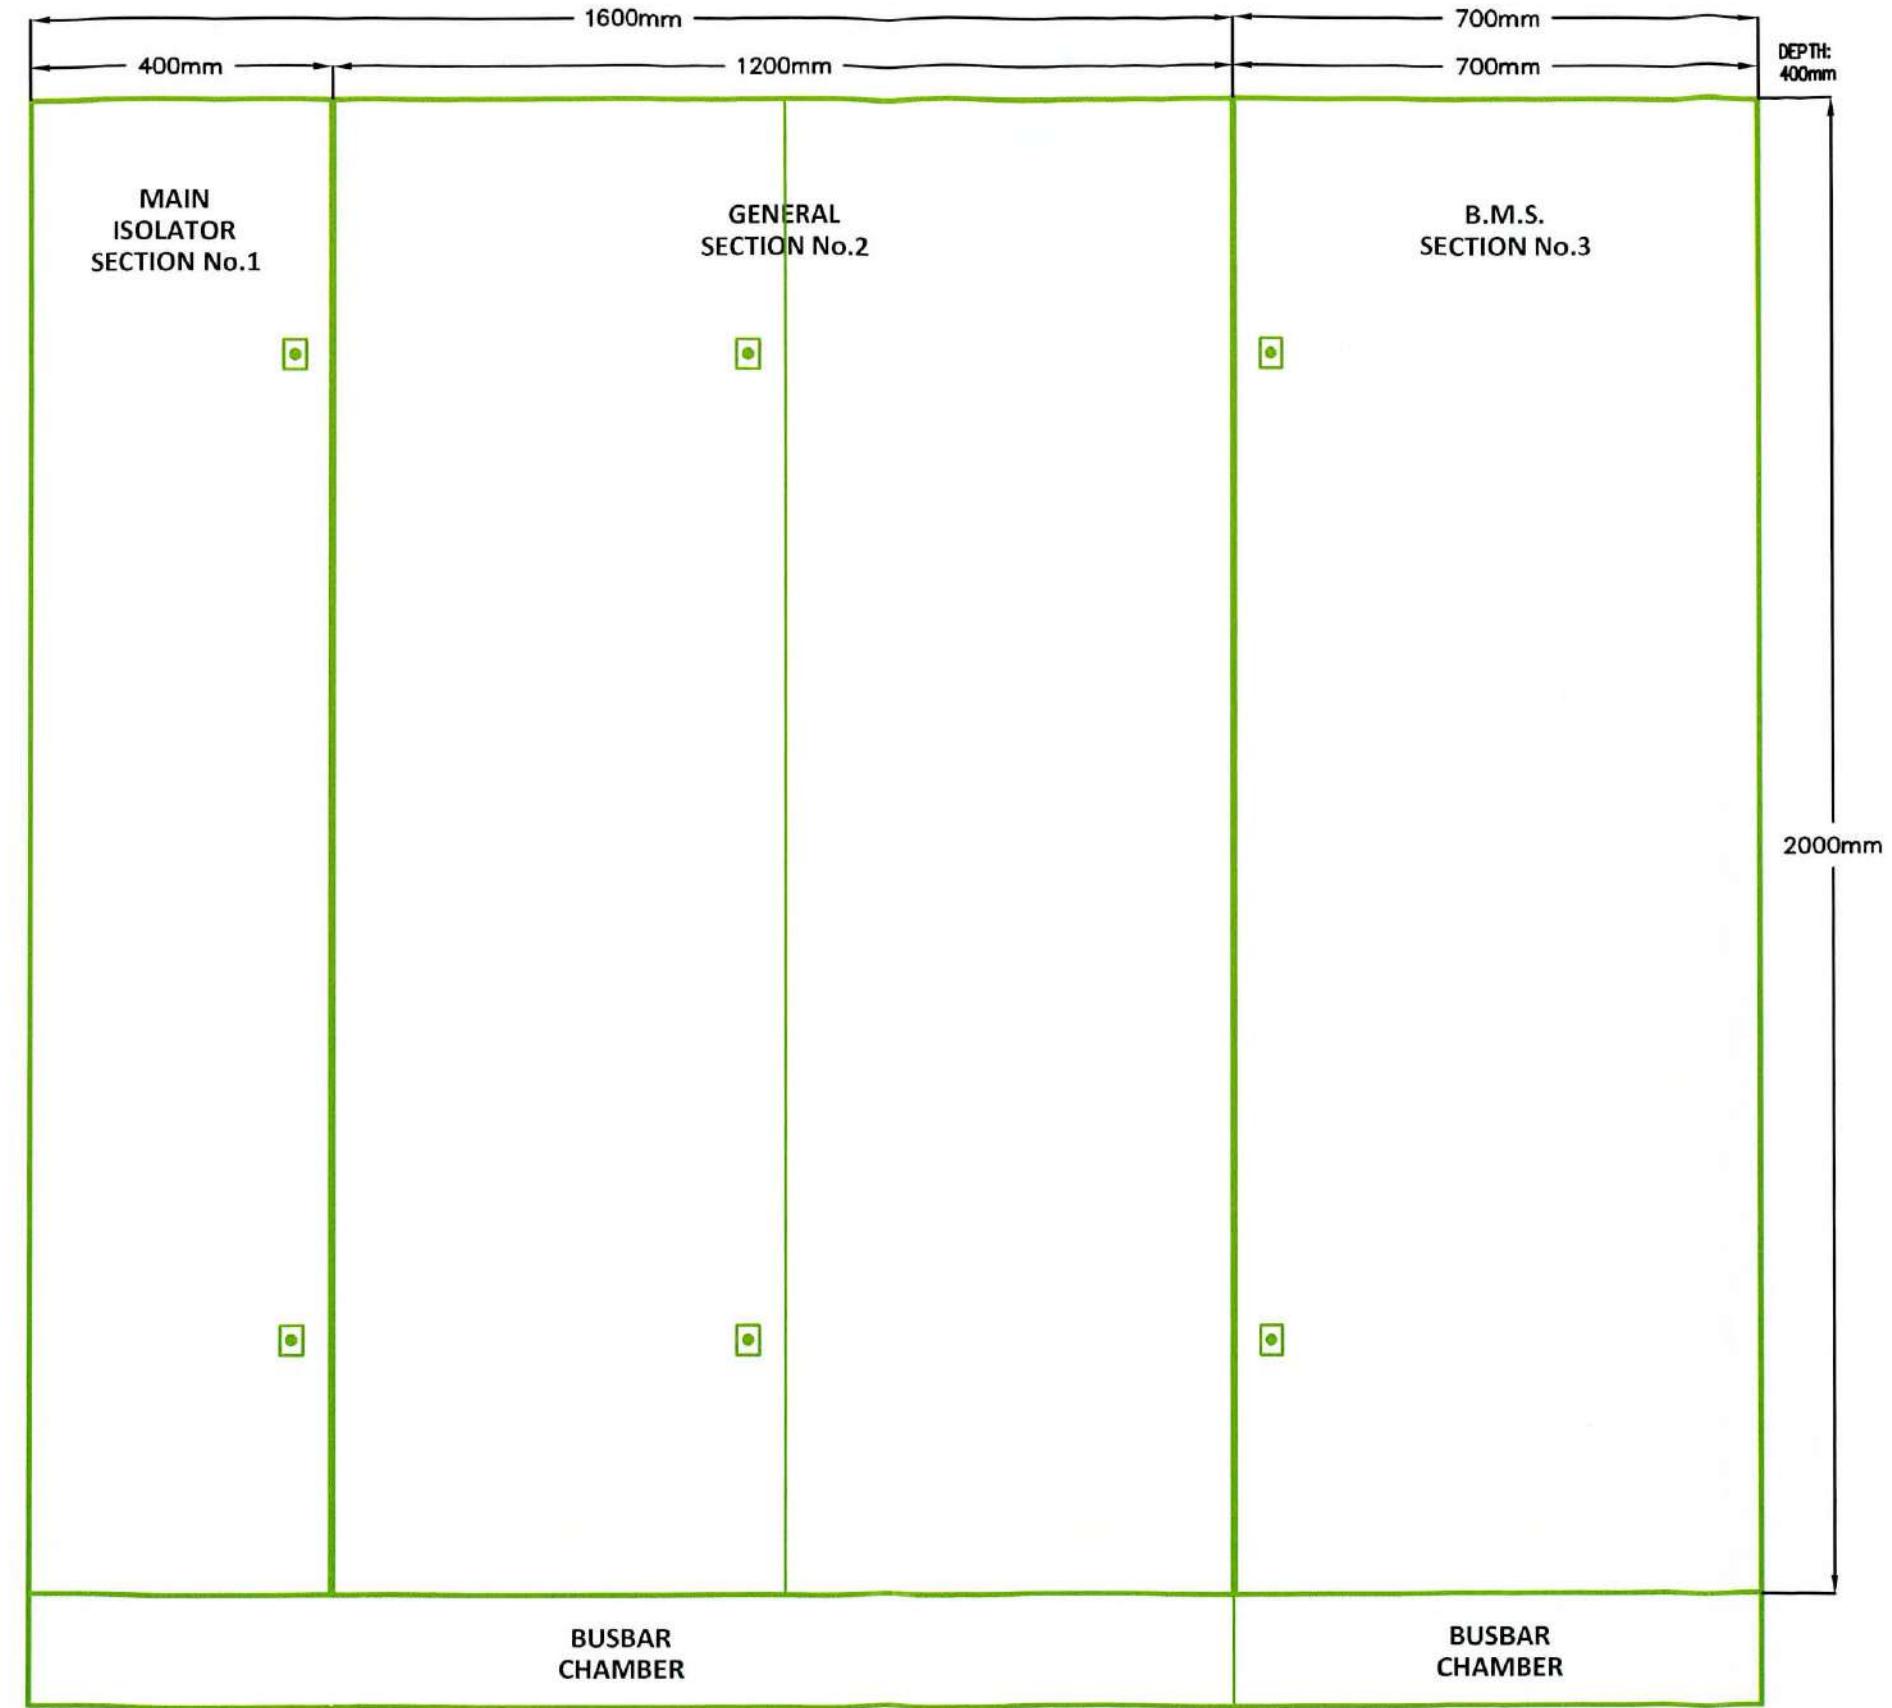

PROVISIONAL AS BUILT
 FOR APPROVAL AS FITTED
 ISSUED FOR CONSTRUCTION



REVISION No	DESCRIPTION OF REVISION	DRAWN BY DATE	CHECKED BY DATE	REVISION No	DESCRIPTION OF REVISION	STATUS	DRAWN BY DATE	CHECKED BY DATE	DRG No.6082-13 PROJECT No.6082	SHT. 19 of 20	REV 1 ©
0	PROVISIONAL	RFD 28/04/21		4							
1	APPROVAL	RFD 09/05/21		5							
2				6							
3				7							
									TITLE	EXCHEQUER COURT	
									PANEL TITLE	BOILERHOUSE PLANTROOM CONTROL PANEL	
									CLIENT		

SPARE PAGE
ANTICIPATED USE

A

B

C

D

E

PROVISIONAL AS BUILT
 FOR APPROVAL AS FITTED
 ISSUED FOR CONSTRUCTION



REVISION No	DESCRIPTION OF REVISION	DRAWN BY	CHECKED BY	REVISION No	DESCRIPTION OF REVISION	STATUS	DRAWN BY	CHECKED BY	DRG No.6082-13 SHT. 20 of 20 PROJECT No.6082	REV 1 ©
		DATE	DATE	DATE			DATE	DATE	DATE	
0	PROVISIONAL	RFD 28/04/21		4						TITLE EXCHEQUER COURT
1	APPROVAL	RFD 09/05/21		5						PANEL TITLE BOILERHOUSE PLANTROOM CONTROL PANEL
2				6						
3				7						CLIENT



Project : EXCHEQUER COURT

Title : CP-BASE HWS
CONTROL PANEL

Client :

ENGINEER : RFD


DATE : 19/05/21

DRAWING No : 6082-14

SHEET : 11


REVISION : 1

PROJECT No. : 6082

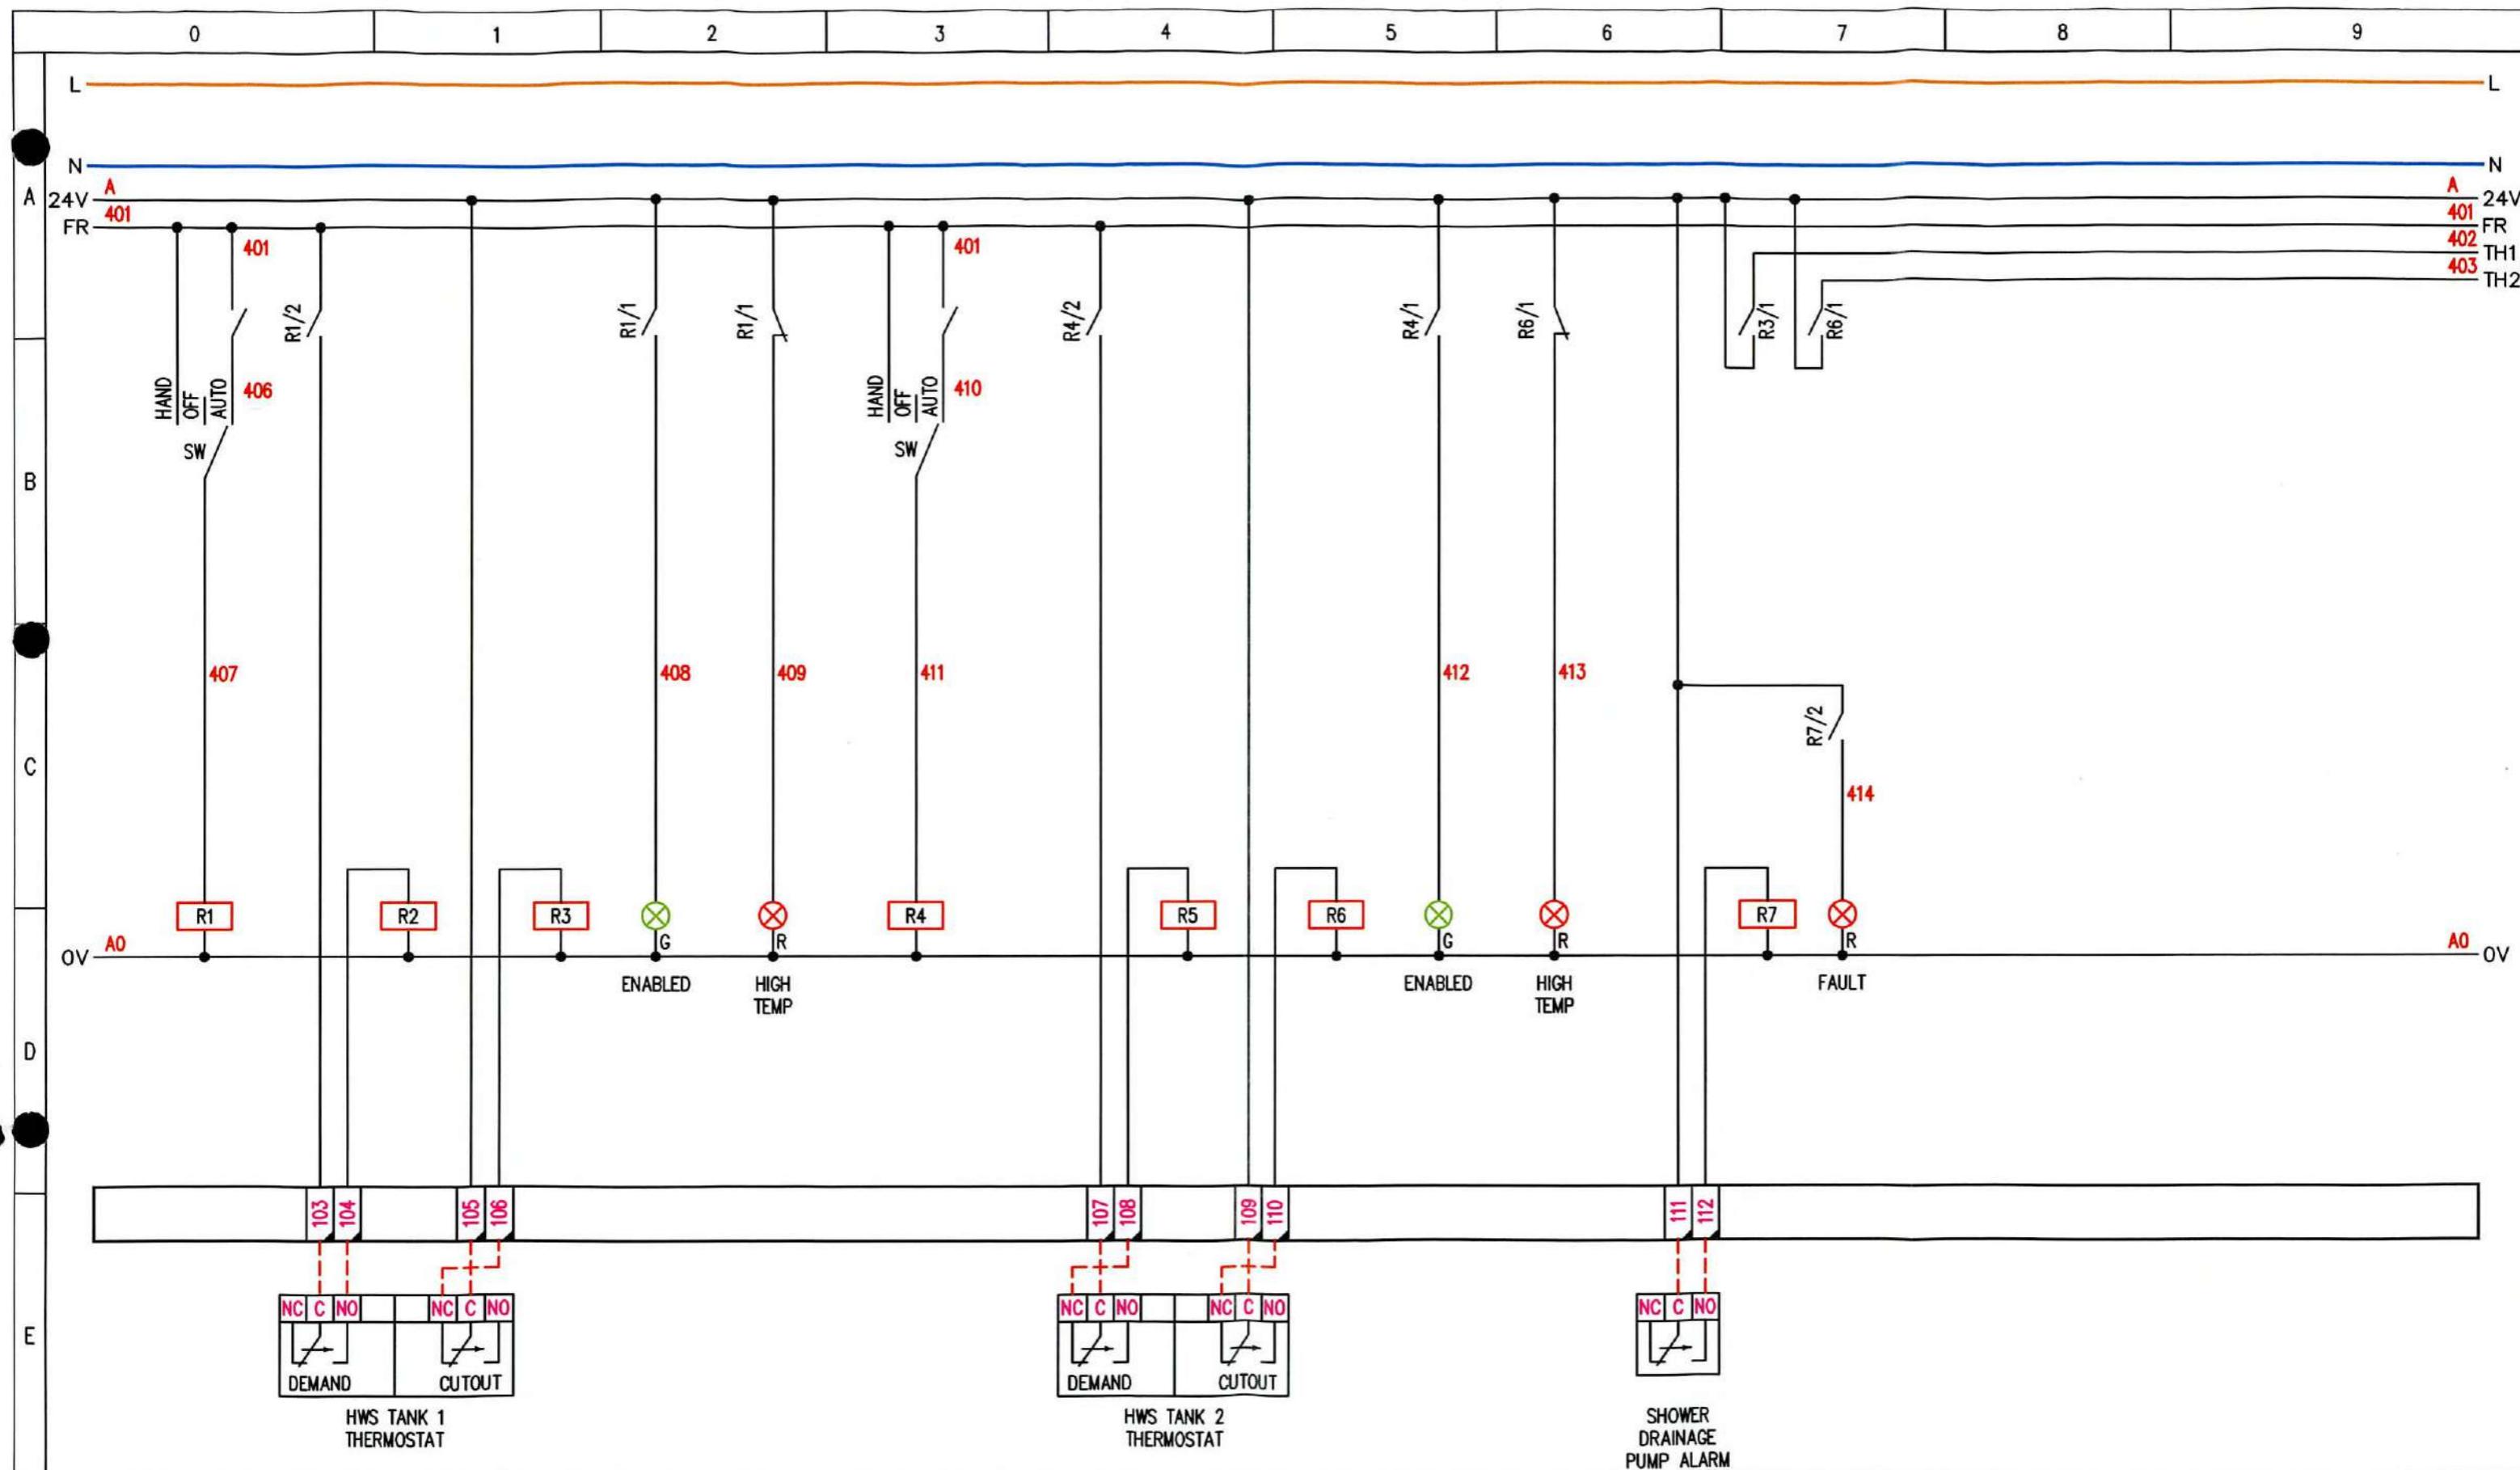


<input checked="" type="radio"/> PROVISIONAL	<input checked="" type="radio"/> AS BUILT	REVISION No	DESCRIPTION OF REVISION		DRAWN BY DATE	CHECKED BY DATE	REVISION No	DESCRIPTION OF REVISION		STATUS	DRAWN BY DATE	CHECKED BY DATE	DRG No.6082-14 PROJECT No.6082	SHT. 3 of 11	REV 1 ©
<input checked="" type="radio"/> FOR APPROVAL	<input checked="" type="radio"/> AS FITTED	0	PROVISIONAL		RFD 28/04/21		4						TITLE	EXCHEQUER COURT	
<input checked="" type="radio"/> ISSUED FOR CONSTRUCTION		1	AS COMMISSIONED		RFD 19/05/21		5						PANEL TITLE	CP-BASE HWS CONTROL PANEL	
		2					6						CLIENT		
		3					7								

0 1 2 3 4 5 6 7 8 9

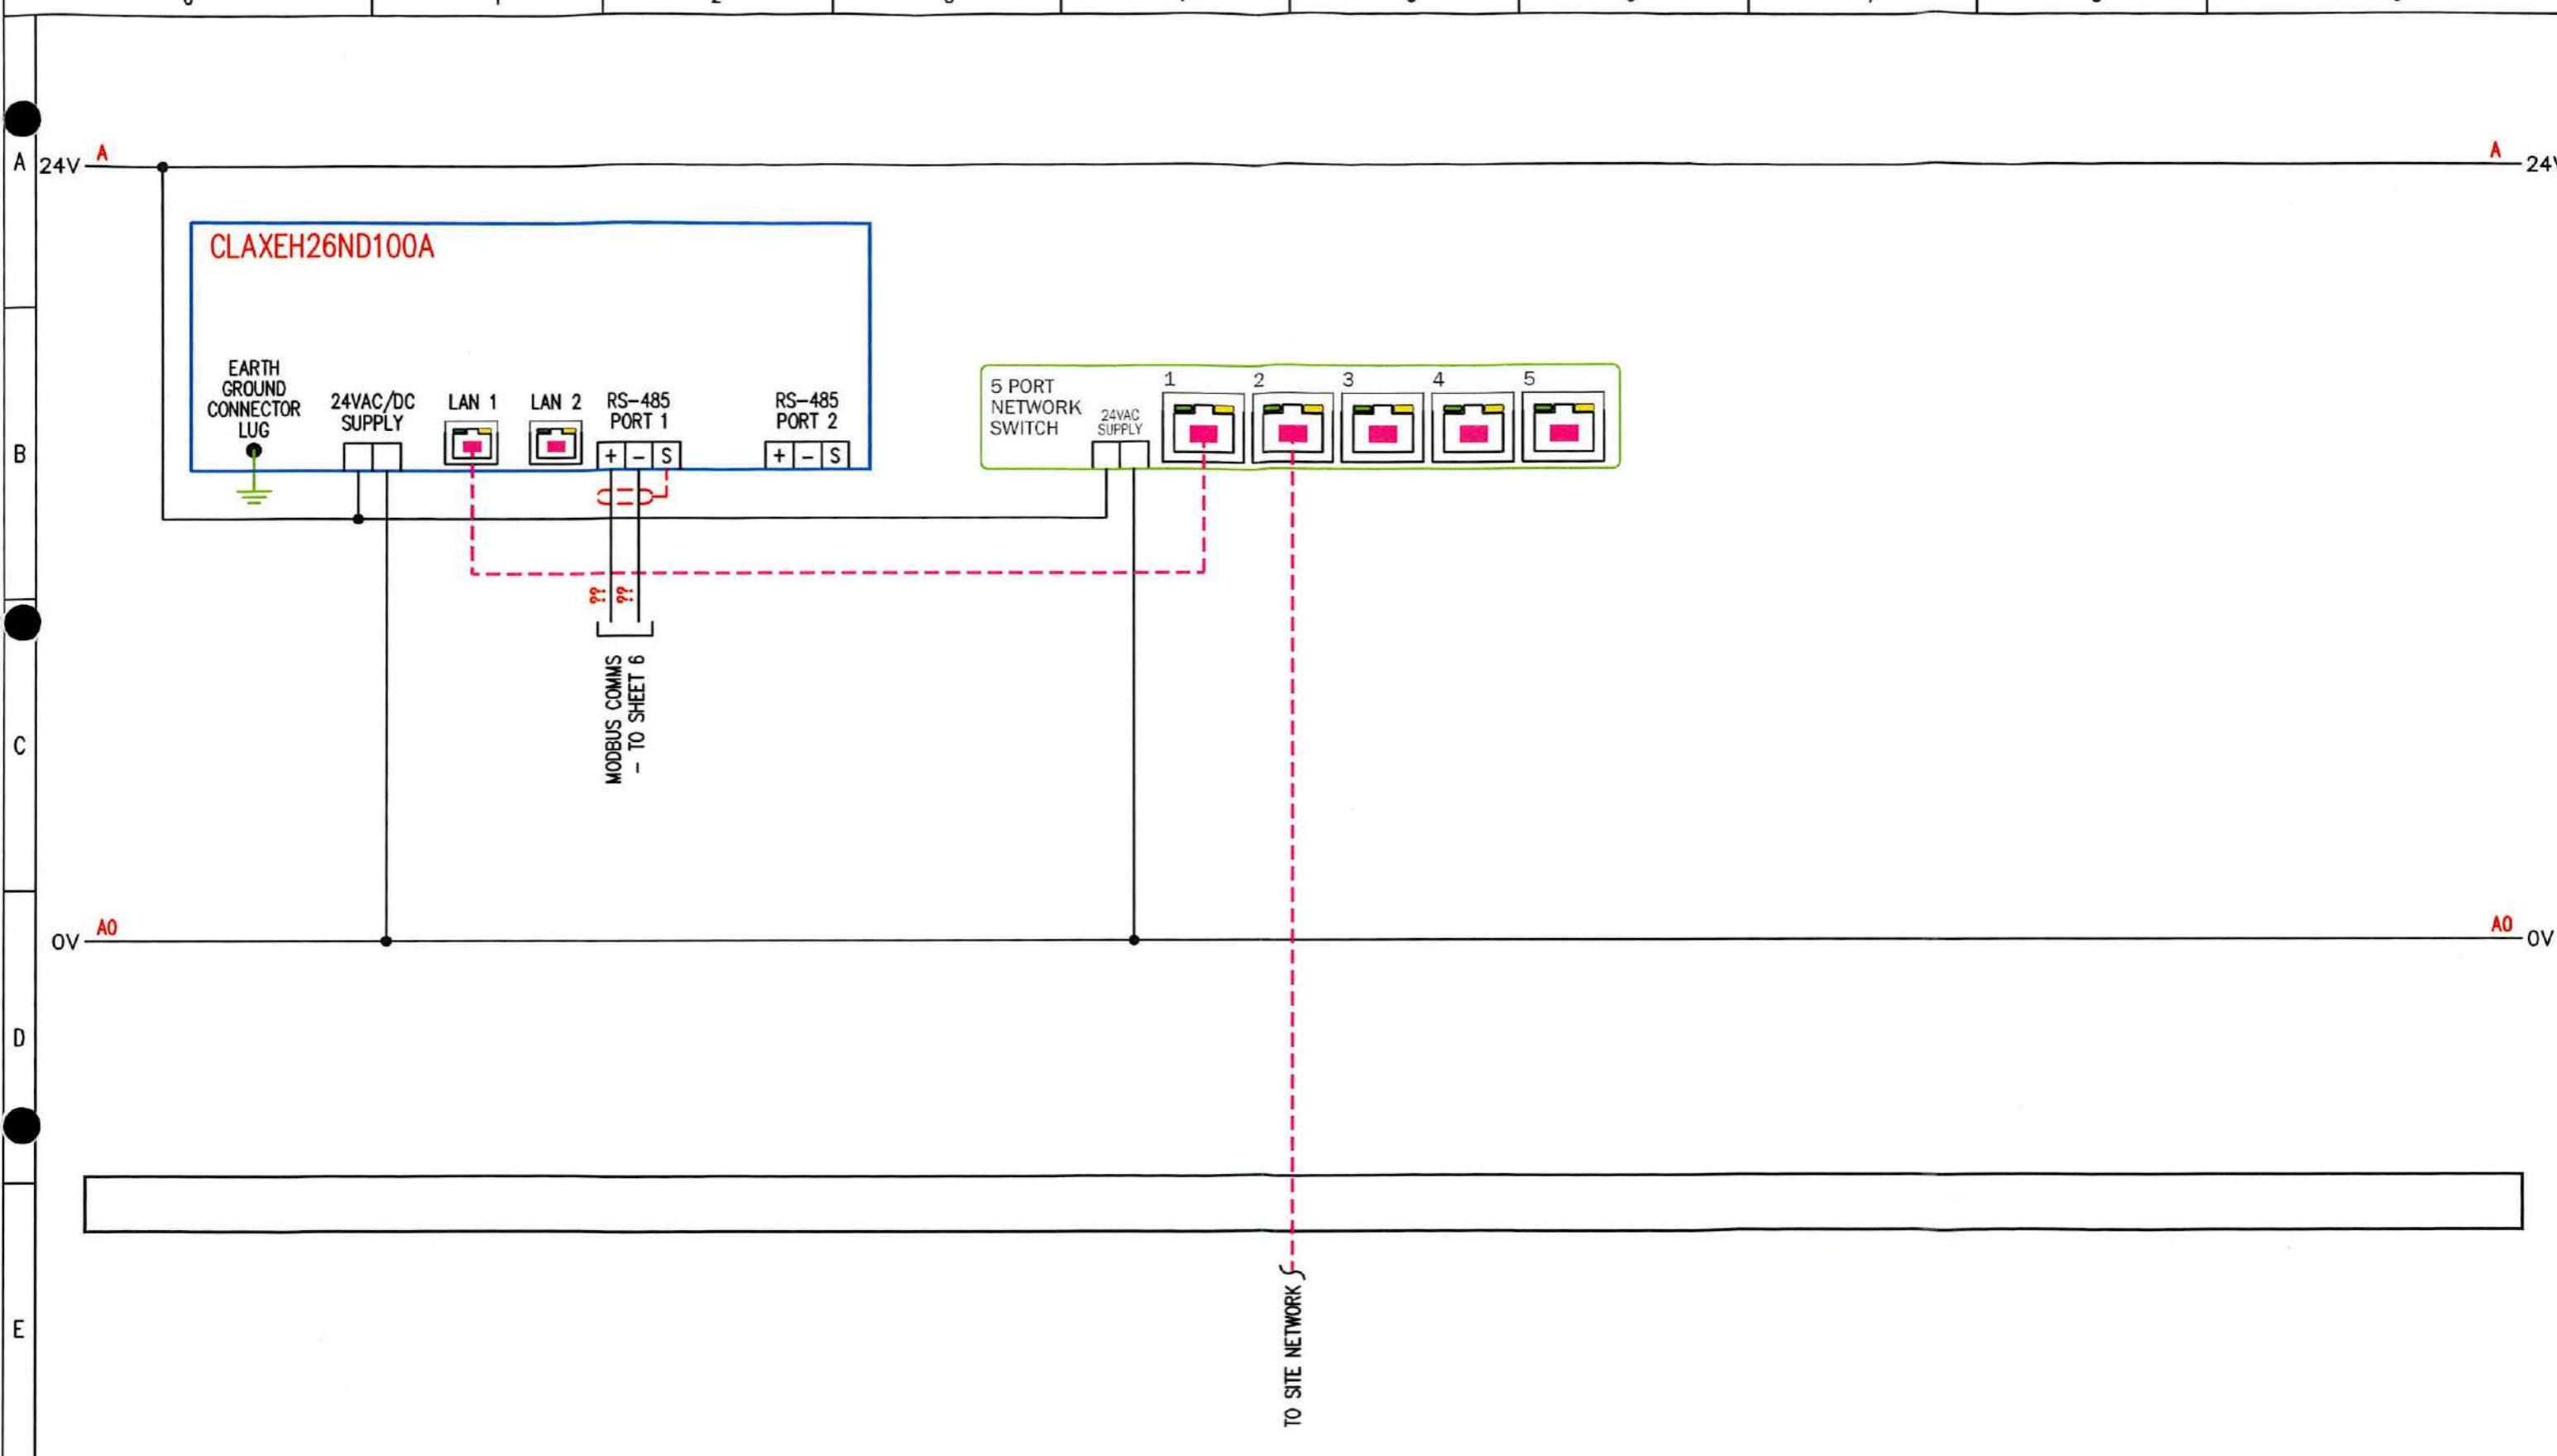


PROVISIONAL FOR APPROVAL ISSUED FOR CONSTRUCTION	AS BUILT AS FITTED	REVISION No	DESCRIPTION OF REVISION	DRAWN BY DATE	CHECKED BY DATE	REVISION No	DESCRIPTION OF REVISION	STATUS	DRAWN BY DATE	CHECKED BY DATE	DRG No.6082-14 PROJECT No.6082	SHT. 5 of 11	REV 1 ©
		0	PROVISIONAL	RFD 28/04/21		4							
		1	AS COMMISSIONED	RFD 19/05/21		5							
		2				6							
		3				7							

bges group

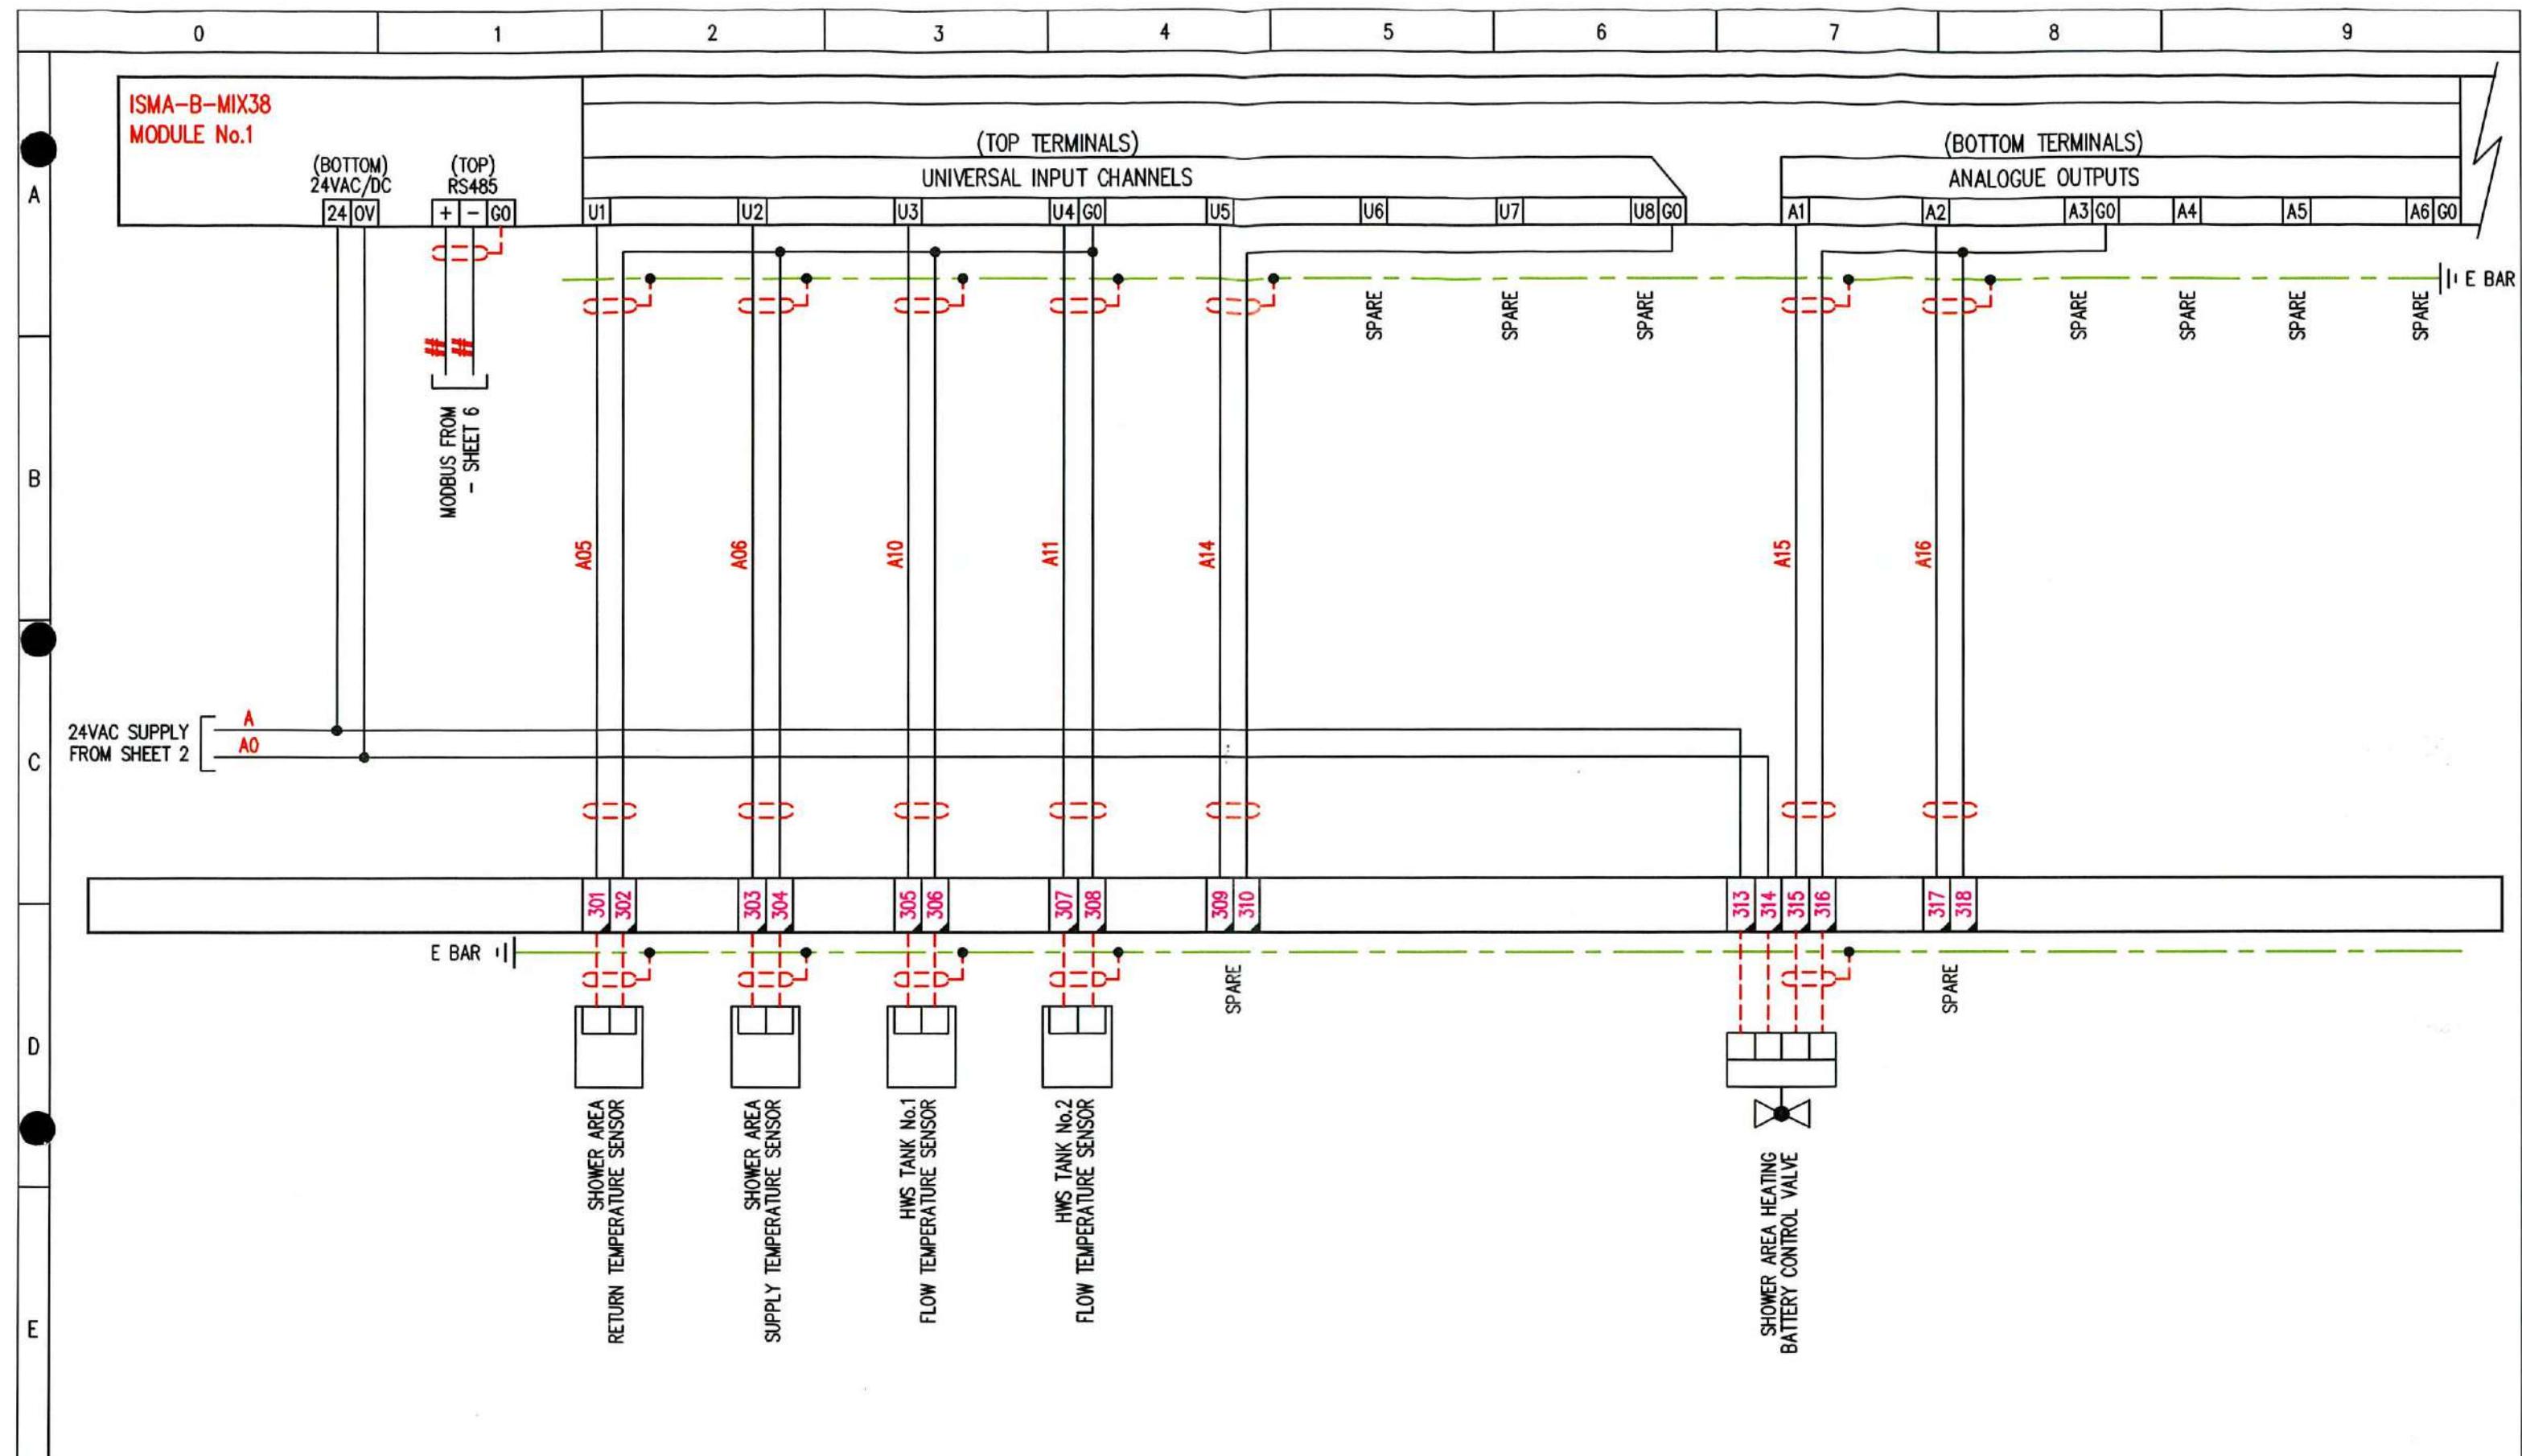

<input checked="" type="radio"/> PROVISIONAL	<input checked="" type="radio"/> AS BUILT	REVISION No	DESCRIPTION OF REVISION			DRAWN BY DATE	CHECKED BY DATE	REVISION No	DESCRIPTION OF REVISION			STATUS	DRAWN BY DATE	CHECKED BY DATE	DRG No.6082-14	SHT. 6	of 11	REV 1						
<input checked="" type="radio"/> FOR APPROVAL	<input checked="" type="radio"/> AS FITTED														PROJECT No.6082									
<input checked="" type="radio"/> ISSUED FOR CONSTRUCTION															TITLE	EXCHEQUER COURT								
			PROVISIONAL				RFD 28/04/21		4							PANEL TITLE	CP-BASE HWS CONTROL PANEL							
			AS COMMISSIONED				RFD 19/05/21		5							CLIENT								
																								


0 1 2 3 4 5 6 7 8 9

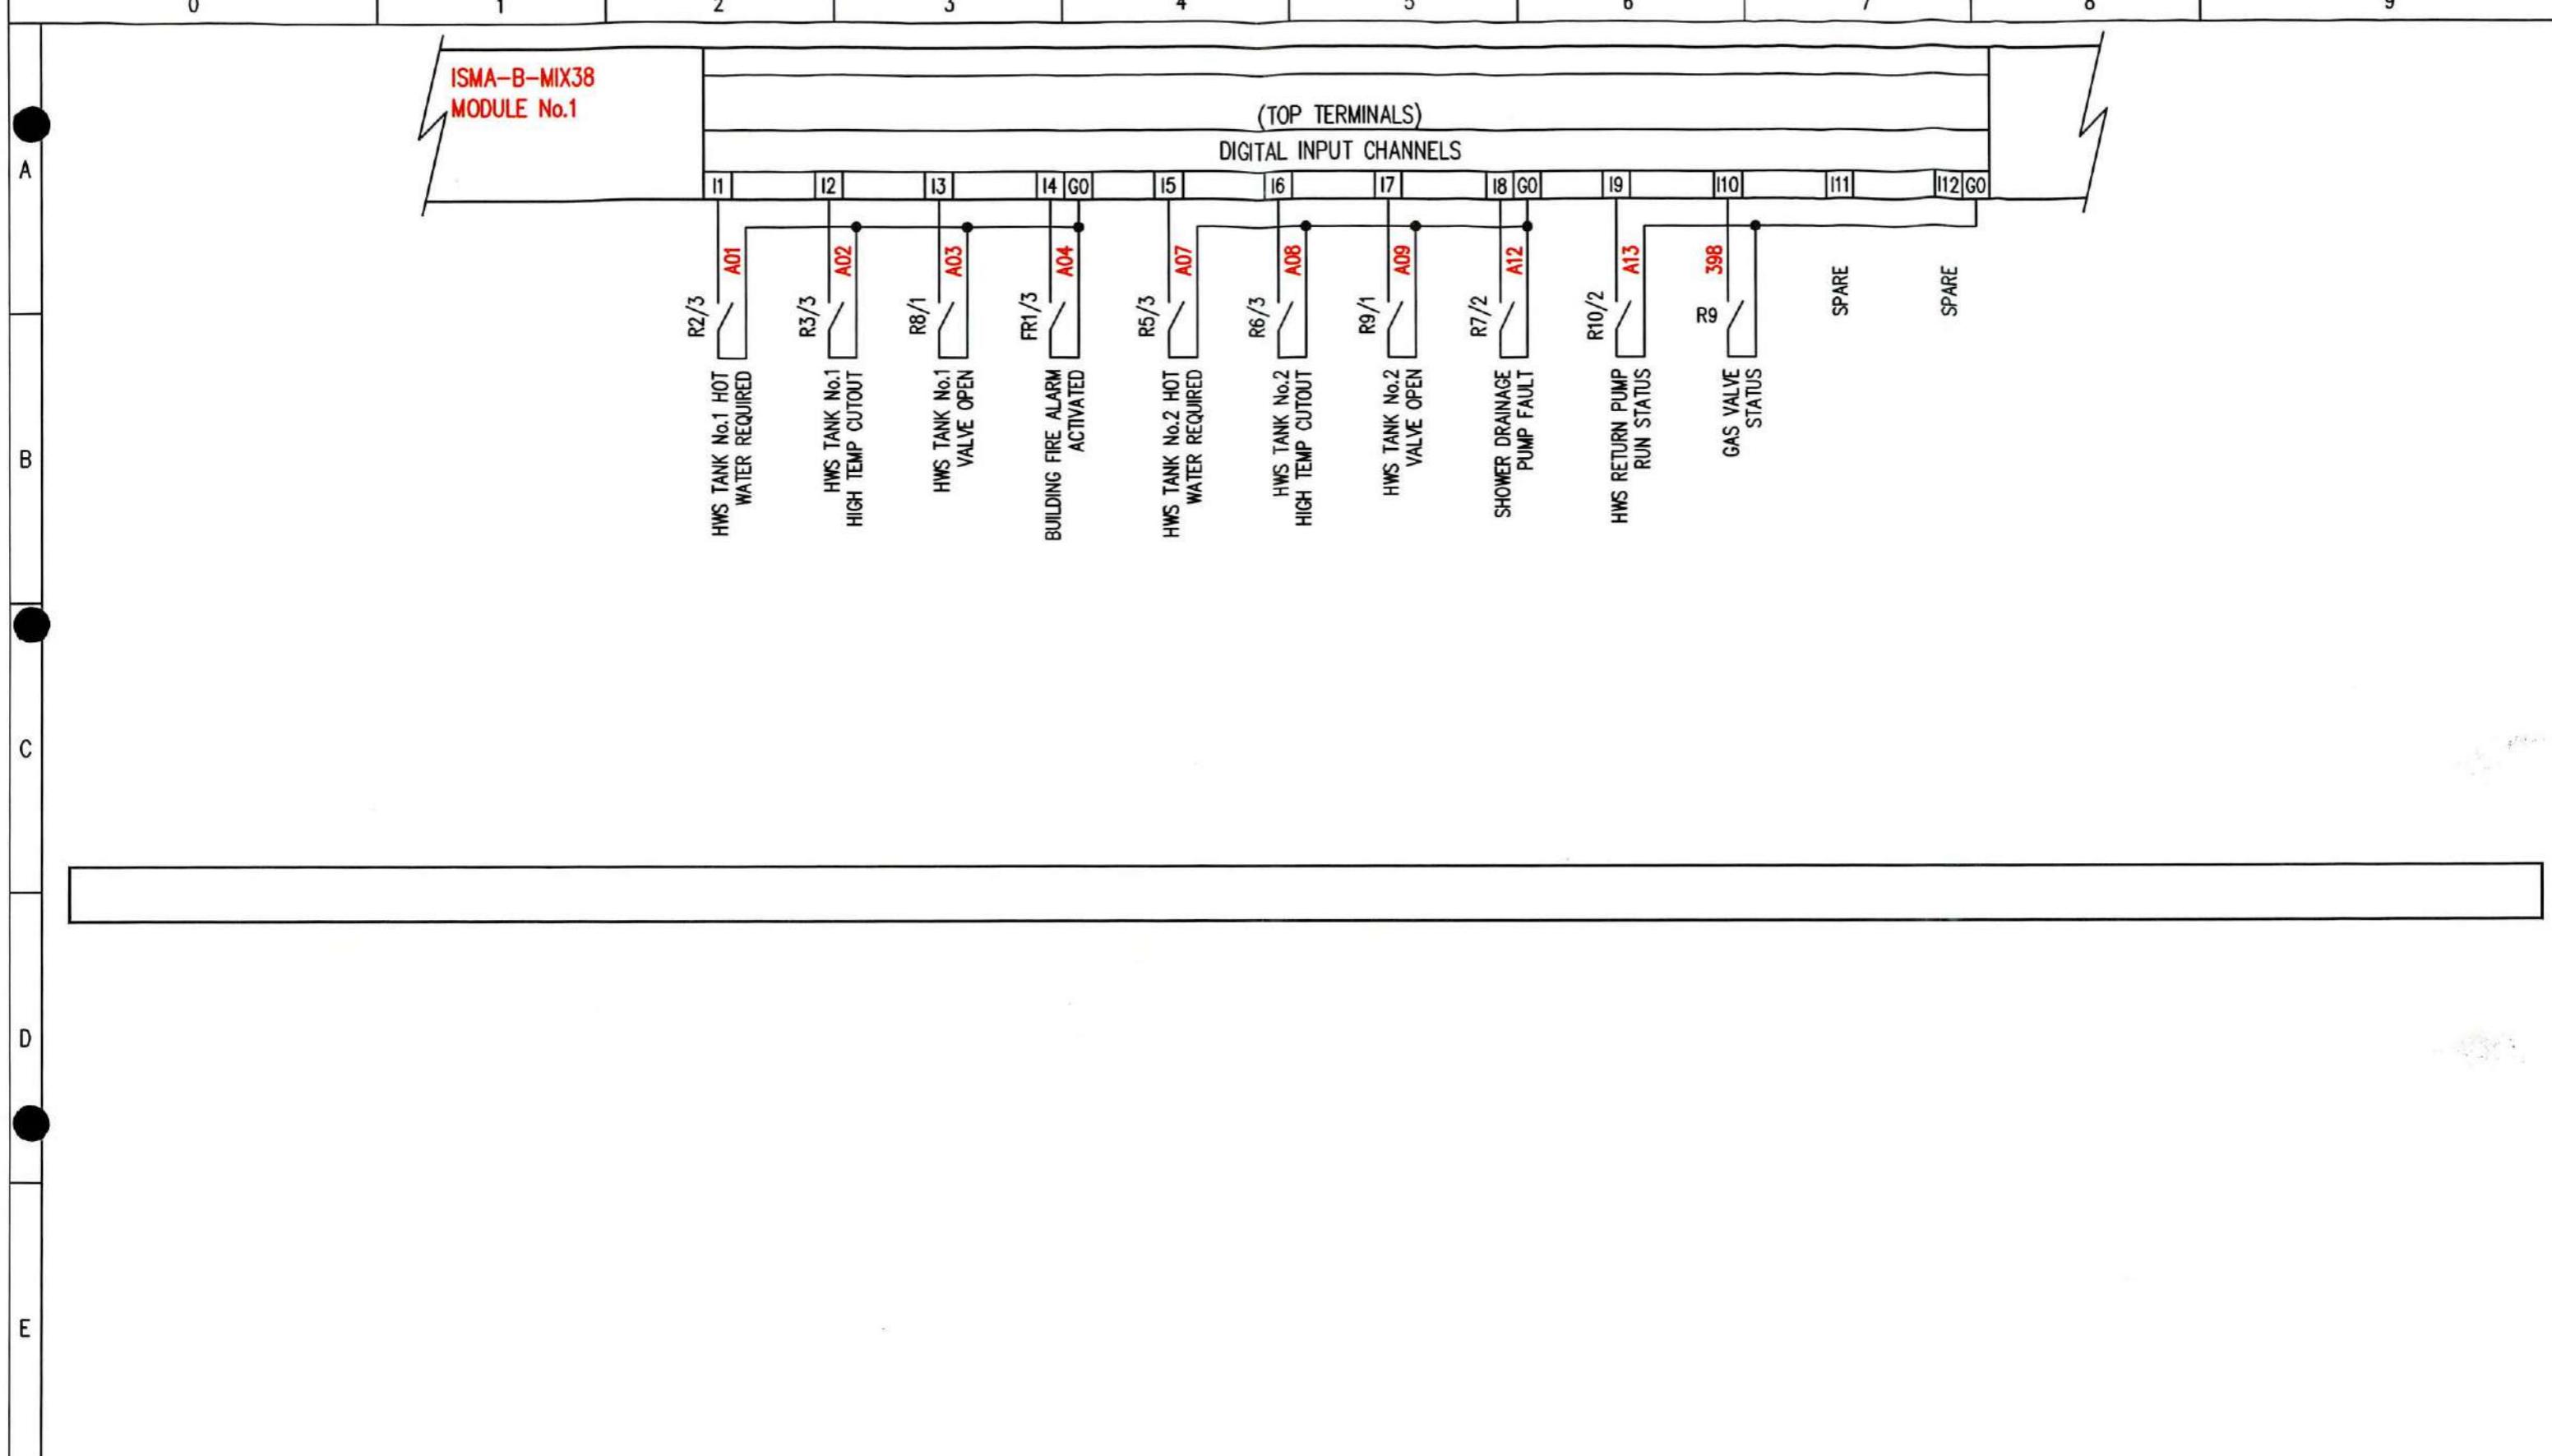


PROVISIONAL FOR APPROVAL ISSUED FOR CONSTRUCTION	AS BUILT AS FITTED	REVISION No	DESCRIPTION OF REVISION	DRAWN BY DATE	CHECKED BY DATE	REVISION No	DESCRIPTION OF REVISION	STATUS	DRAWN BY DATE	CHECKED BY DATE	DRG No.6082-14 PROJECT No.6082	SHT. 7 of 11	REV 1 ©
		0	PROVISIONAL	RFD 28/04/21		4					TITLE	EXCHEQUER COURT	
		1	AS COMMISSIONED	RFD 19/05/21		5					PANEL TITLE	CP-BASE HWS CONTROL PANEL	
		2				6					CLIENT		
		3				7							



0 1 2 3 4 5 6 7 8 9

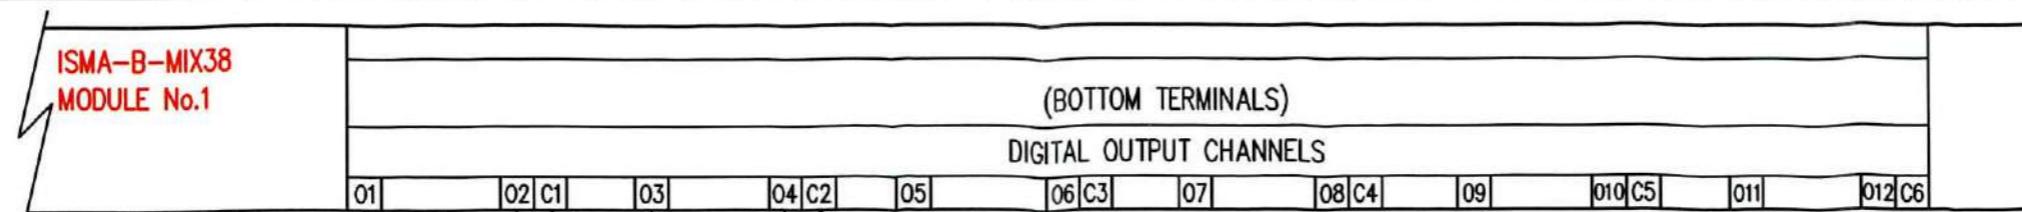

427 428 429 SPARE SPARE SPARE SPARE SPARE SPARE SPARE SPARE SPARE

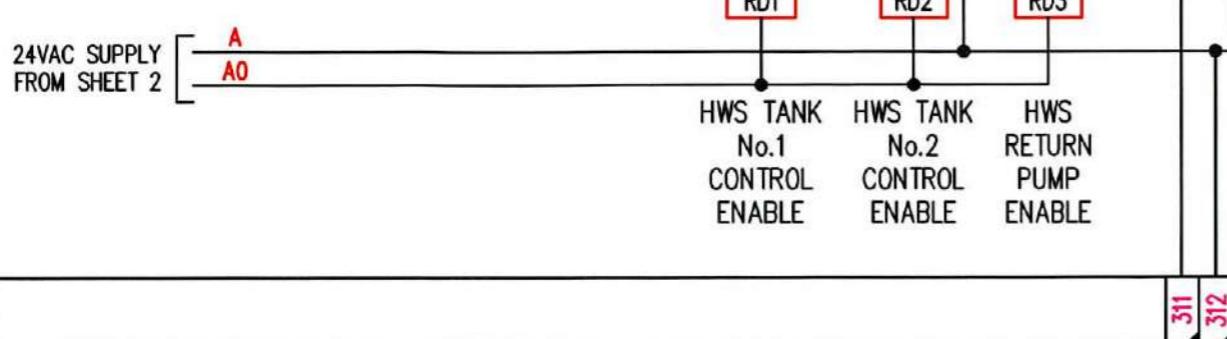



311 312

SPARE

● PROVISIONAL ● AS BUILT
● FOR APPROVAL ● AS FITTED
● ISSUED FOR CONSTRUCTION



REVISION No	DESCRIPTION OF REVISION	DRAWN BY DATE	CHECKED BY DATE	REVISION No	DESCRIPTION OF REVISION	STATUS	DRAWN BY DATE	CHECKED BY DATE	DRG No.6082-14 PROJECT No.6082	SHT. 8 of 11	REV 1 ©
0	PROVISIONAL	RFD 28/04/21		4							
1	AS COMMISSIONED	RFD 19/05/21		5							
2				6							
3				7							
									TITLE	EXCHEQUER COURT	
									PANEL TITLE	CP-BASE HWS CONTROL PANEL	
									CLIENT		

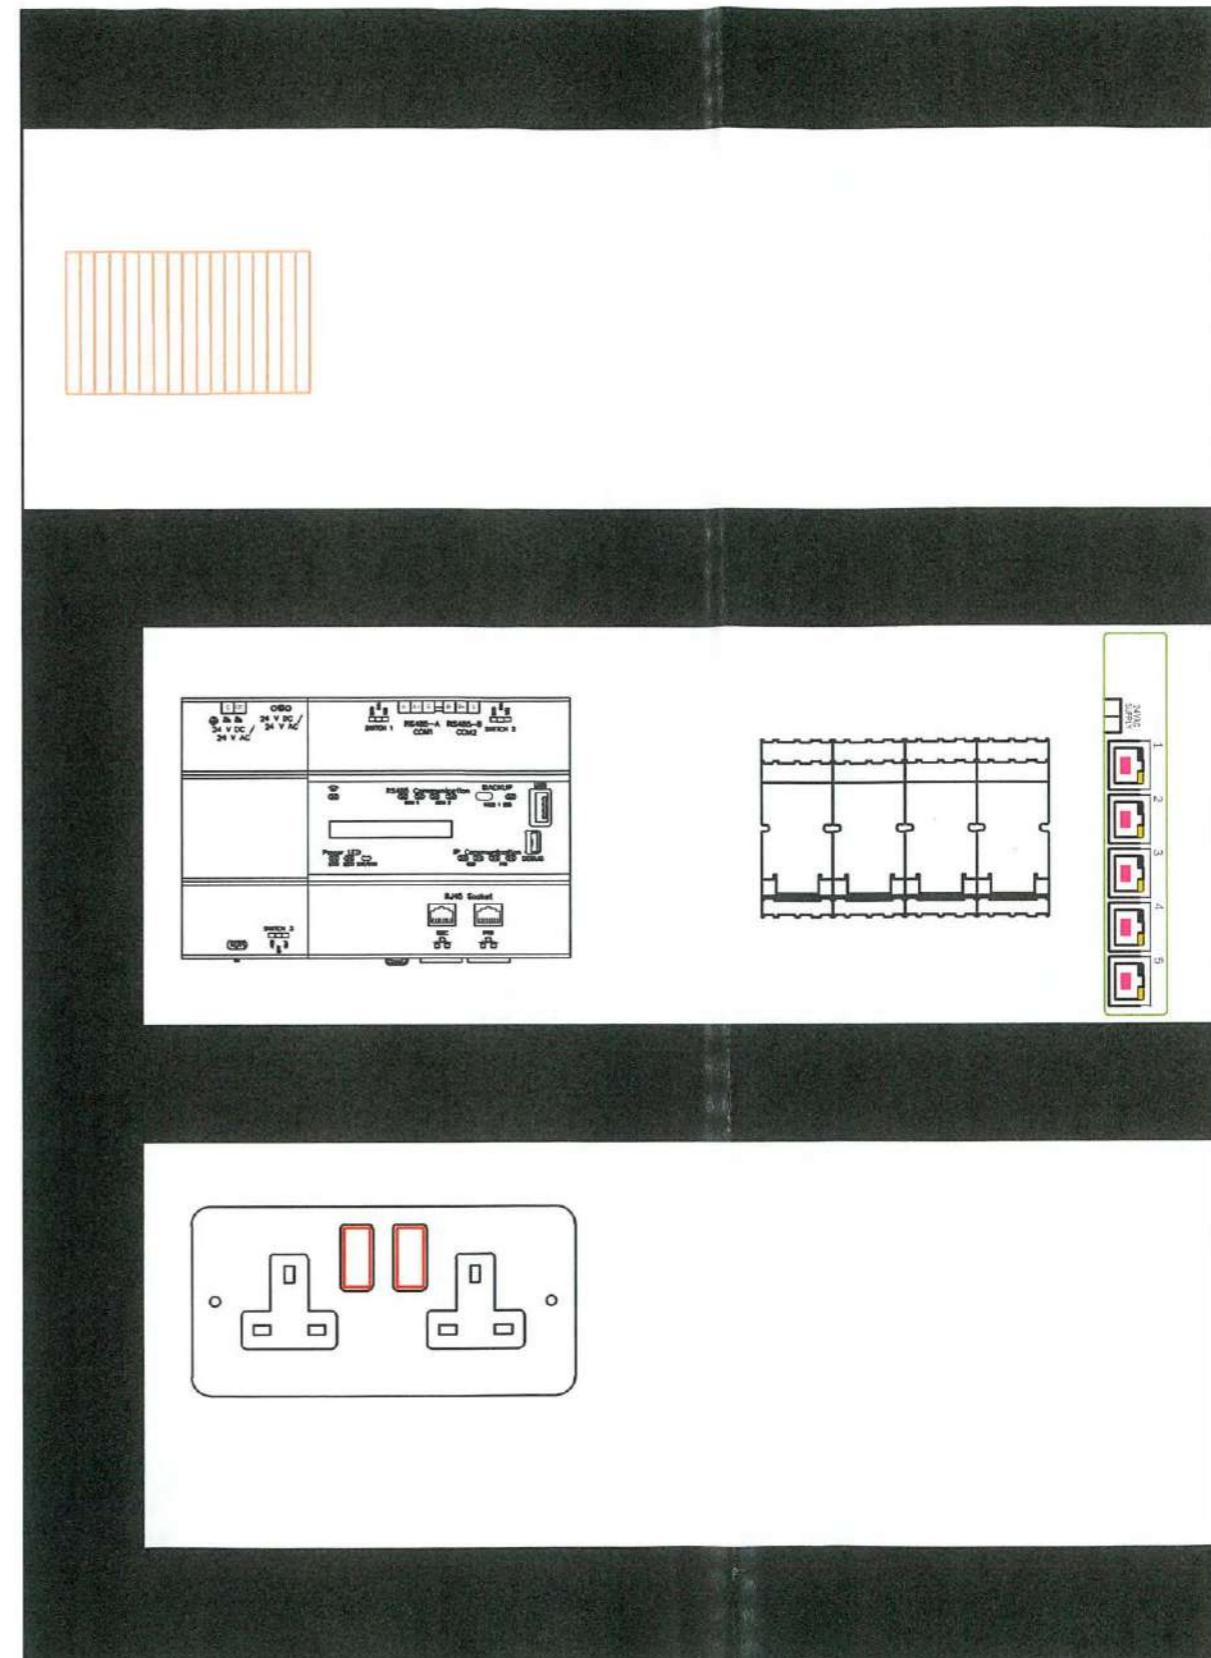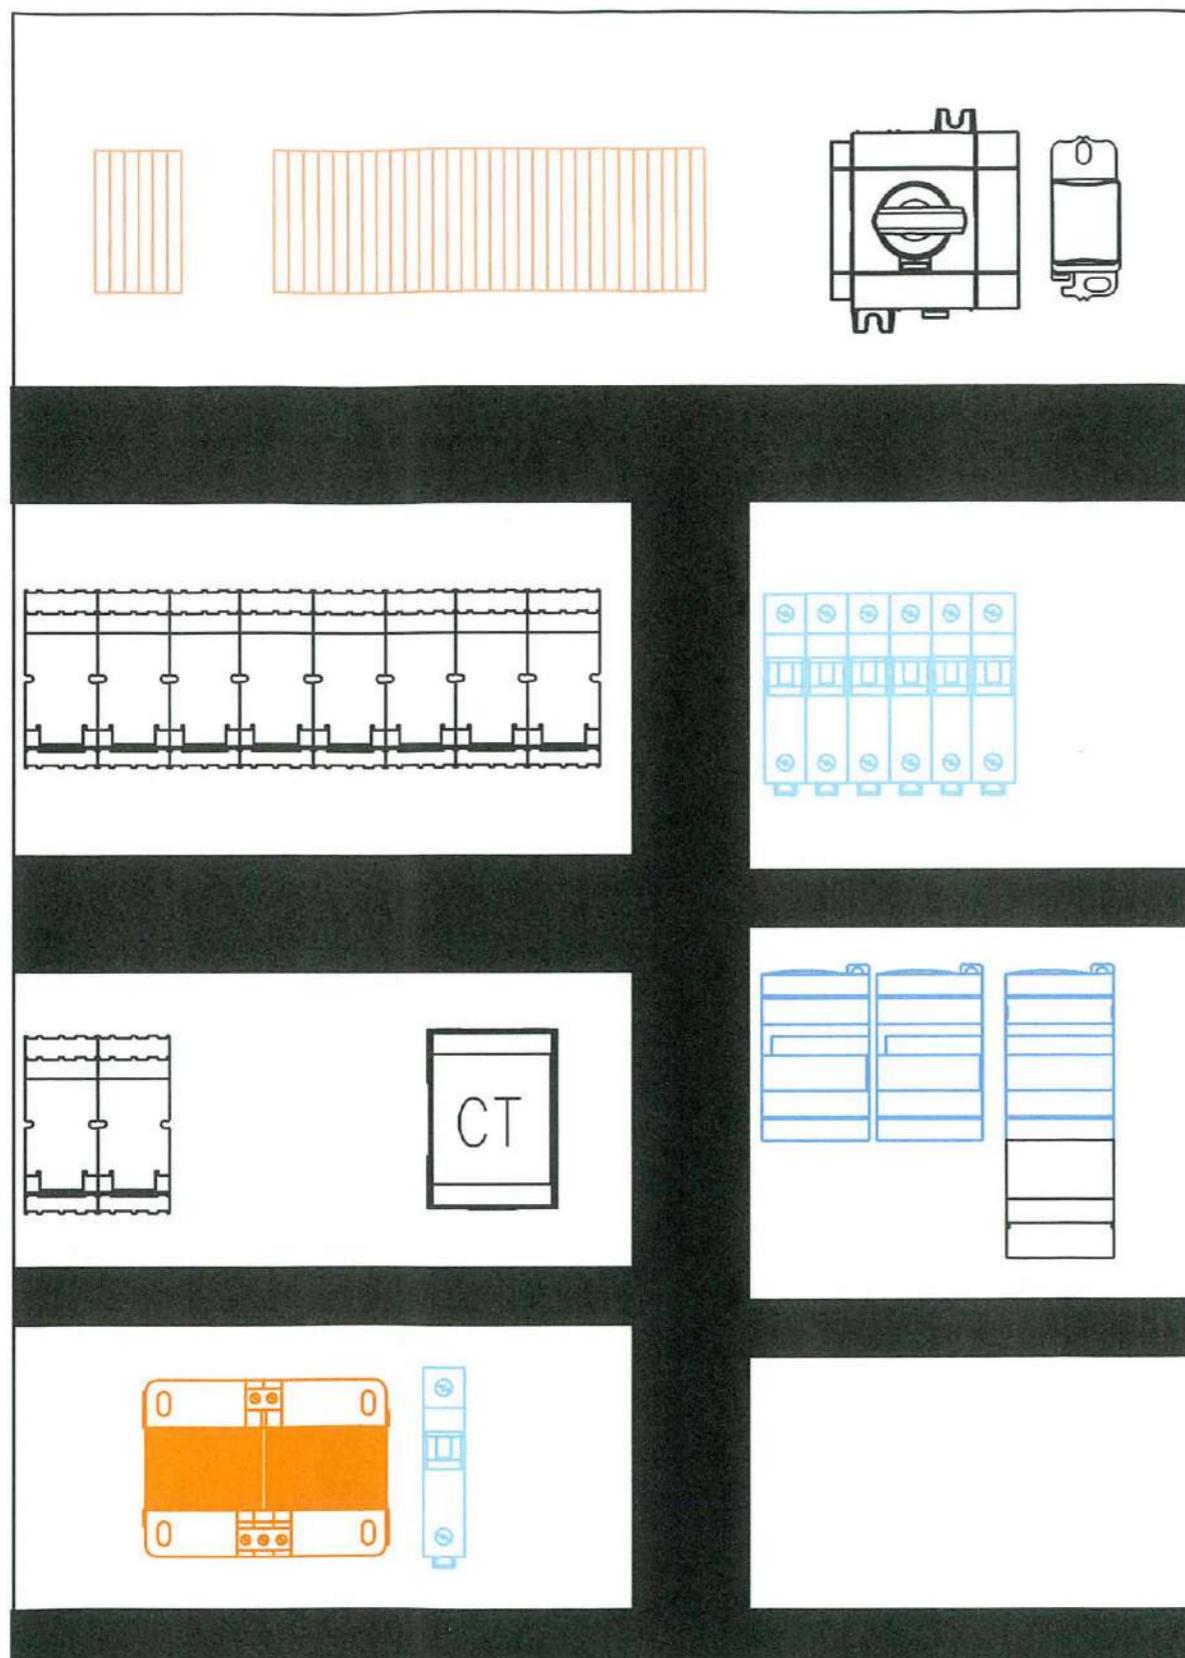


PROVISIONAL
 FOR APPROVAL
 ISSUED FOR CONSTRUCTION
 AS BUILT
 AS FITTED



REVISION No	DESCRIPTION OF REVISION	DRAWN BY	CHECKED BY	REVISION No
0	PROVISIONAL	RFD 28/04/21		4
1	AS COMMISSIONED	RFD 19/05/21		5
2				6
3				7

DESCRIPTION OF REVISION	STATUS	DRAWN BY	CHECKED BY

DRG No.6082-14 SHT. 9 of 11 REV 1
 PROJECT No.6082
 TITLE EXCHEQUER COURT
 PANEL TITLE CP-BASE HWS CONTROL PANEL
 CLIENT

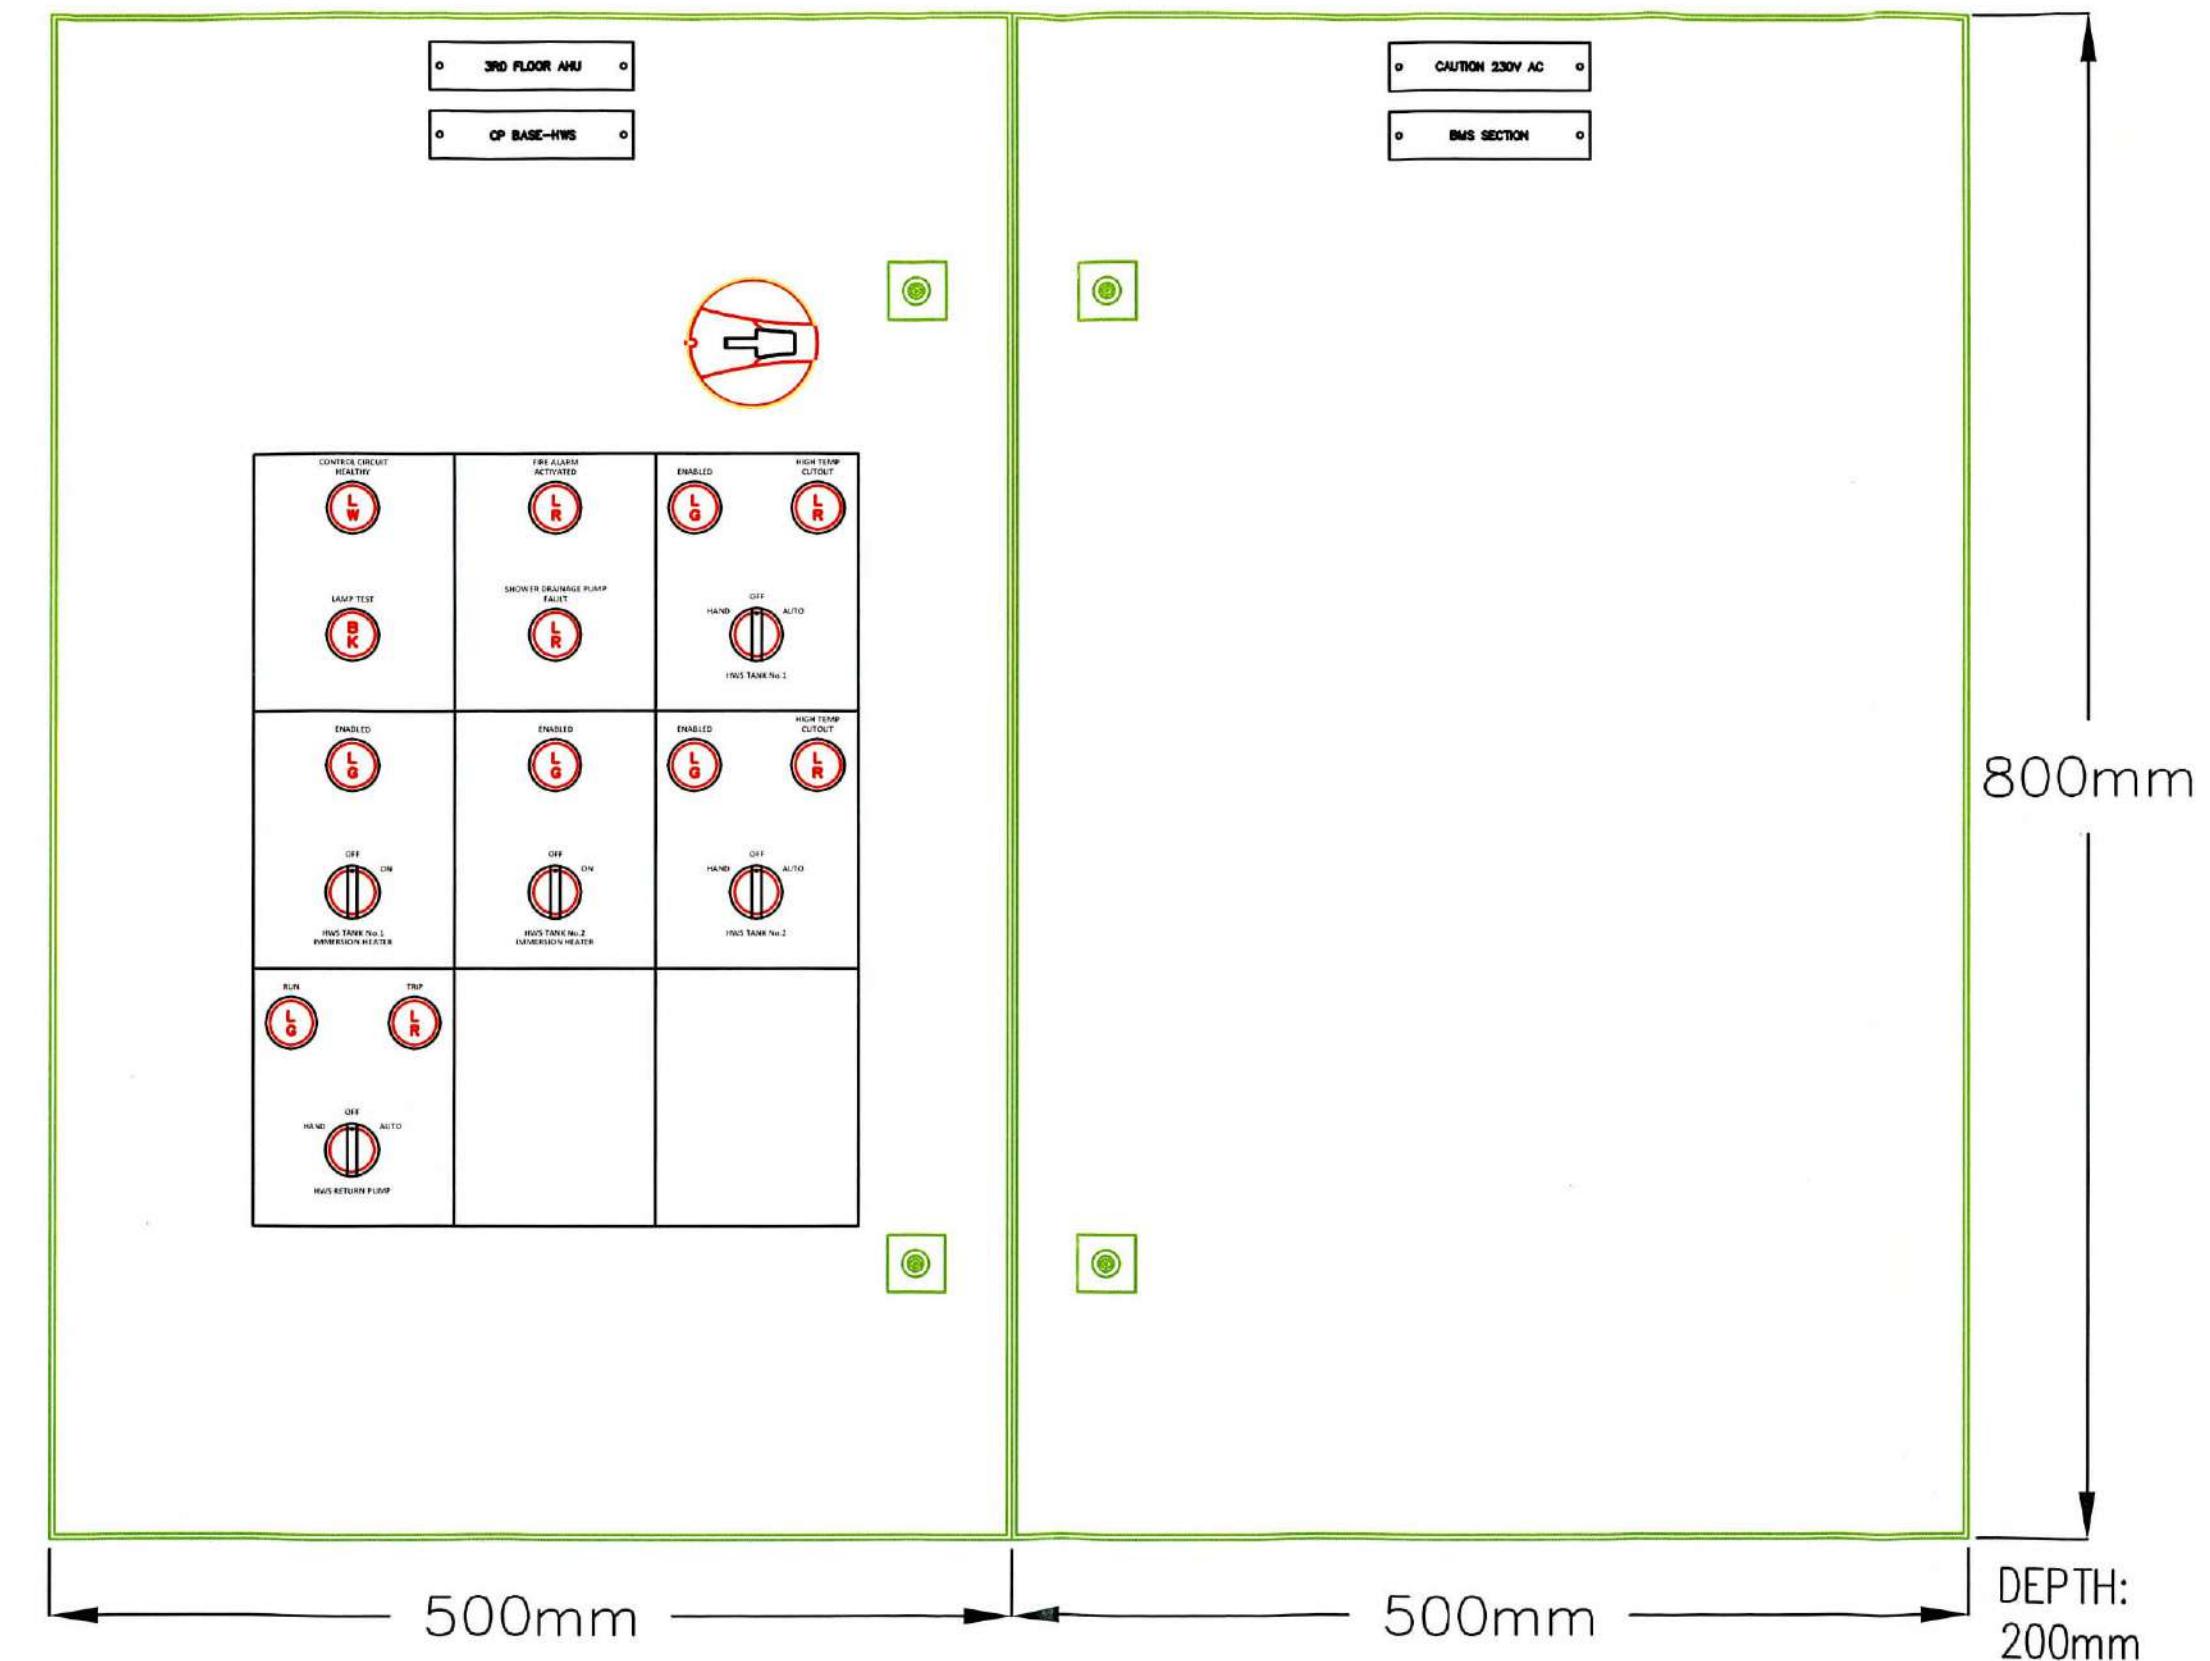

0	1	2	3	4	5	6	7	8	9
---	---	---	---	---	---	---	---	---	---

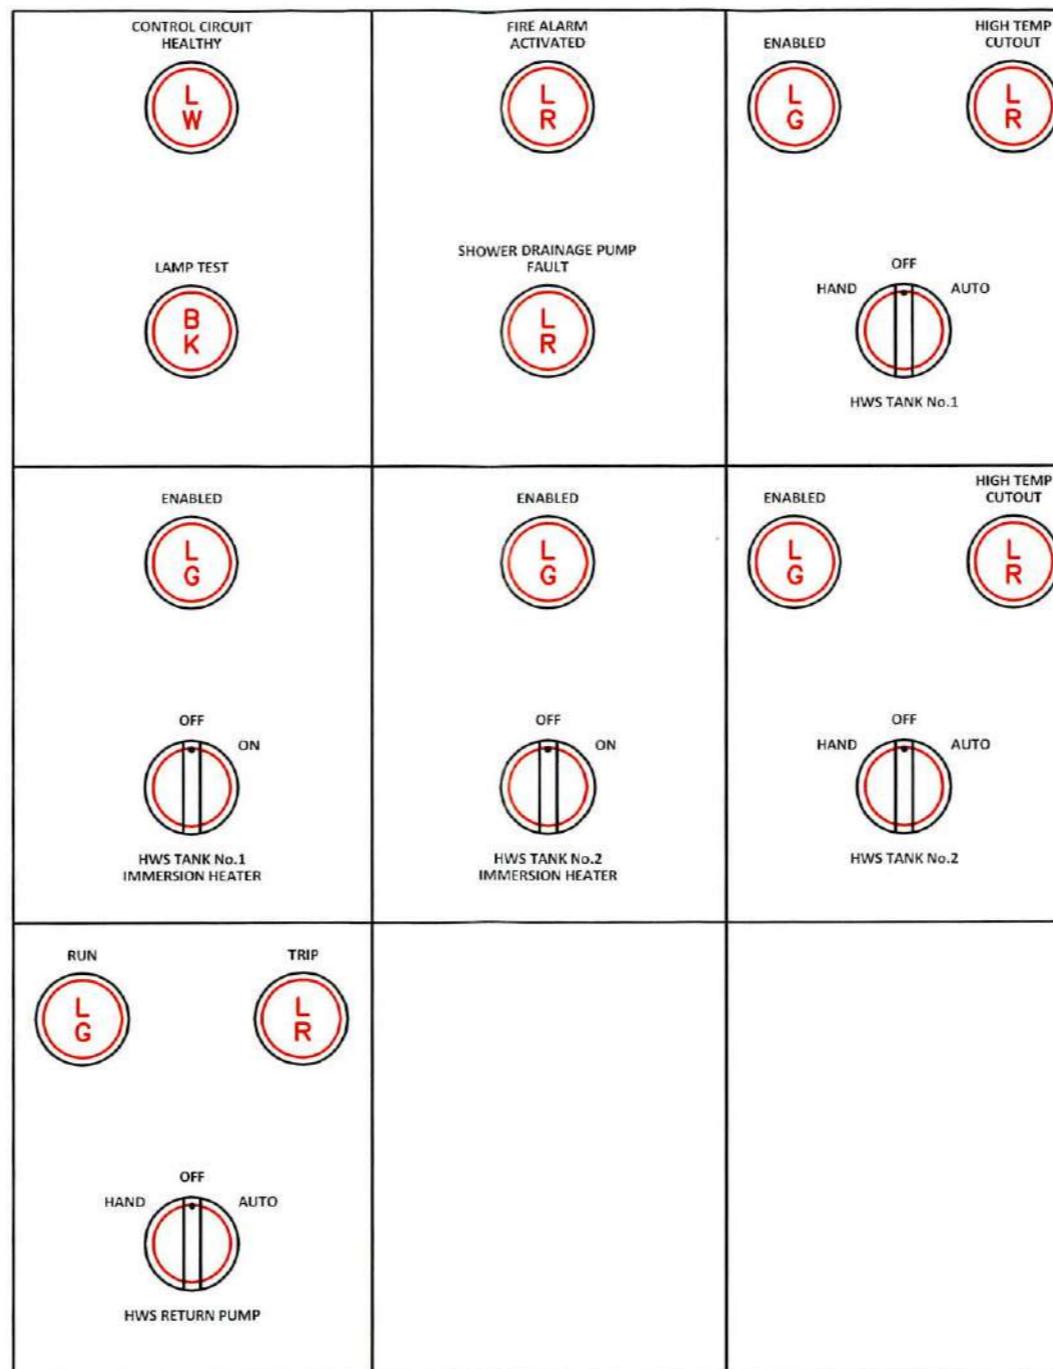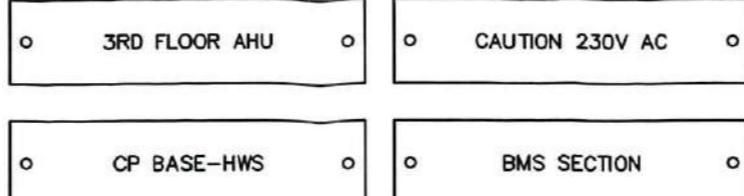

PROVISIONAL FOR APPROVAL ISSUED FOR CONSTRUCTION	AS BUILT AS FITTED	REVISION No	DESCRIPTION OF REVISION	DRAWN BY DATE	CHECKED BY DATE	REVISION No	DESCRIPTION OF REVISION	STATUS	DRAWN BY DATE	CHECKED BY DATE	DRG No.6082-14 PROJECT No.6082	SHT. 11 of 11	REV 1 ©
		0	PROVISIONAL	RFD 28/04/21		4							
		1	AS COMMISSIONED	RFD 19/05/21		5							
		2				6							
		3				7							



Project : EXCHEQUER COURT

Title : EXISTING SOUTH ROOF
CONTROL PANEL

Client :

ENGINEER : RFD


DATE : 19/05/21


DRAWING No : 6082-15

SHEET : 21


REVISION : 1

PROJECT No. : 6082

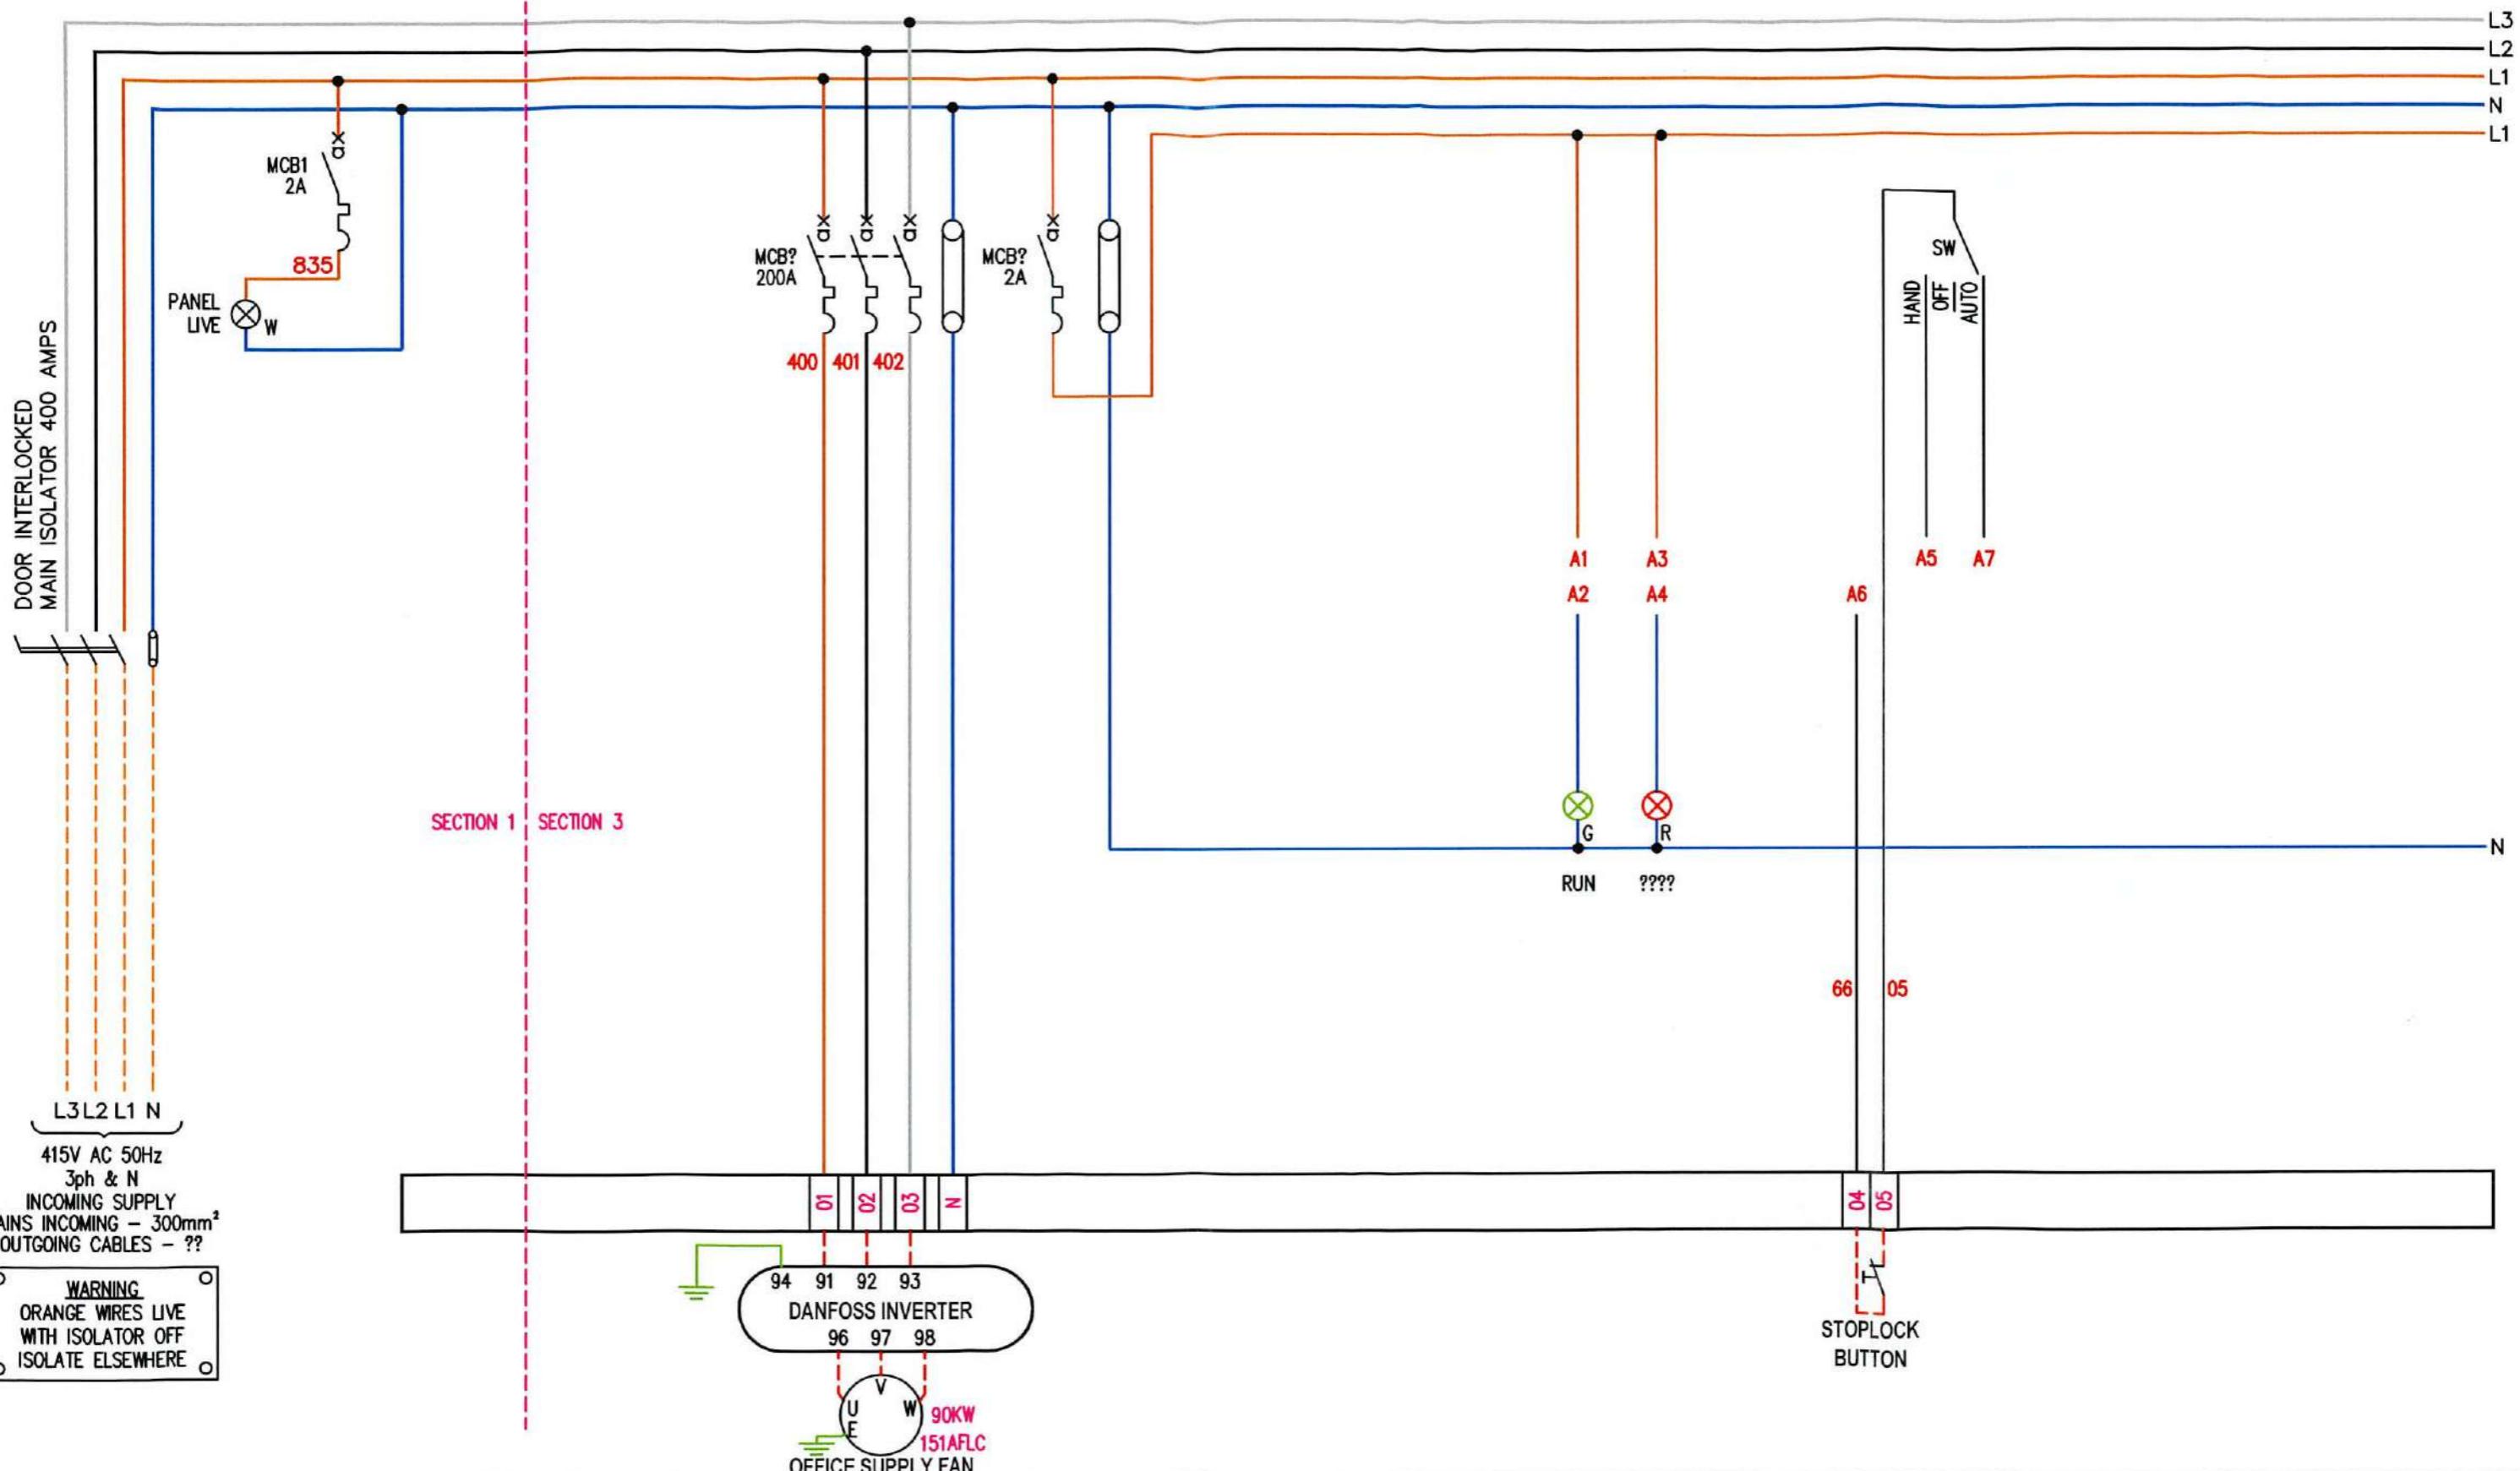


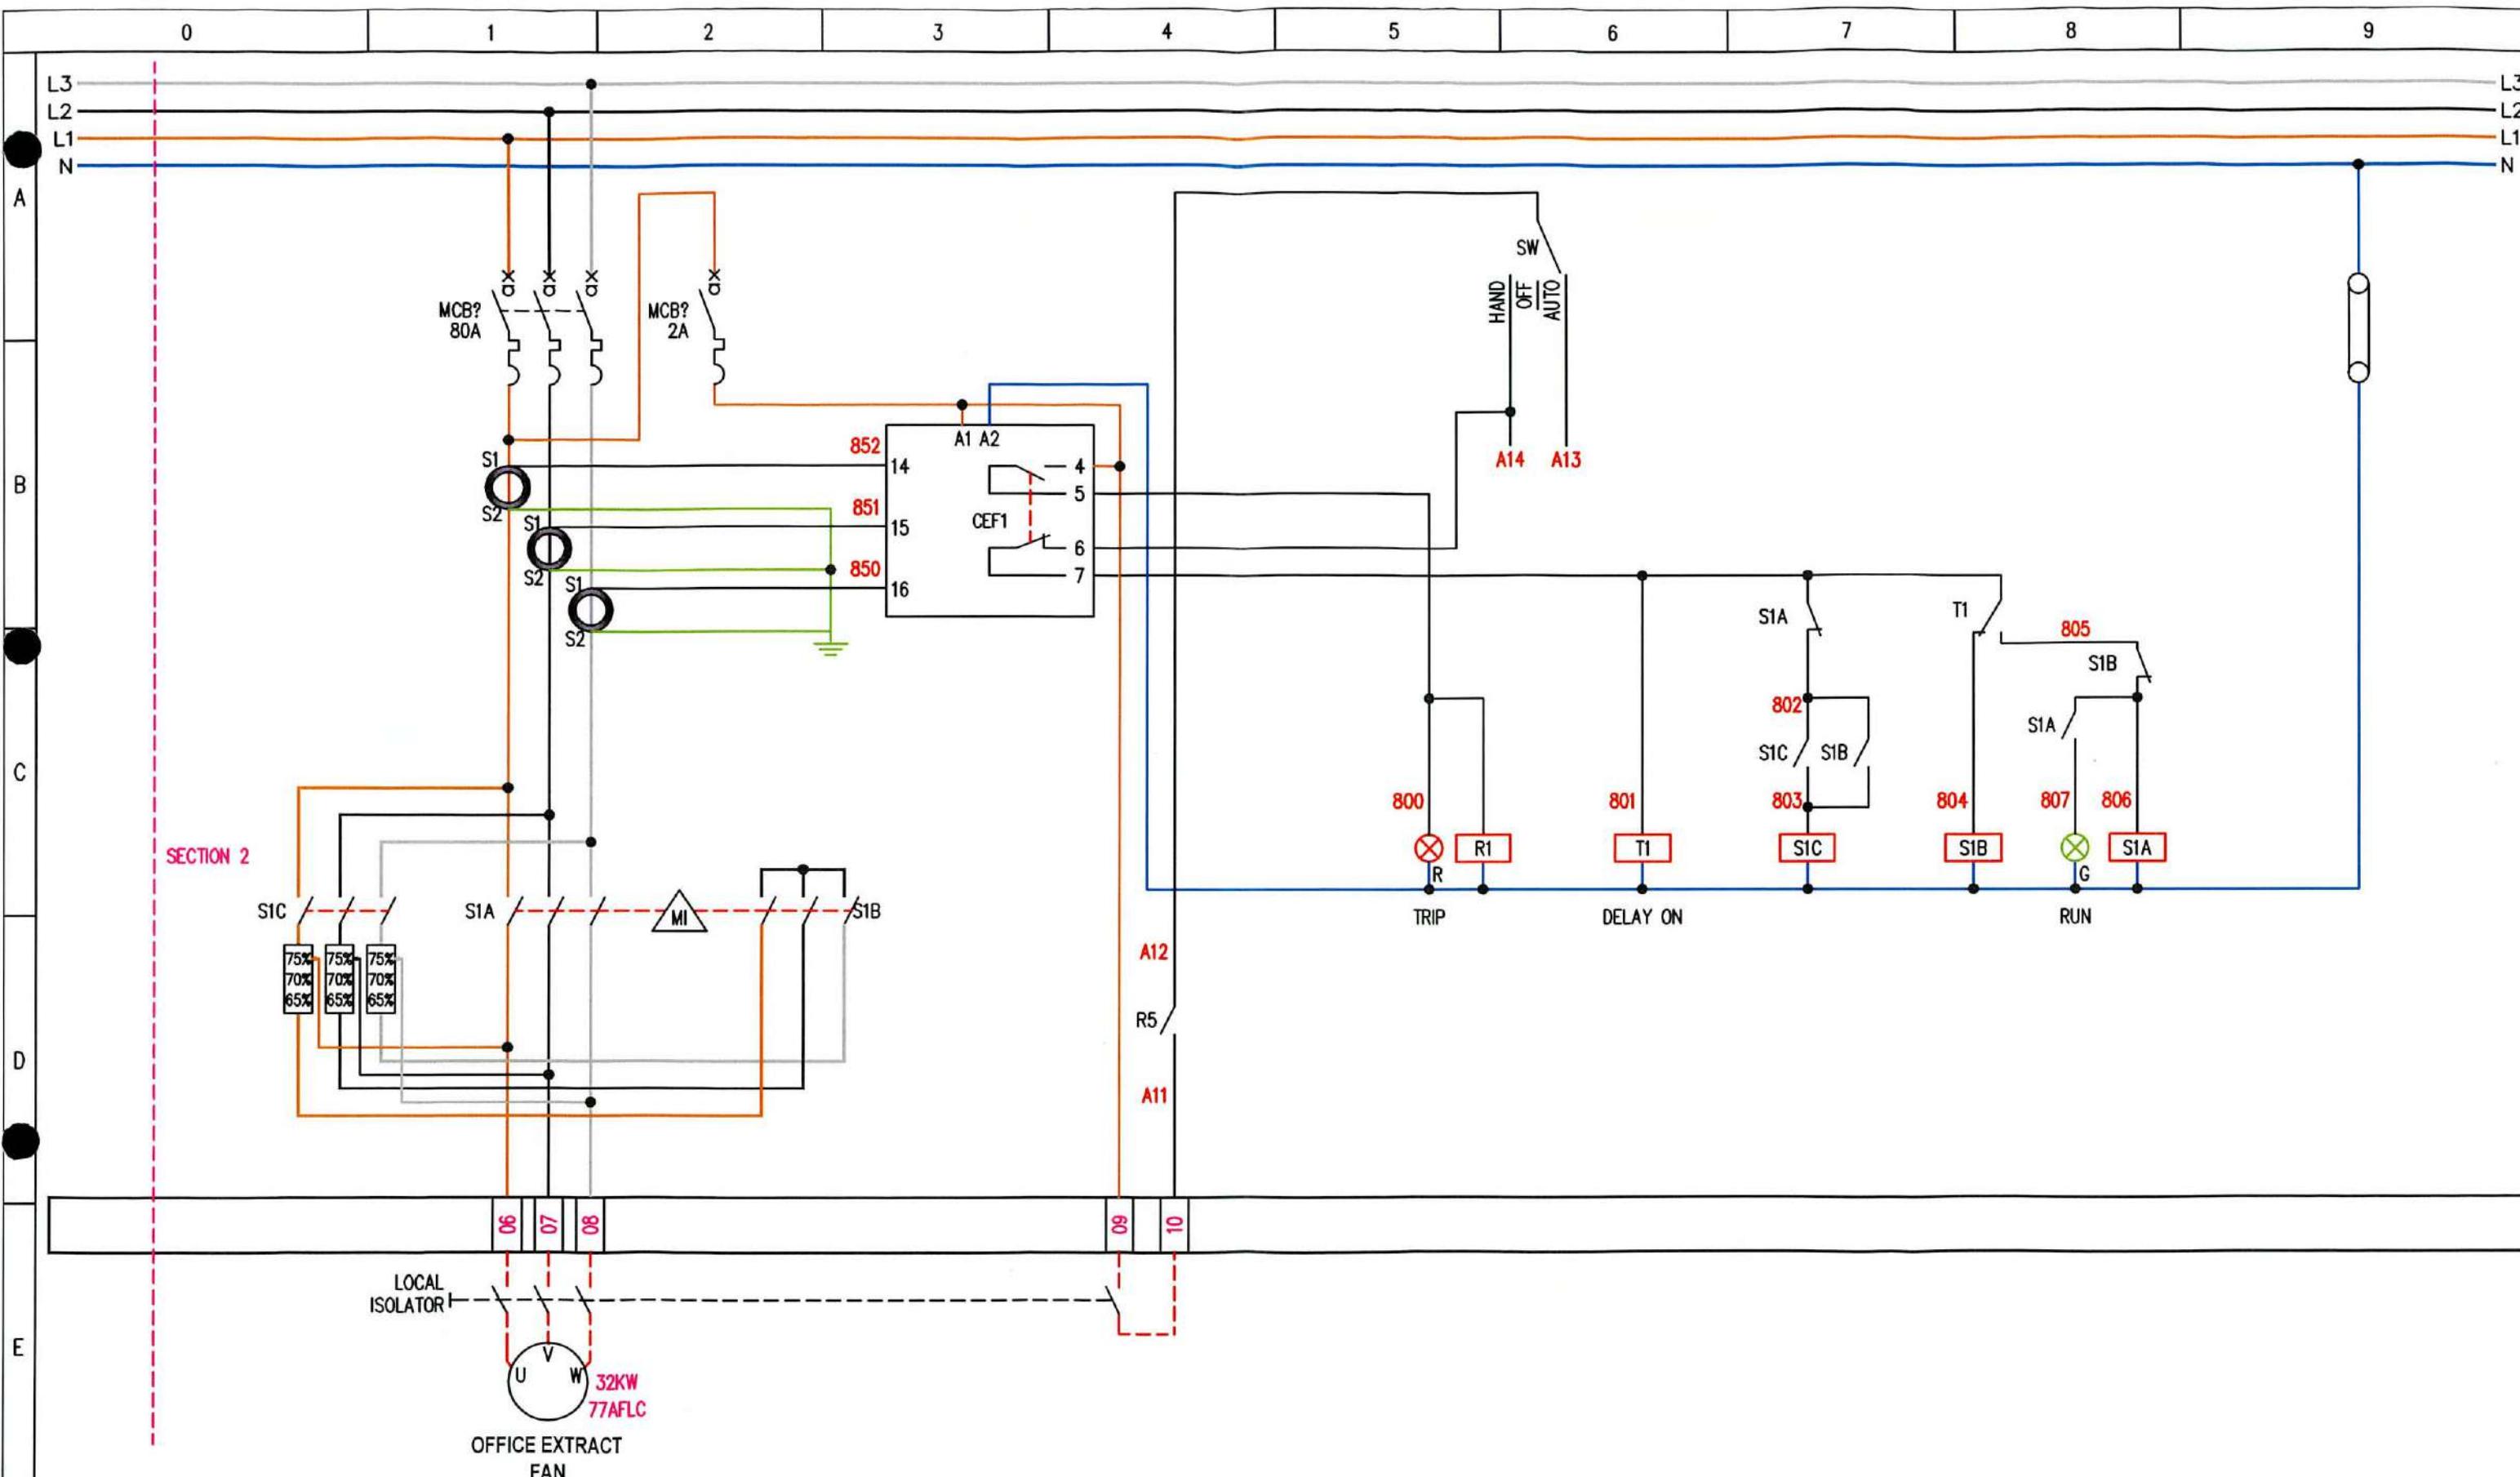

		DRAWN BY			CHECKED BY			DRAWN BY			CHECKED BY		
<input checked="" type="radio"/> PROVISIONAL <input checked="" type="radio"/> AS BUILT <input checked="" type="radio"/> FOR APPROVAL <input checked="" type="radio"/> AS FITTED <input checked="" type="radio"/> ISSUED FOR CONSTRUCTION		REVISION No	DESCRIPTION OF REVISION		DATE	DATE	REVISION No	DESCRIPTION OF REVISION		STATUS	DATE	DATE	
	0	PROVISIONAL		RFD 13/05/21			4						DRG No.6082-15 SHT. 3 of 21 PROJECT No.6082
	1	AS COMMISSIONED		RFD 19/05/21			5						TITLE EXCHEQUER COURT
	2						6						PANEL TITLE EXISTING SOUTH ROOF CONTROL PANEL
	3						7						CLIENT

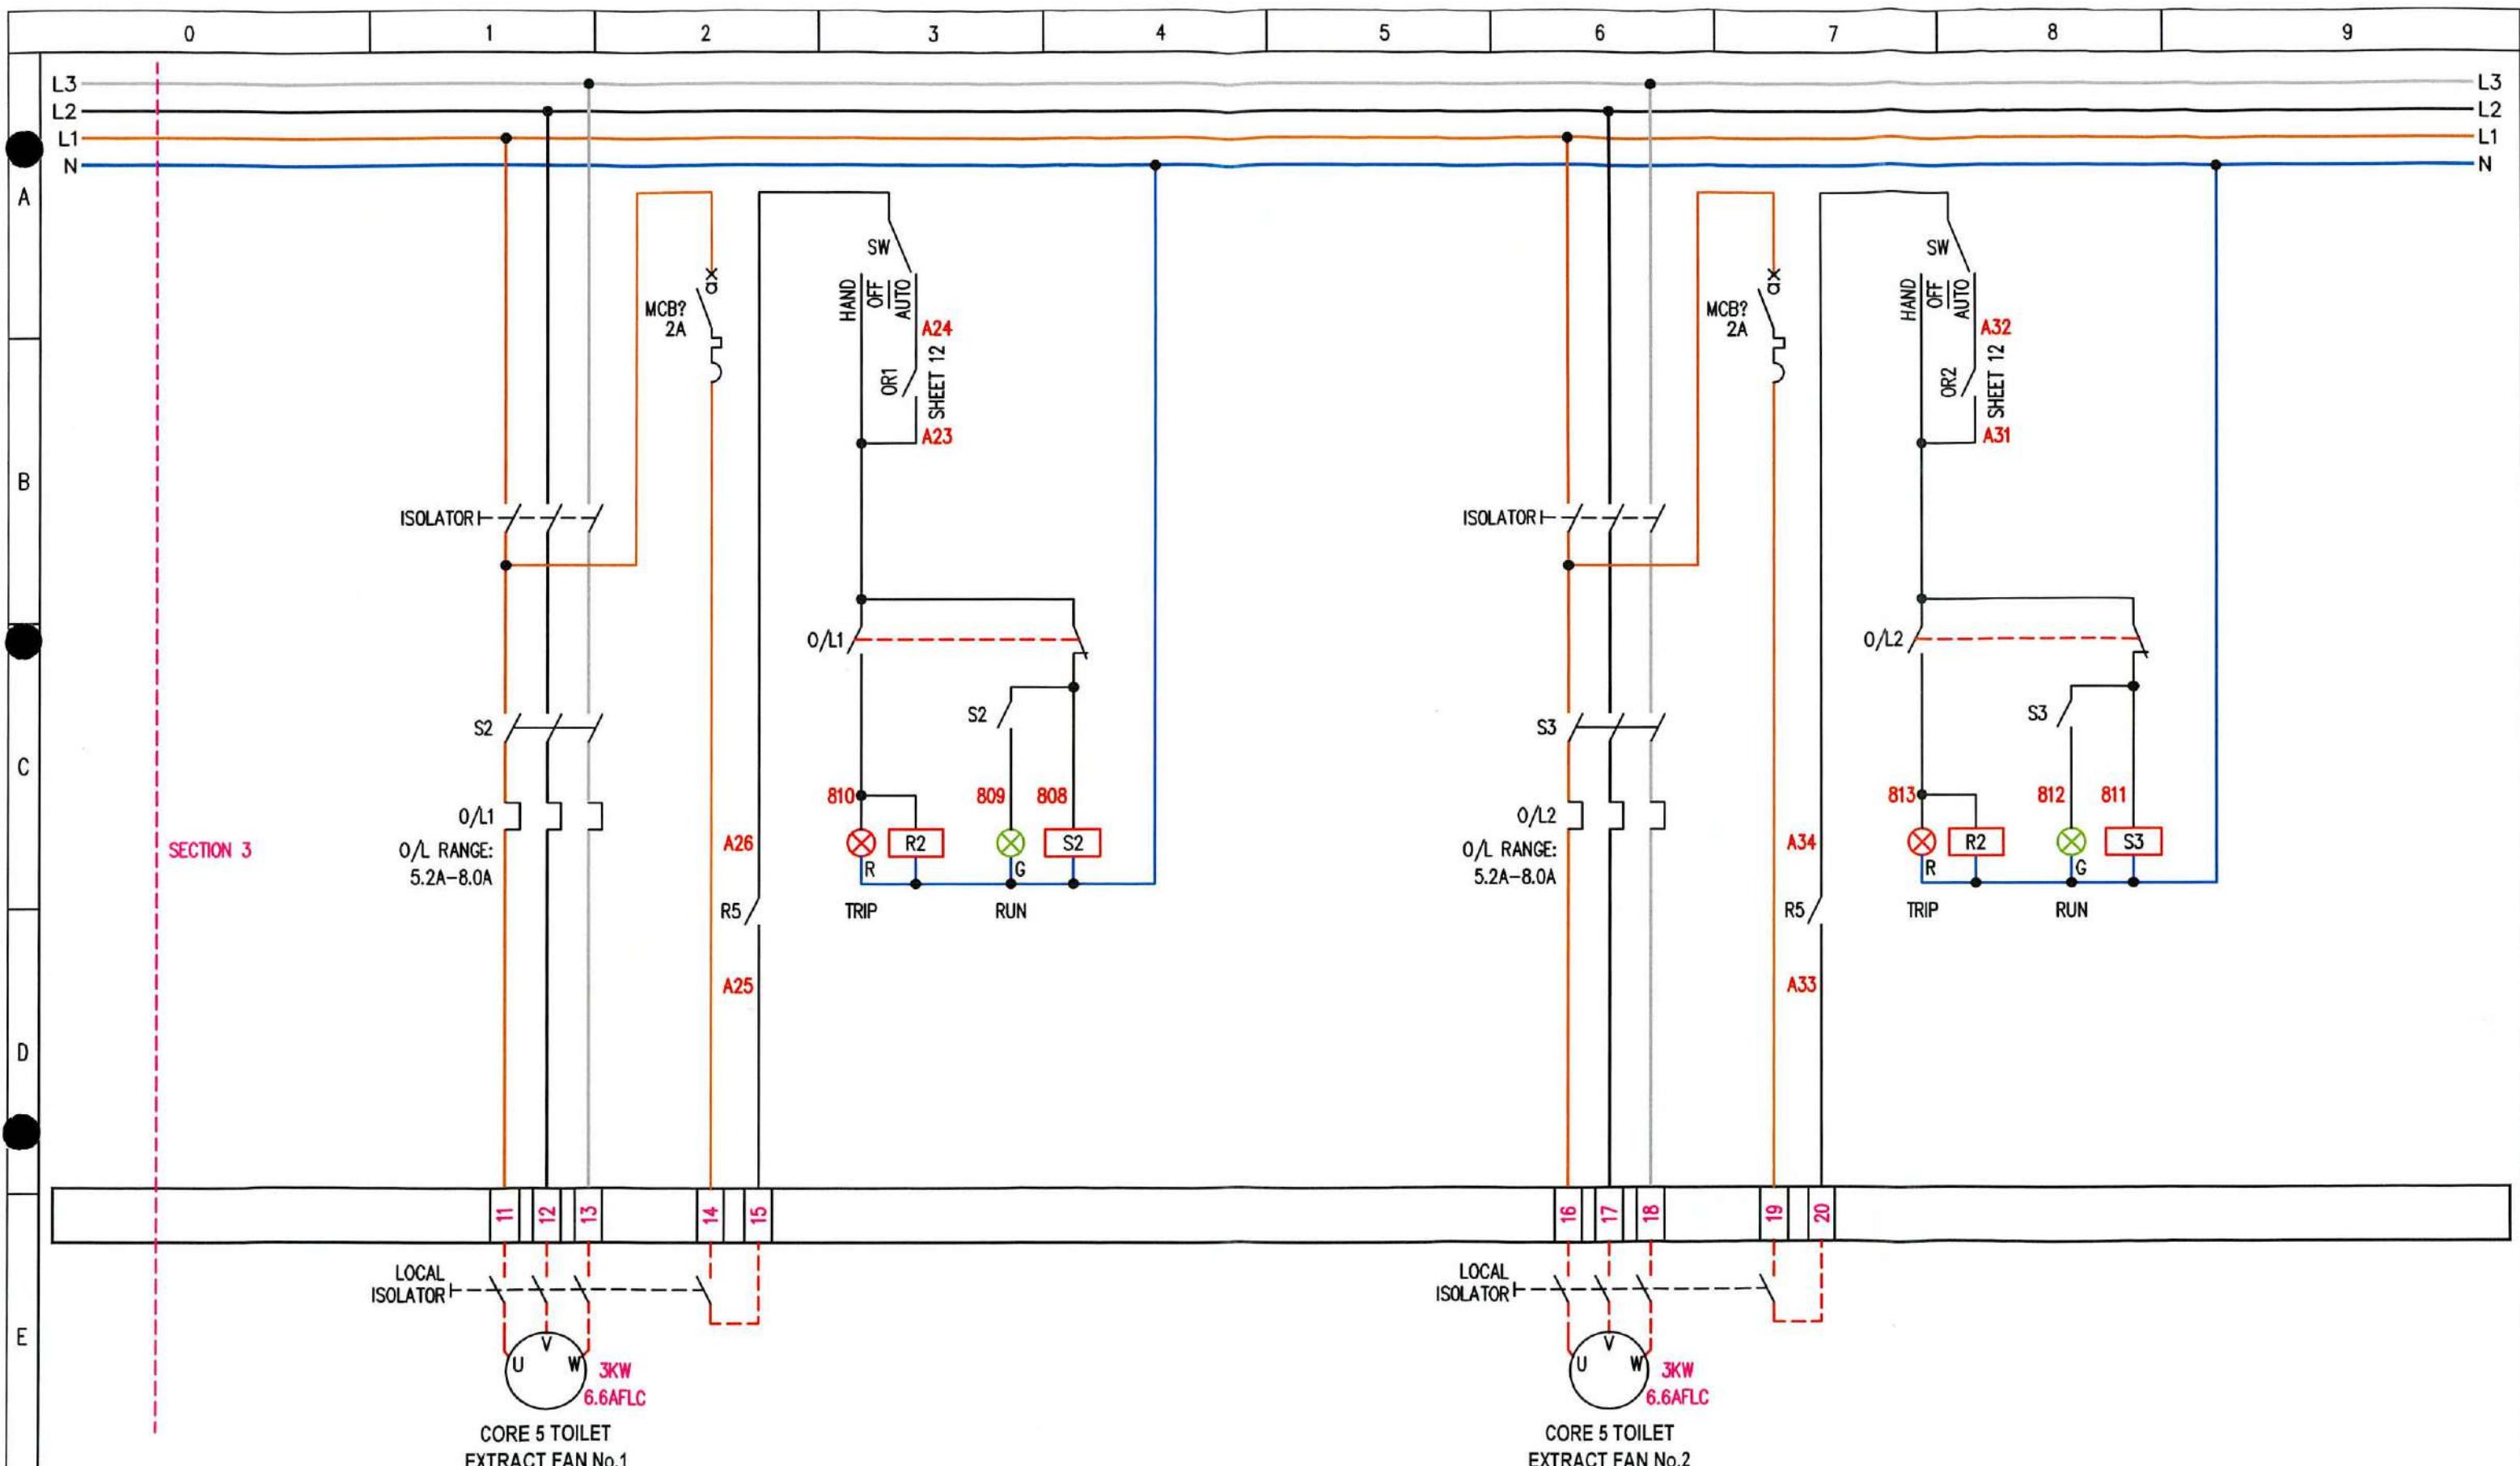


PROVISIONAL FOR APPROVAL ISSUED FOR CONSTRUCTION	AS BUILT AS FITTED	REVISION No	DESCRIPTION OF REVISION	DRAWN BY DATE	CHECKED BY DATE	REVISION No	DESCRIPTION OF REVISION	STATUS	DRAWN BY DATE	CHECKED BY DATE	DRG No.6082-15 PROJECT No.6082	SHT. 4 of 21	REV 1 ©
		0	PROVISIONAL	RFD 13/05/21		4							
		1	AS COMMISSIONED	RFD 19/05/21		5							
		2				6							
		3				7							
bges group			TITLE		EXCHEQUER COURT		PANEL TITLE		EXISTING SOUTH ROOF CONTROL PANEL		CLIENT		

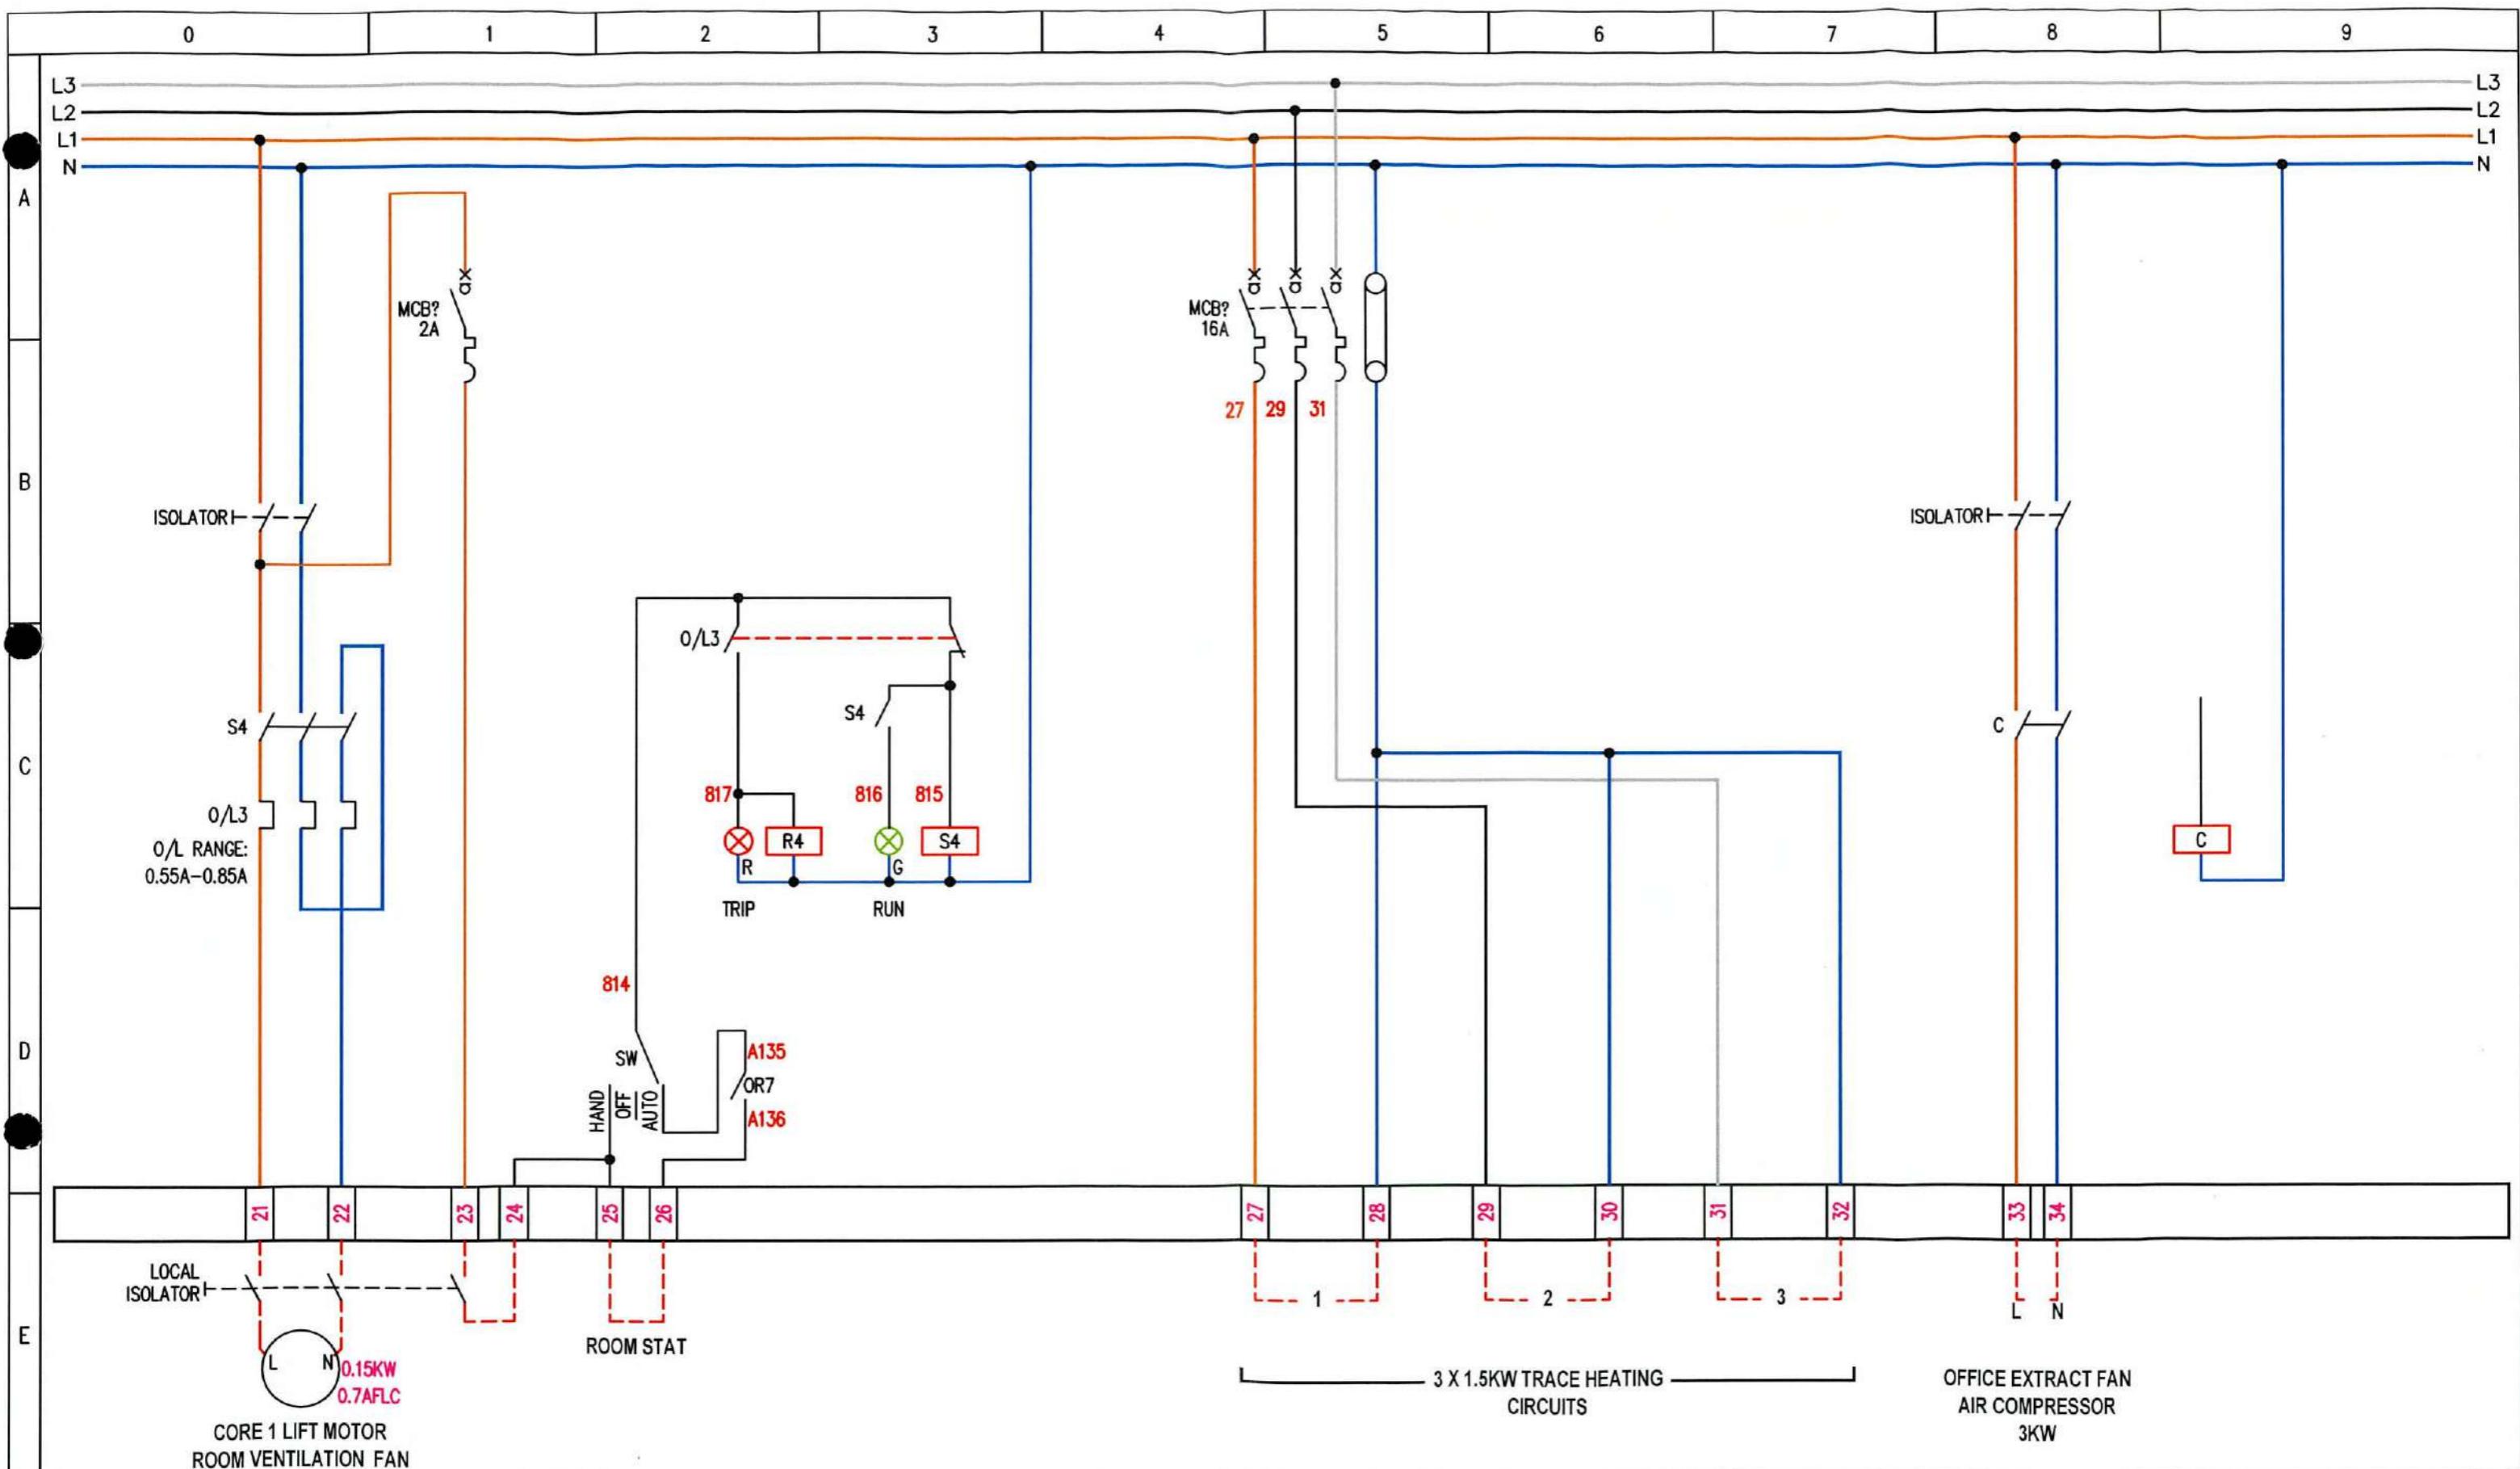

PROVISIONAL	AS BUILT	REVISION No	DESCRIPTION OF REVISION	DRAWN BY	CHECKED BY	REVISION No	DESCRIPTION OF REVISION	STATUS	DRAWN BY	CHECKED BY	REVISION No	DRG No.	SHT.	of	REV
FOR APPROVAL	AS FITTED	0	PROVISIONAL	RFD 13/05/21		4						6082-15	5	21	1
ISSUED FOR CONSTRUCTION		1	AS COMMISSIONED	RFD 19/05/21		5						PROJECT No.	6082		
		2				6						TITLE	EXCHEQUER COURT		
		3				7						PANEL TITLE	EXISTING SOUTH ROOF CONTROL PANEL		
												CLIENT			


bges group

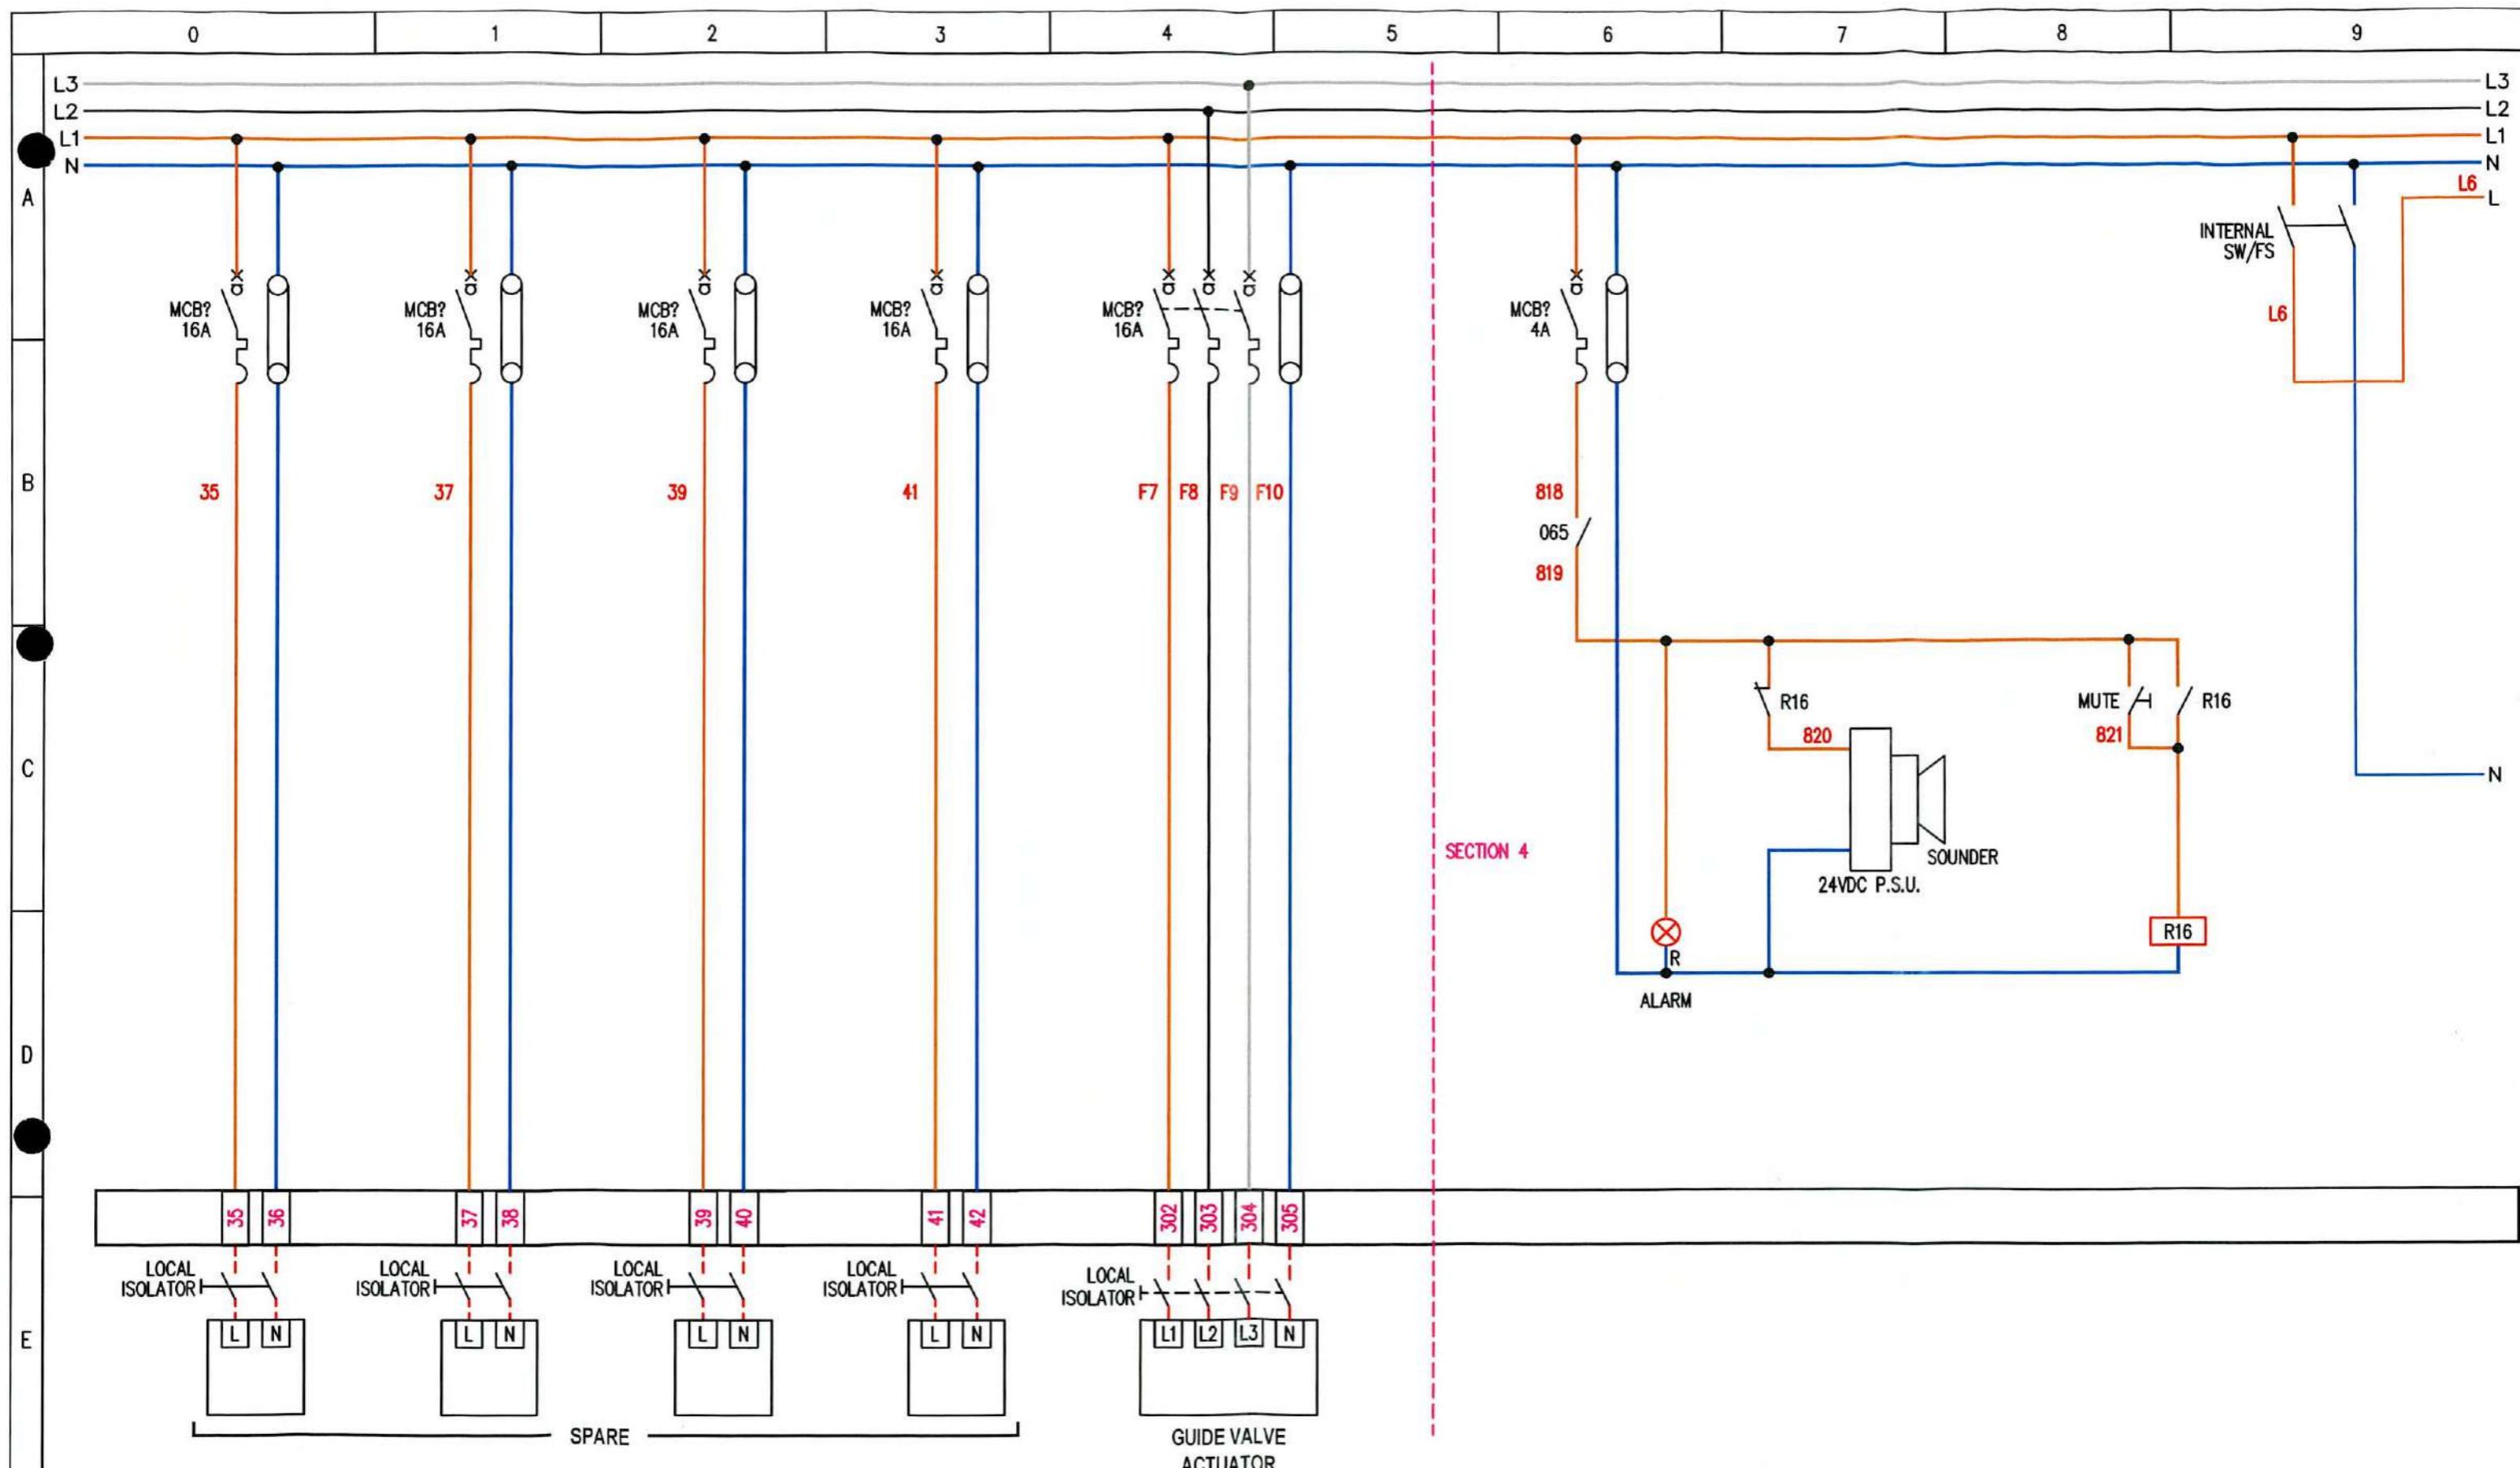

● PROVISIONAL
 ● AS BUILT
 ● FOR APPROVAL
 ● AS FITTED
 ● ISSUED FOR
 CONSTRUCTION




REVISION No	DESCRIPTION OF REVISION	DRAWN BY RFD DATE	CHECKED BY DATE	REVISION No	DESCRIPTION OF REVISION	STATUS	DRAWN BY RFD DATE	CHECKED BY DATE	DRG No.6082-15 PROJECT No.6082	SHT. 6 of 21	REV 1 ©
0	PROVISIONAL	RFD 13/05/21		4							
1	AS COMMISSIONED	RFD 19/05/21		5							
2				6							
3				7							
									TITLE	EXCHEQUER COURT	
									PANEL TITLE	EXISTING SOUTH ROOF CONTROL PANEL	
									CLIENT		

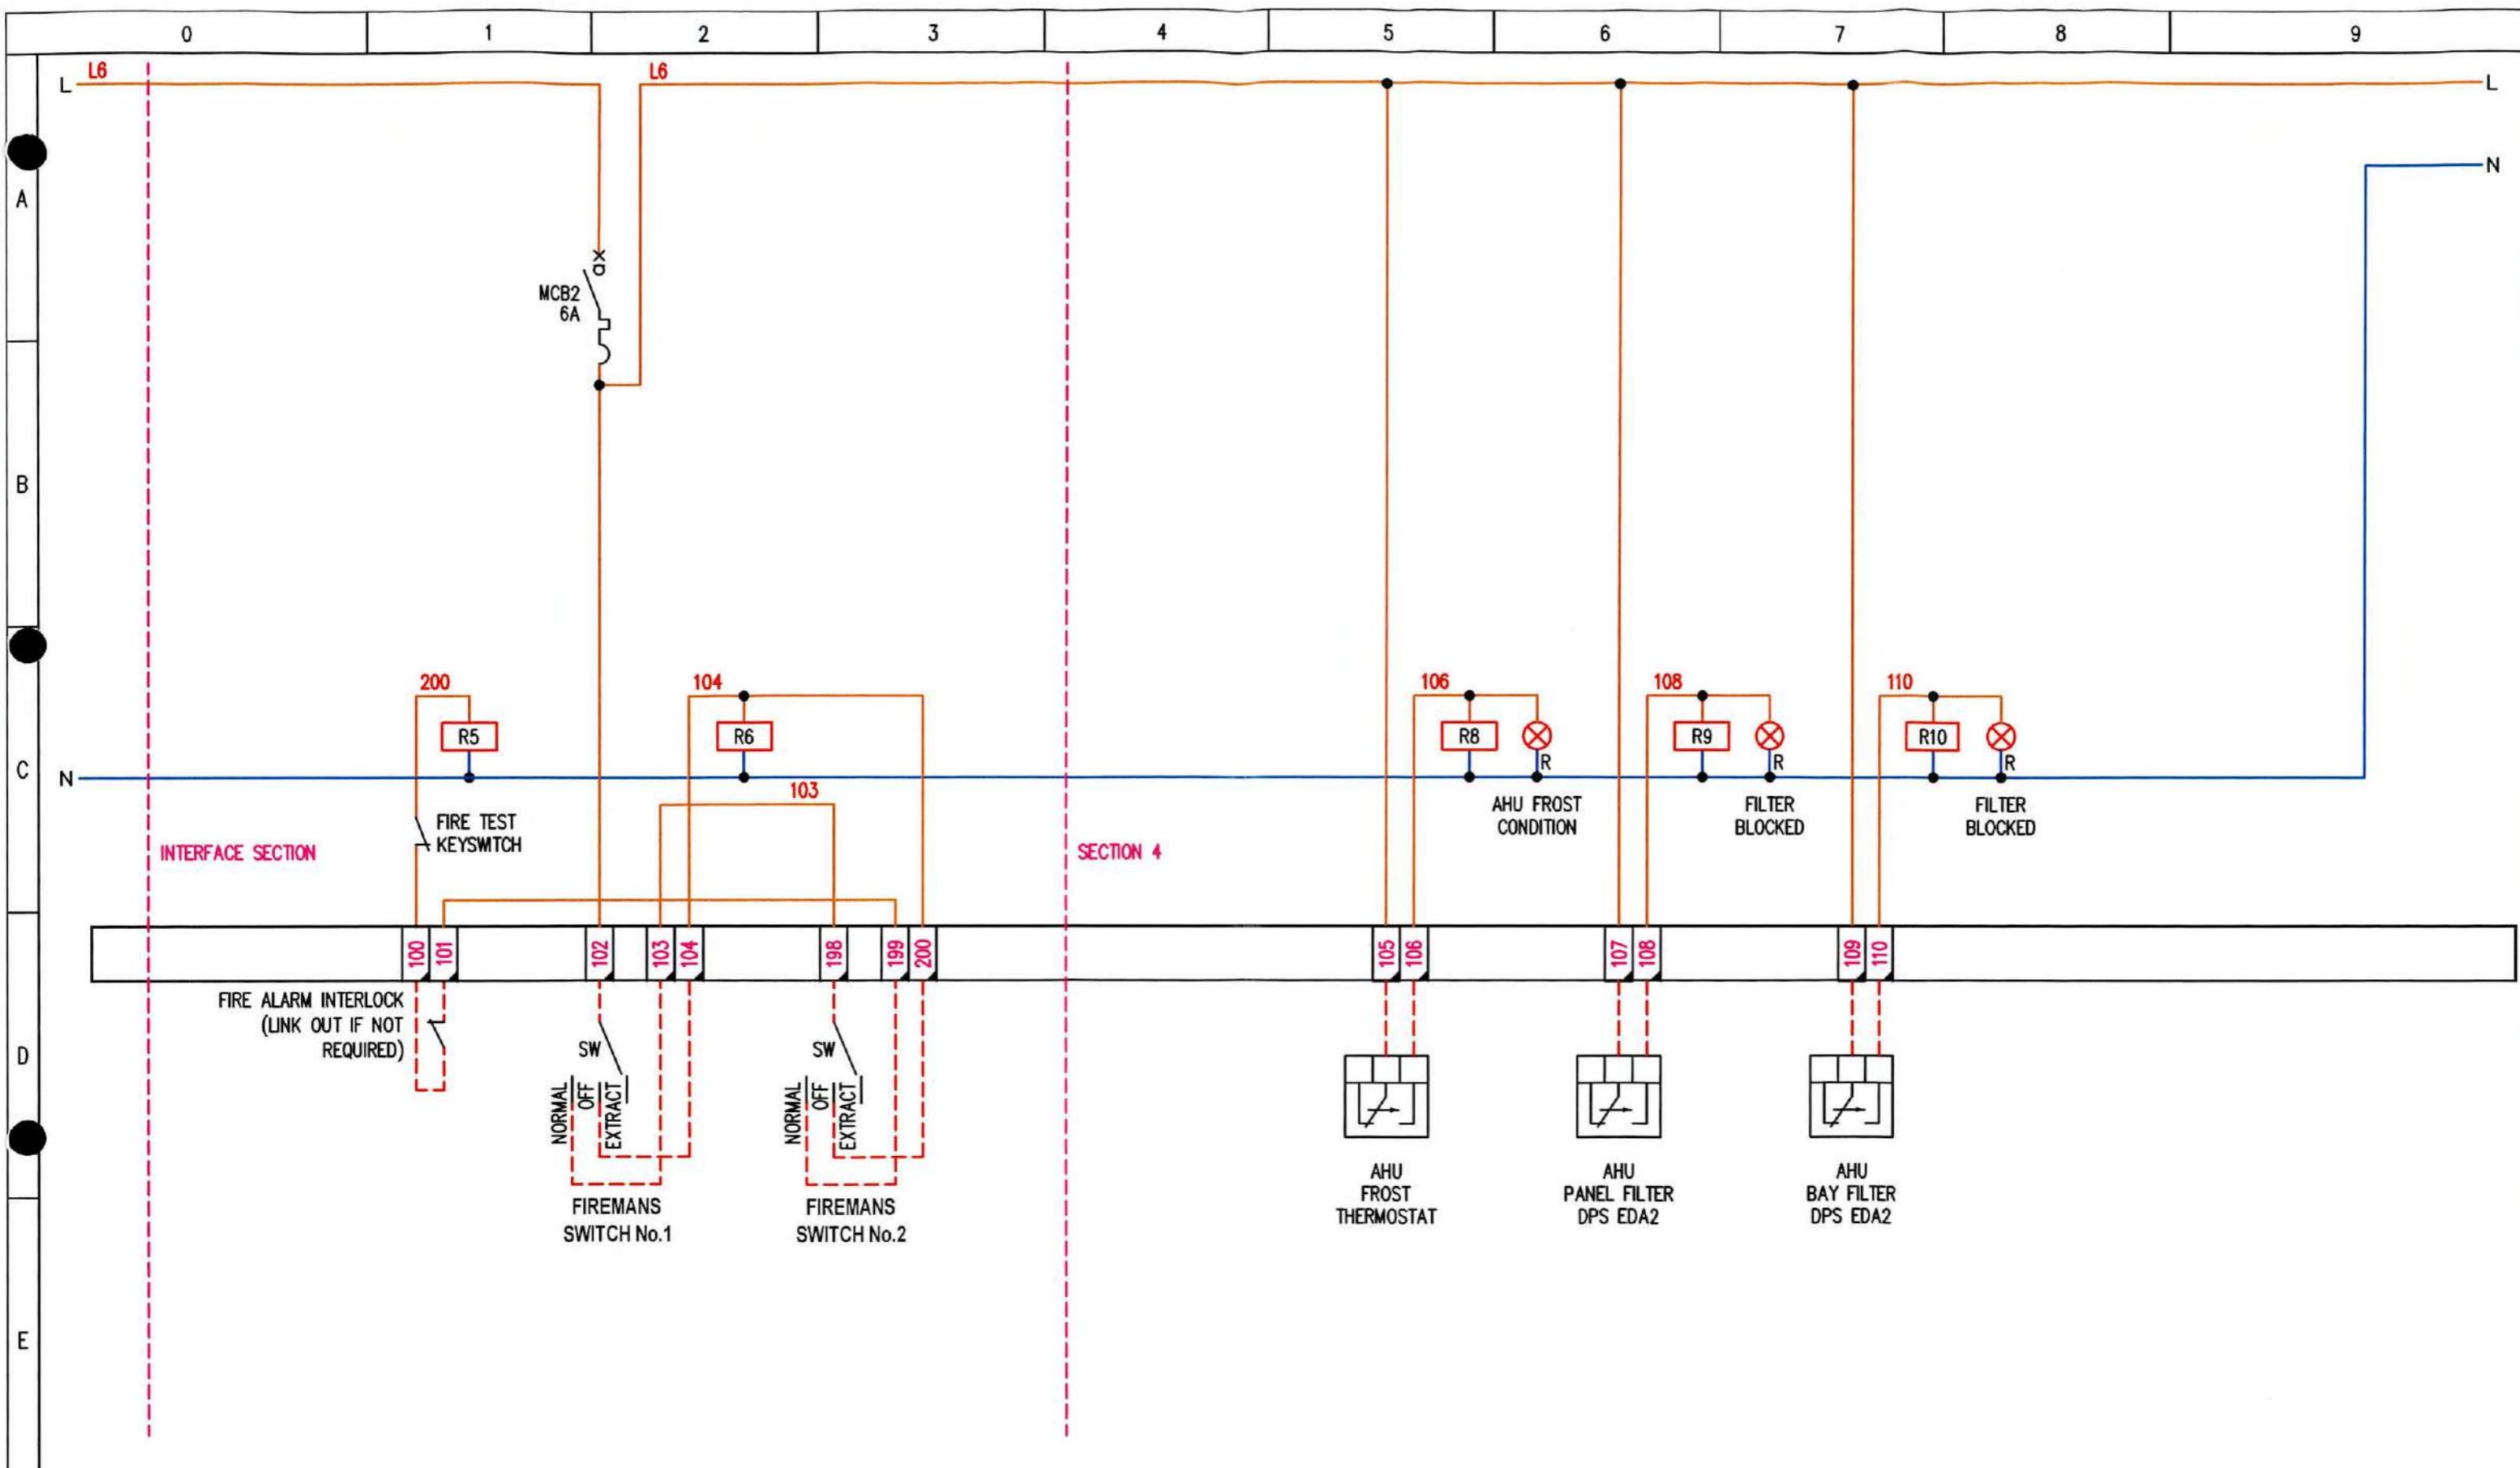

PROVISIONAL FOR APPROVAL ISSUED FOR CONSTRUCTION		AS BUILT AS FITTED	REVISION No	DESCRIPTION OF REVISION	DRAWN BY DATE	CHECKED BY DATE	REVISION No	DESCRIPTION OF REVISION	STATUS	DRAWN BY DATE	CHECKED BY DATE	DRG No.6082-15 PROJECT No.6082	SHT. 7 of 21	REV 1 ©
			0	PROVISIONAL	RFD 13/05/21		4					TITLE	EXCHEQUER COURT	
			1	AS COMMISSIONED	RFD 19/05/21		5					PANEL TITLE	EXISTING SOUTH ROOF CONTROL PANEL	
			2				6					CLIENT		
			3				7							

0 1 2 3 4 5 6 7 8 9

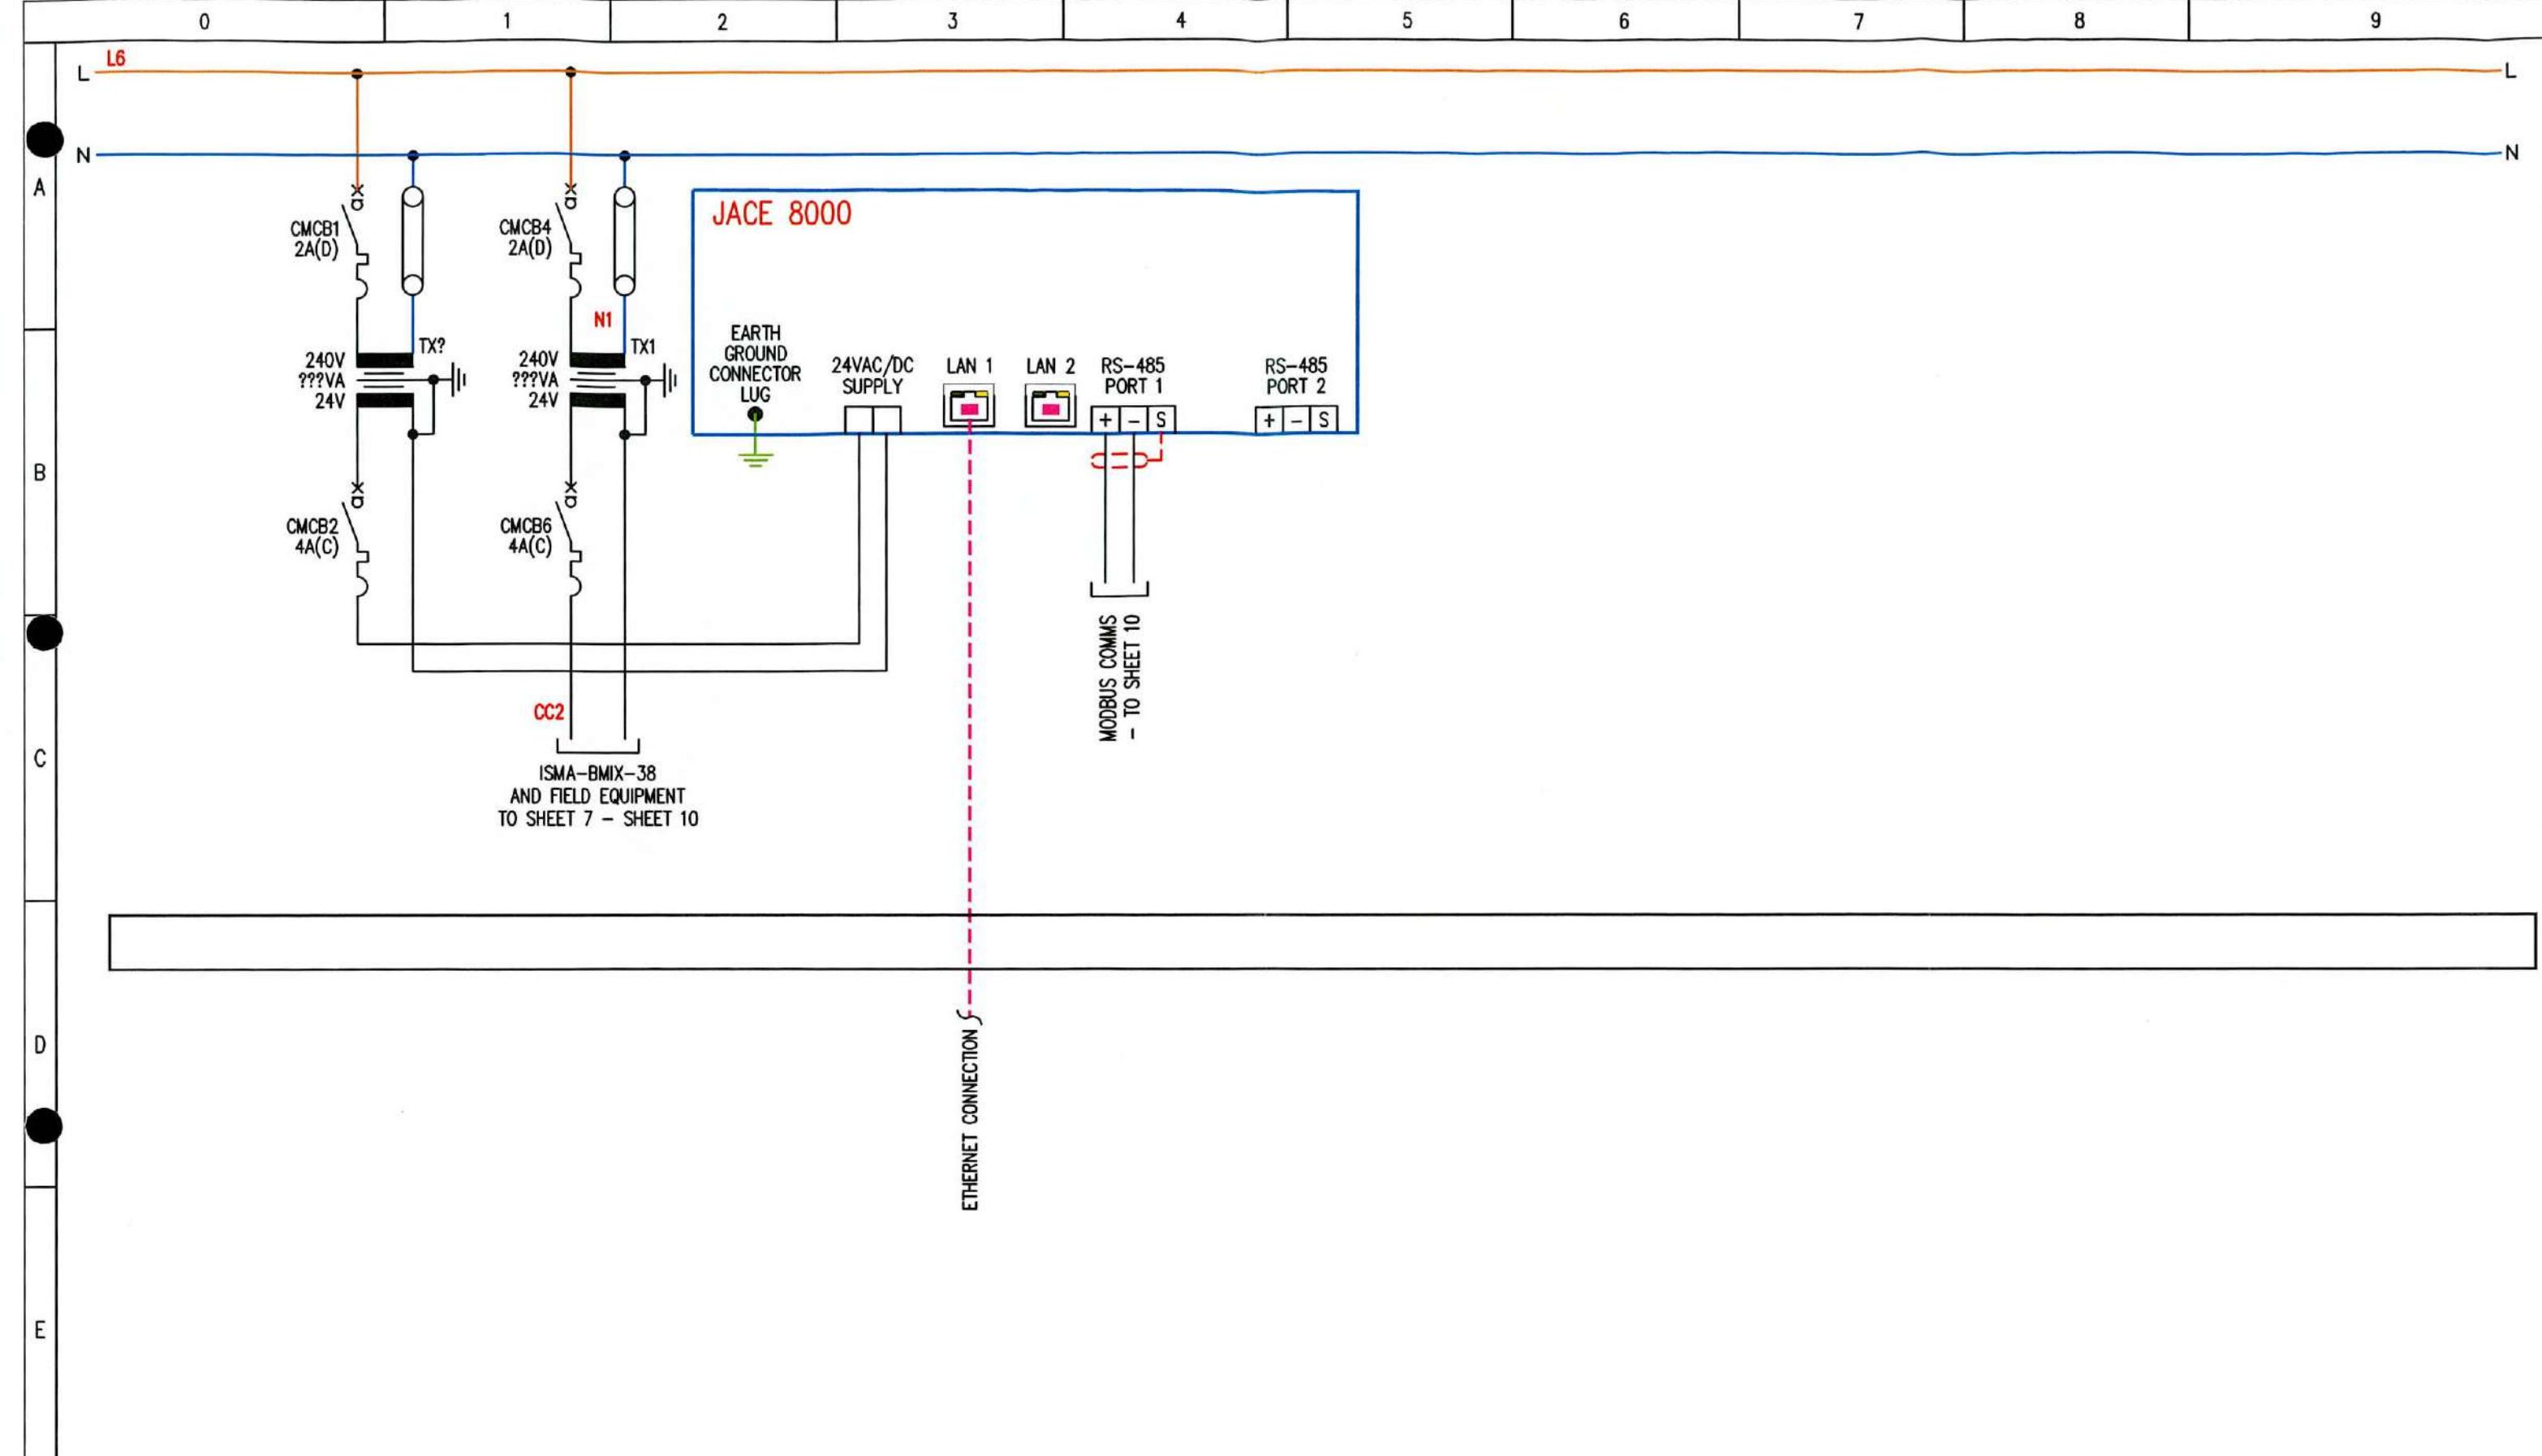

PROVISIONAL FOR APPROVAL ISSUED FOR CONSTRUCTION	AS BUILT AS FITTED	REVISION No	DESCRIPTION OF REVISION	DRAWN BY DATE	CHECKED BY DATE	REVISION No	DESCRIPTION OF REVISION	STATUS	DRAWN BY DATE	CHECKED BY DATE	DRG No.6082-15 PROJECT No.6082	SHT. 8 of 21	REV 1 ©
		0	PROVISIONAL	RFD 13/05/21		4					TITLE	EXCHEQUER COURT	
		1	AS COMMISSIONED	RFD 19/05/21		5					PANEL TITLE	EXISTING SOUTH ROOF CONTROL PANEL	
		2				6					CLIENT		
		3				7							

SPARE PAGE
ANTICIPATED USE

A

B

C


D

E

		REVISION No	DESCRIPTION OF REVISION		DRAWN BY DATE	CHECKED BY DATE	REVISION No	DESCRIPTION OF REVISION		STATUS	DRAWN BY DATE	CHECKED BY DATE	DRG No.6082-15 SHT. 9 of 21 PROJECT No.6082	REV 1 ©
● PROVISIONAL ● FOR APPROVAL ● ISSUED FOR CONSTRUCTION	● AS BUILT ● AS FITTED	0	PROVISIONAL		RFD 13/05/21		4						TITLE	EXCHEQUER COURT
		1	AS COMMISSIONED		RFD 19/05/21		5						PANEL TITLE	EXISTING SOUTH ROOF CONTROL PANEL
		2					6						CLIENT	
		3					7							




0 1 2 3 4 5 6 7 8 9

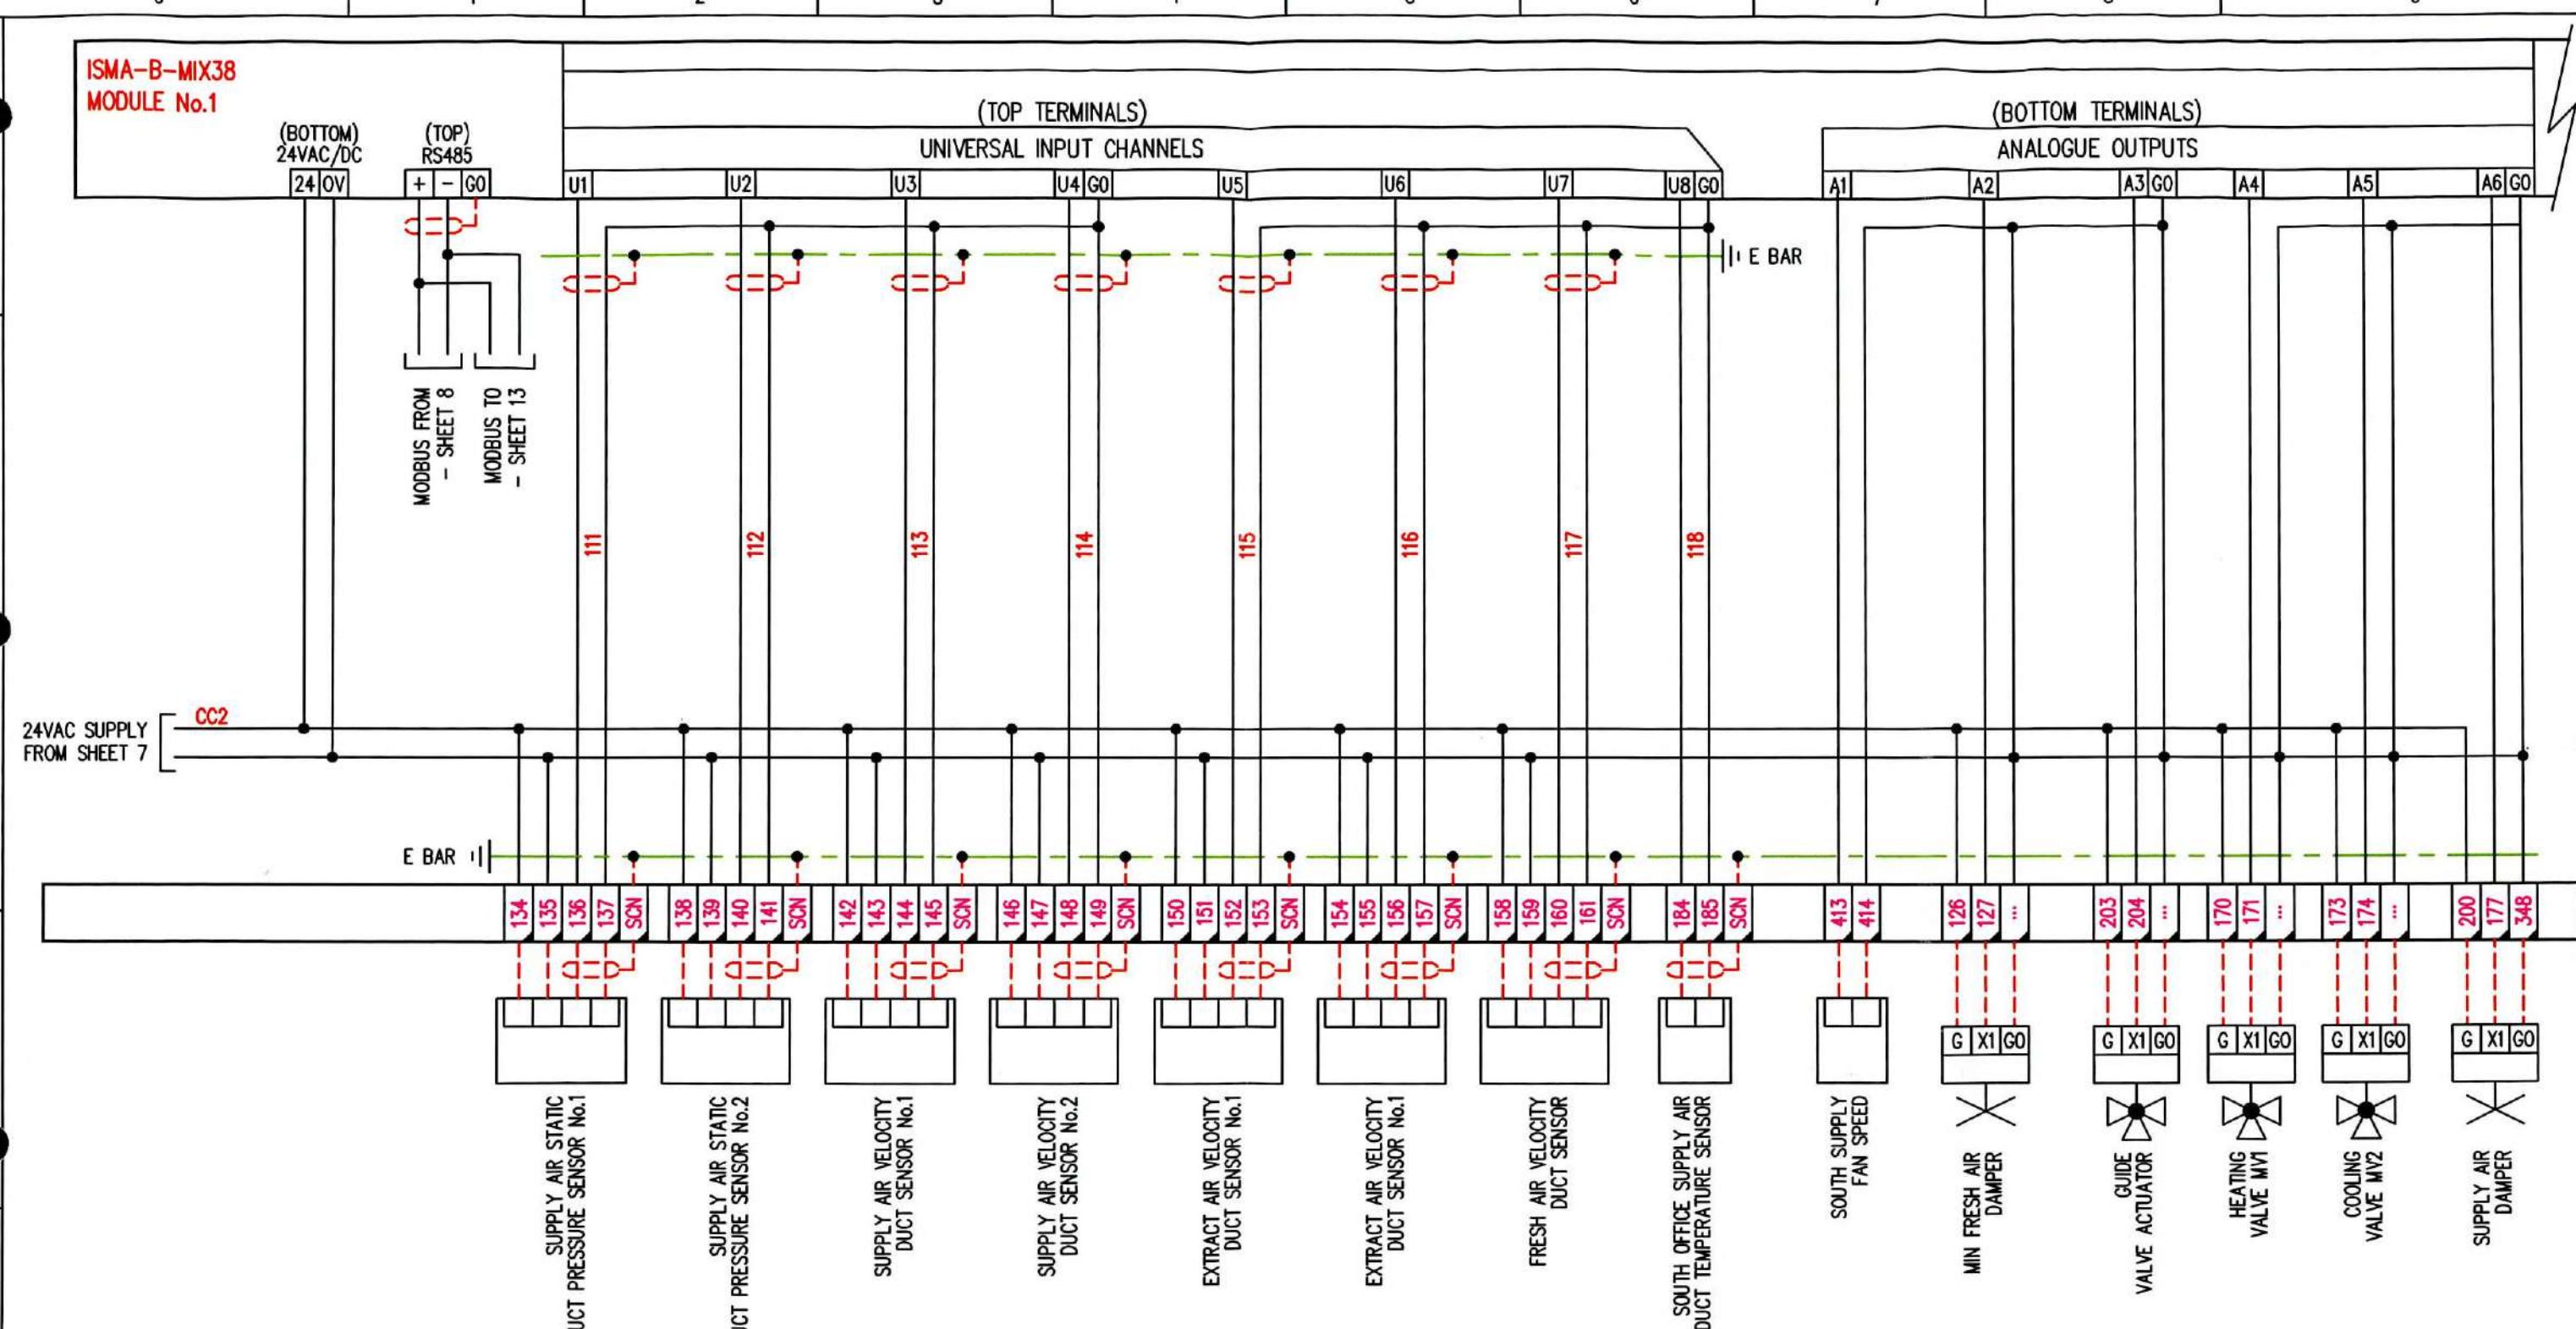

PROVISIONAL FOR APPROVAL ISSUED FOR CONSTRUCTION	AS BUILT AS FITTED	REVISION No	DESCRIPTION OF REVISION	DRAWN BY DATE	CHECKED BY DATE	REVISION No	DESCRIPTION OF REVISION	STATUS	DRAWN BY DATE	CHECKED BY DATE	DRG No.6082-15 PROJECT No.6082	SHT. 10 of 21	REV 1 ©
		0	PROVISIONAL	RFD 13/05/21		4					TITLE	EXCHEQUER COURT	
		1	AS COMMISSIONED	RFD 19/05/21		5					PANEL TITLE	EXISTING SOUTH ROOF CONTROL PANEL	
		2				6					CLIENT		
		3				7							


0 1 2 3 4 5 6 7 8 9

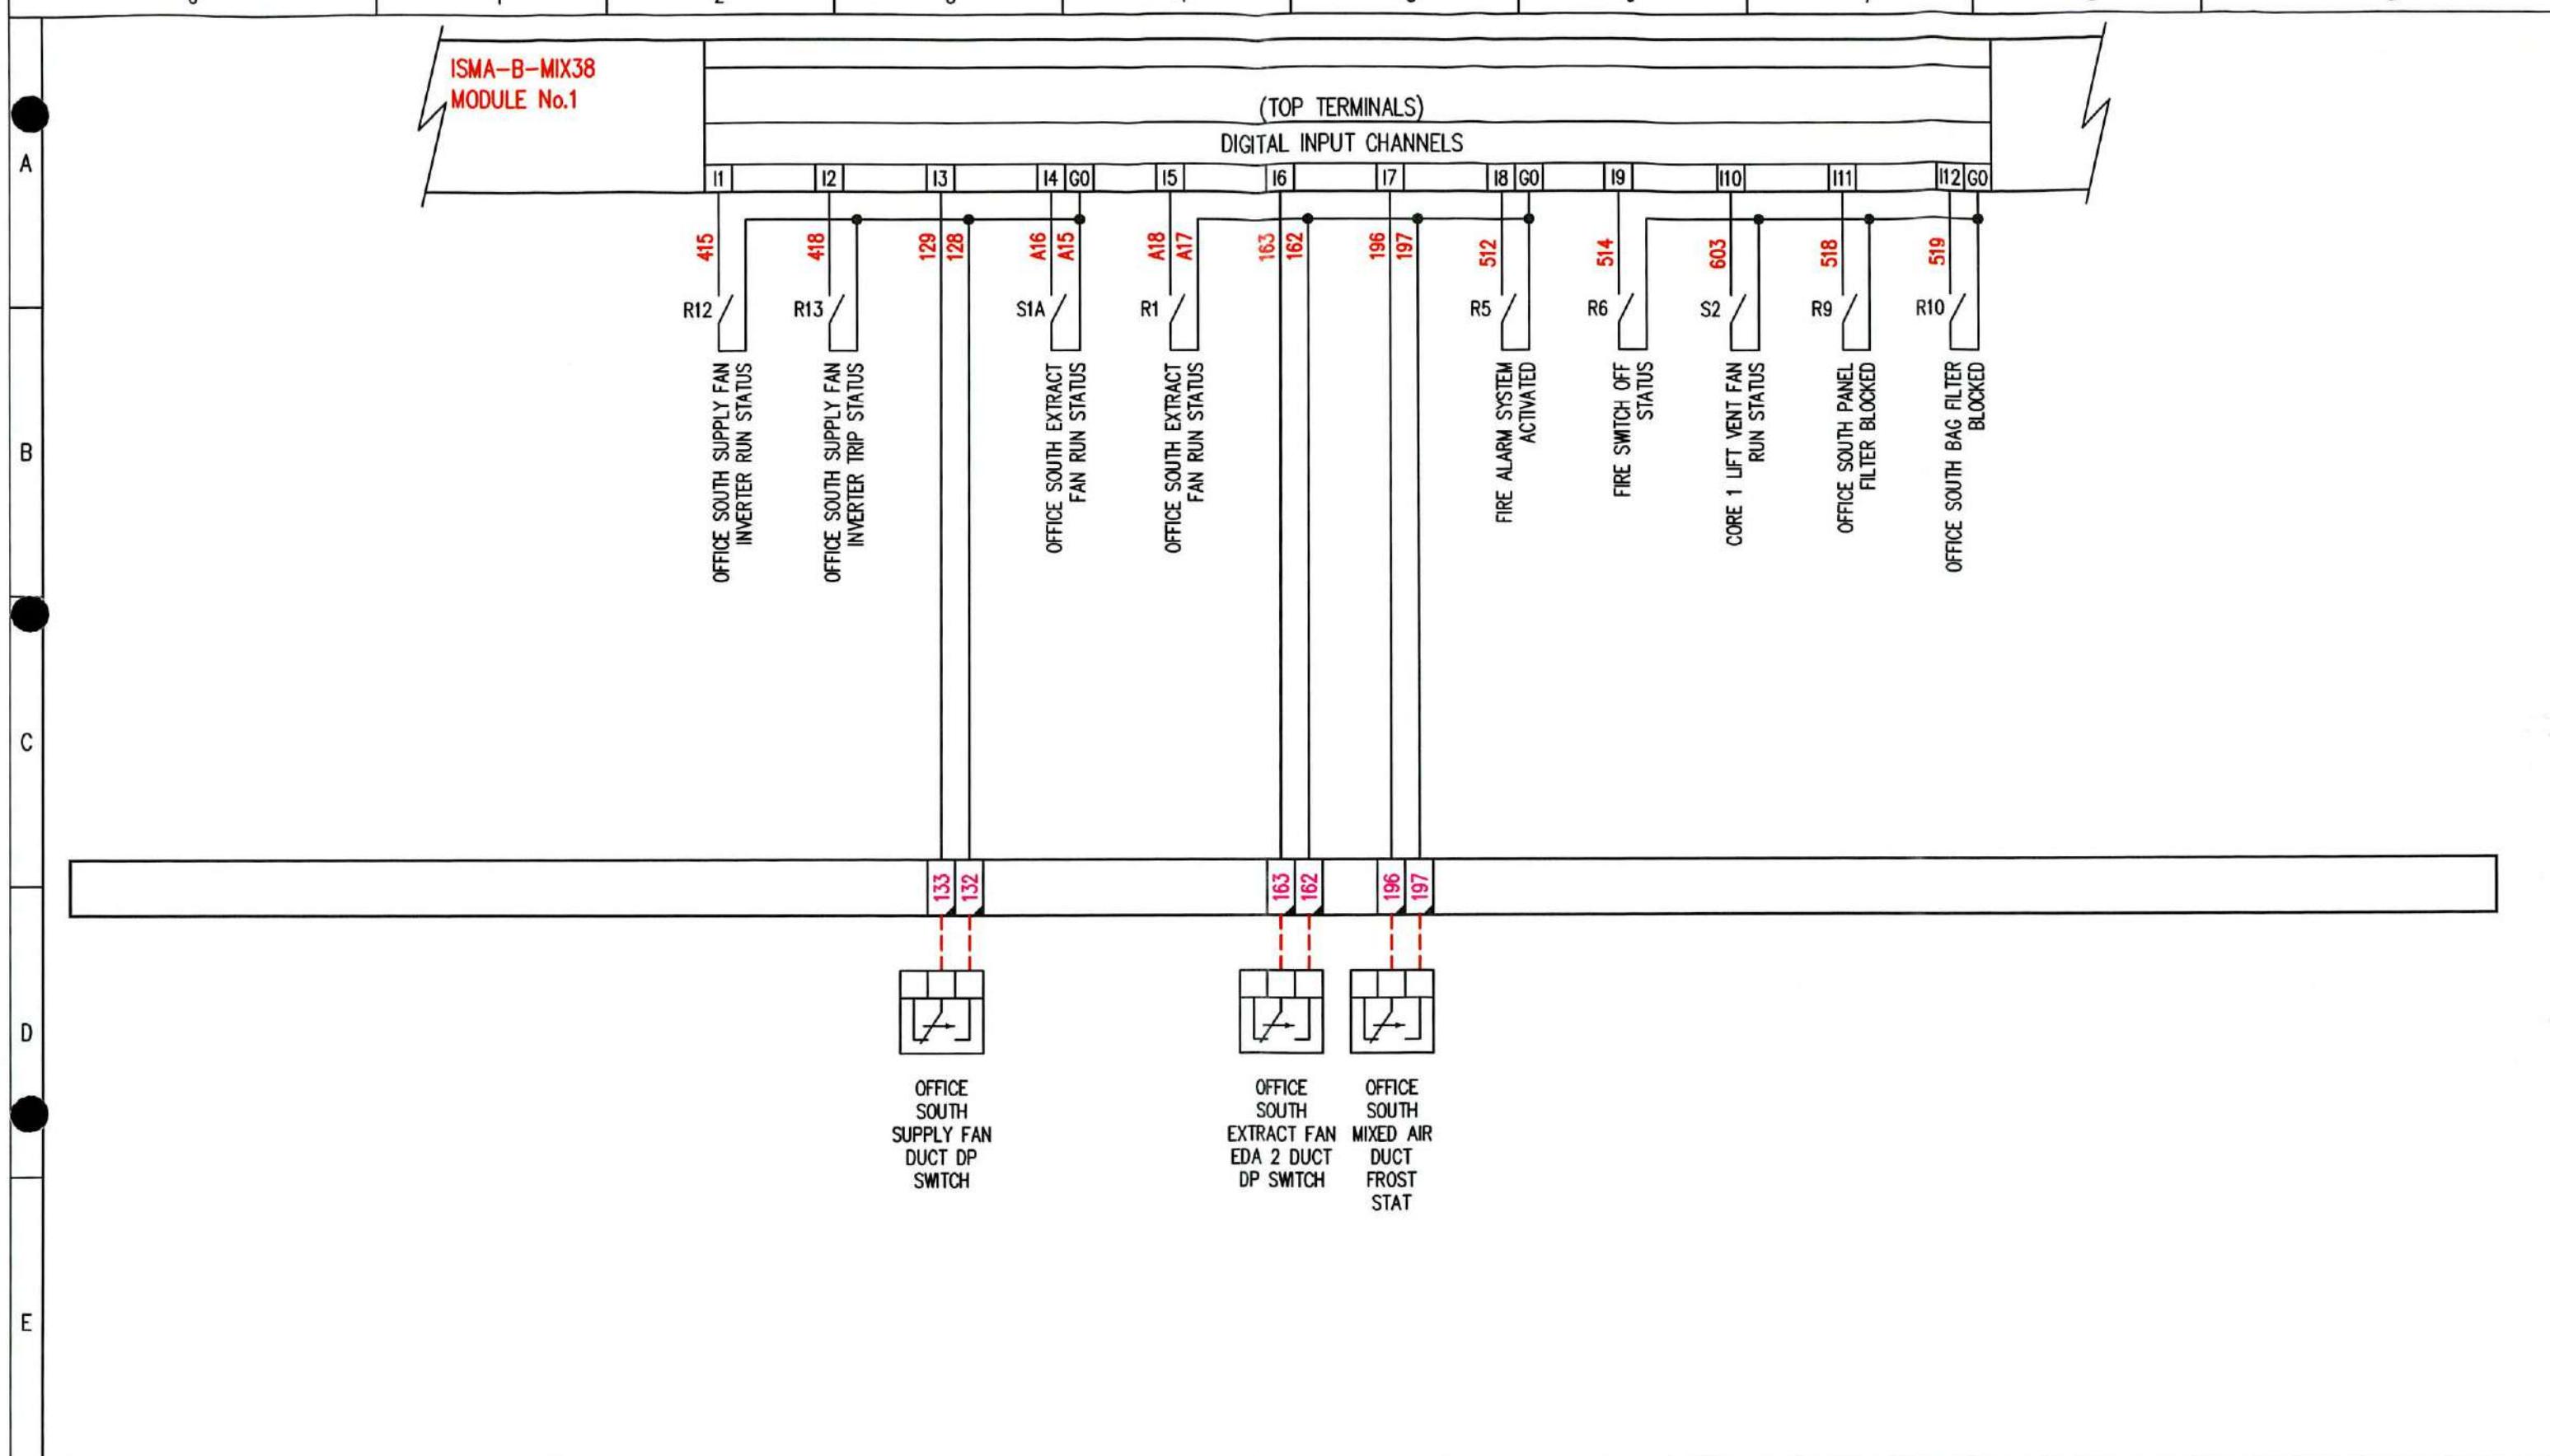

PROVISIONAL FOR APPROVAL ISSUED FOR CONSTRUCTION	AS BUILT AS FITTED	REVISION No	DESCRIPTION OF REVISION	DRAWN BY DATE	CHECKED BY DATE	REVISION No	DESCRIPTION OF REVISION	STATUS	DRAWN BY DATE	CHECKED BY DATE	DRG No.6082-15 PROJECT No.6082	SHT. 11 of 21	REV 1 ©
		0	PROVISIONAL	RFD 13/05/21		4							
		1	AS COMMISSIONED	RFD 19/05/21		5							
		2				6							
		3				7							

bges group


0 1 2 3 4 5 6 7 8 9

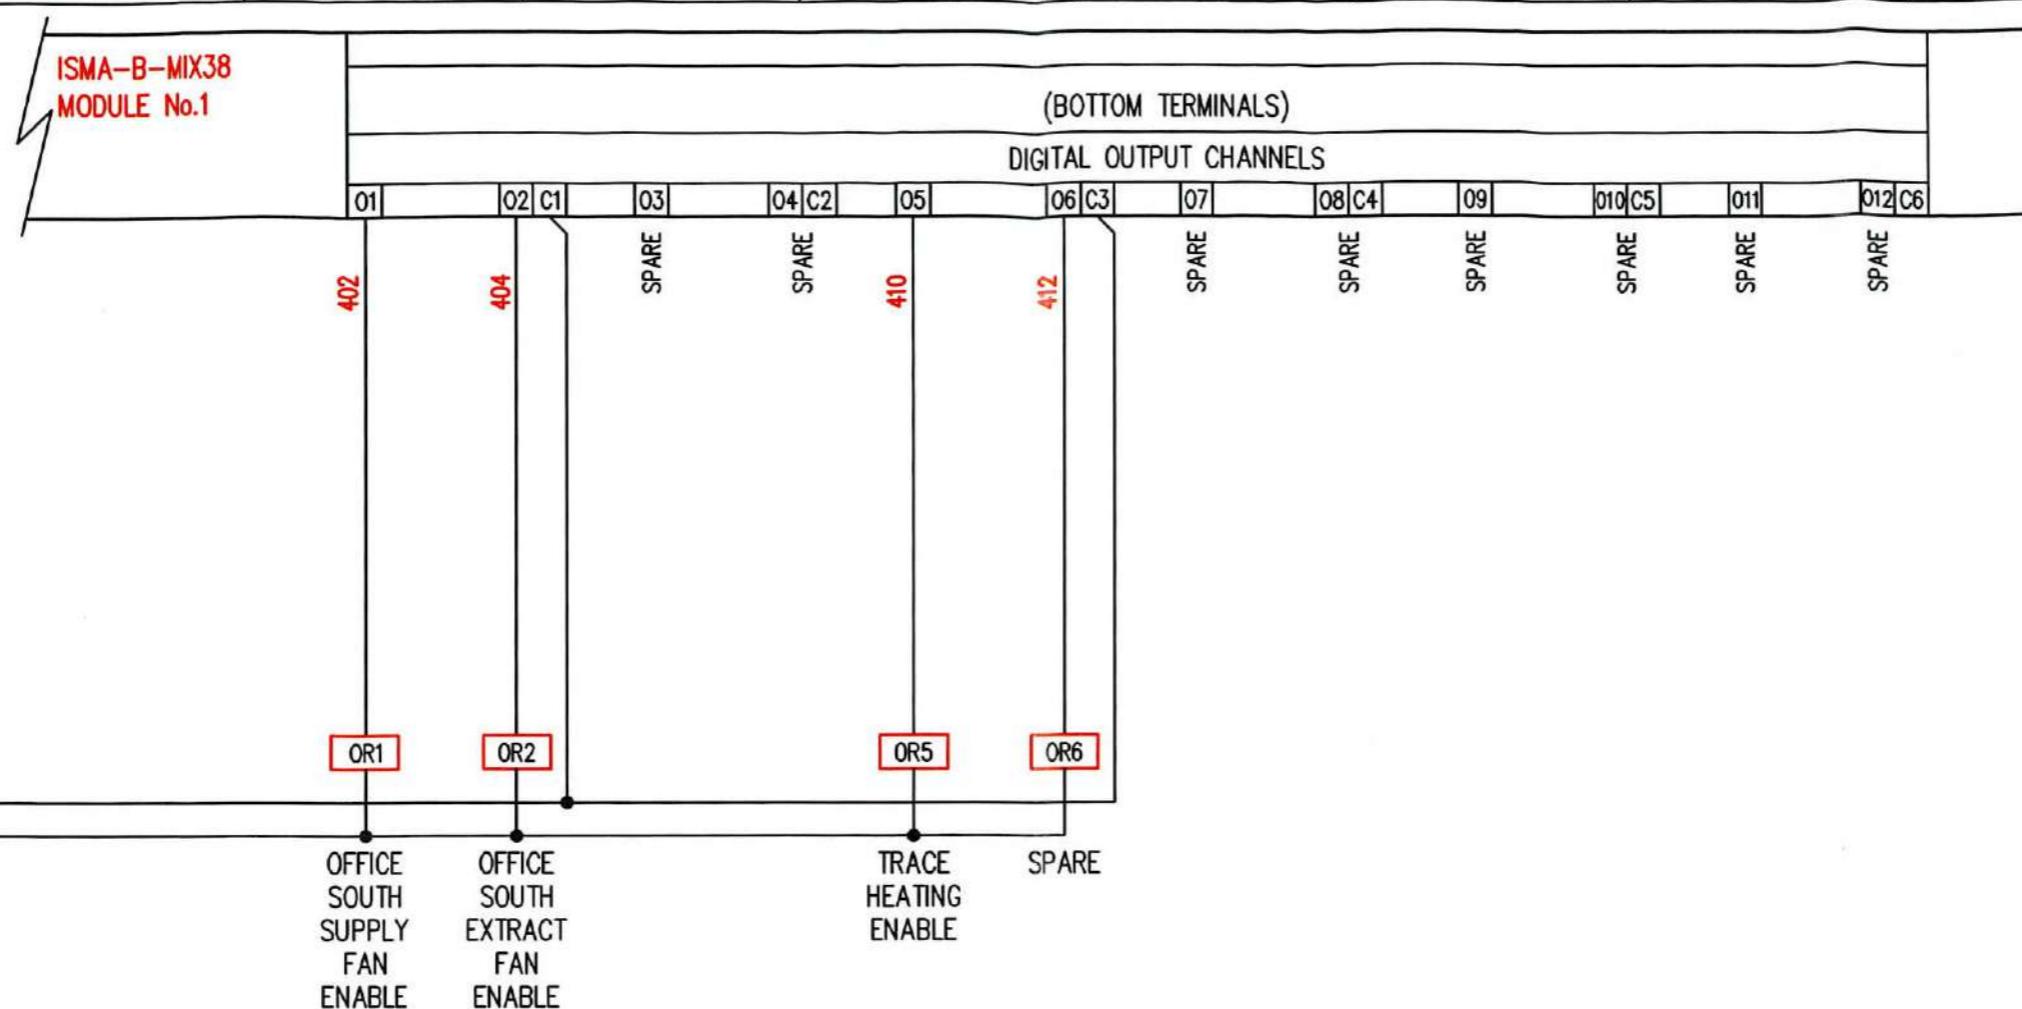

PROVISIONAL FOR APPROVAL ISSUED FOR CONSTRUCTION	AS BUILT AS FITTED	REVISION No	DESCRIPTION OF REVISION	DRAWN BY DATE	CHECKED BY DATE	REVISION No	DESCRIPTION OF REVISION	STATUS	DRAWN BY DATE	CHECKED BY DATE	DRG No.6082-15 PROJECT No.6082	SHT. 12 of 21	REV 1 ©
		0	PROVISIONAL	RFD 13/05/21		4							
		1	AS COMMISSIONED	RFD 19/05/21		5							
		2				6							
		3				7							



bges group

0 1 2 3 4 5 6 7 8 9

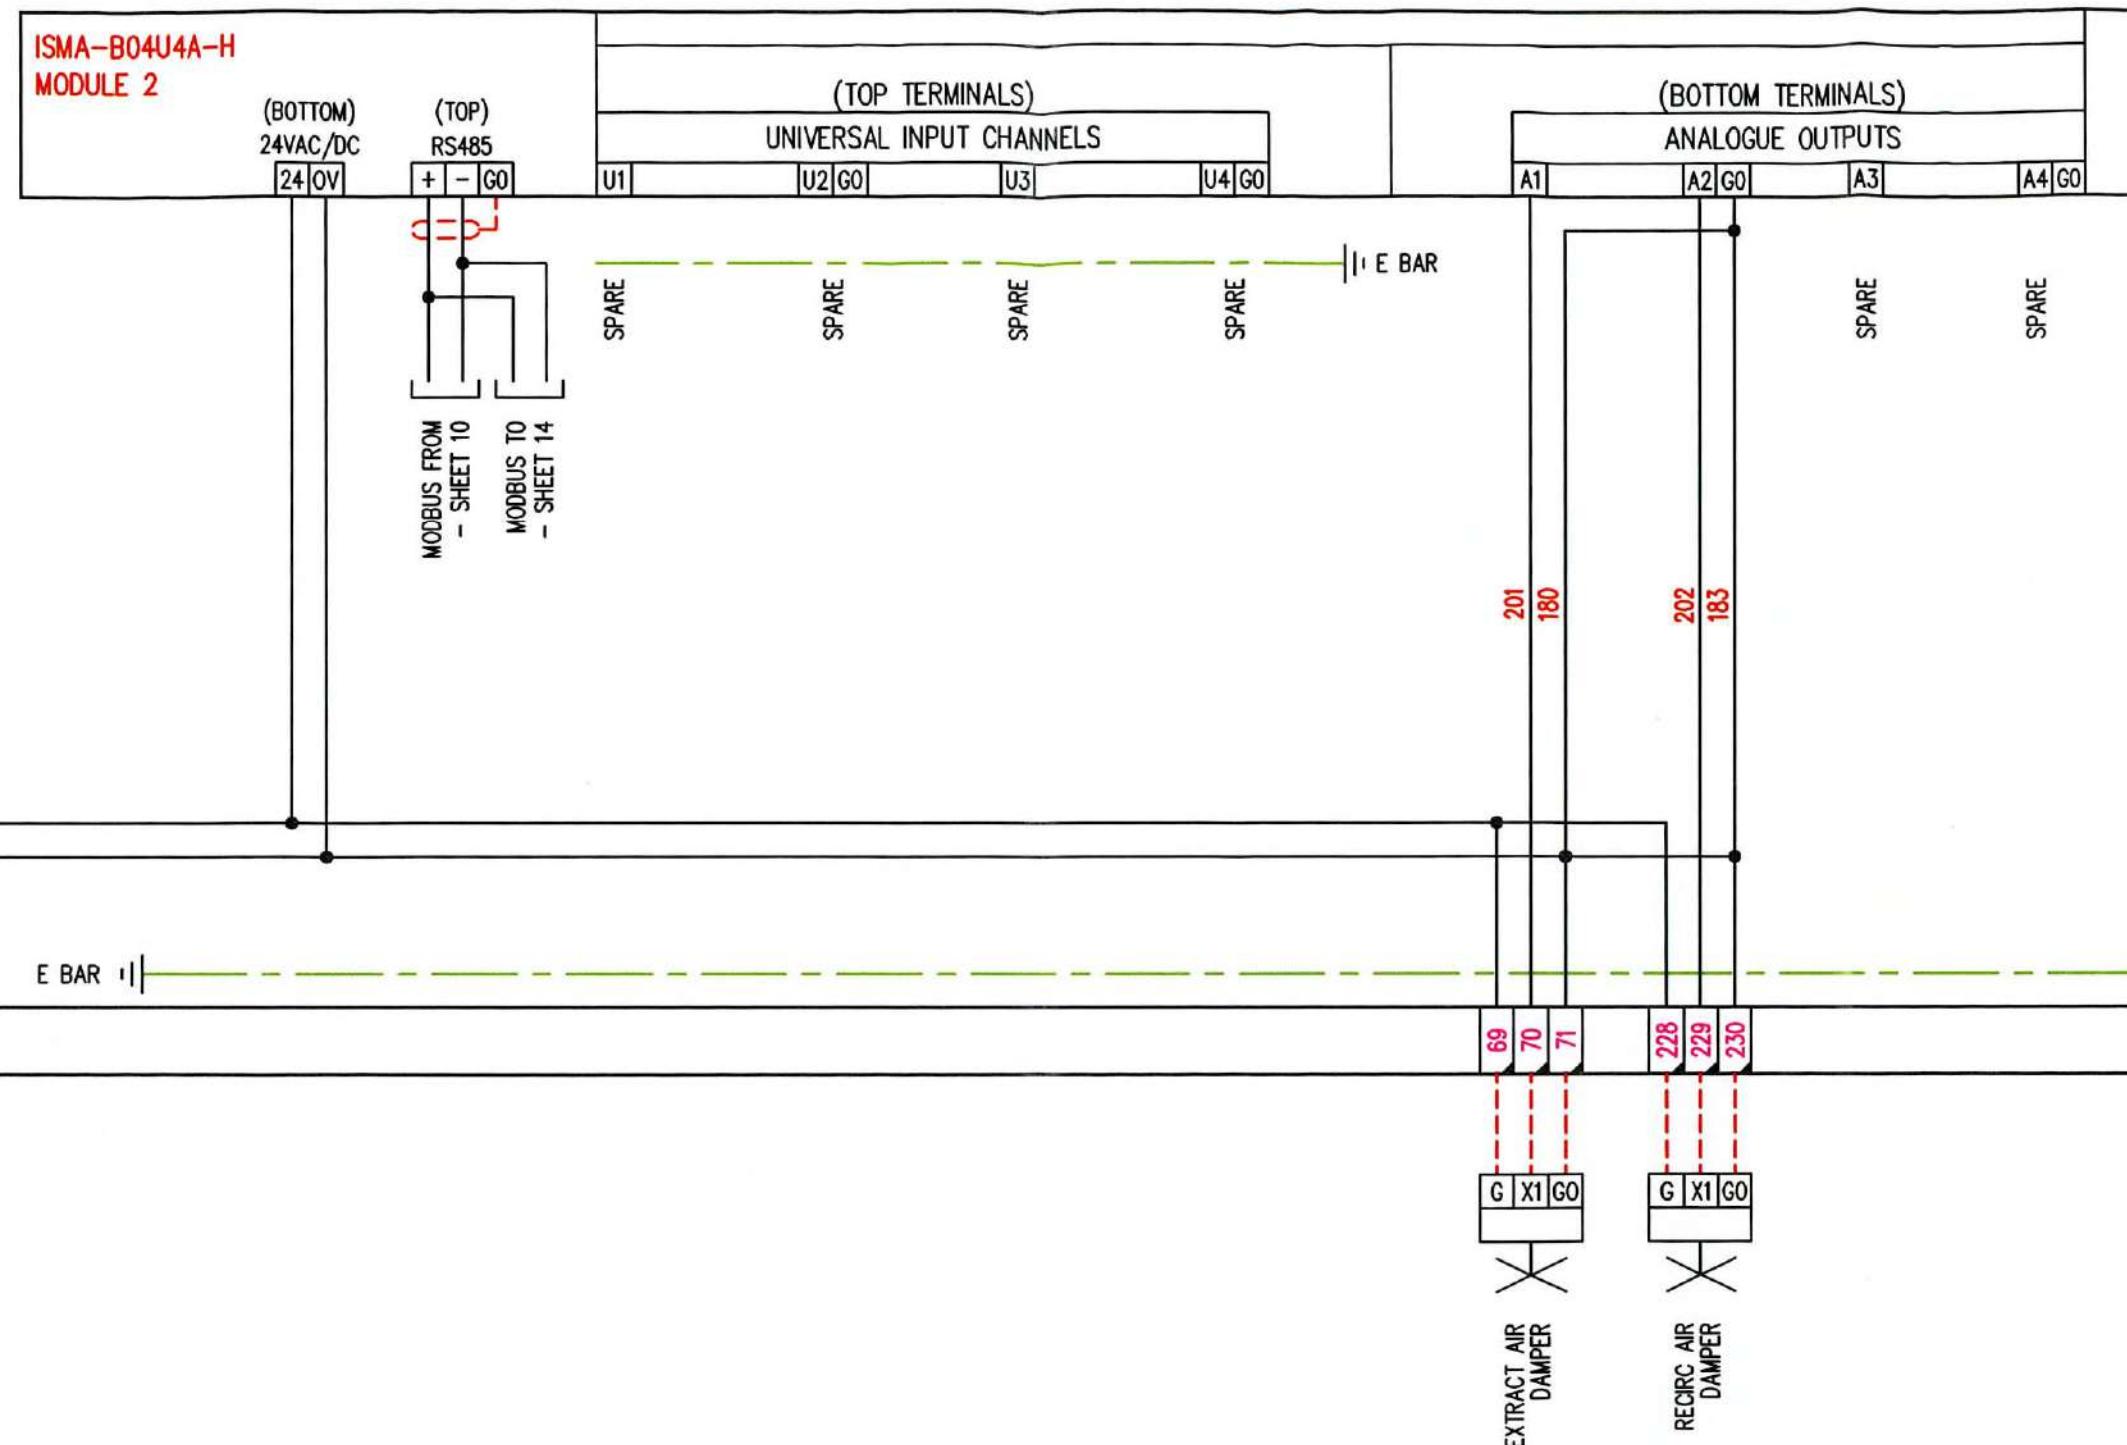

PROVISIONAL FOR APPROVAL ISSUED FOR CONSTRUCTION	AS BUILT AS FITTED	REVISION No	DESCRIPTION OF REVISION	DRAWN BY DATE	CHECKED BY DATE	REVISION No	DESCRIPTION OF REVISION	STATUS	DRAWN BY DATE	CHECKED BY DATE	DRG No.6082-15 PROJECT No.6082	SHT. 13 of 21	REV 1 ©
		0	PROVISIONAL	RFD 13/05/21		4							
		1	AS COMMISSIONED	RFD 19/05/21		5							
		2				6							
		3				7							

bges group

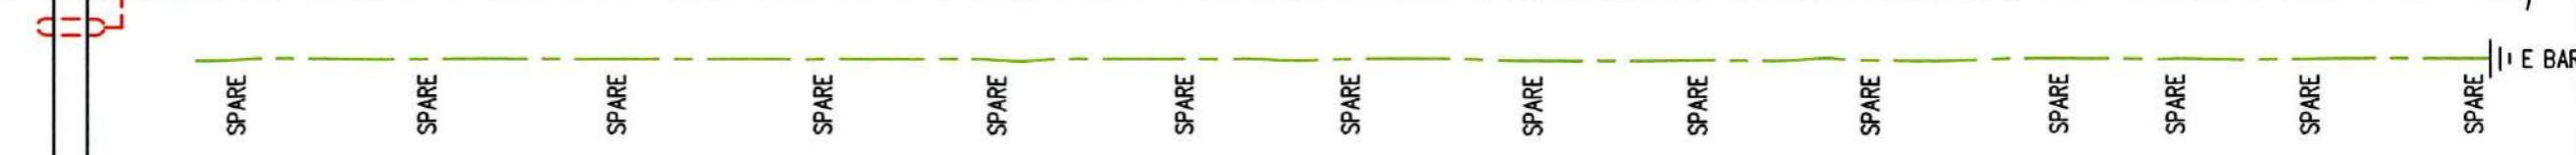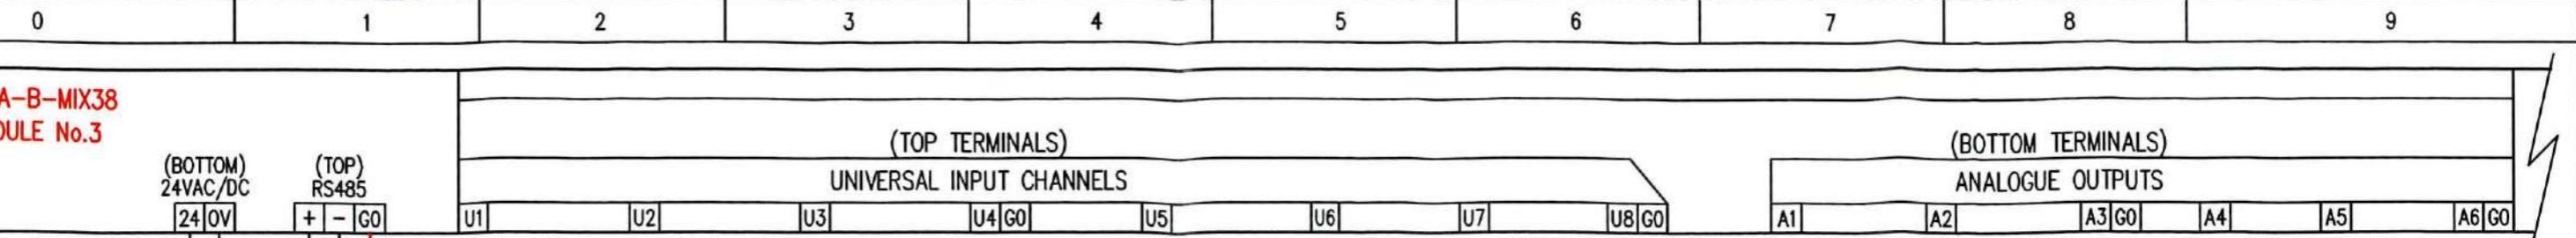

B

C

D

E

PROVISIONAL
 FOR APPROVAL
 ISSUED FOR CONSTRUCTION

AS BUILT
 AS FITTED

REVISION No	DESCRIPTION OF REVISION	DRAWN BY	CHECKED BY	REVISION No	DESCRIPTION OF REVISION	STATUS	DRAWN BY	CHECKED BY	DRG No.6082-15 PROJECT No.6082	SHT. 14 of 21	REV 1 ©
		DATE	DATE	DATE			DATE	DATE	DATE	DATE	
0	PROVISIONAL	RFD 13/05/21		4							
1	AS COMMISSIONED	RFD 19/05/21		5							
2				6							
3				7							
									TITLE	EXCHEQUER COURT	
									PANEL TITLE	EXISTING SOUTH ROOF CONTROL PANEL	
									CLIENT		




0 1 2 3 4 5 6 7 8 9

ISMA-B-MIX38
MODULE No.3


(TOP TERMINALS)

DIGITAL INPUT CHANNELS


I1 I2 I3 I4 G0 I5 I6 I7 I8 G0 I9 I10 I11 I12 G0

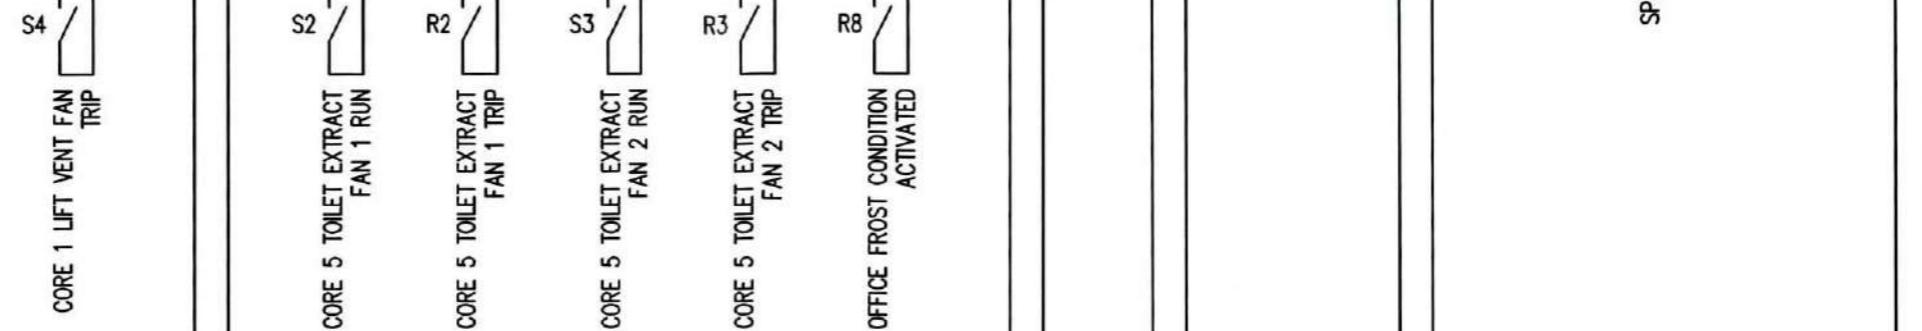


E BAR 1 | ----- | 193 192 | ----- | 194 195 | 189 188 | 191 190 | 197 196 | -----

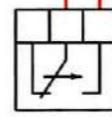


CORE 5
TOILET
EXTRACT AIR
FLOW DUCT
DPS SWITCH

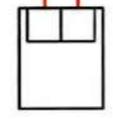

CORE 5 TOILET
EXTRACT DAMPER
OPEN / CLOSE
STATUS

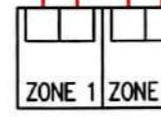

TRACE HEATING
FAULTS
ZONE 1 ZONE 2

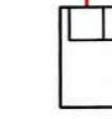

EXT FAN PITCH
COMPRESSOR
FAULT

LIFT ROOM (POINT
TO BE IDENTIFIED)

● PROVISIONAL ● AS BUILT
● FOR APPROVAL ● AS FITTED
● ISSUED FOR
CONSTRUCTION



REVISION No	DESCRIPTION OF REVISION	DRAWN BY DATE	CHECKED BY DATE	REVISION No	DESCRIPTION OF REVISION	STATUS	DRAWN BY DATE	CHECKED BY DATE
0	PROVISIONAL	RFD 13/05/21		4				
1	AS COMMISSIONED	RFD 19/05/21		5				
2				6				
3				7				


DRG No.6082-15 SHT. 15 of 21
PROJECT No.6082

REV 1
©

TITLE EXCHEQUER COURT
PANEL TITLE EXISTING SOUTH ROOF
CLIENT CONTROL PANEL

©

0 1 2 3 4 5 6 7 8 9

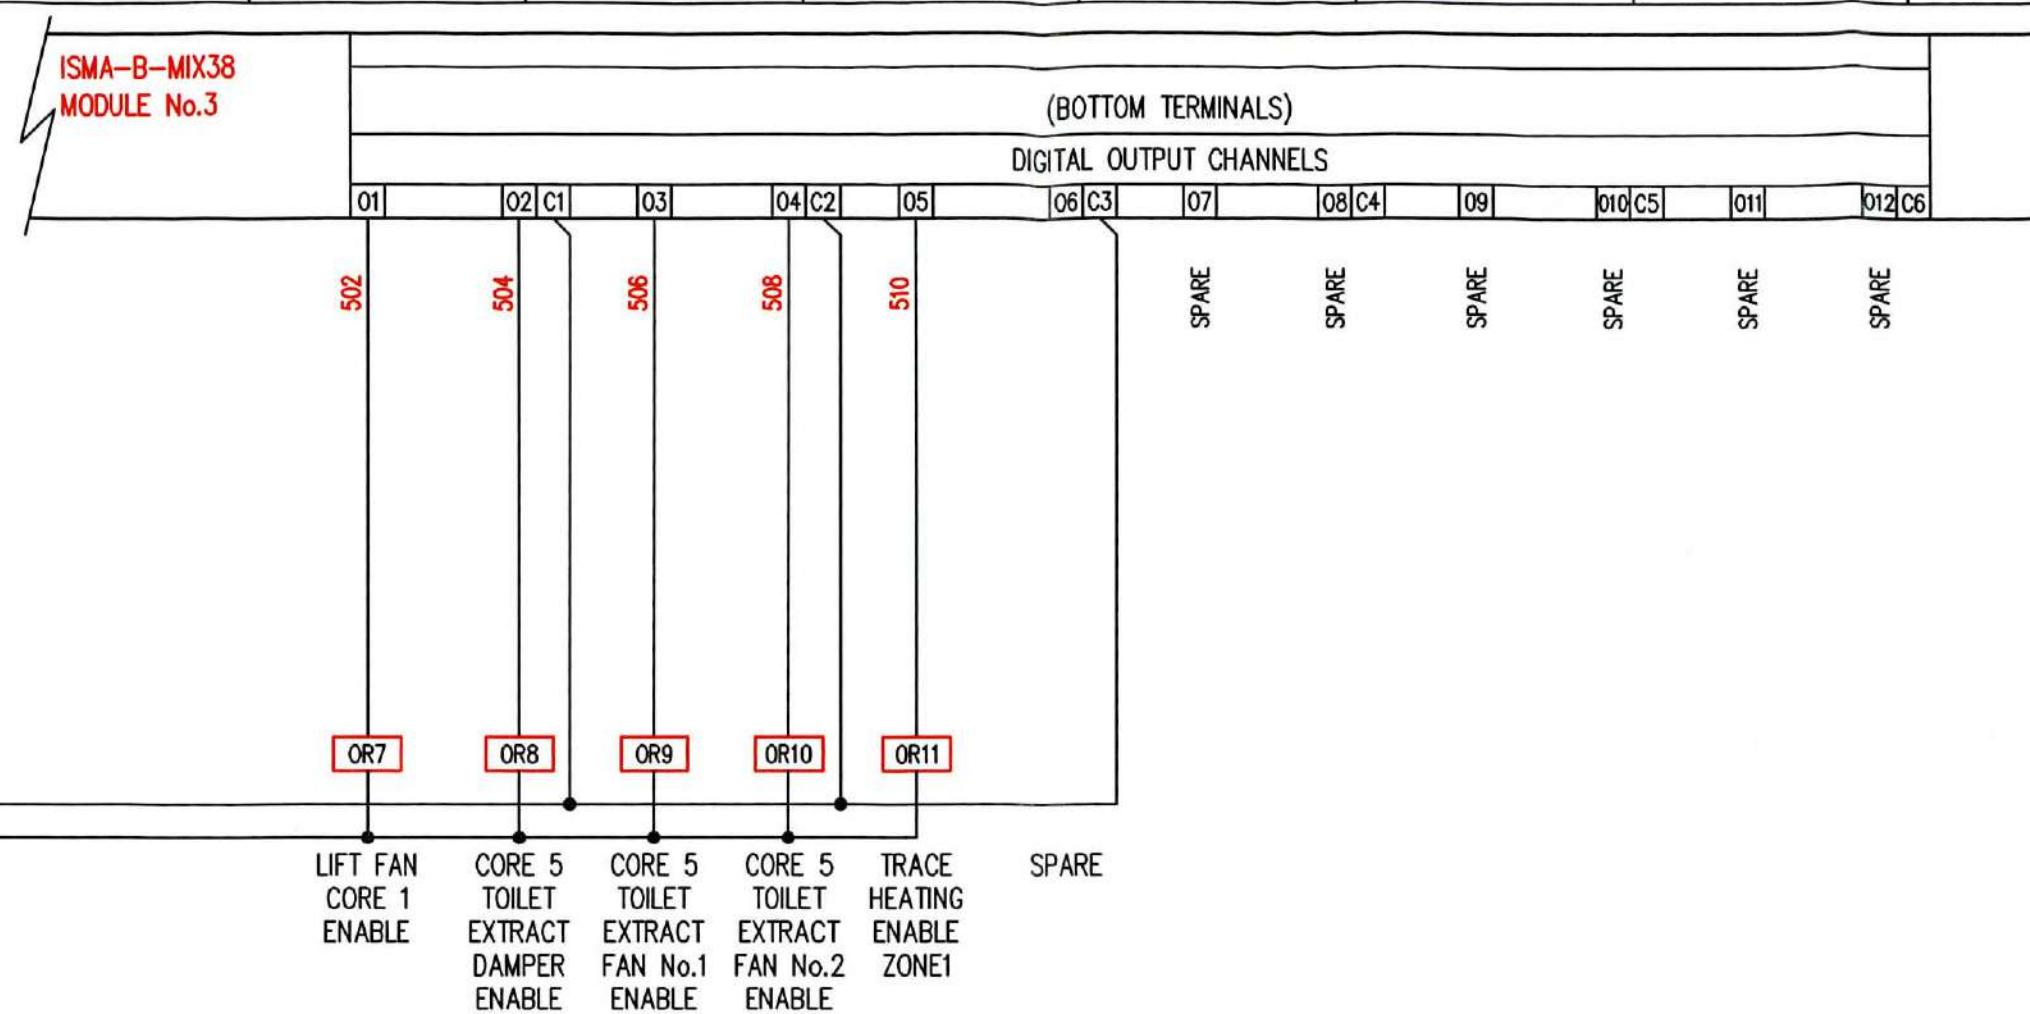

PROVISIONAL FOR APPROVAL ISSUED FOR CONSTRUCTION	AS BUILT AS FITTED	REVISION No	DESCRIPTION OF REVISION	DRAWN BY DATE	CHECKED BY DATE	REVISION No	DESCRIPTION OF REVISION	STATUS	DRAWN BY DATE	CHECKED BY DATE	DRG No.6082-15 PROJECT No.6082	SHT. 16 of 21	REV 1 ©
		0	PROVISIONAL	RFD 13/05/21		4					TITLE	EXCHEQUER COURT	
		1	AS COMMISSIONED	RFD 19/05/21		5					PANEL TITLE	EXISTING SOUTH ROOF CONTROL PANEL	
		2				6					CLIENT		
		3				7							

SPARE PAGE
ANTICIPATED USE

A

B

C

D

E

PROVISIONAL AS BUILT
 FOR APPROVAL AS FITTED
 ISSUED FOR CONSTRUCTION

REVISION No	DESCRIPTION OF REVISION	DRAWN BY DATE	CHECKED BY DATE	REVISION No	DESCRIPTION OF REVISION	STATUS	DRAWN BY DATE	CHECKED BY DATE
0	PROVISIONAL	RFD 13/05/21		4				
1	AS COMMISSIONED	RFD 19/05/21		5				
2				6				
3				7				

DRG No.6082-15 SHT. 17 of 21
PROJECT No.6082

REV 1


©

TITLE EXCHEQUER COURT

PANEL TITLE EXISTING SOUTH ROOF CONTROL PANEL



CLIENT



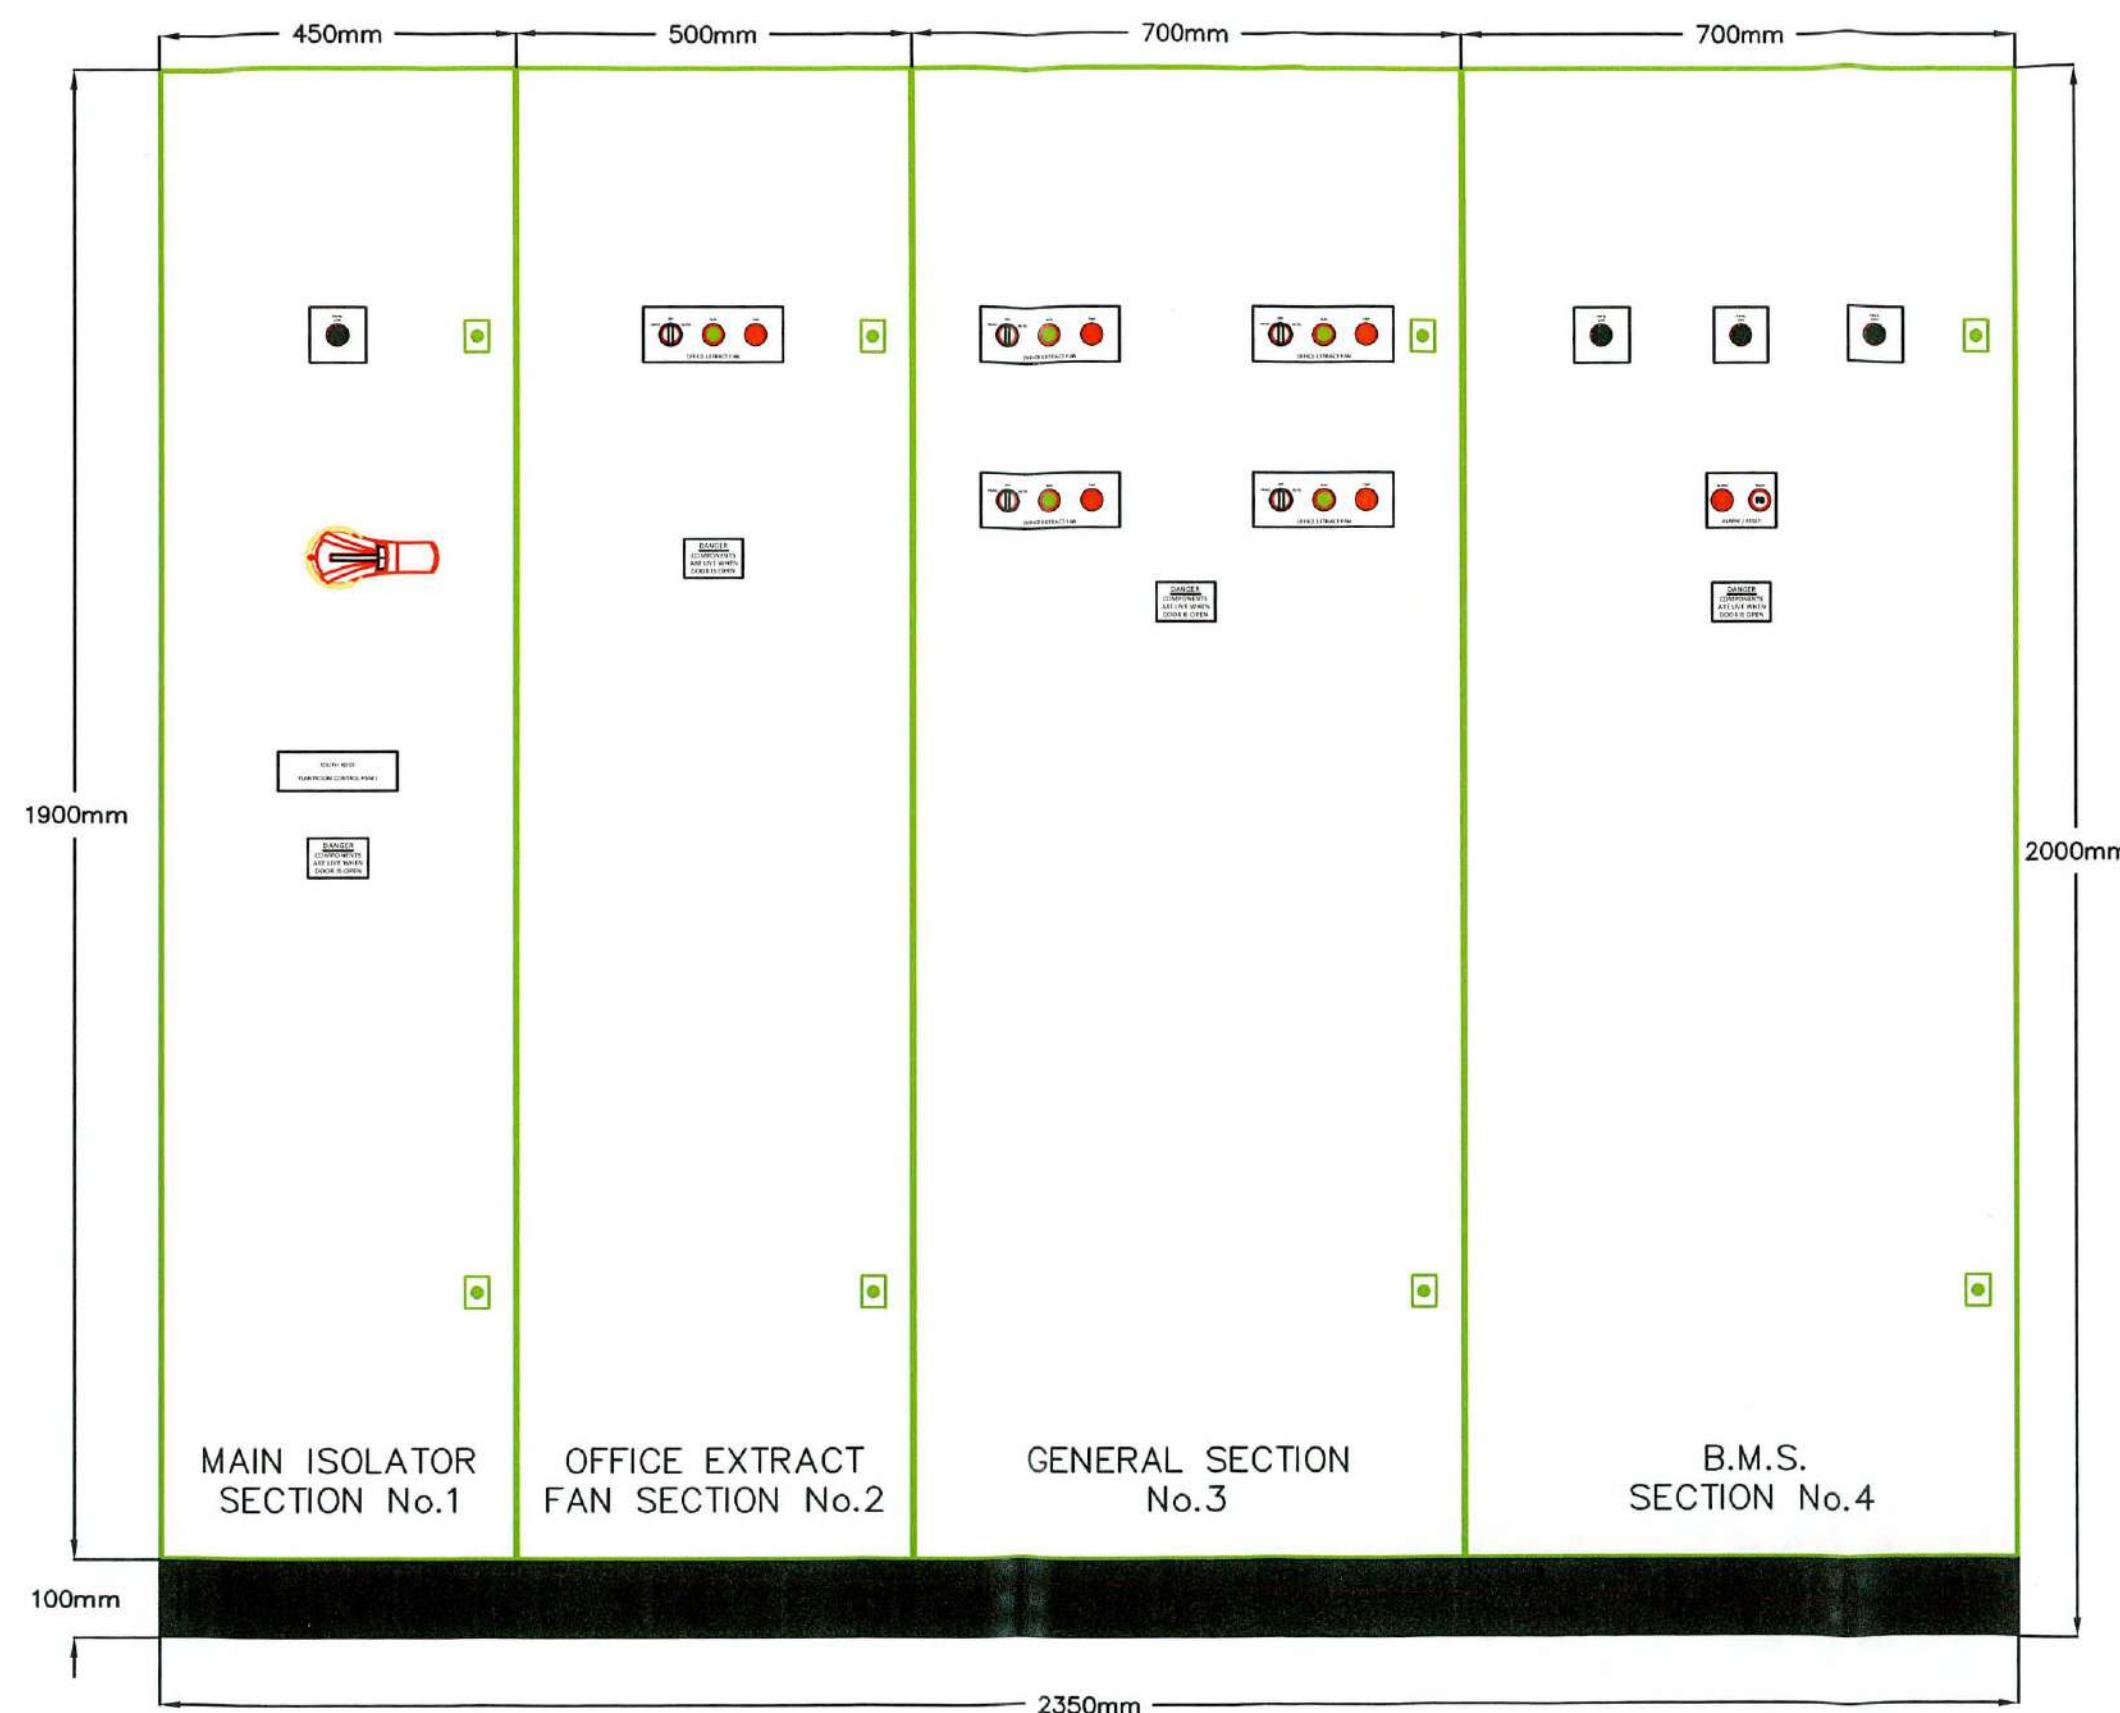

0	1	2	3	4	5	6	7	8	9
---	---	---	---	---	---	---	---	---	---

A

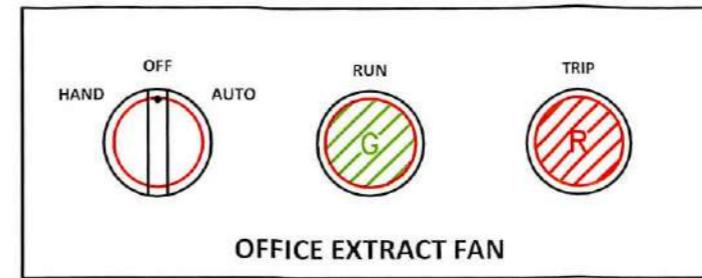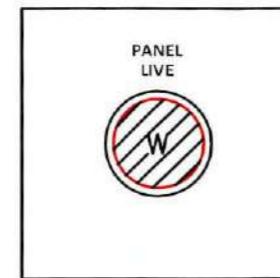

B

C

D

E

SOUTH ROOF
PLANTROOM CONTROL PANEL

DANGER
COMPONENTS
ARE LIVE WHEN
DOOR IS OPEN

DANGER
COMPONENTS
ARE LIVE WHEN
DOOR IS OPEN

PROVISIONAL AS BUILT
 FOR APPROVAL AS FITTED
 ISSUED FOR CONSTRUCTION

REVISION No	DESCRIPTION OF REVISION	DRAWN BY DATE	CHECKED BY DATE	REVISION No	DESCRIPTION OF REVISION	STATUS	DRAWN BY DATE	CHECKED BY DATE
0	PROVISIONAL	RFD 13/05/21		4				
1	AS COMMISSIONED	RFD 19/05/21		5				
2				6				
3				7				

DRG No.6082-15 SHT. 19 of 21
PROJECT No.6082

REV 1
©






TITLE EXCHEQUER COURT

PANEL TITLE EXISTING SOUTH ROOF
CONTROL PANEL




CLIENT

0 1 2 3 4 5 6 7 8 9

A

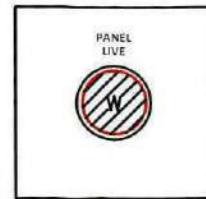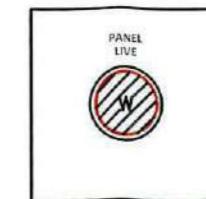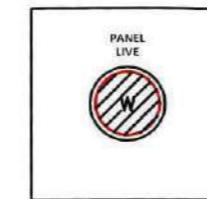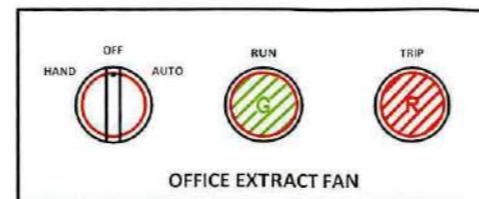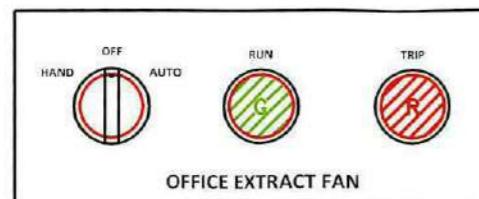

B

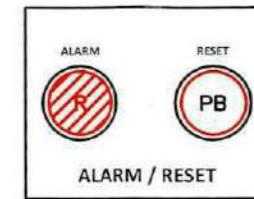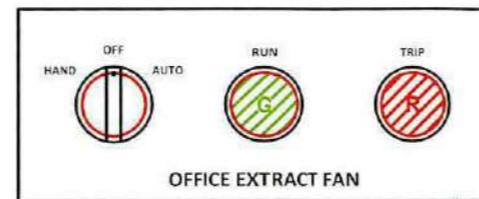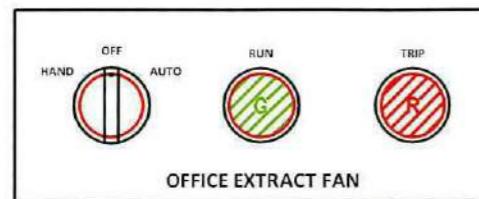

C

DANGER
COMPONENTS
ARE LIVE WHEN
DOOR IS OPEN

DANGER
COMPONENTS
ARE LIVE WHEN
DOOR IS OPEN


D

E

● PROVISIONAL ● AS BUILT
● FOR APPROVAL ● AS FITTED
● ISSUED FOR
CONSTRUCTION



REVISION No	DESCRIPTION OF REVISION	DRAWN BY DATE	CHECKED BY DATE	REVISION No	DESCRIPTION OF REVISION	STATUS	DRAWN BY DATE	CHECKED BY DATE	DRG No.6082-15 PROJECT No.6082	SHT. 20 of 21	REV 1 ©
0	PROVISIONAL	RFD 13/05/21		4							
1	AS COMMISSIONED	RFD 19/05/21		5							
2				6							
3				7							
									TITLE	EXCHEQUER COURT	
									PANEL TITLE	EXISTING SOUTH ROOF CONTROL PANEL	
									CLIENT		

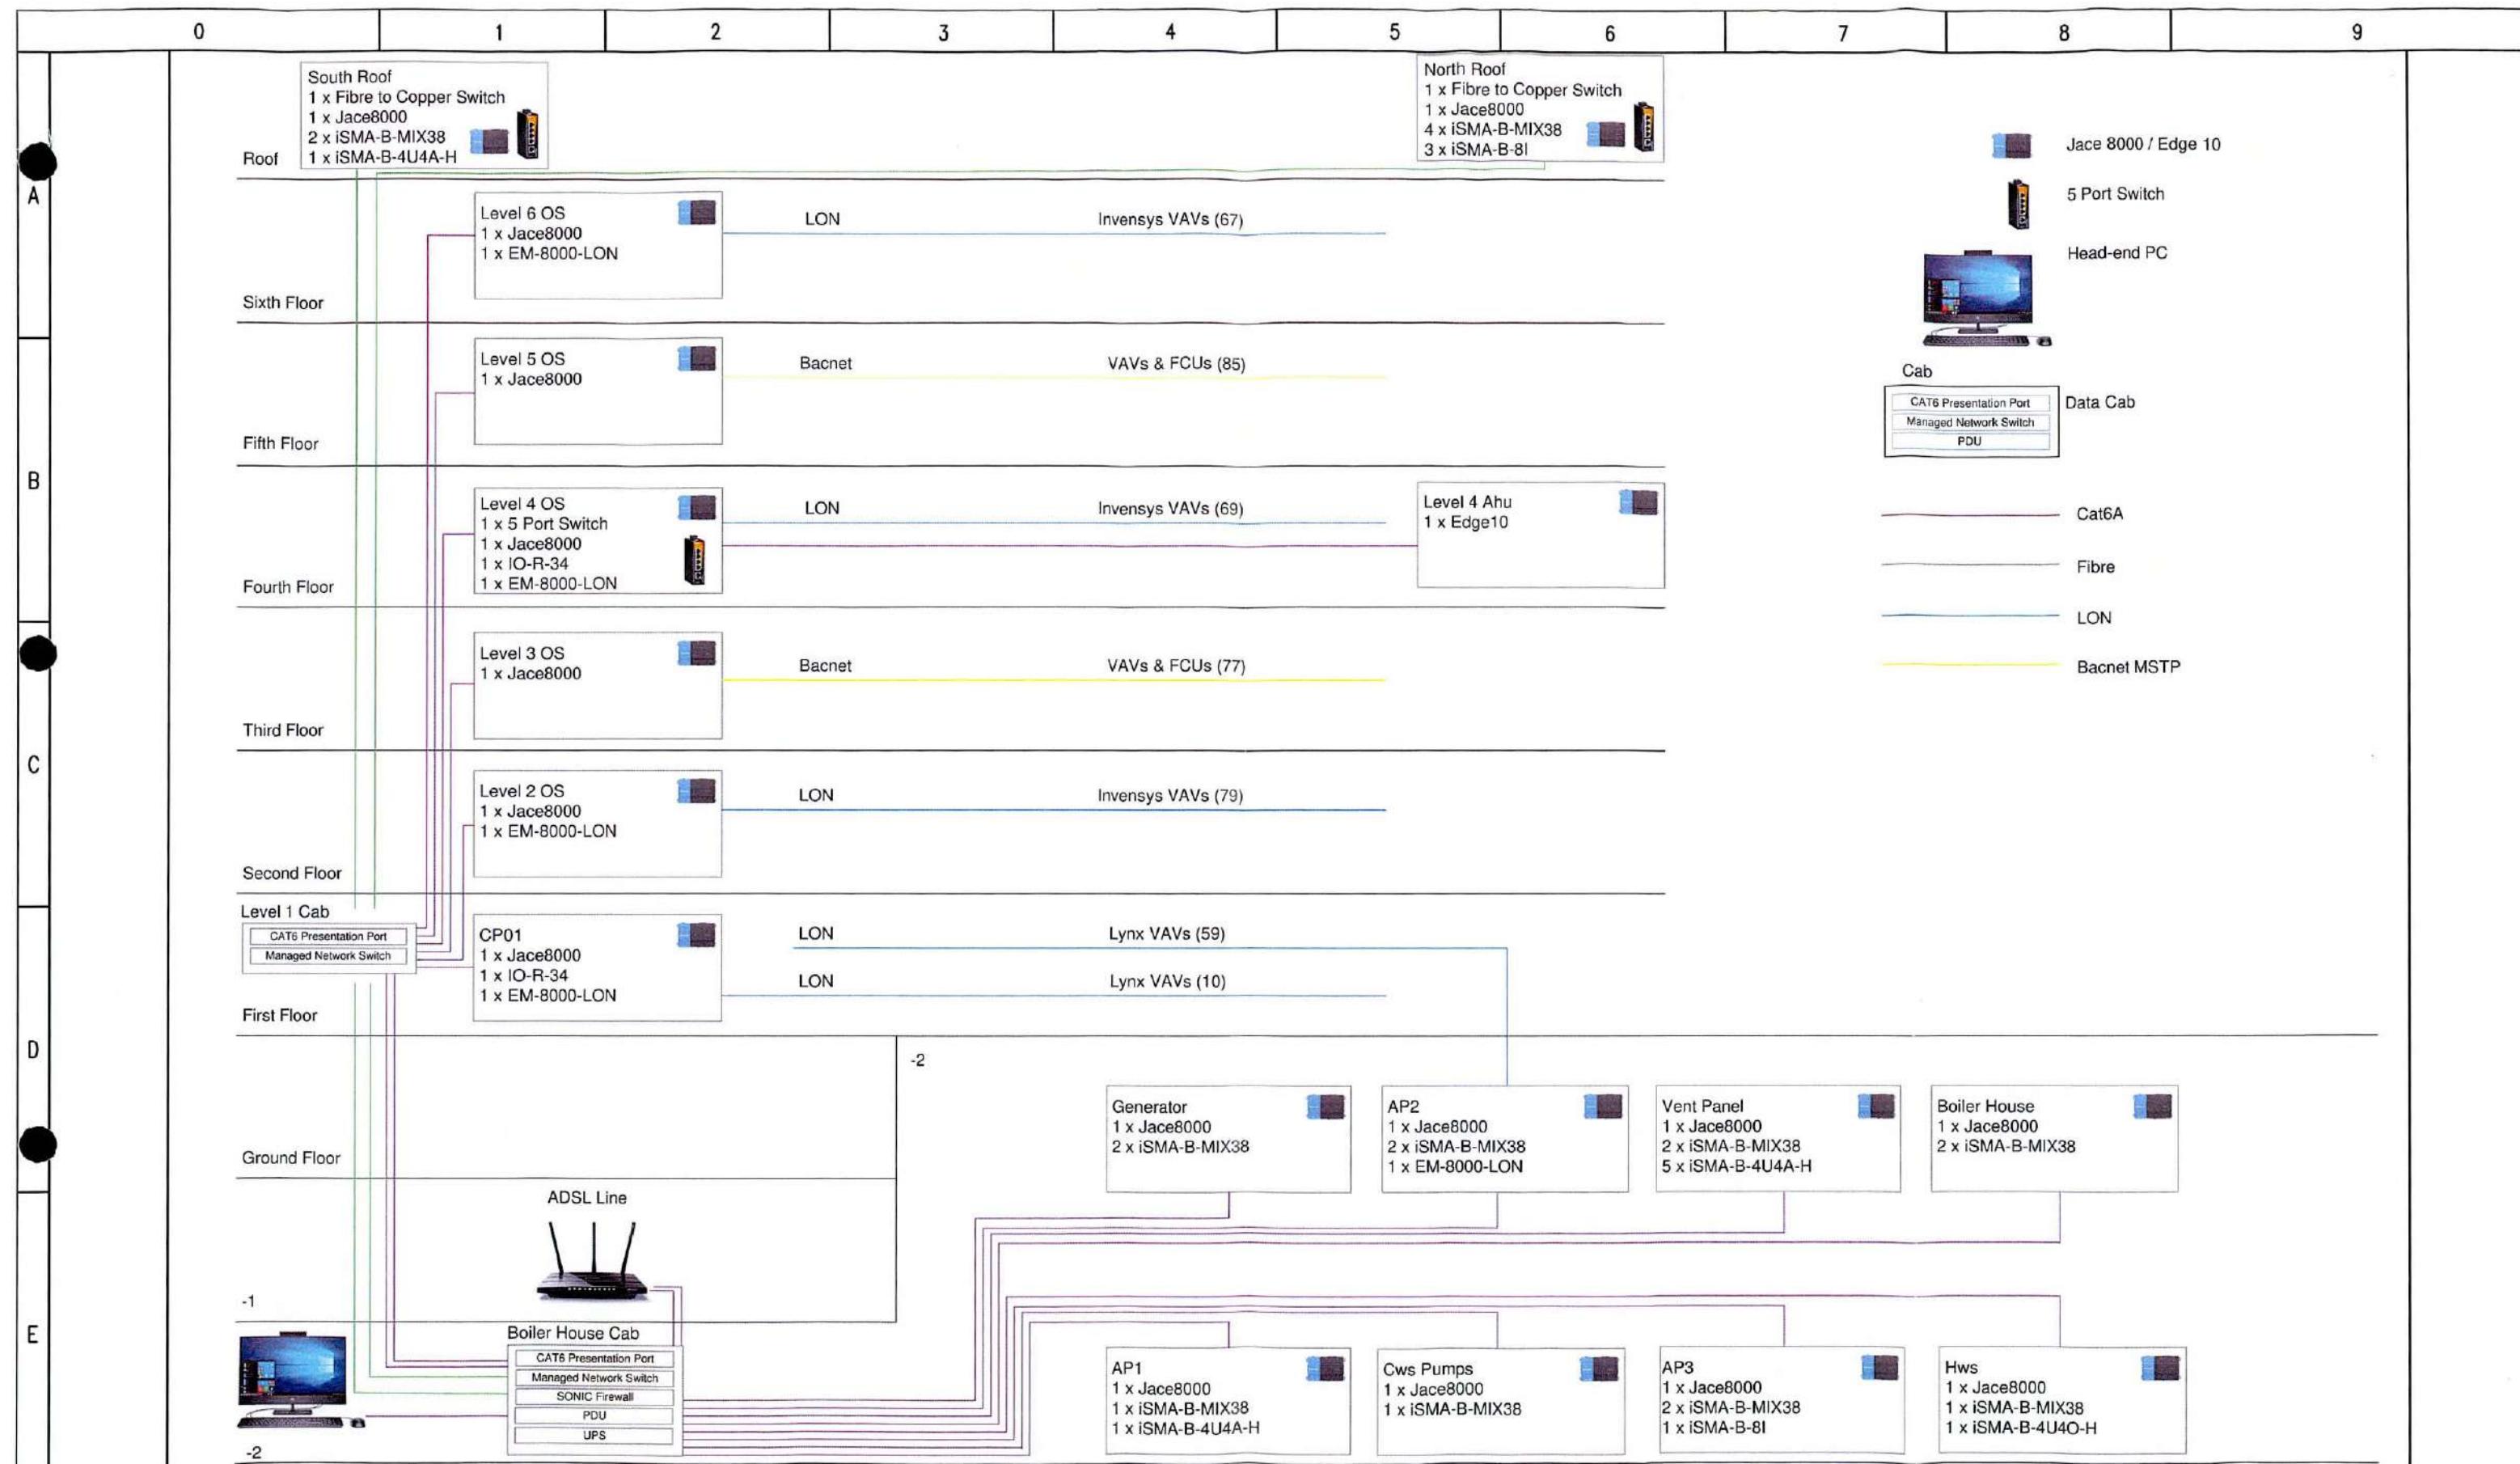



Project : EXCHEQUER COURT

Title : ROOF NORTH ADDITIONAL
CONTROL PANEL

Client :

ENGINEER : RFD


DATE : 19/05/21


DRAWING No : 6082-16

SHEET : 15

REVISION : 1


PROJECT No. : 6082

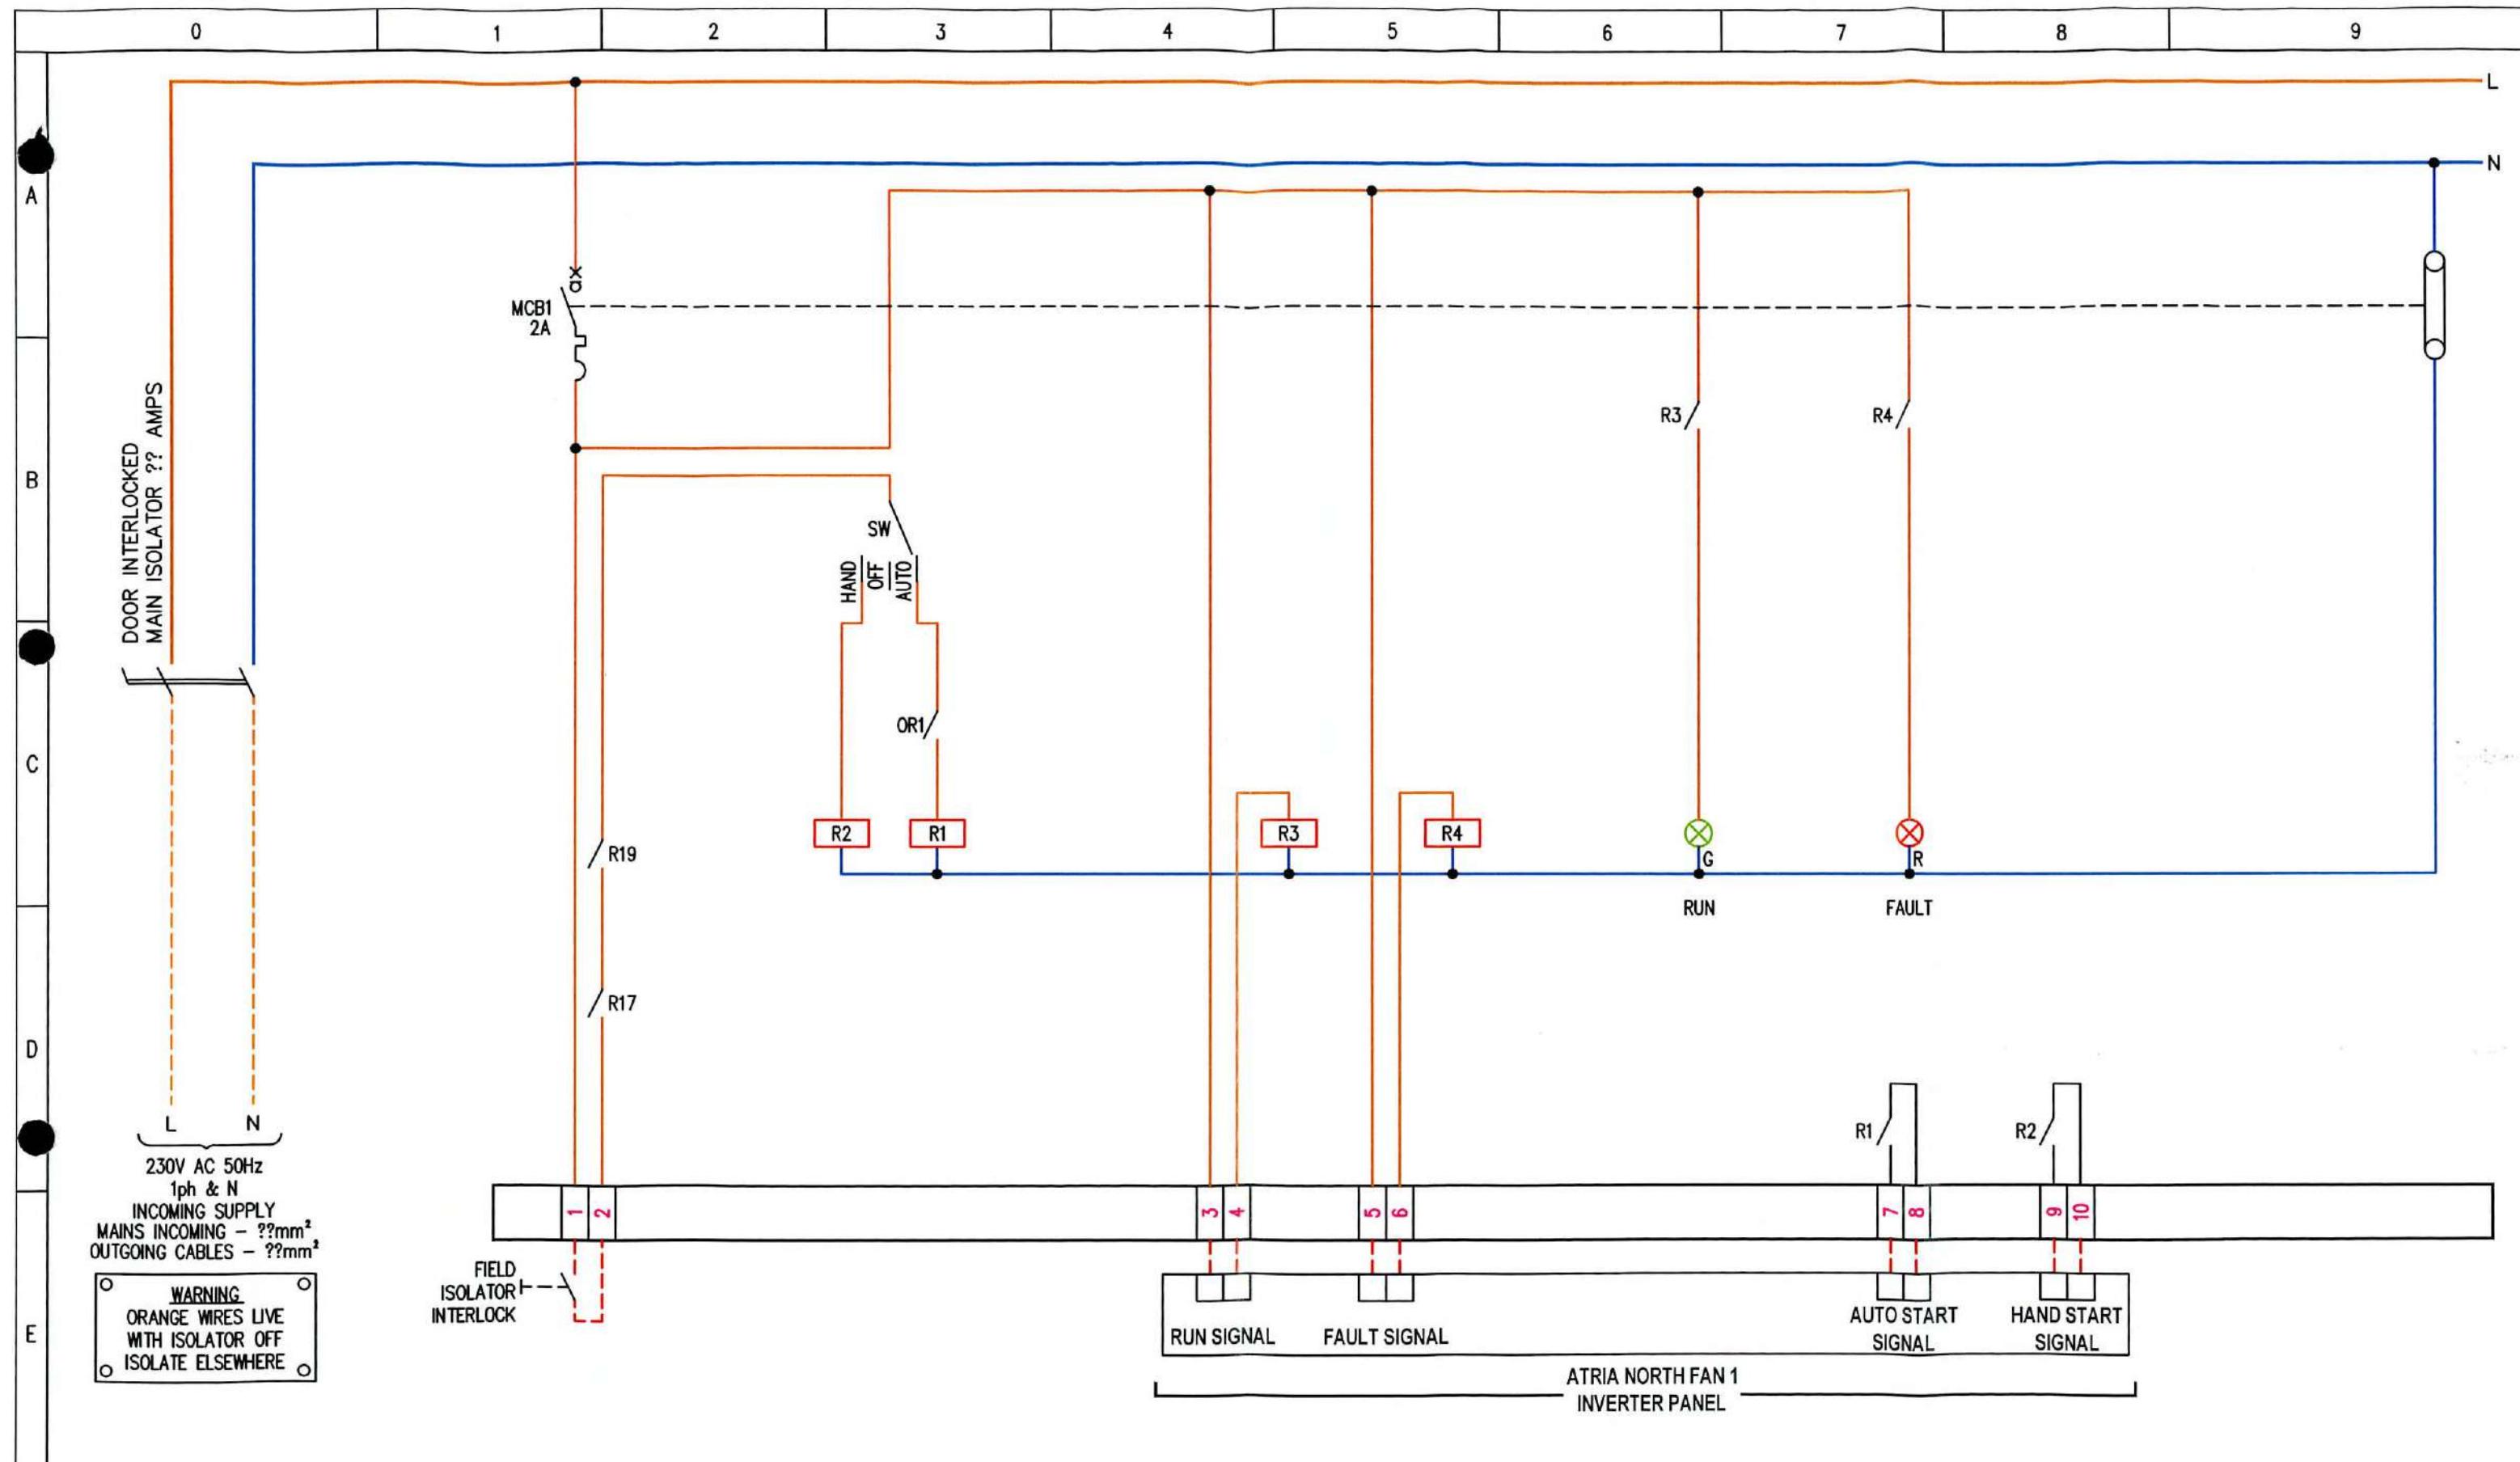

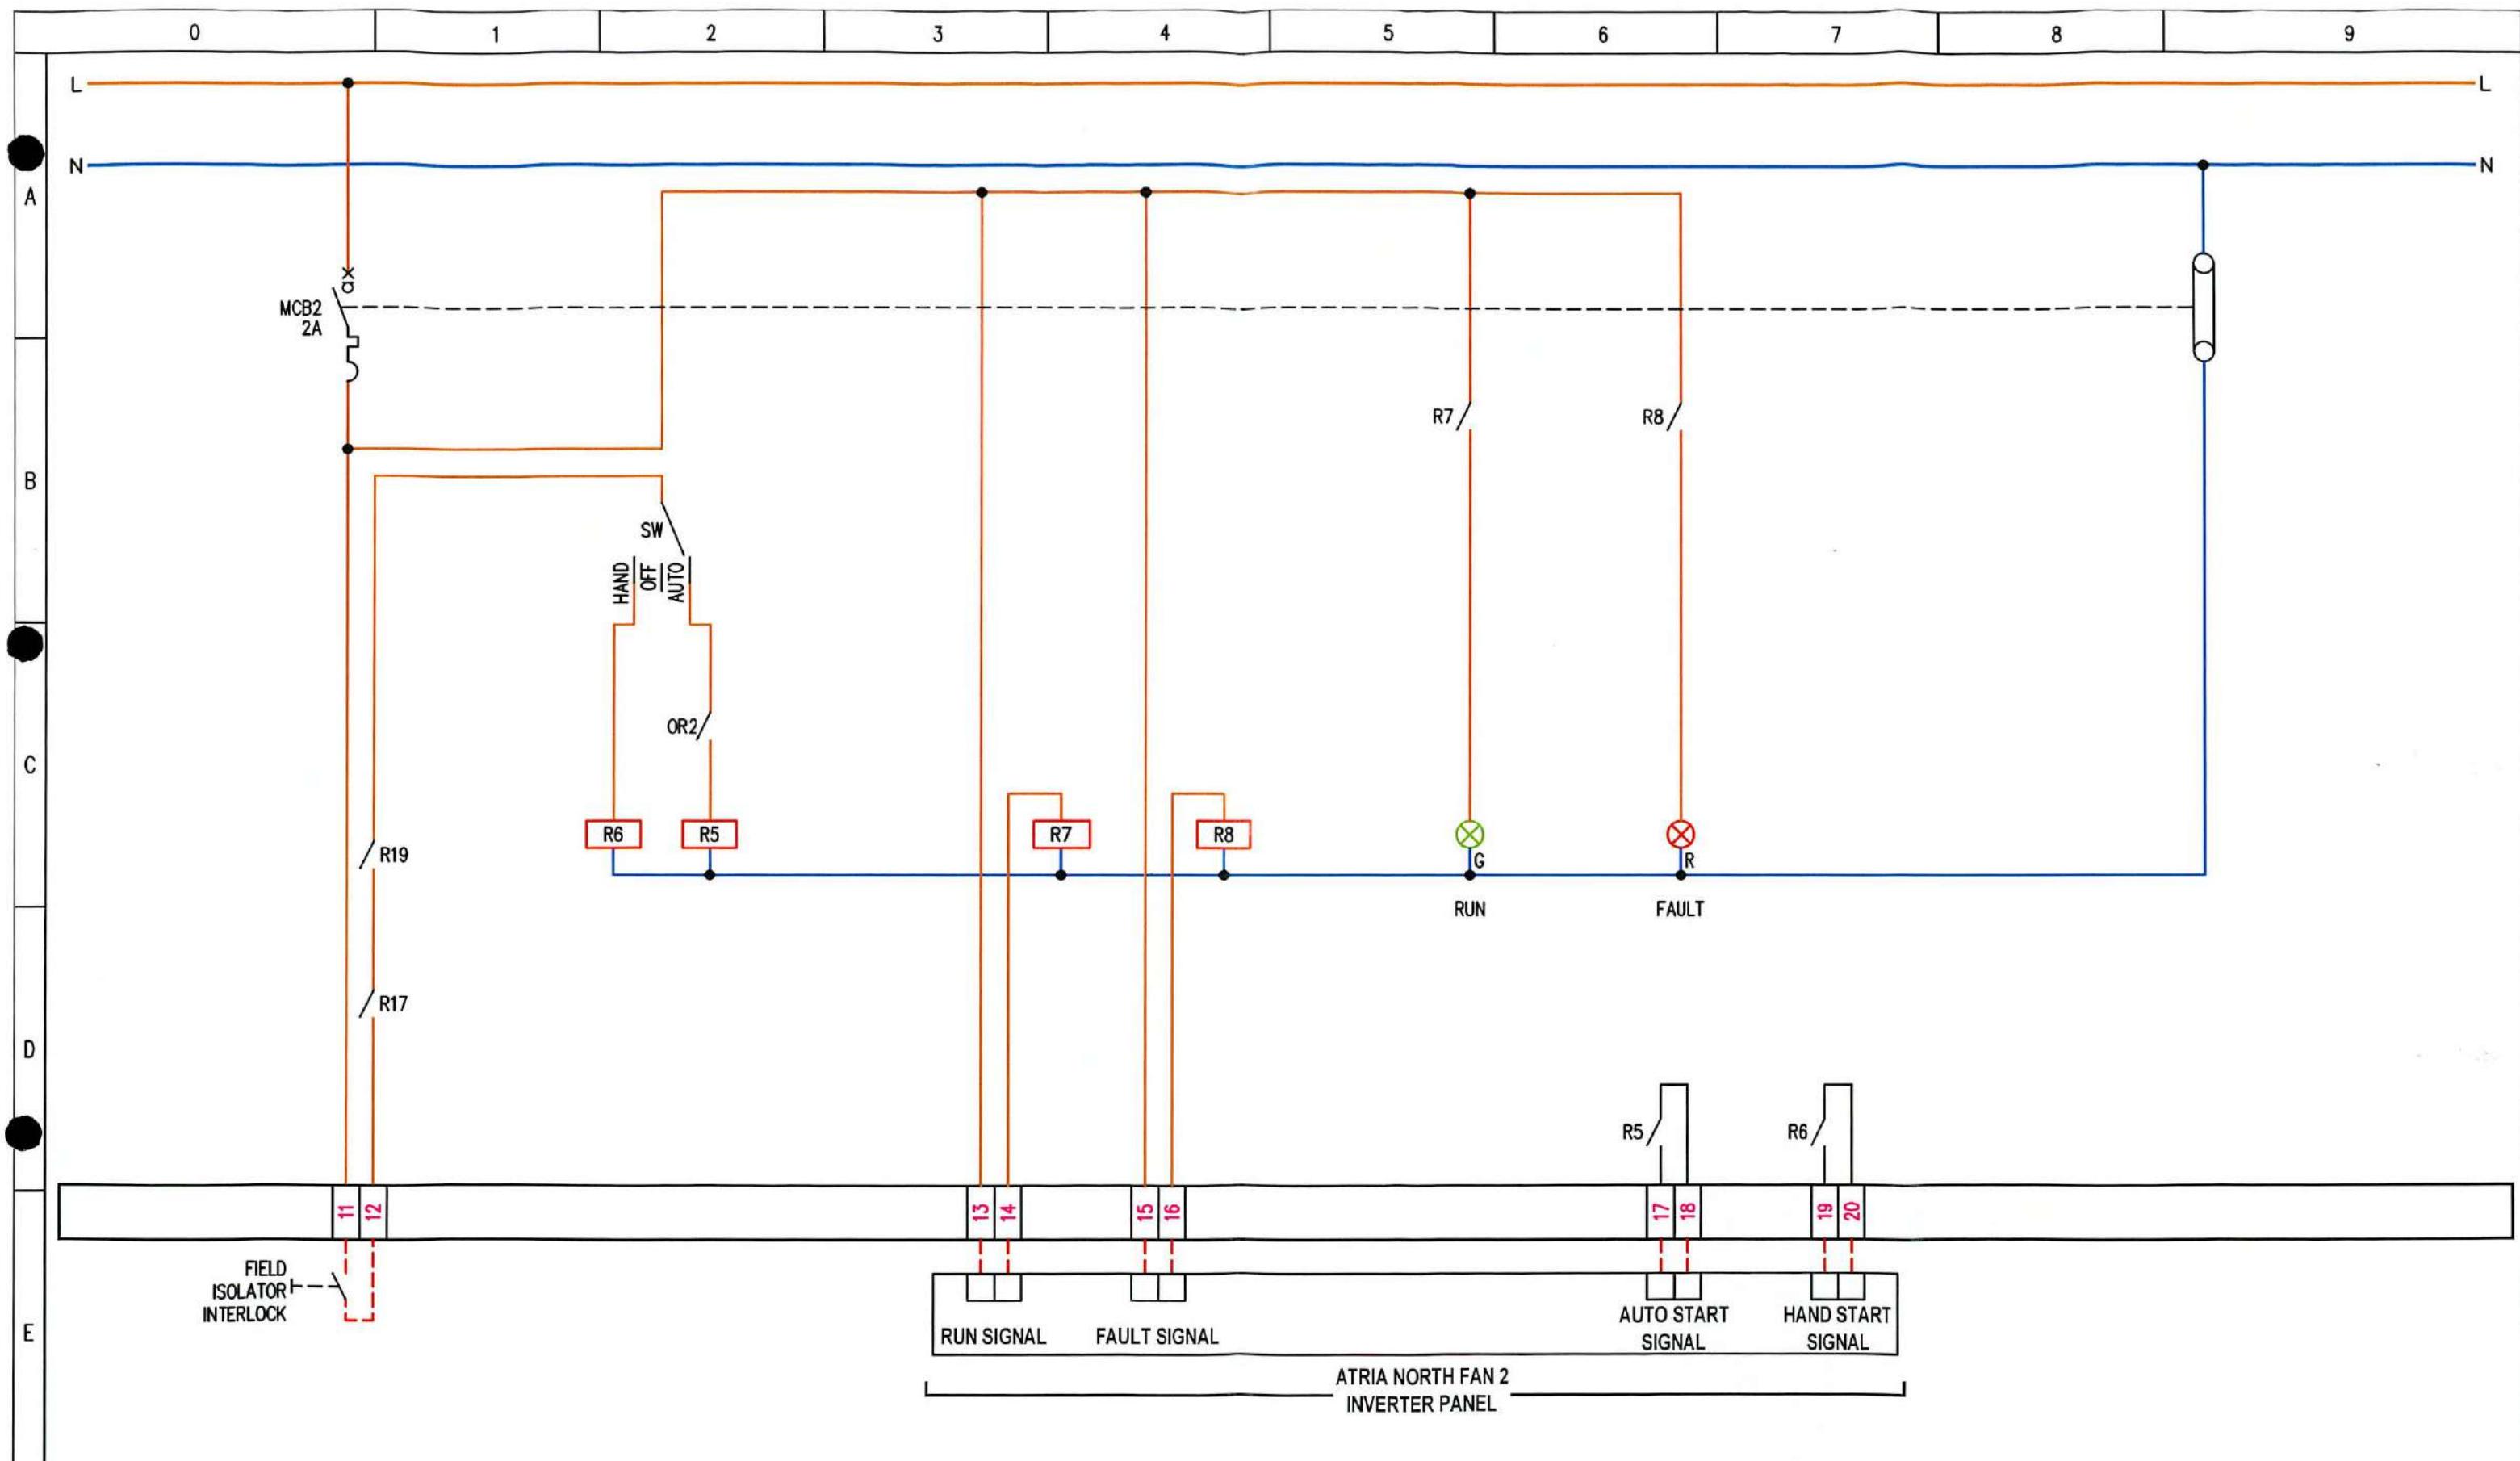


PROVISIONAL FOR APPROVAL ISSUED FOR CONSTRUCTION	AS BUILT	REVISION No	DESCRIPTION OF REVISION	DRAWN BY DATE	CHECKED BY DATE	REVISION No	DESCRIPTION OF REVISION	STATUS	DRAWN BY DATE	CHECKED BY DATE	DRG No.6082-16 PROJECT No.6082	SHT. 3 of 15	REV 1 ©
		0	PROVISIONAL	RFD 14/05/21		4							
		1	AS COMMISSIOND	RFD 19/05/21		5							
		2				6							
		3				7							


bges group

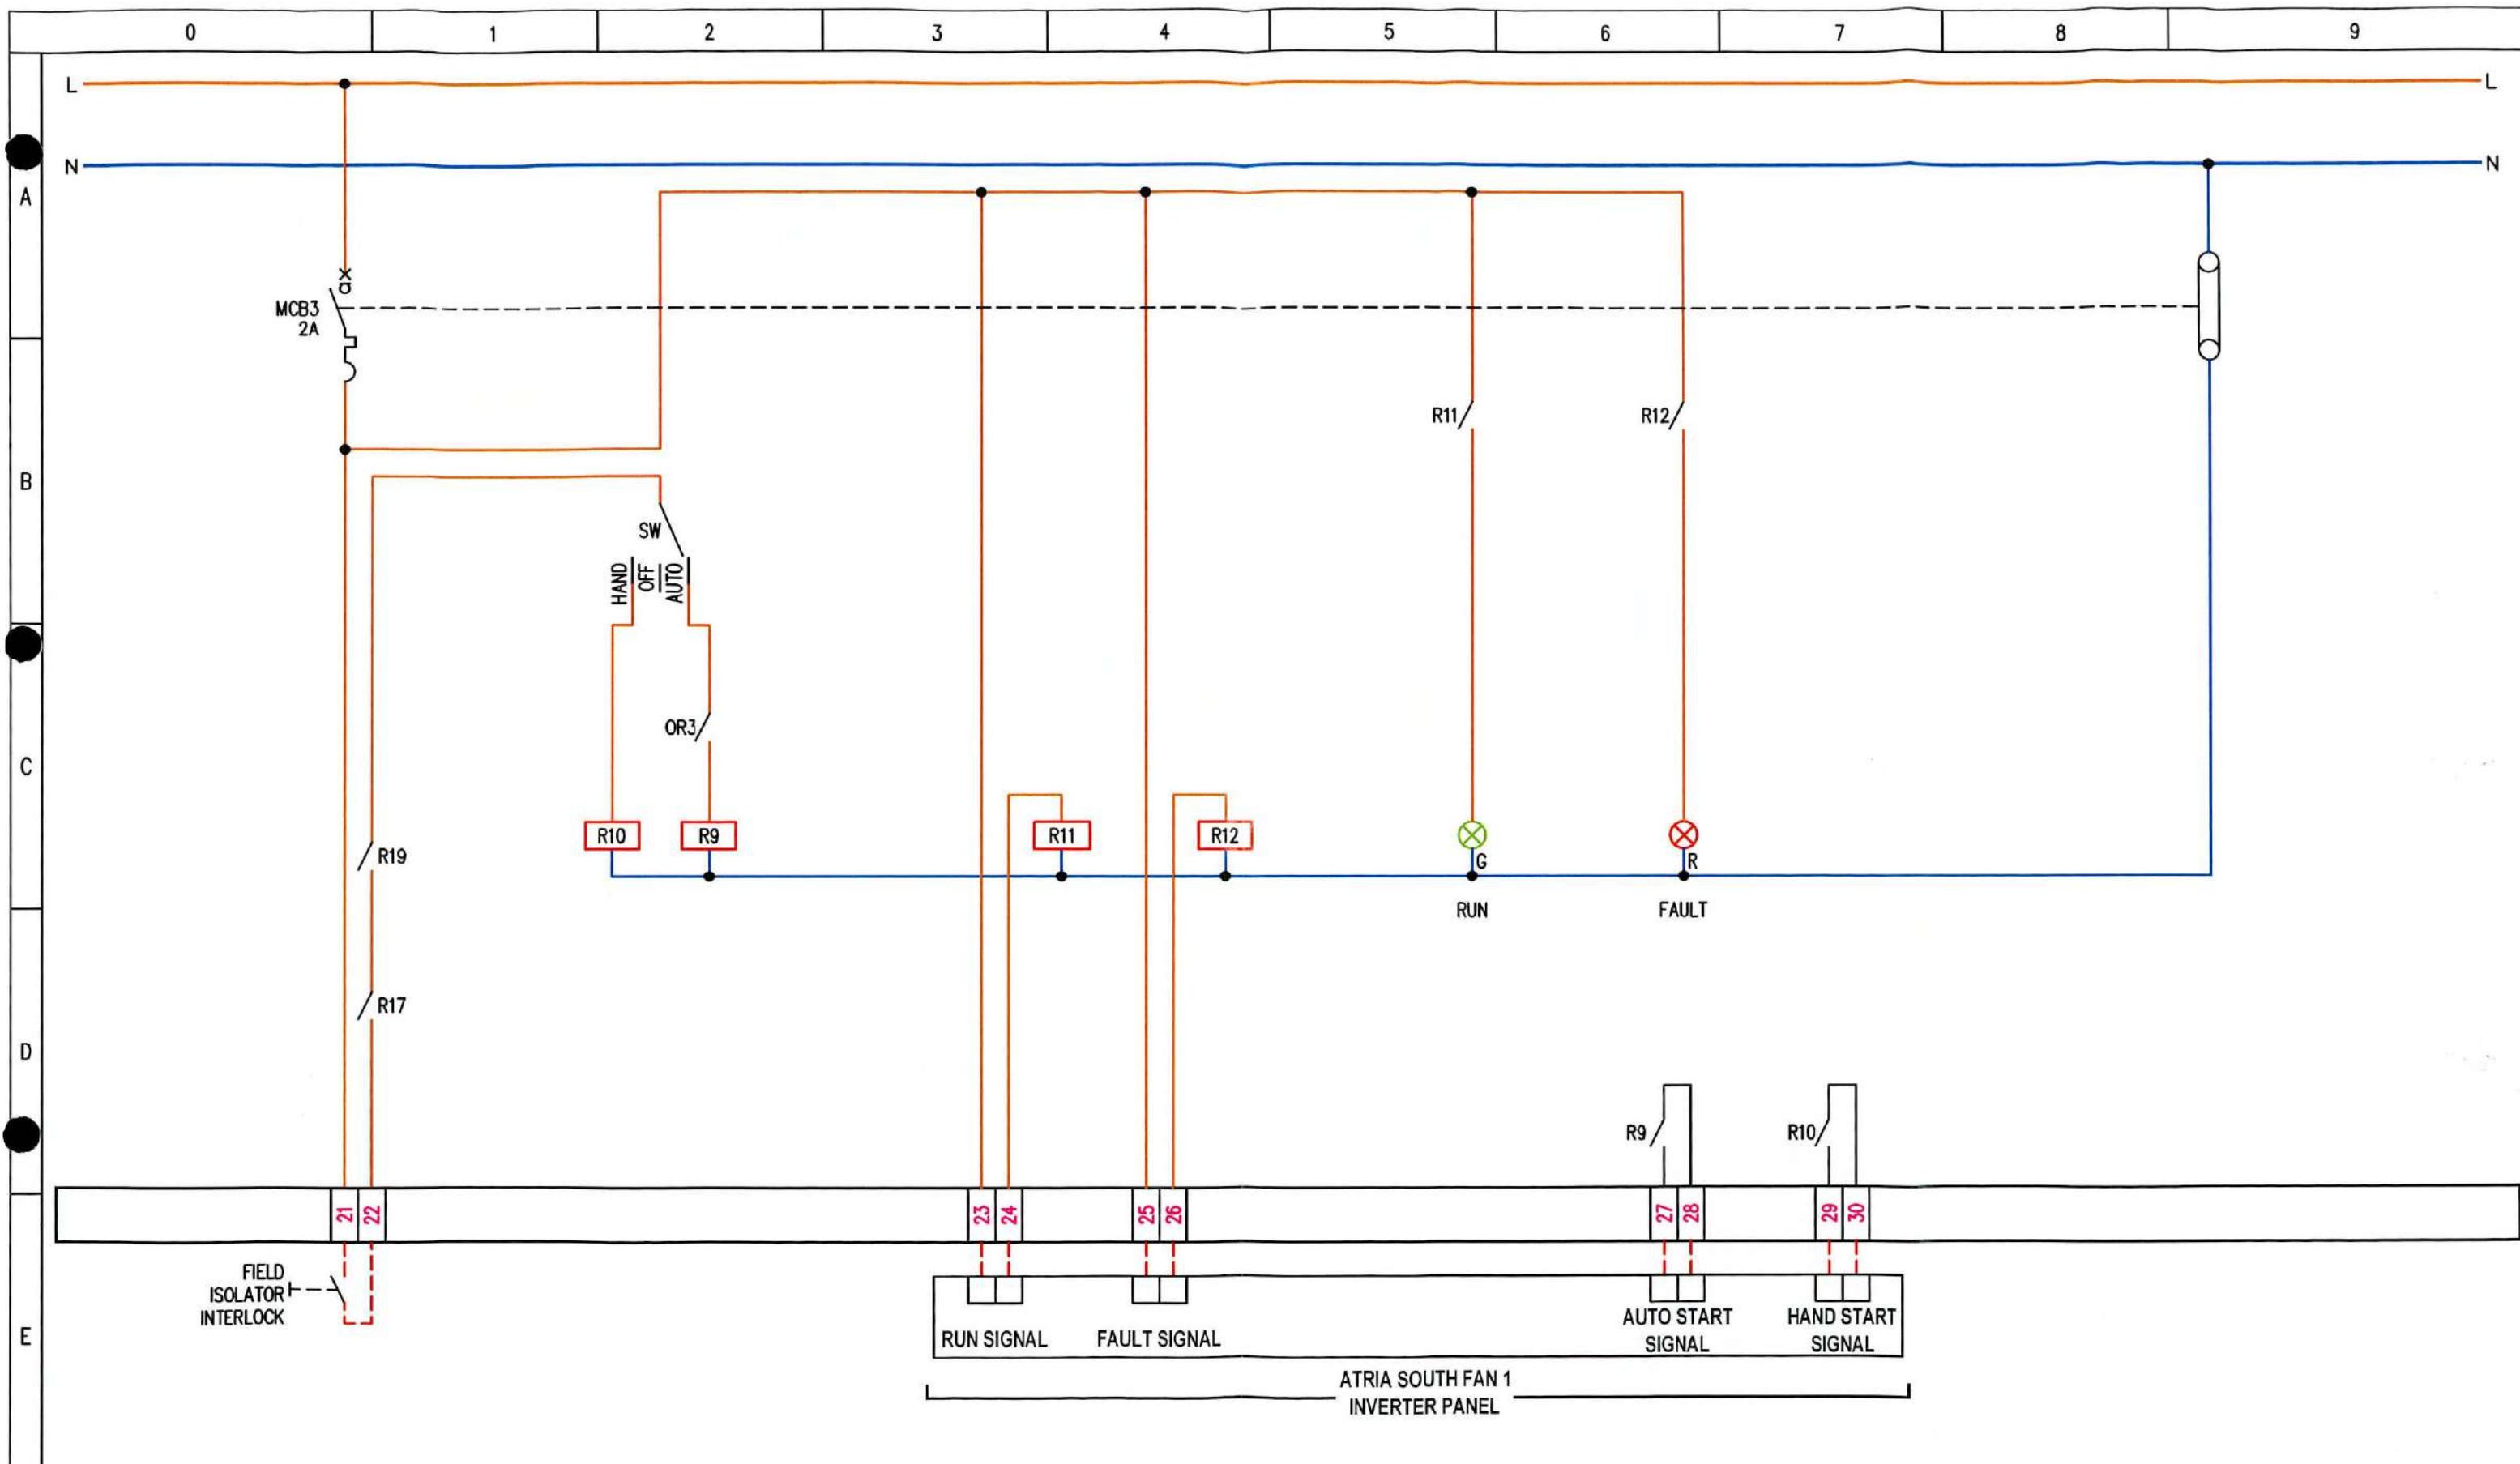

PROVISIONAL FOR APPROVAL ISSUED FOR CONSTRUCTION	AS BUILT	AS FITTED	REVISION No	DESCRIPTION OF REVISION	DRAWN BY DATE	CHECKED BY DATE	REVISION No	DESCRIPTION OF REVISION	STATUS	DRAWN BY DATE	CHECKED BY DATE	DRG No.6082-16 PROJECT No.6082	SHT. 4 of 15	REV 1 ©
			0	PROVISIONAL	RFD 14/05/21		4							
			1	AS COMMISSIONED	RFD 19/05/21		5							
			2				6							
			3				7							
bges group												TITLE EXCHEQUER COURT		
												PANEL TITLE ROOF NORTH ADDITIONAL CONTROL PANEL		
												CLIENT		

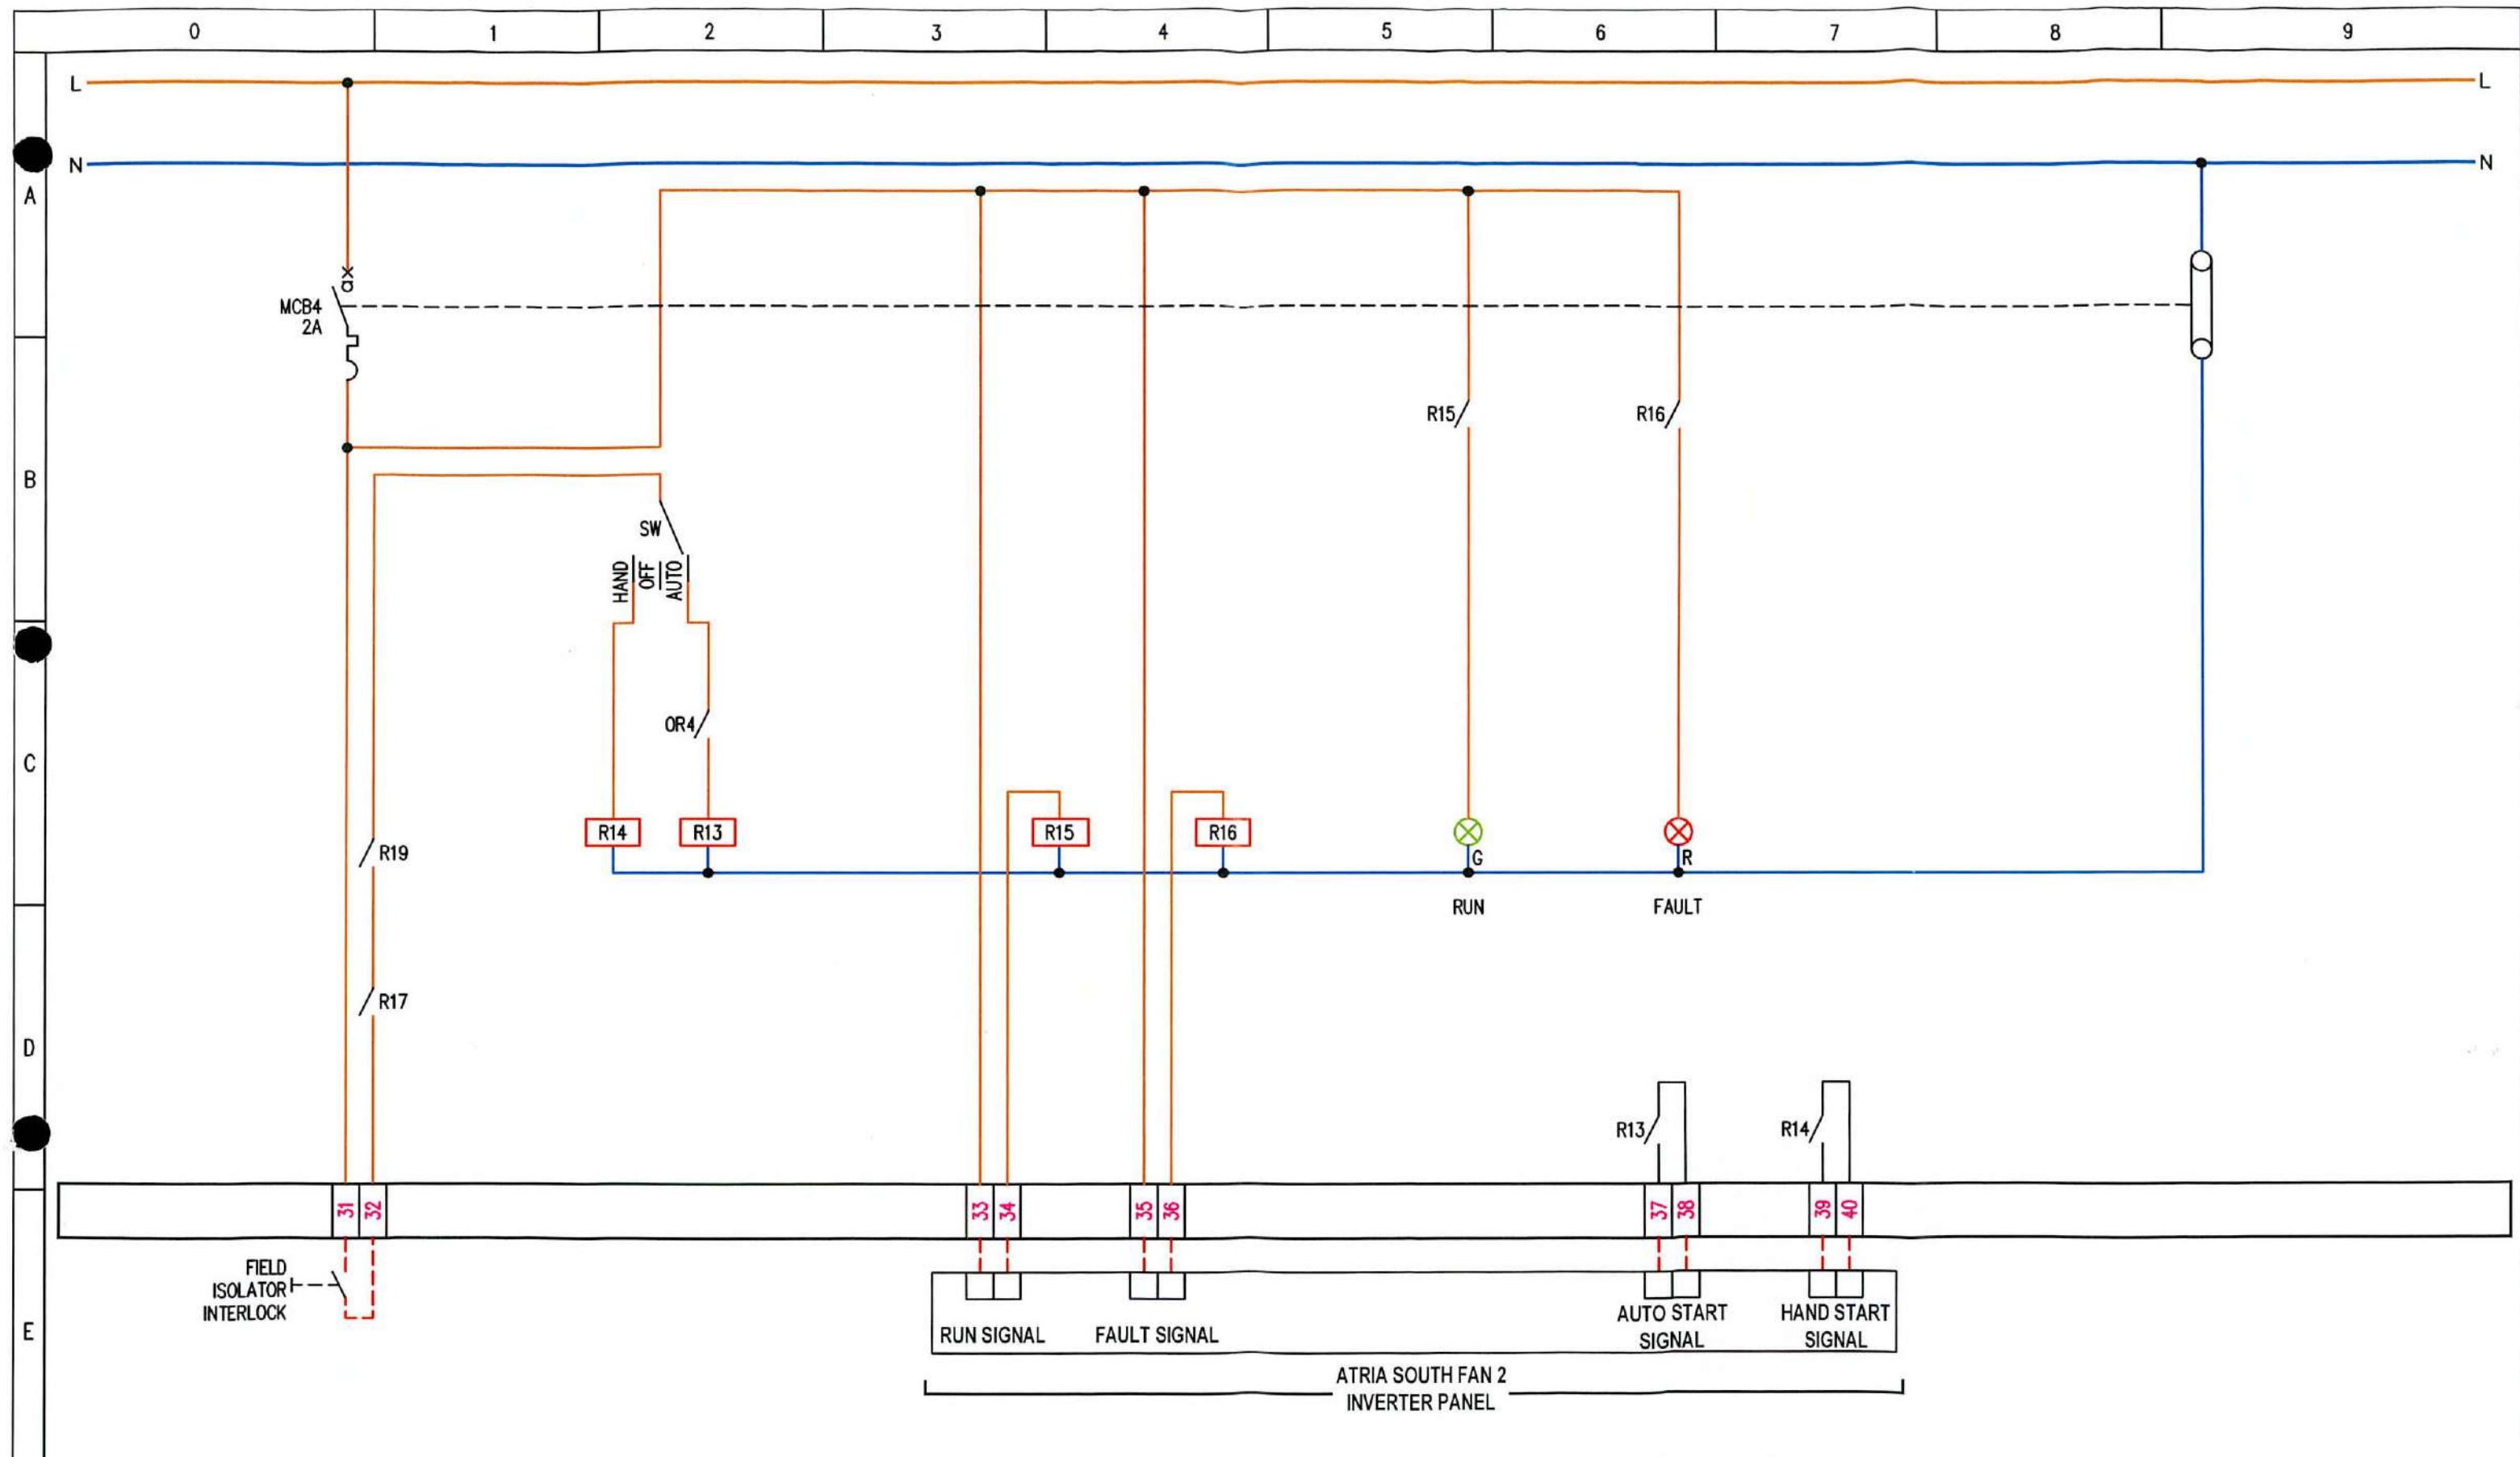


		REVISION No	DESCRIPTION OF REVISION		DRAWN BY RFD DATE	CHECKED BY RFD DATE	REVISION No	DESCRIPTION OF REVISION		STATUS	DRAWN BY RFD DATE	CHECKED BY RFD DATE	DRG No.6082-16 SHT. 5 of 15 PROJECT No.6082	
● PROVISIONAL	● AS BUILT		● FOR APPROVAL	● AS FITTED				● ISSUED FOR CONSTRUCTION	● FIELD ISOLATOR INTERLOCK				● TITLE	EXCHEQUER COURT
0	PROVISIONAL				RFD 14/05/21		4						PANEL TITLE	ROOF NORTH ADDITIONAL CONTROL PANEL
1	AS COMMISSIOND				RFD 19/05/21		5						CLIENT	
2							6							
3							7							

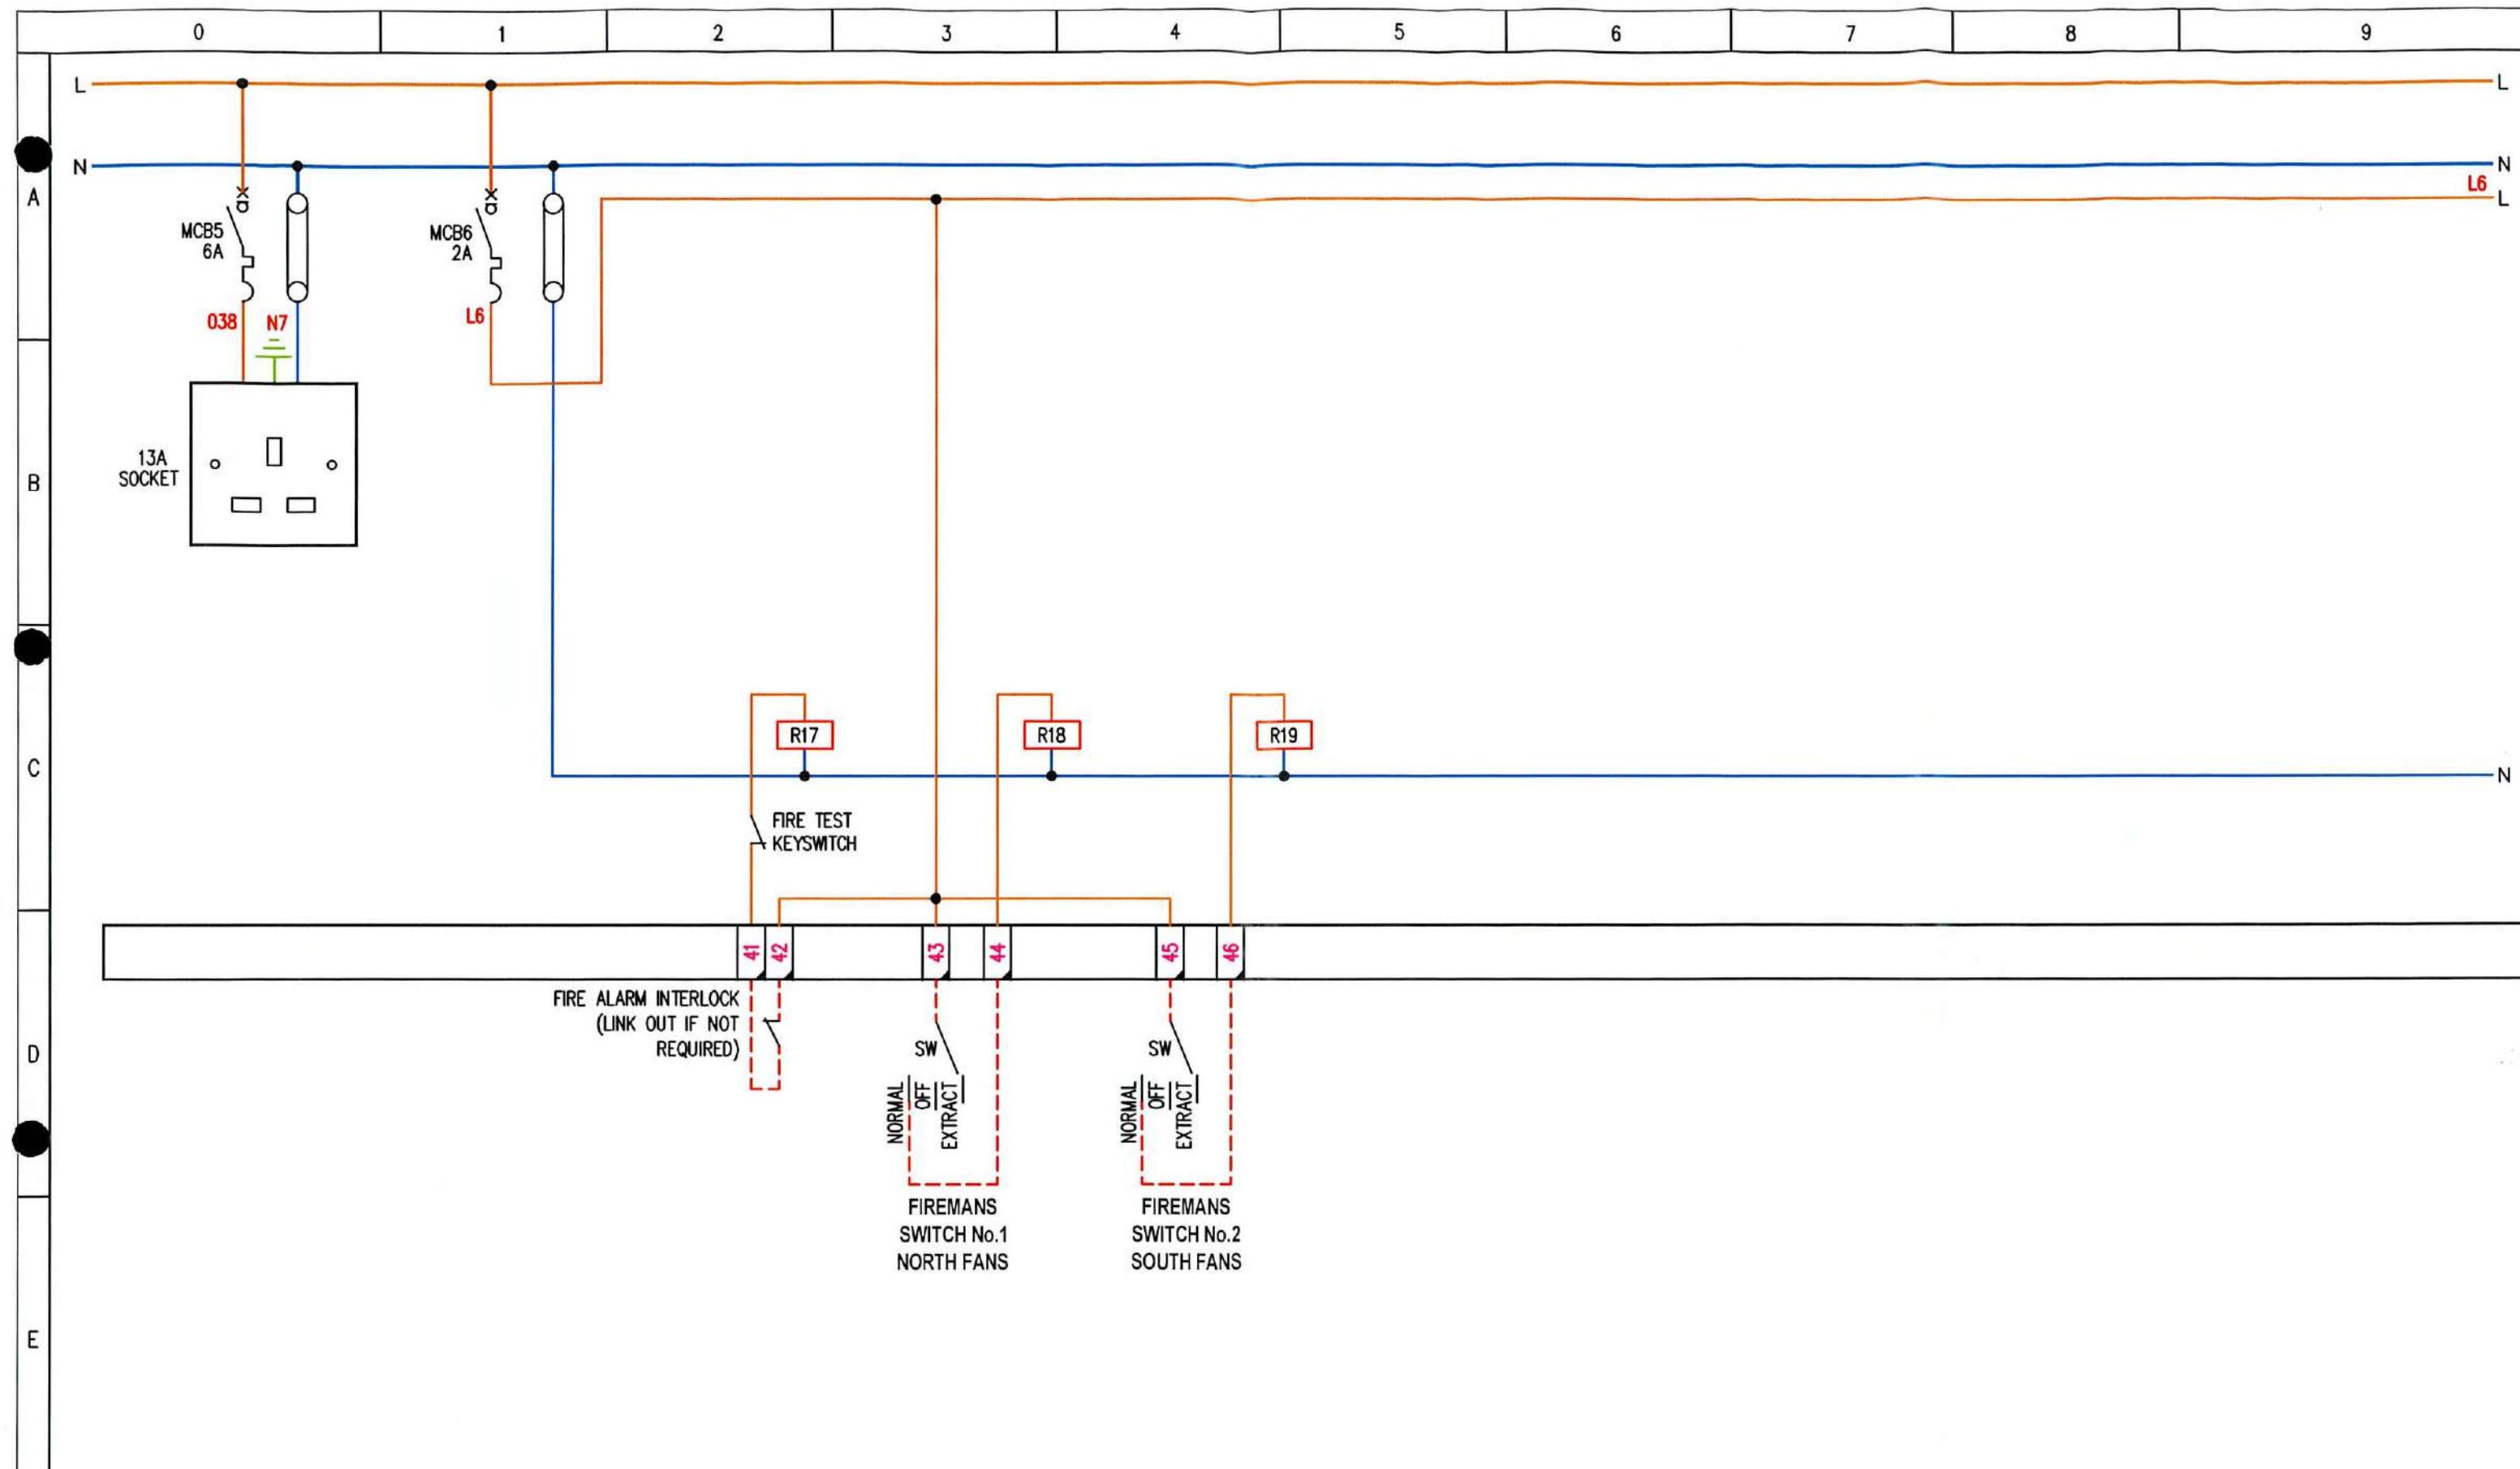



		REVISION No	DESCRIPTION OF REVISION	DRAWN BY DATE	CHECKED BY DATE	REVISION No	DESCRIPTION OF REVISION	STATUS	DRAWN BY DATE	CHECKED BY DATE	DRG No.6082-16 SHT. 7 of 15 REV 1 PROJECT No.6082		
● PROVISIONAL ● FOR APPROVAL ● ISSUED FOR CONSTRUCTION	● AS BUILT ● AS FITTED												
		0	PROVISIONAL	RFD 14/05/21		4					TITLE	EXCHEQUER COURT	
		1	AS COMMISSIOND	RFD 19/05/21		5					PANEL TITLE	ROOF NORTH ADDITIONAL CONTROL PANEL	
		2				6					CLIENT		
		3				7							

0 1 2 3 4 5 6 7 8 9

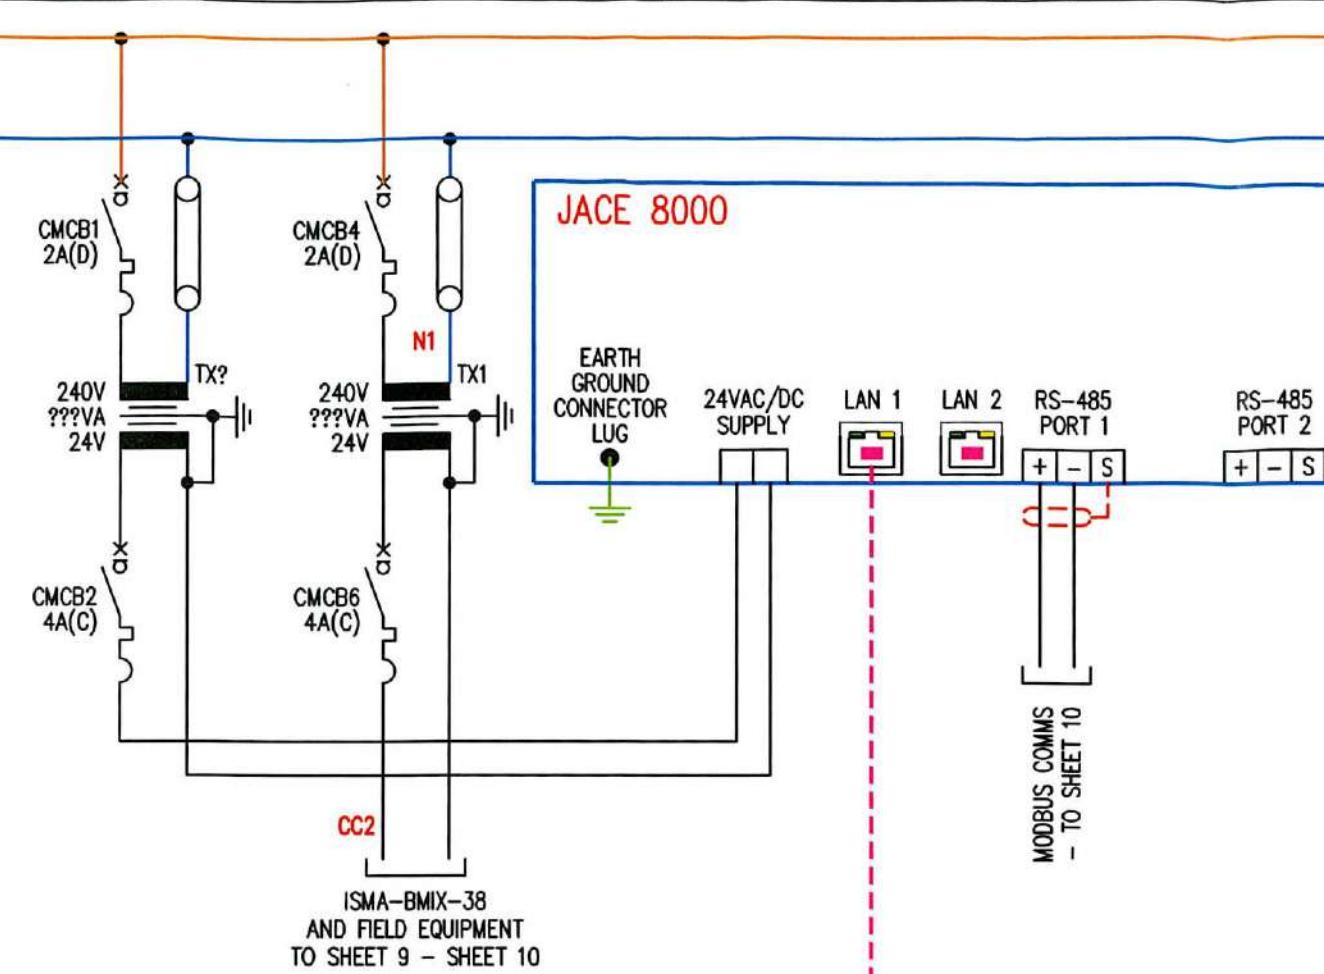


ETHERNET CONNECTION

● PROVISIONAL ● FOR APPROVAL ● ISSUED FOR CONSTRUCTION	● AS BUILT ● AS FITTED
REVISION No	DESCRIPTION OF REVISION
0	PROVISIONAL
1	AS COMMISSIONED
2	
3	


bgesgroup

DRAWN BY	CHECKED BY	REVISION No	DESCRIPTION OF REVISION	STATUS	DRAWN BY	CHECKED BY	REVISION No
RFD 14/05/21		4					
RFD 19/05/21		5					
		6					
		7					

DRG No.6082-16 SHT. 8 of 15 REV 1
PROJECT No.6082
©
TITLE EXCHEQUER COURT
PANEL TITLE ROOF NORTH ADDITIONAL CONTROL PANEL
CLIENT

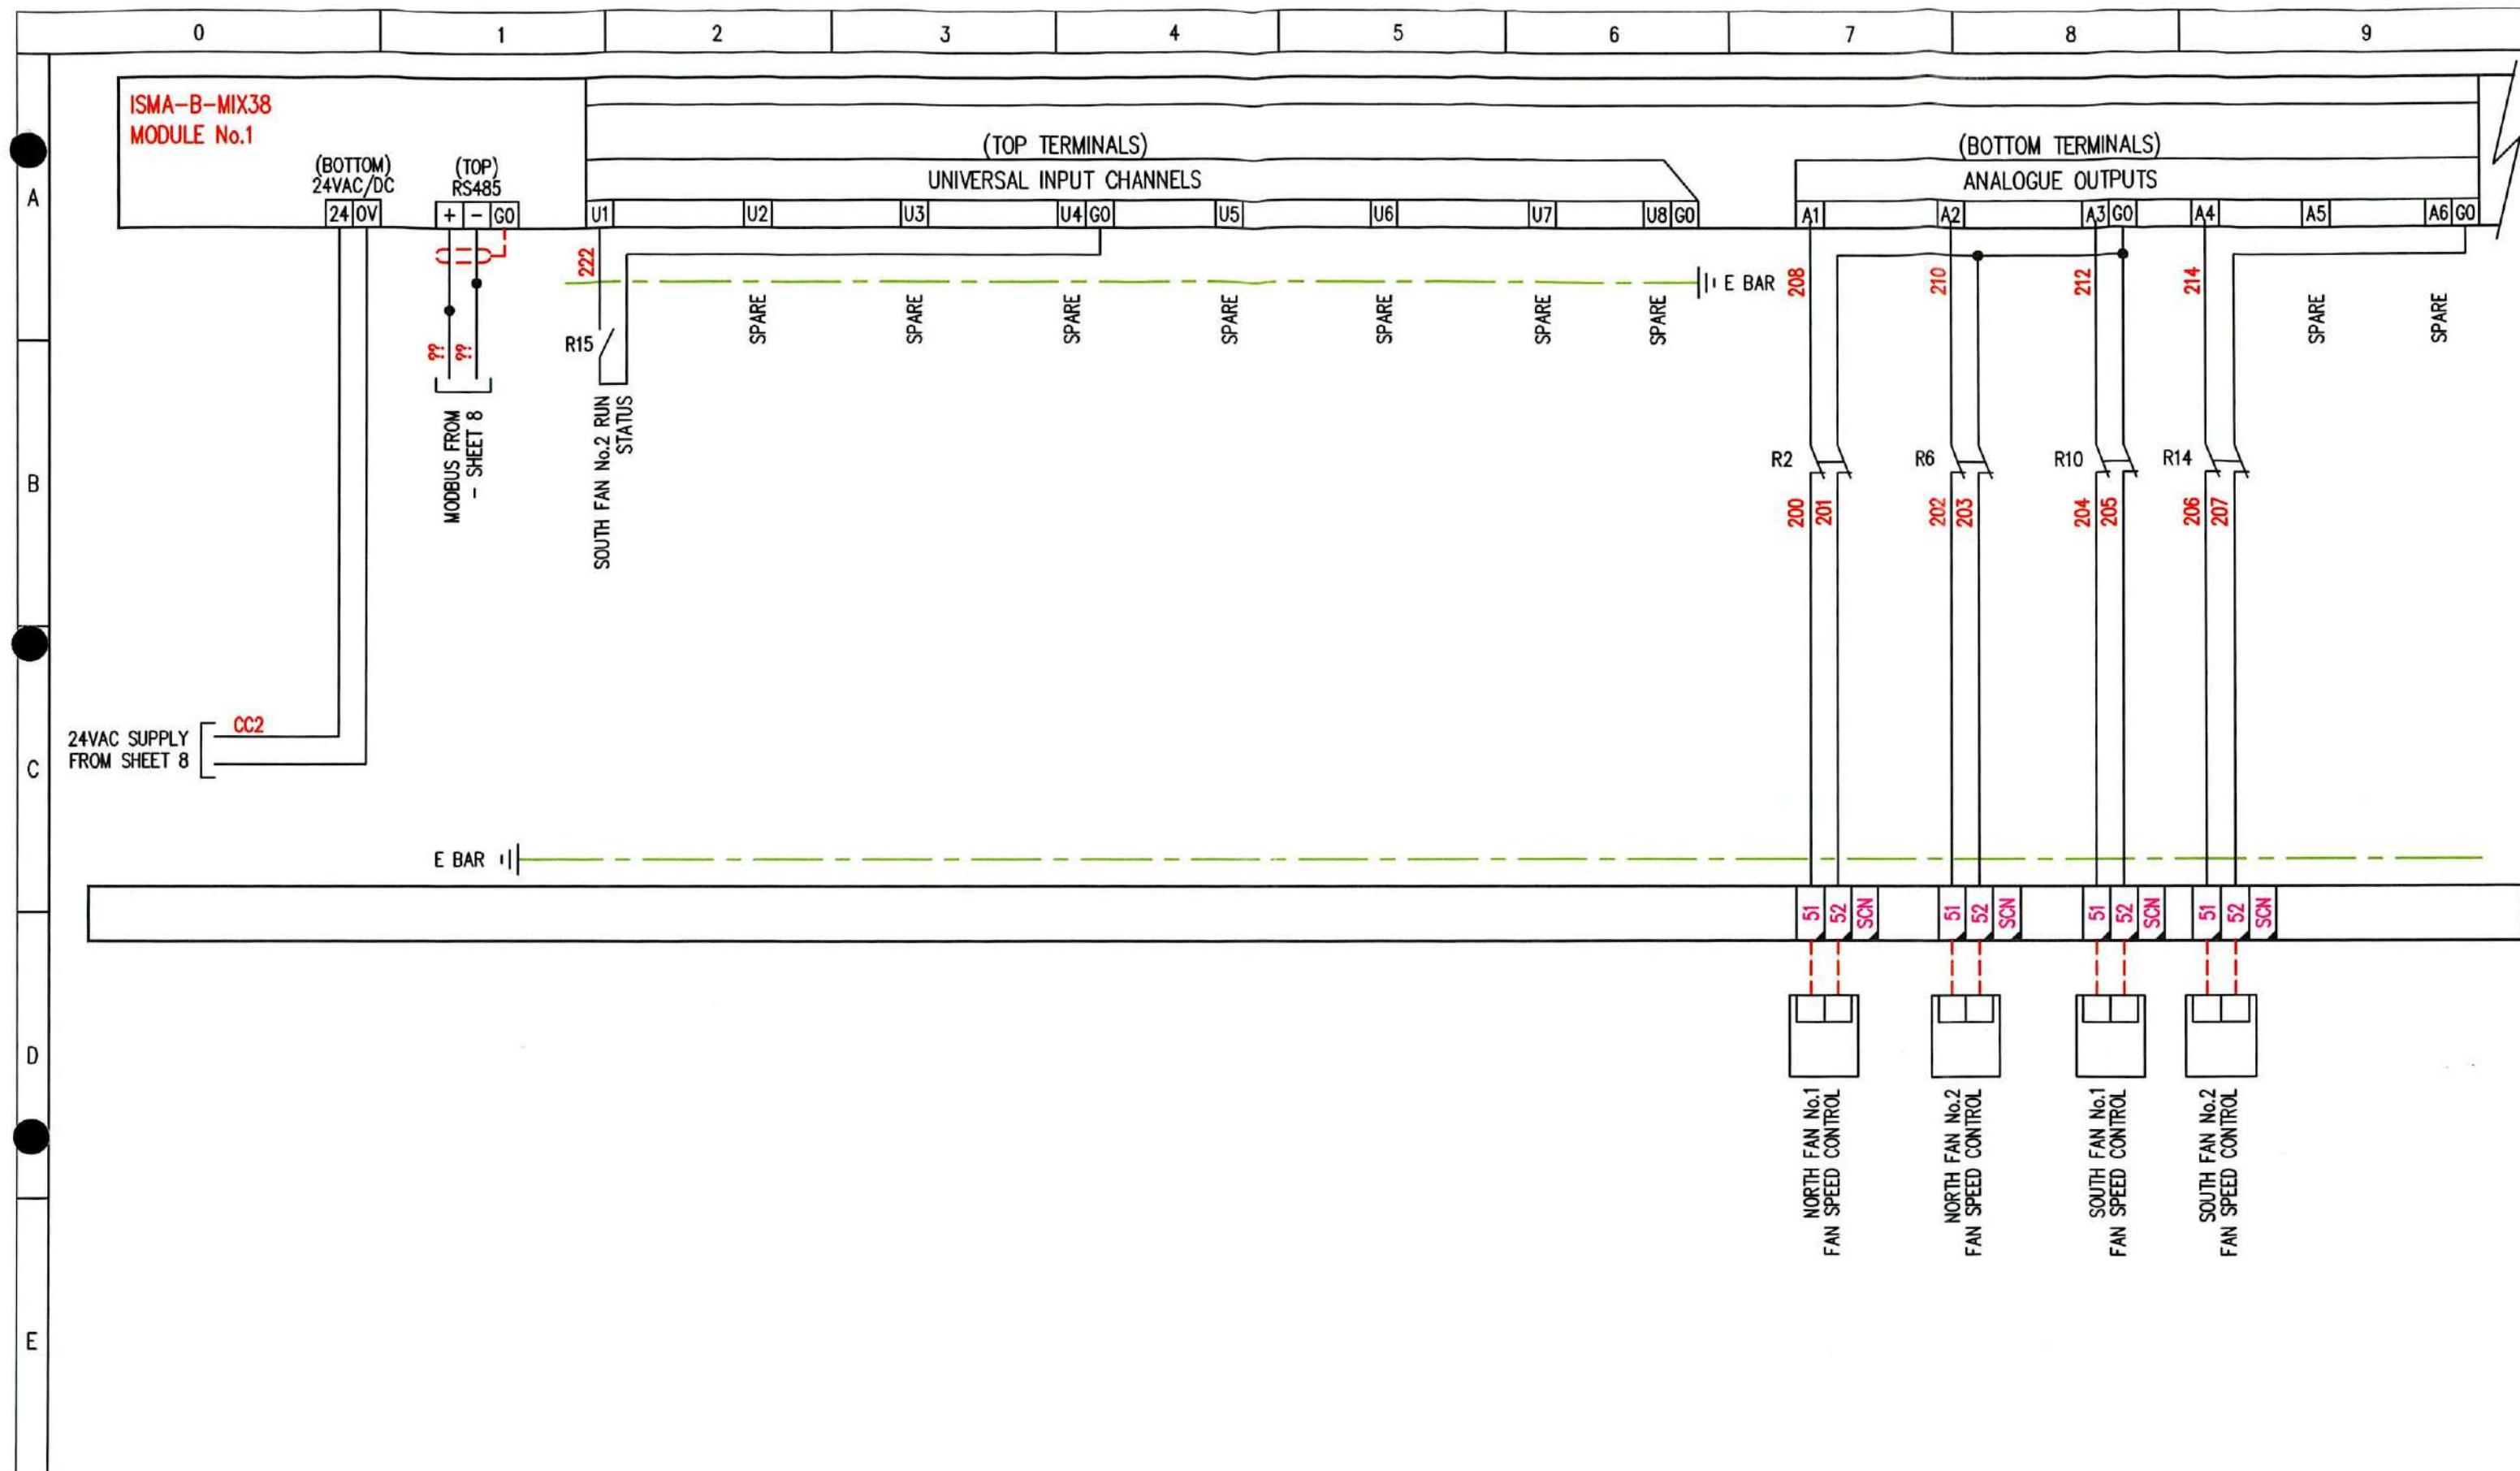


0 1 2 3 4 5 6 7 8 9

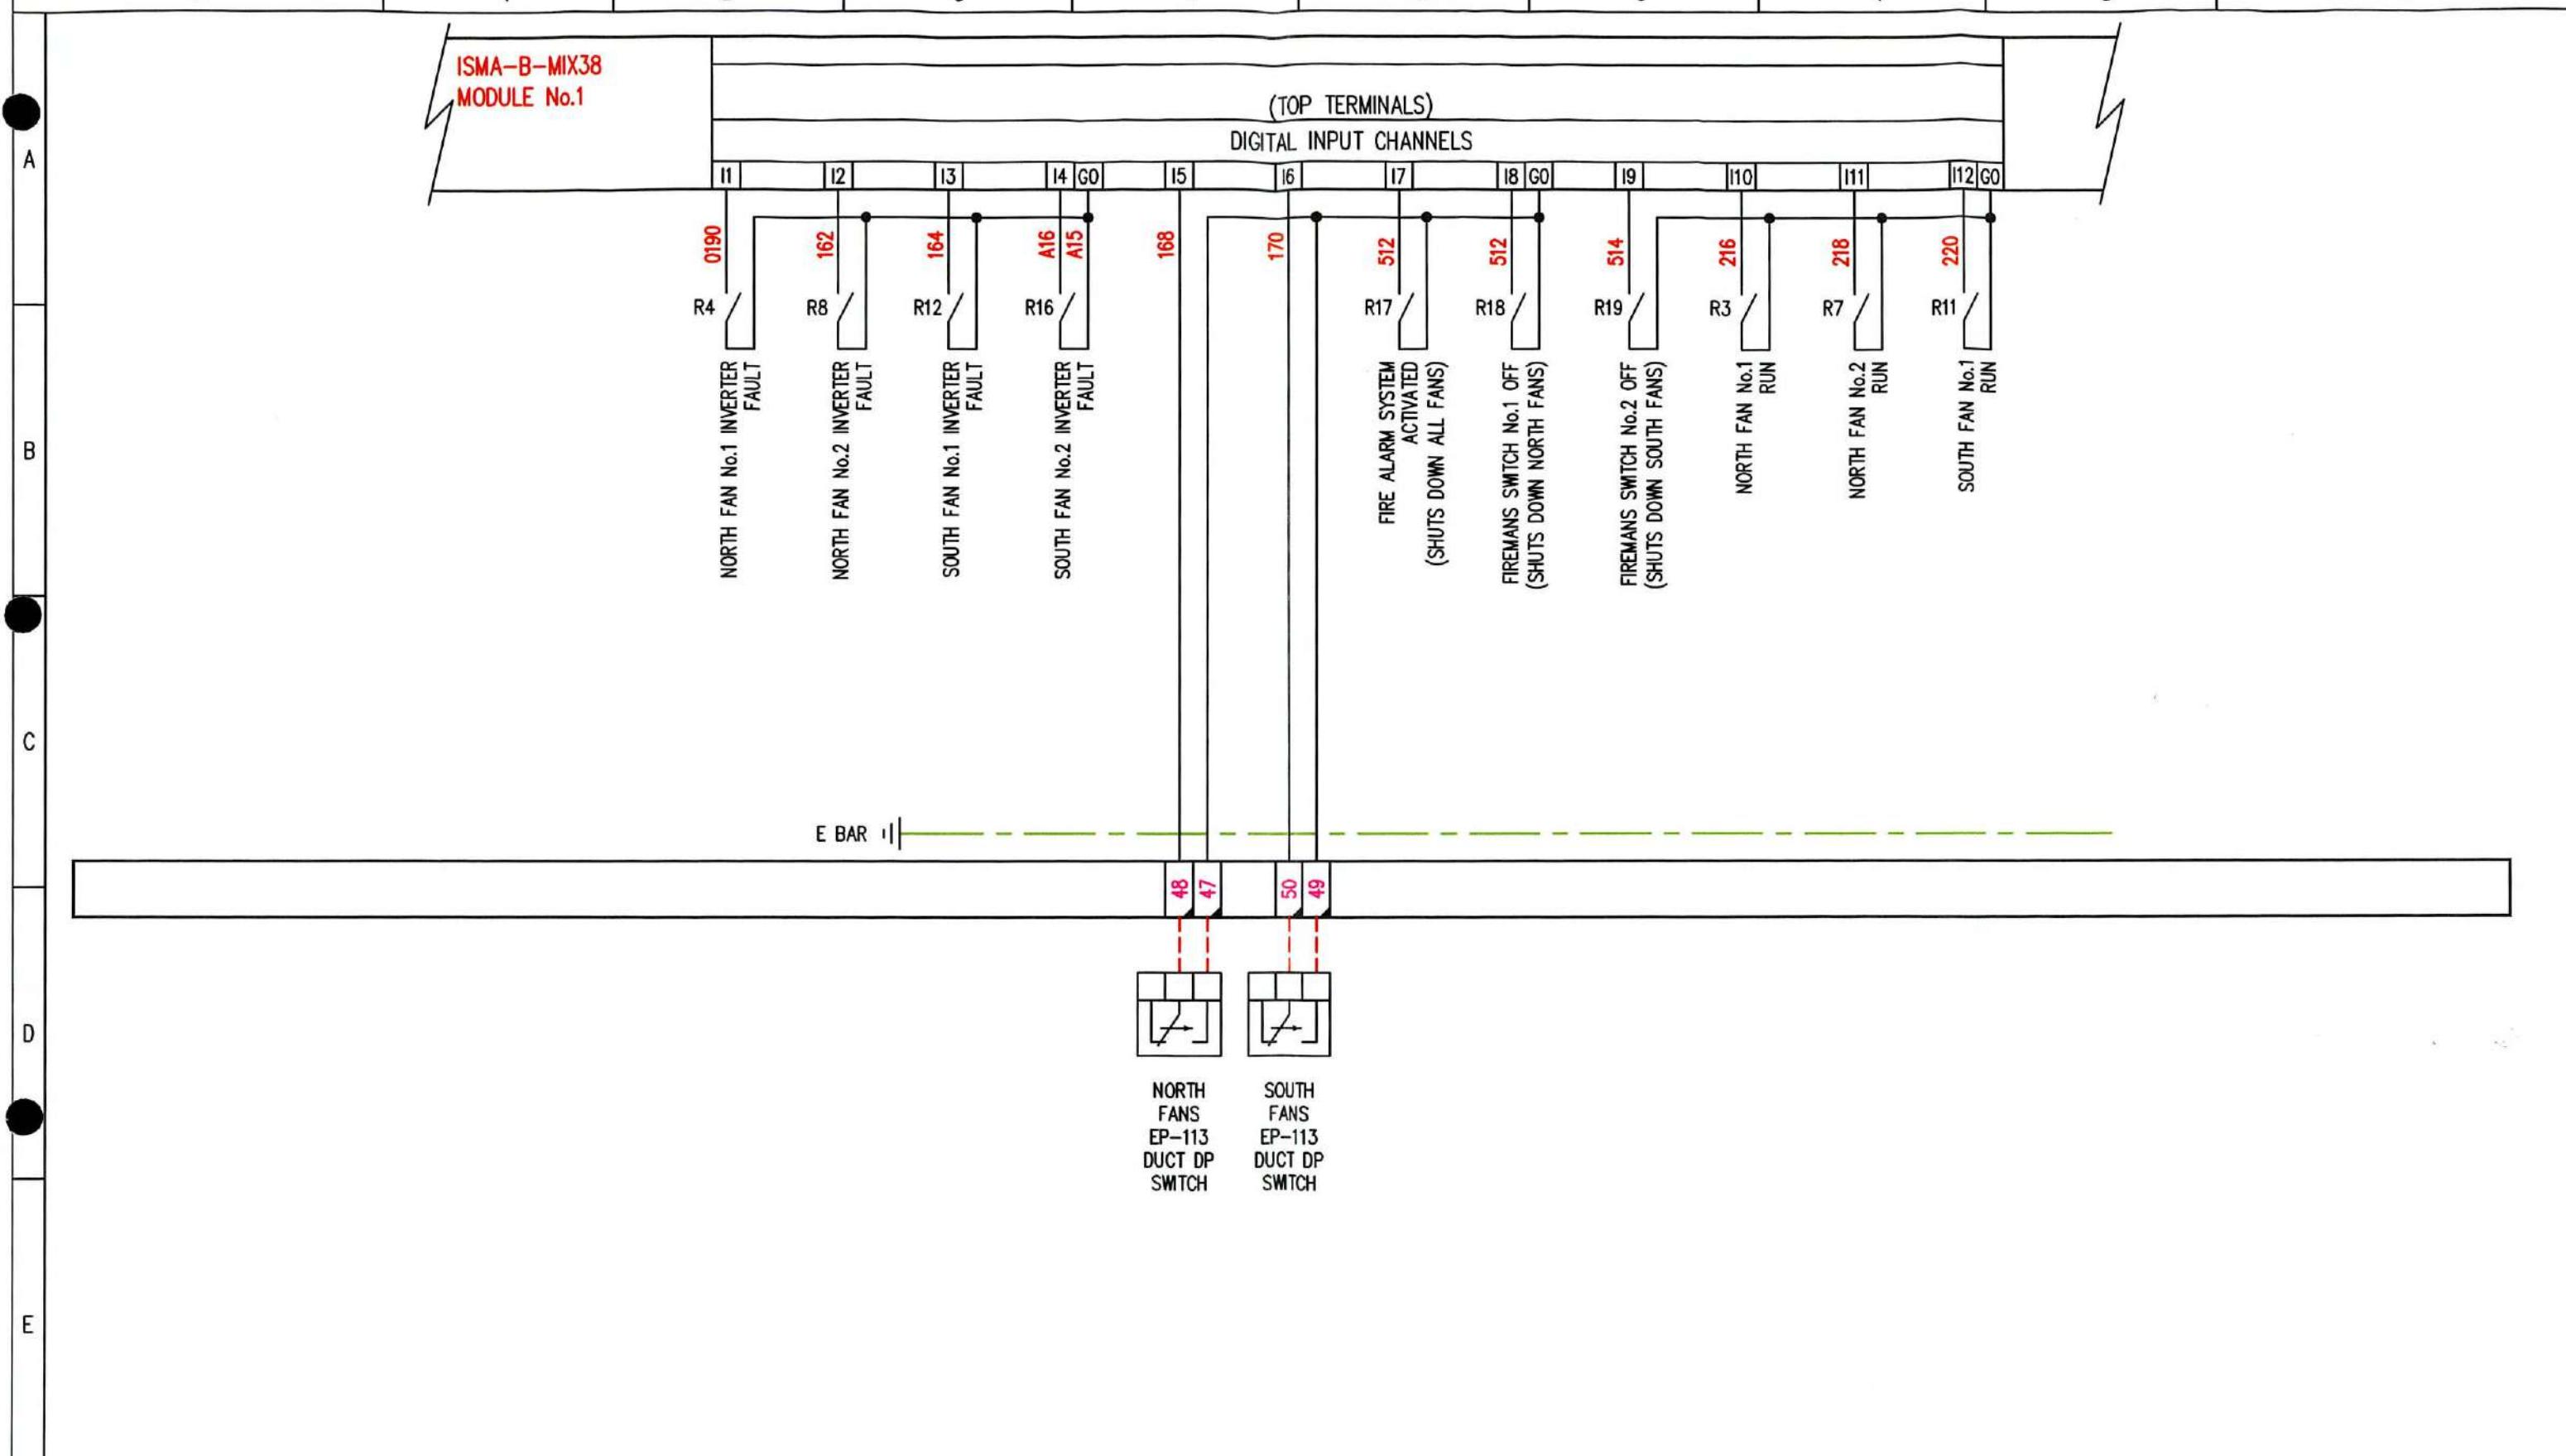

PROVISIONAL FOR APPROVAL ISSUED FOR CONSTRUCTION	AS BUILT AS FITTED	REVISION No	DESCRIPTION OF REVISION	DRAWN BY DATE	CHECKED BY DATE	REVISION No	DESCRIPTION OF REVISION	STATUS	DRAWN BY DATE	CHECKED BY DATE	DRG No.6082-16 PROJECT No.6082	SHT. 10 of 15	REV 1 ©
		0	PROVISIONAL	RFD 14/05/21		4							
		1	AS COMMISSIOND	RFD 19/05/21		5							
		2				6							
		3				7							

bges group

0 1 2 3 4 5 6 7 8 9

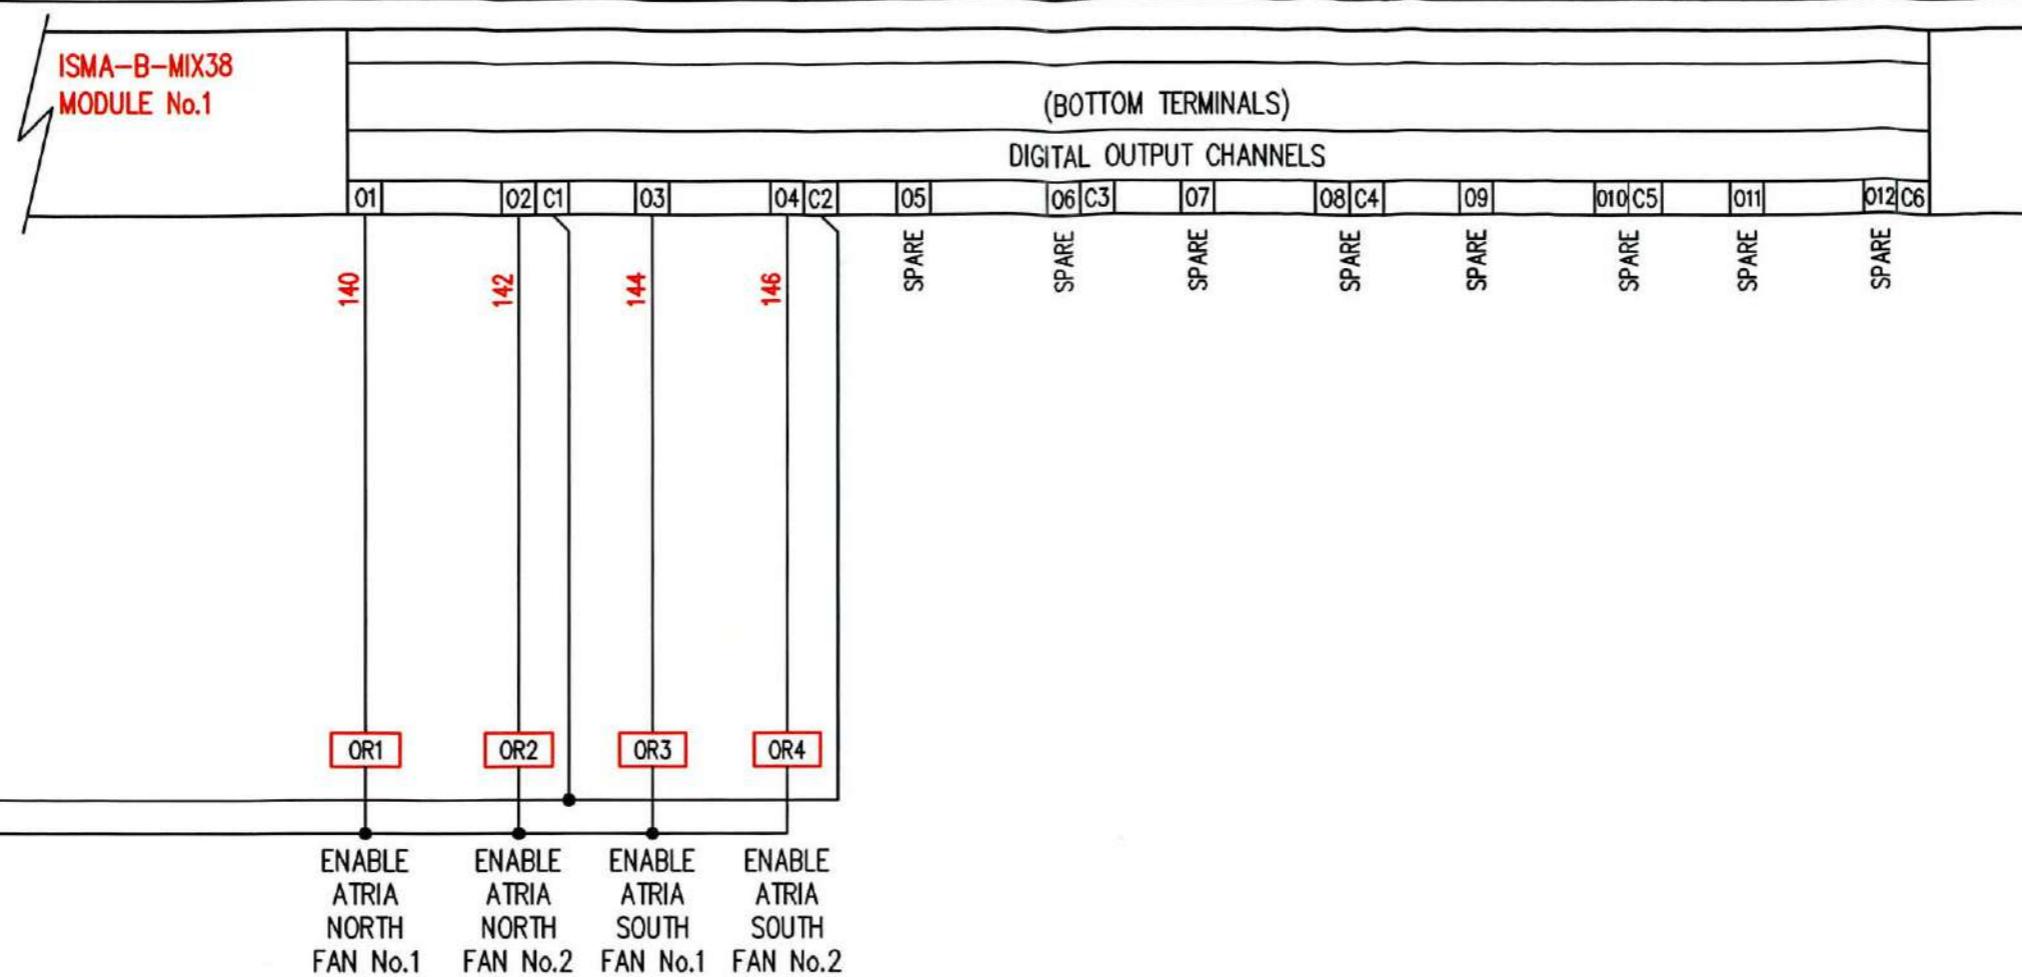

PROVISIONAL FOR APPROVAL ISSUED FOR CONSTRUCTION	AS BUILT AS FITTED	REVISION No	DESCRIPTION OF REVISION	DRAWN BY DATE	CHECKED BY DATE	REVISION No	DESCRIPTION OF REVISION	STATUS	DRAWN BY DATE	CHECKED BY DATE	DRG No.6082-16 PROJECT No.6082	SHT. 11 of 15	REV 1 ©
		0	PROVISIONAL	RFD 14/05/21		4							
		1	AS COMMISSIOND	RFD 19/05/21		5							
		2				6							
		3				7							

bgesgroup

SPARE PAGE
ANTICIPATED USE

A

B

C

D

E


PROVISIONAL AS BUILT
 FOR APPROVAL AS FITTED
 ISSUED FOR CONSTRUCTION



REVISION No	DESCRIPTION OF REVISION	DRAWN BY	CHECKED BY	REVISION No	DESCRIPTION OF REVISION	STATUS	DRAWN BY	CHECKED BY	DRG No.6082-16 SHT. 12 of 15 PROJECT No.6082
		DATE	DATE	DATE			DATE	DATE	REV 1 ©
0	PROVISIONAL	RFD 14/05/21		4					TITLE EXCHEQUER COURT
1	AS COMMISSIOND	RFD 19/05/21		5					PANEL TITLE ROOF NORTH ADDITIONAL CONTROL PANEL
2				6					
3				7					CLIENT

0 1 2 3 4 5 6 7 8 9

A
B
C
D
E

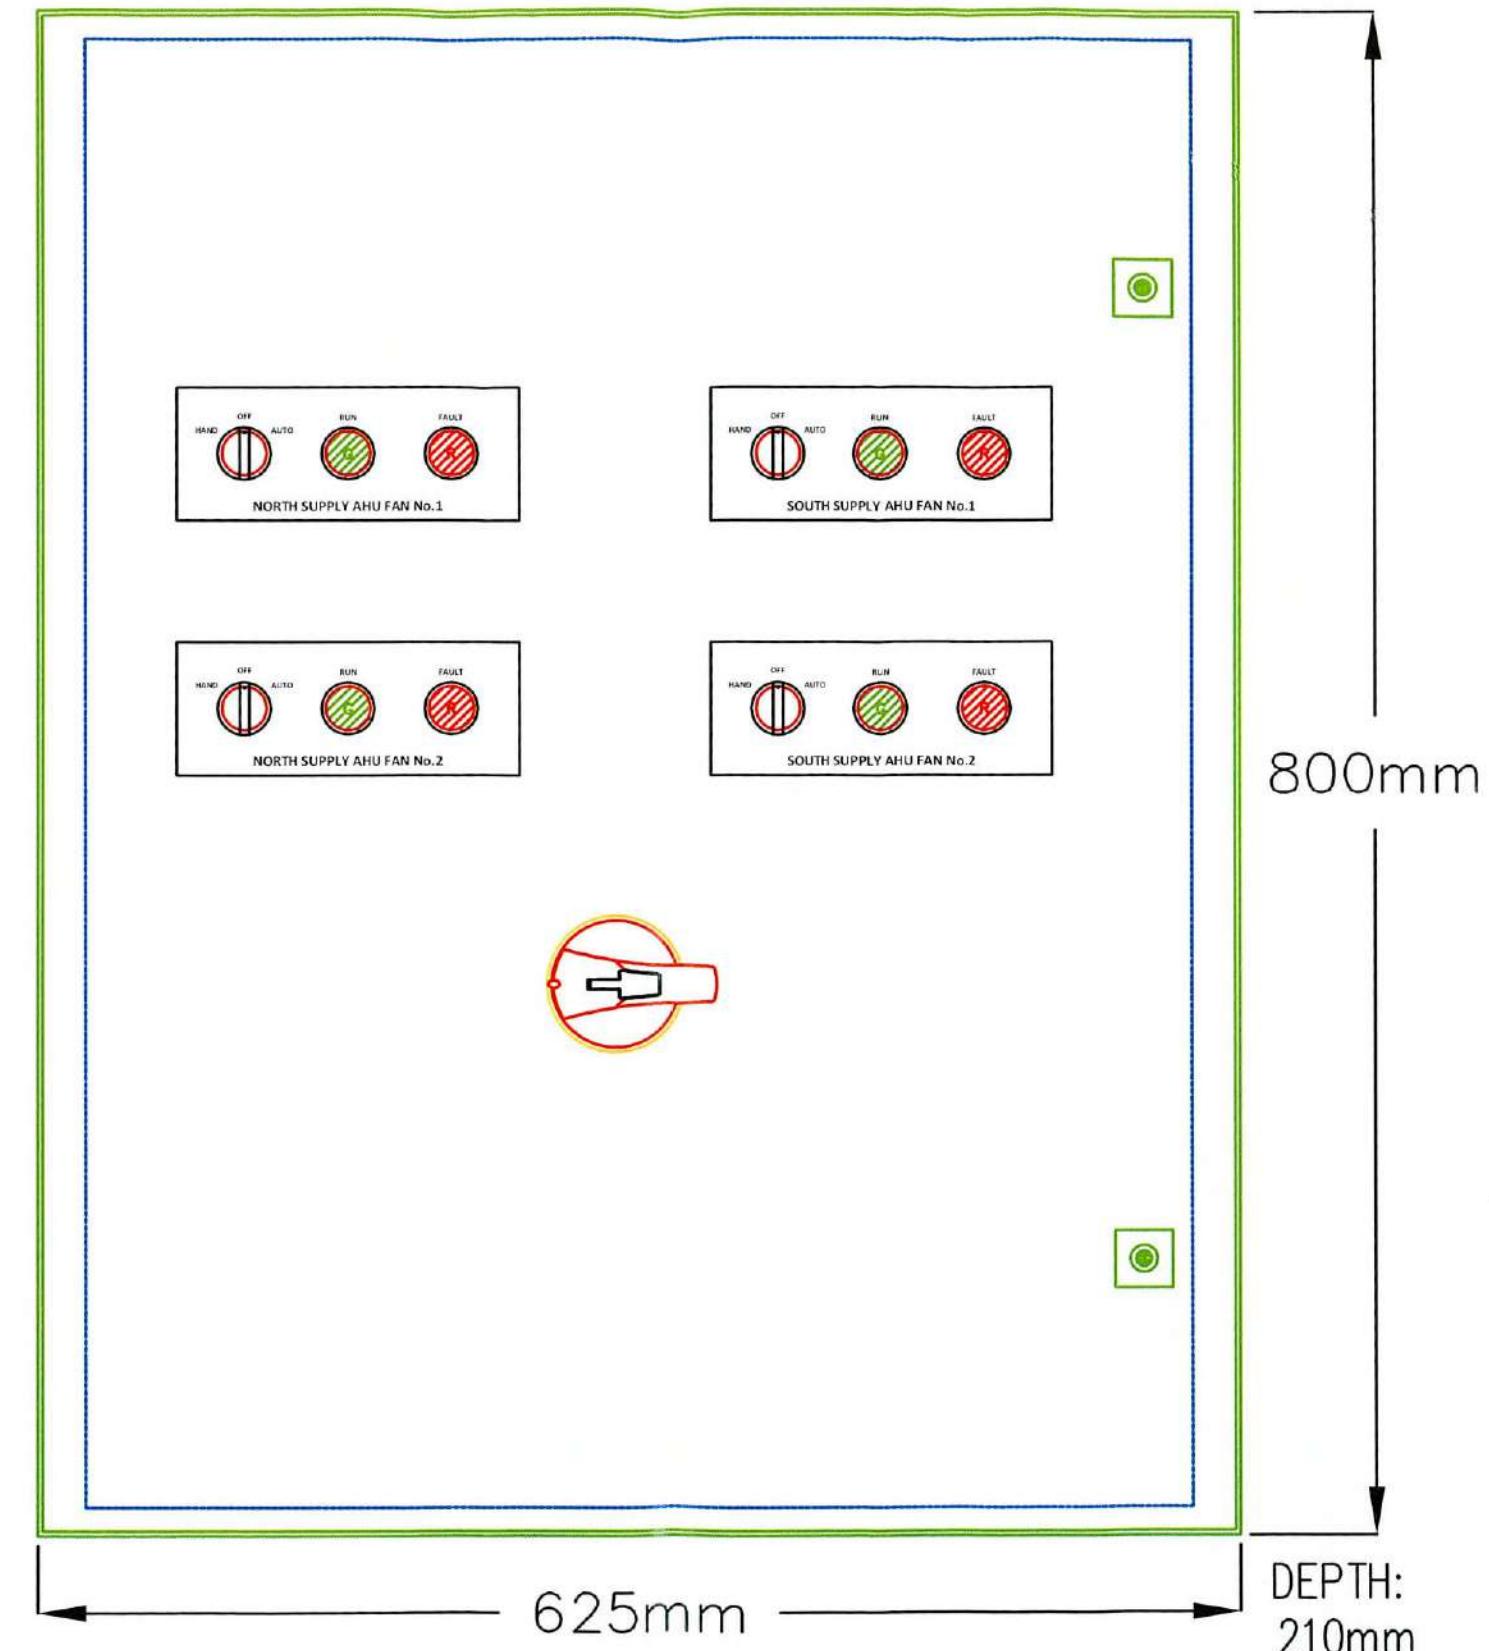

PROVISIONAL FOR APPROVAL ISSUED FOR CONSTRUCTION		AS BUILT AS FITTED		REVISION No	DESCRIPTION OF REVISION		DRAWN BY DATE	CHECKED BY DATE	REVISION No	DESCRIPTION OF REVISION		STATUS	DRAWN BY DATE	CHECKED BY DATE	DRG No.6082-16 PROJECT No.6082	SHT. 13 of 15	REV 1 ©
0	PROVISIONAL						RFD 14/05/21		4								
1	AS COMMISSIOND						RFD 19/05/21		5								
2									6								
3									7								
bges group																	

SPARE PAGE
ANTICIPATED USE

A

B

C


D

E

PROVISIONAL AS BUILT
 FOR APPROVAL AS FITTED
 ISSUED FOR CONSTRUCTION



REVISION No	DESCRIPTION OF REVISION	DRAWN BY	CHECKED BY	REVISION No	DESCRIPTION OF REVISION	STATUS	DRAWN BY	CHECKED BY	DRG No.6082-16 SHT. 14 of 15 PROJECT No.6082
		DATE	DATE	DATE			DATE	DATE	REV 1 ©
0	PROVISIONAL	RFD 14/05/21		4					TITLE EXCHEQUER COURT
1	AS COMMISSIOND	RFD 19/05/21		5					PANEL TITLE ROOF NORTH ADDITIONAL CONTROL PANEL
2				6					
3				7					CLIENT

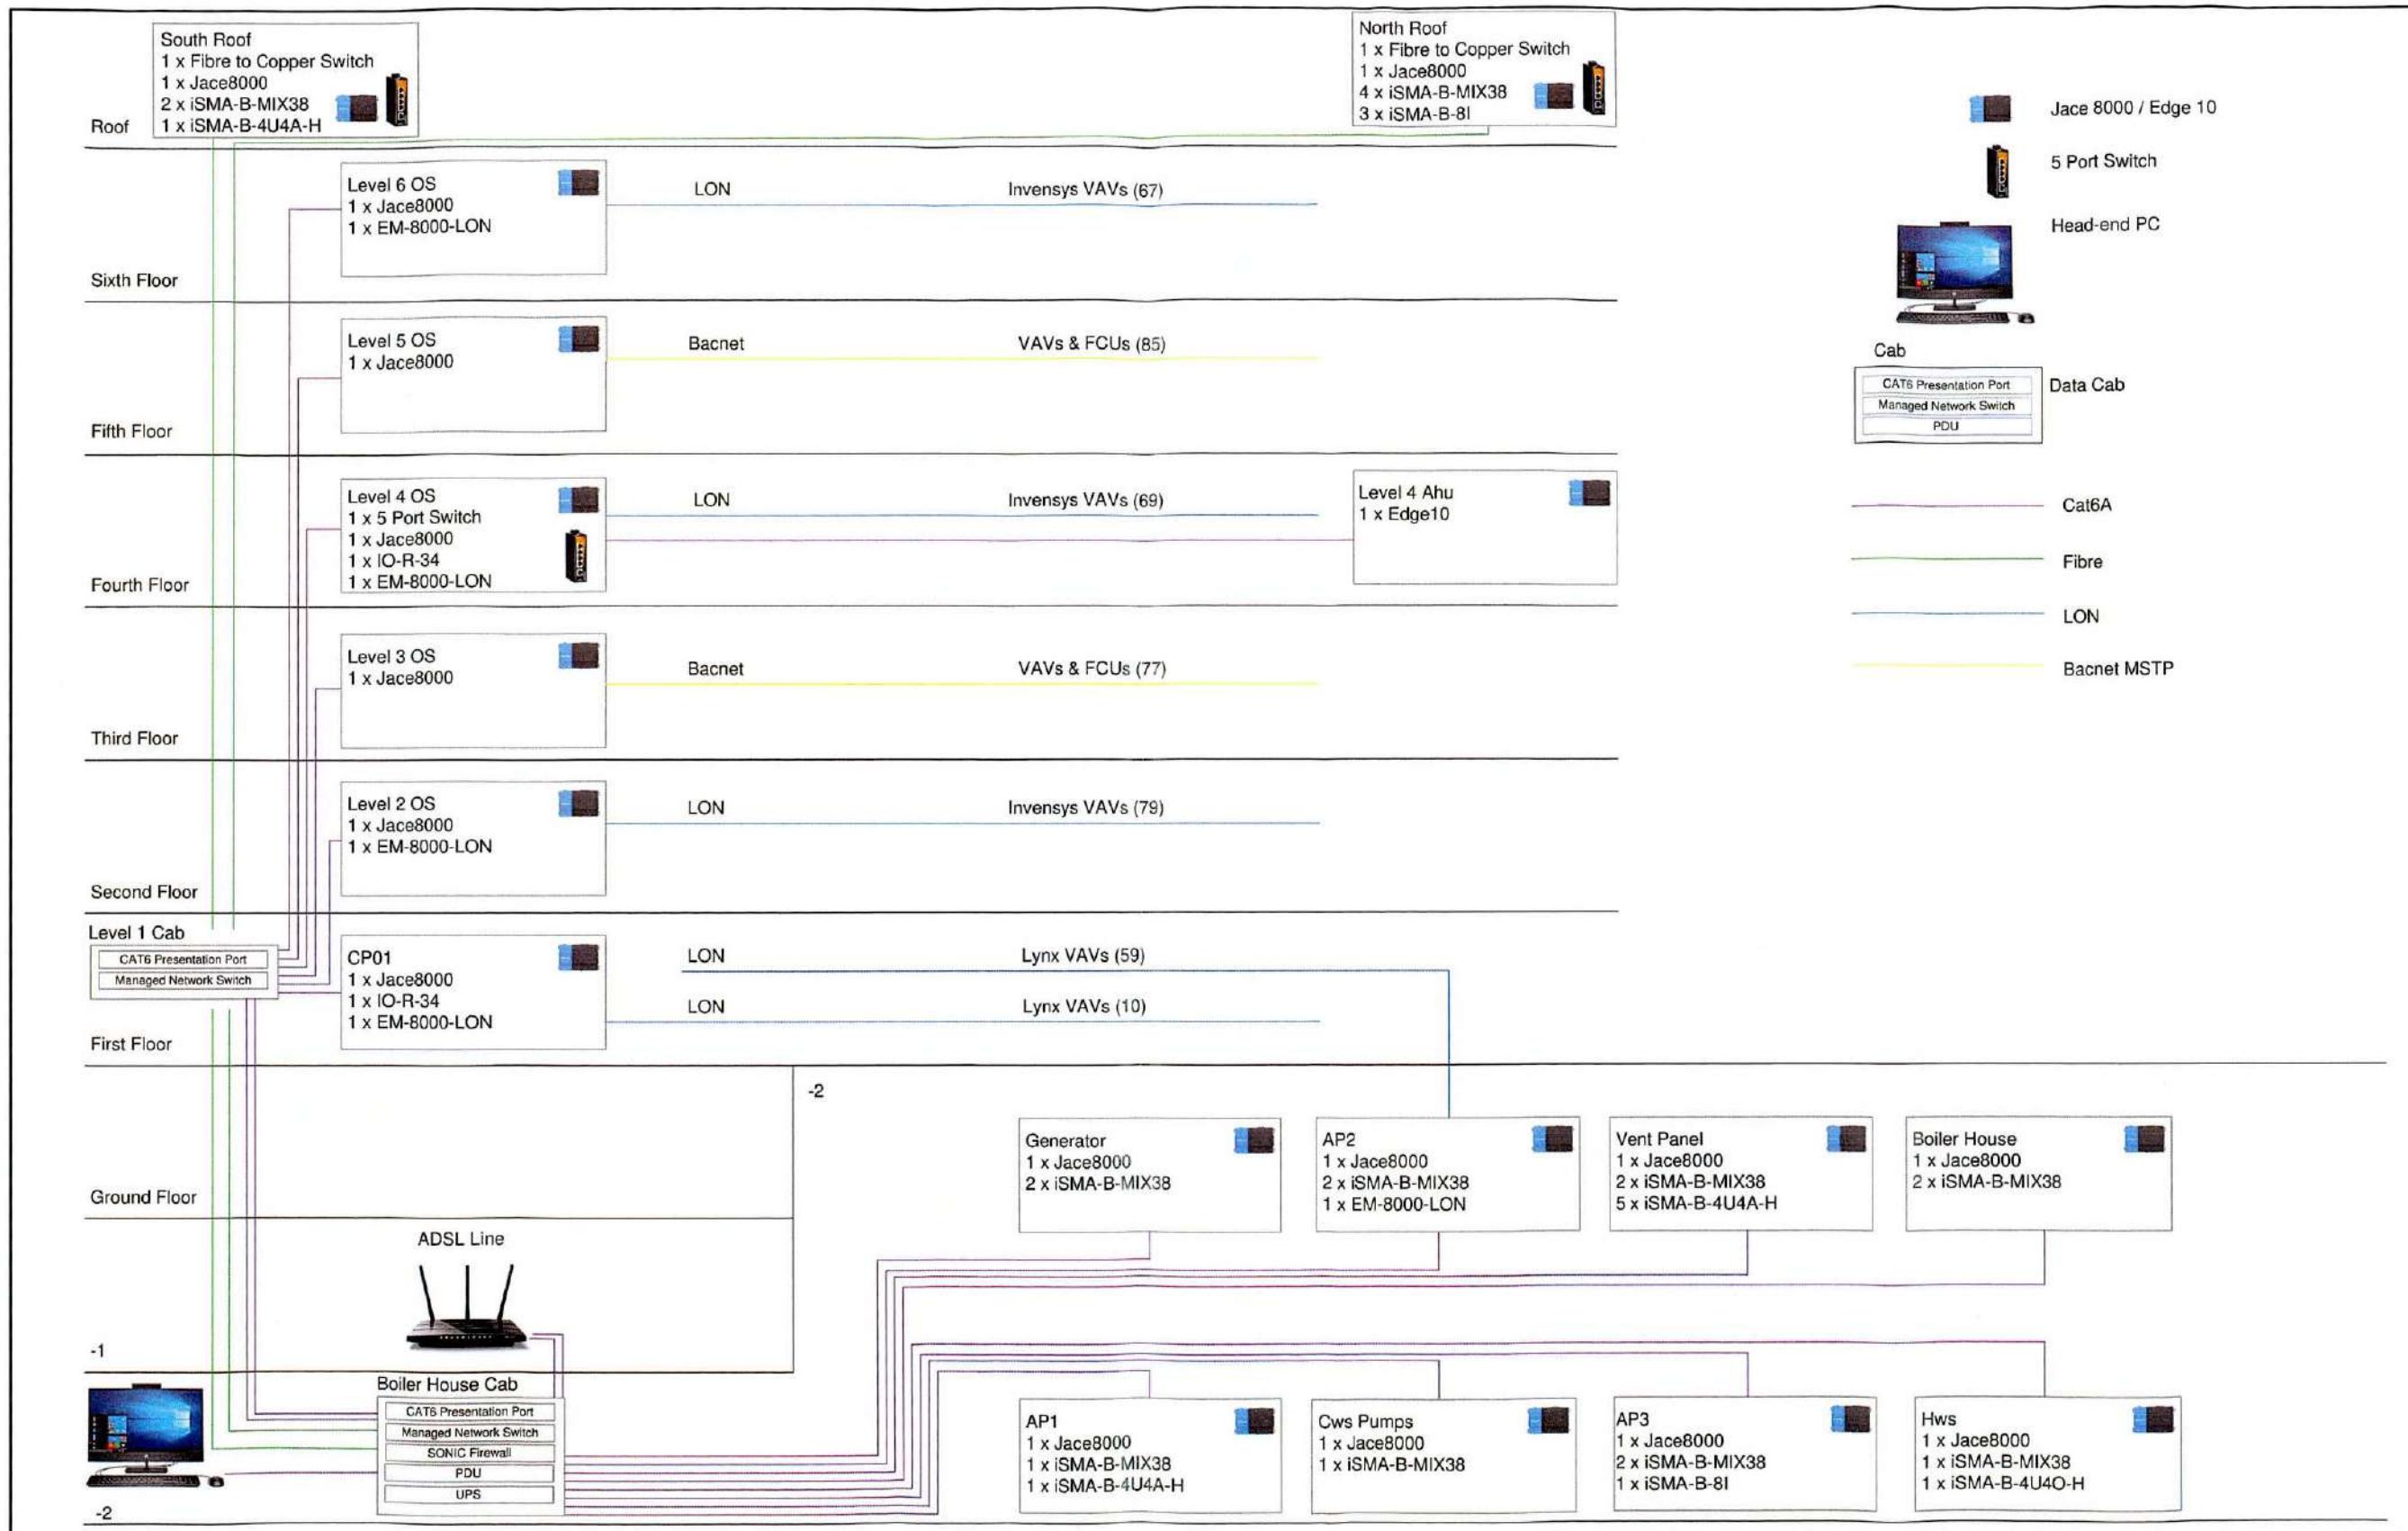

PROVISIONAL FOR APPROVAL ISSUED FOR CONSTRUCTION	AS BUILT AS FITTED	REVISION No	DESCRIPTION OF REVISION	DRAWN BY DATE	CHECKED BY DATE	REVISION No	DESCRIPTION OF REVISION	STATUS	DRAWN BY DATE	CHECKED BY DATE	DRG No.6082-16 PROJECT No.6082	SHT. 15 of 15	REV 1 ©
		0	PROVISIONAL	RFD 14/05/21		4					TITLE	EXCHEQUER COURT	
		1	AS COMMISSIOND	RFD 19/05/21		5					PANEL TITLE	ROOF NORTH ADDITIONAL CONTROL PANEL	
		2				6					CLIENT		
		3				7							



Project : EXCHEQUER COURT

Title : ROOF NORTH PLANTROOM
CONTROL PANEL

Client :

ENGINEER : RFD


DATE : 19/05/21

DRAWING No : 6082-17

SHEET : 26


REVISION : 1


PROJECT No. : 6085

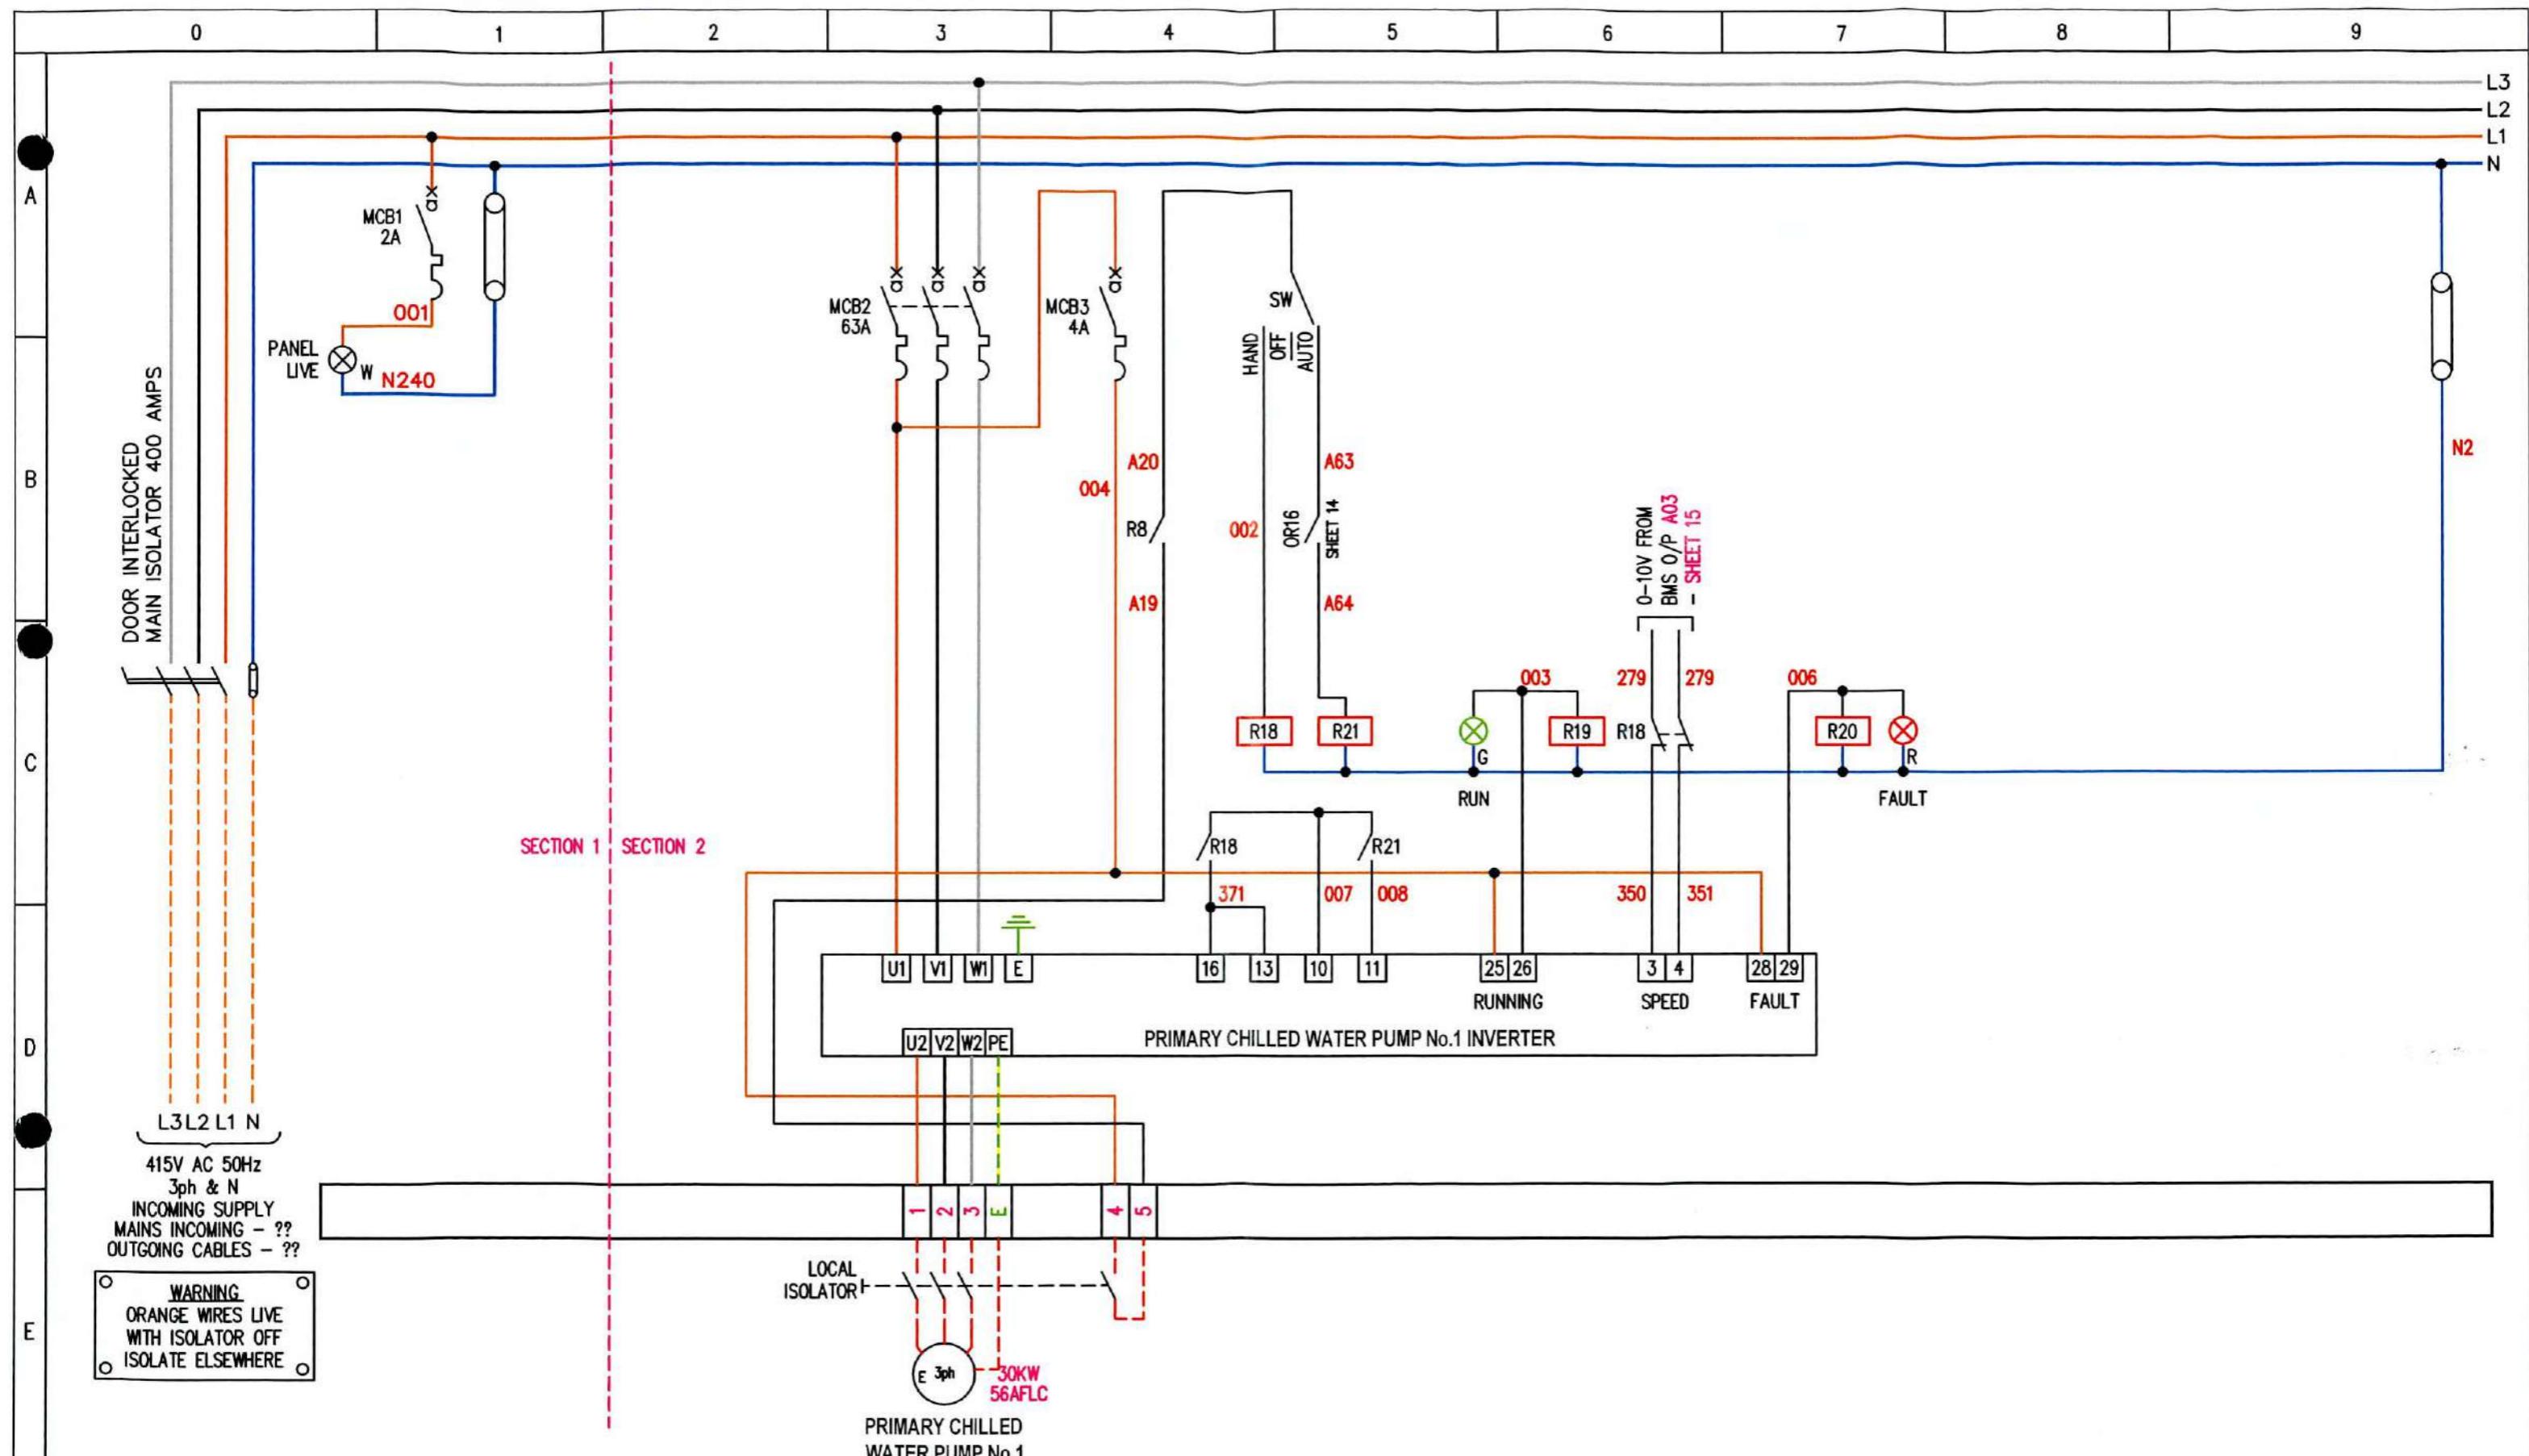


PROVISIONAL	AS BUILT	REVISION No	DESCRIPTION OF REVISION	DRAWN BY	CHECKED BY	REVISION No	DESCRIPTION OF REVISION	STATUS	DRAWN BY	CHECKED BY	DRG No.6082-17 SHT. 2 of 26 REV 1 PROJECT No.6085
FOR APPROVAL	AS FITTED			RFD							TITLE EXCHEQUER COURT
ISSUED FOR CONSTRUCTION				14/05/21		4					PANEL TITLE ROOF NORTH PLANTROOM CONTROL PANEL
		0	PROVISIONAL	RFD		4					CLIENT
		1	AS COMMISSIONED	RFD		5					
		2				6					
		3				7					


bges group

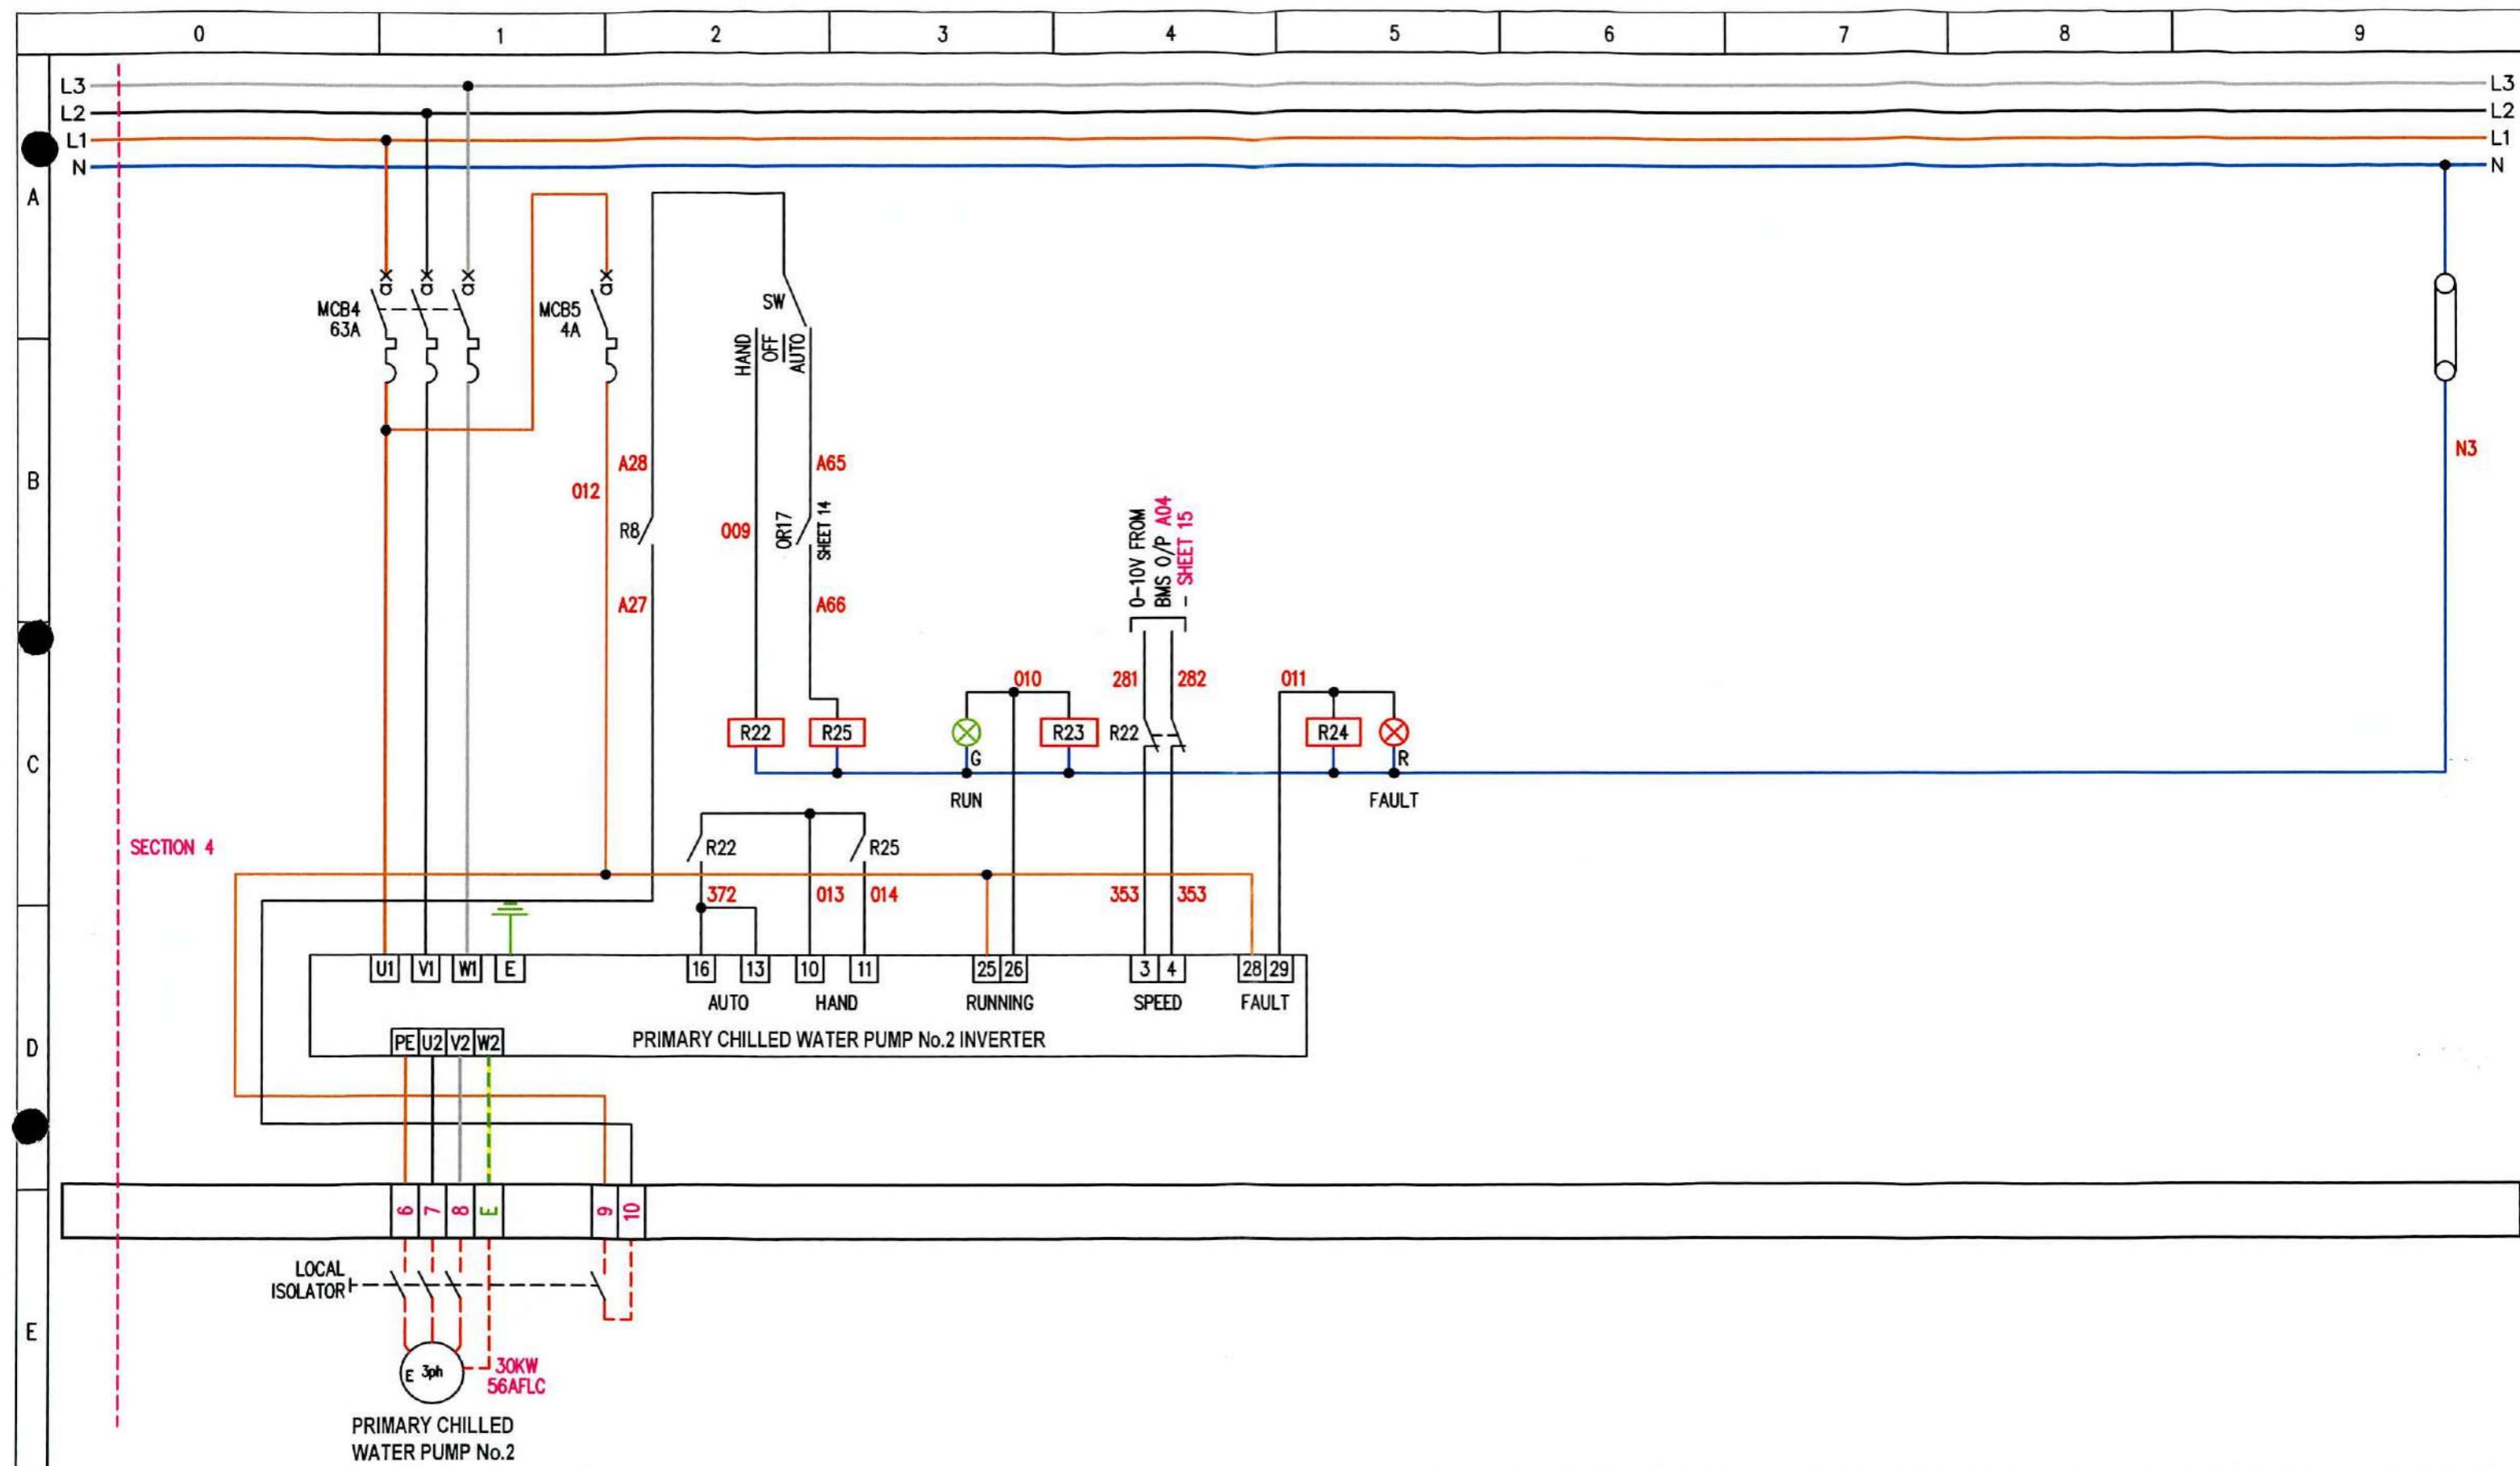


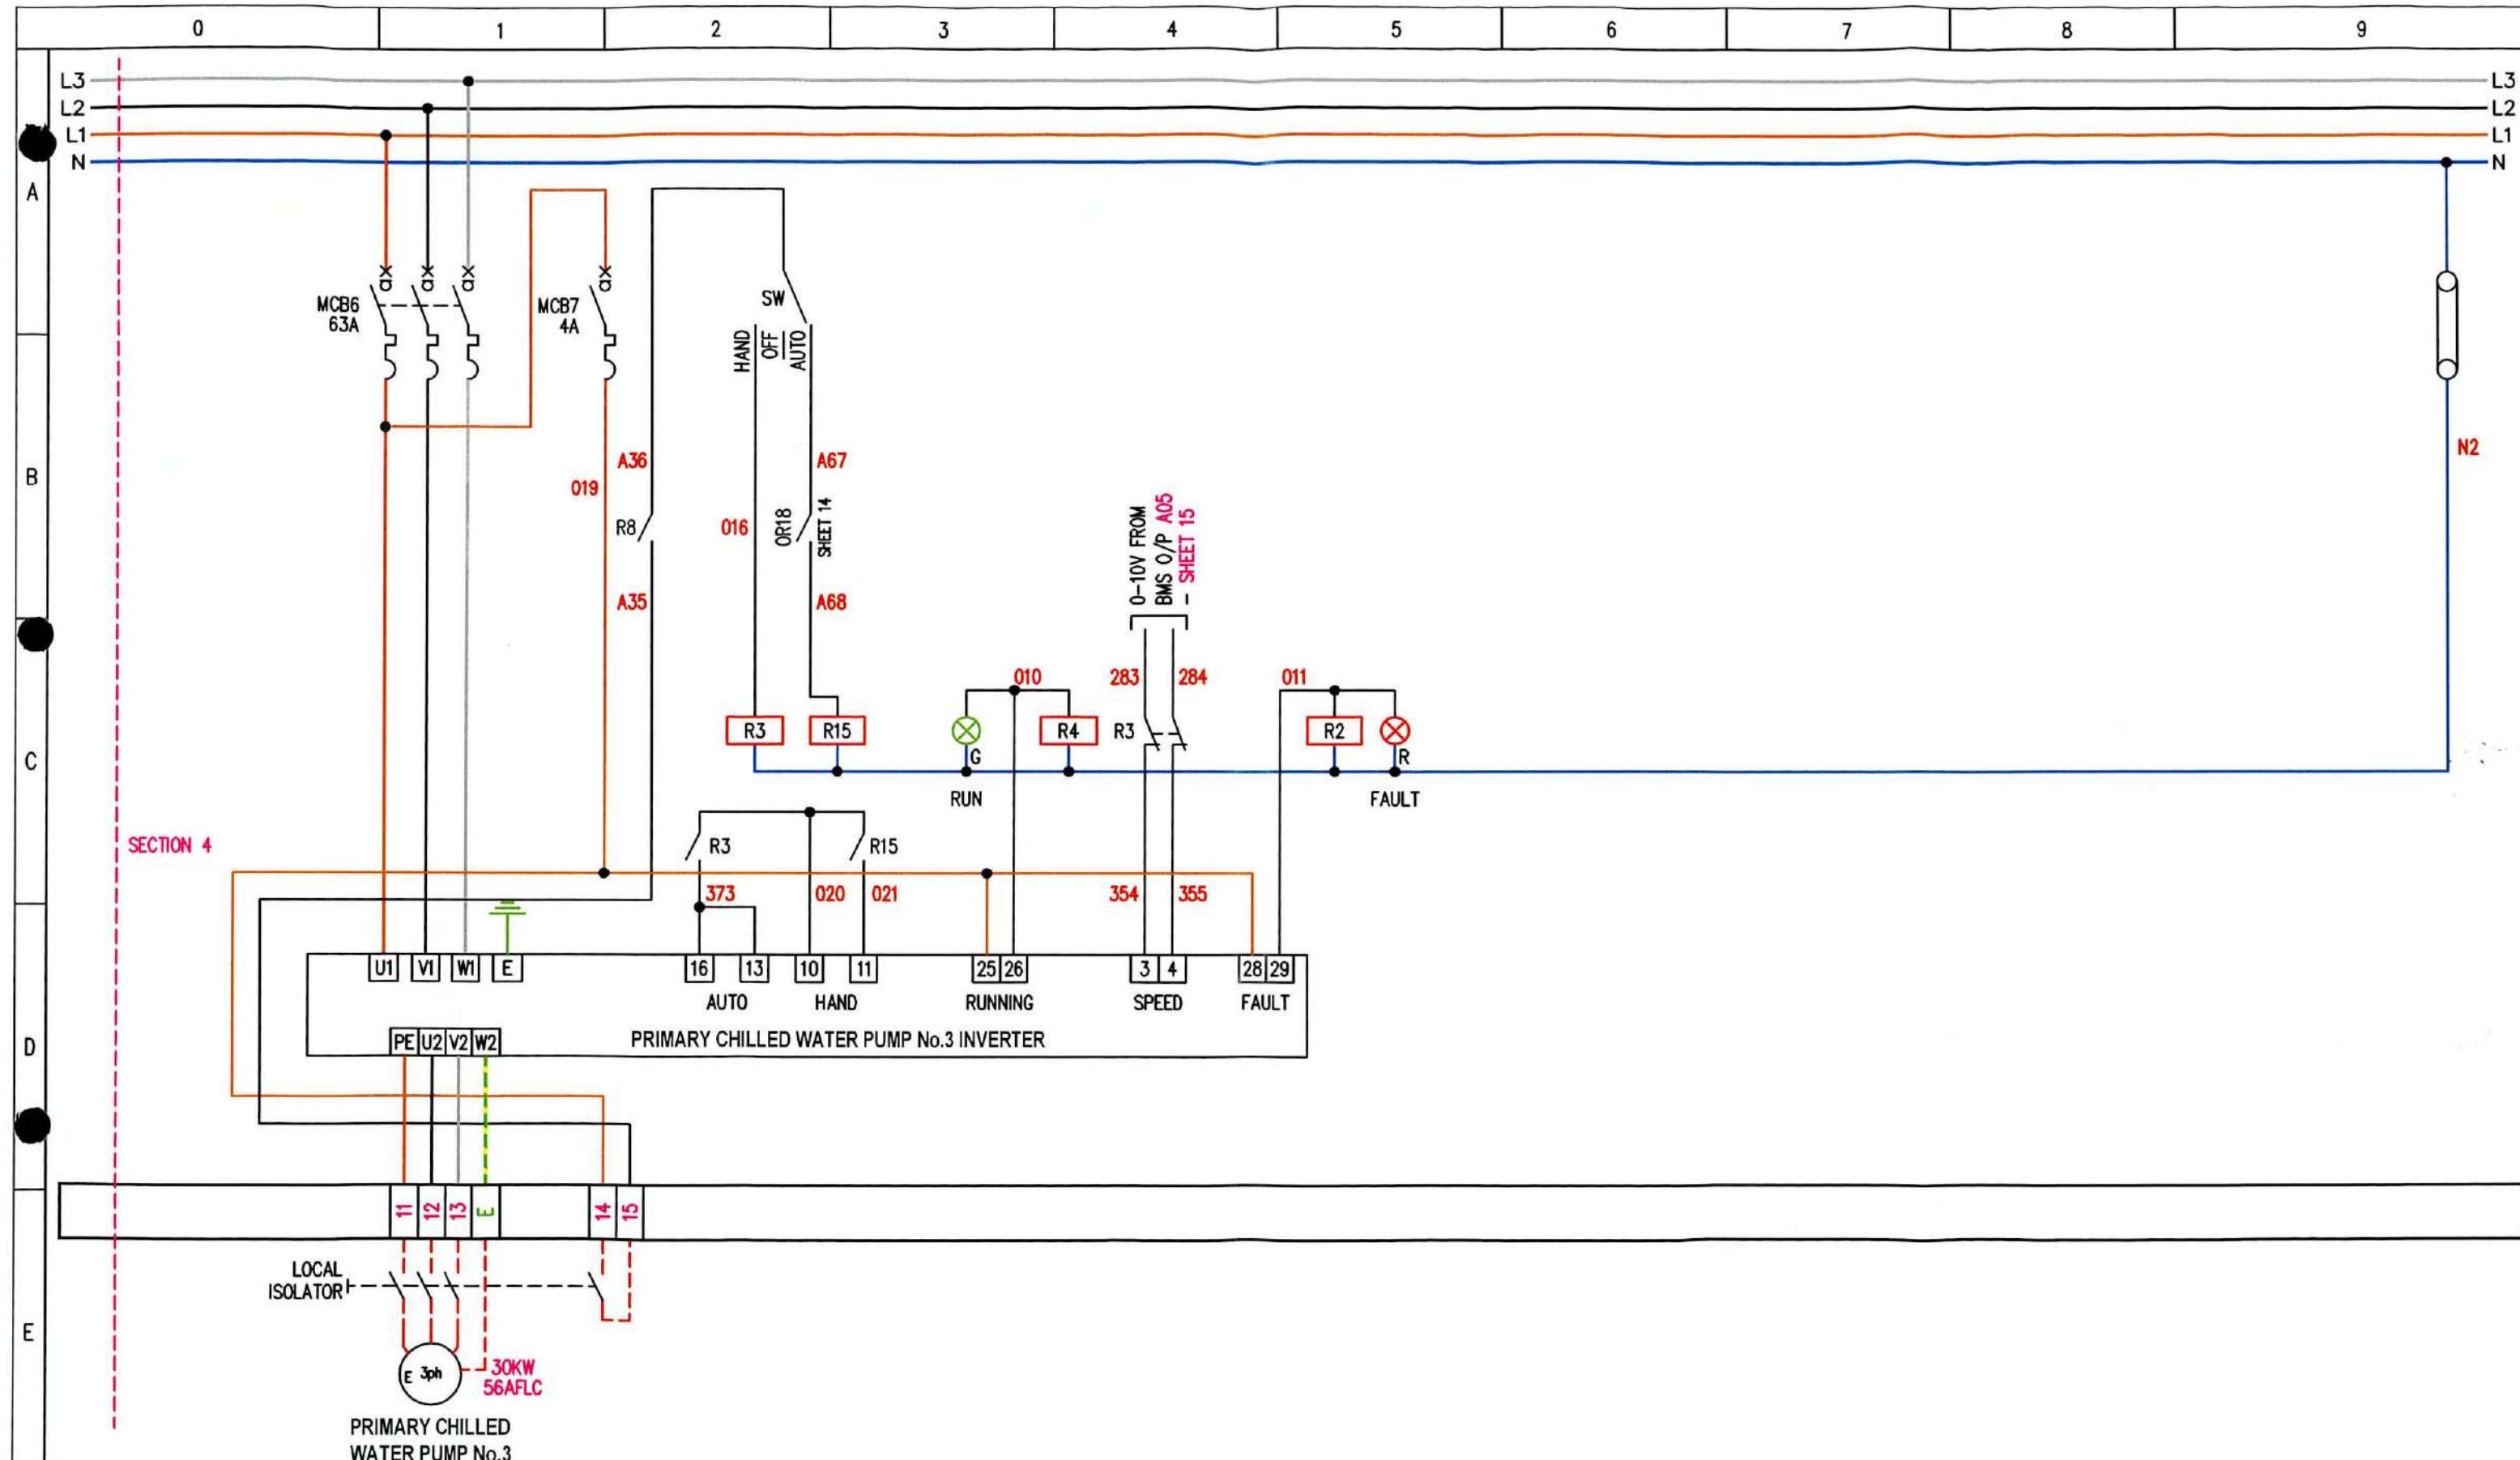


PROVISIONAL FOR APPROVAL ISSUED FOR CONSTRUCTION	AS BUILT	AS FITTED	REVISION No	DESCRIPTION OF REVISION	DRAWN BY DATE	CHECKED BY DATE	REVISION No	DESCRIPTION OF REVISION	STATUS	DRAWN BY DATE	CHECKED BY DATE	DRG No.6082-17 PROJECT No.6085	SHT. 4 of 26	REV 1 ©
			0	PROVISIONAL	RFD 14/05/21		4							
			1	AS COMMISSIONED	RFD 19/05/21		5							
			2				6							
			3				7							
bges group			TITLE		EXCHEQUER COURT		PANEL TITLE		ROOF NORTH PLANTROOM CONTROL PANEL		CLIENT			

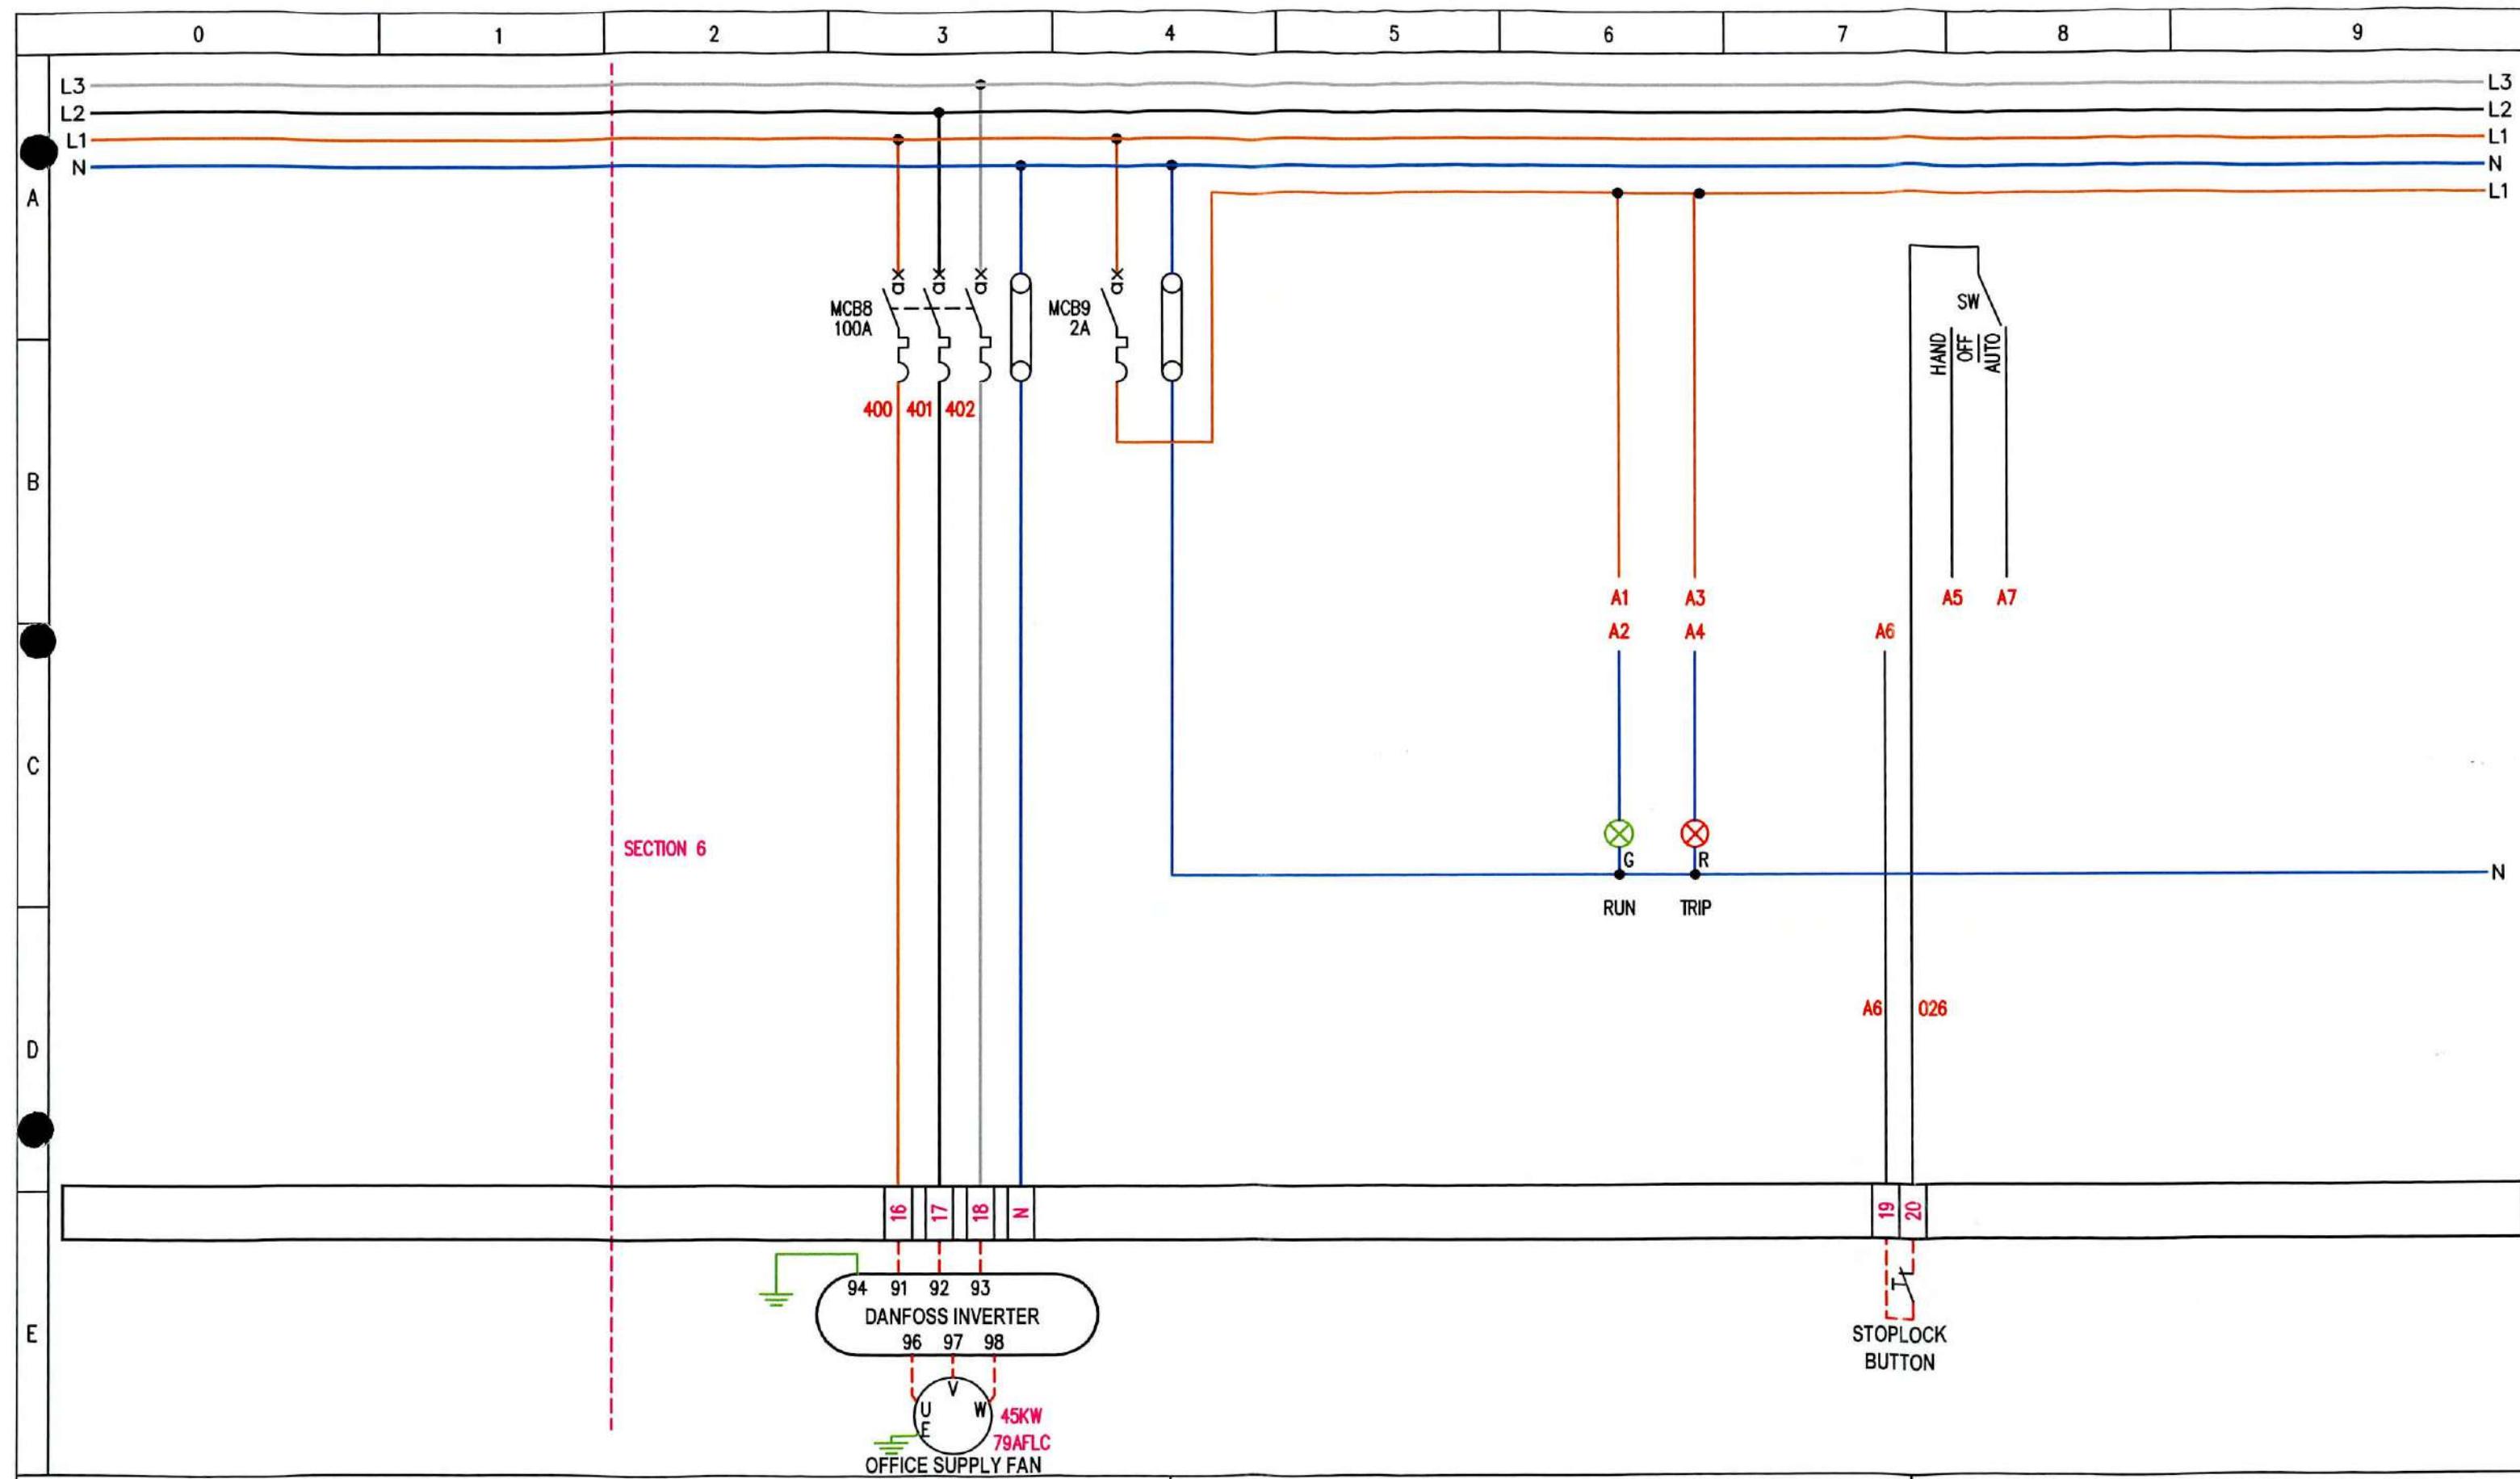

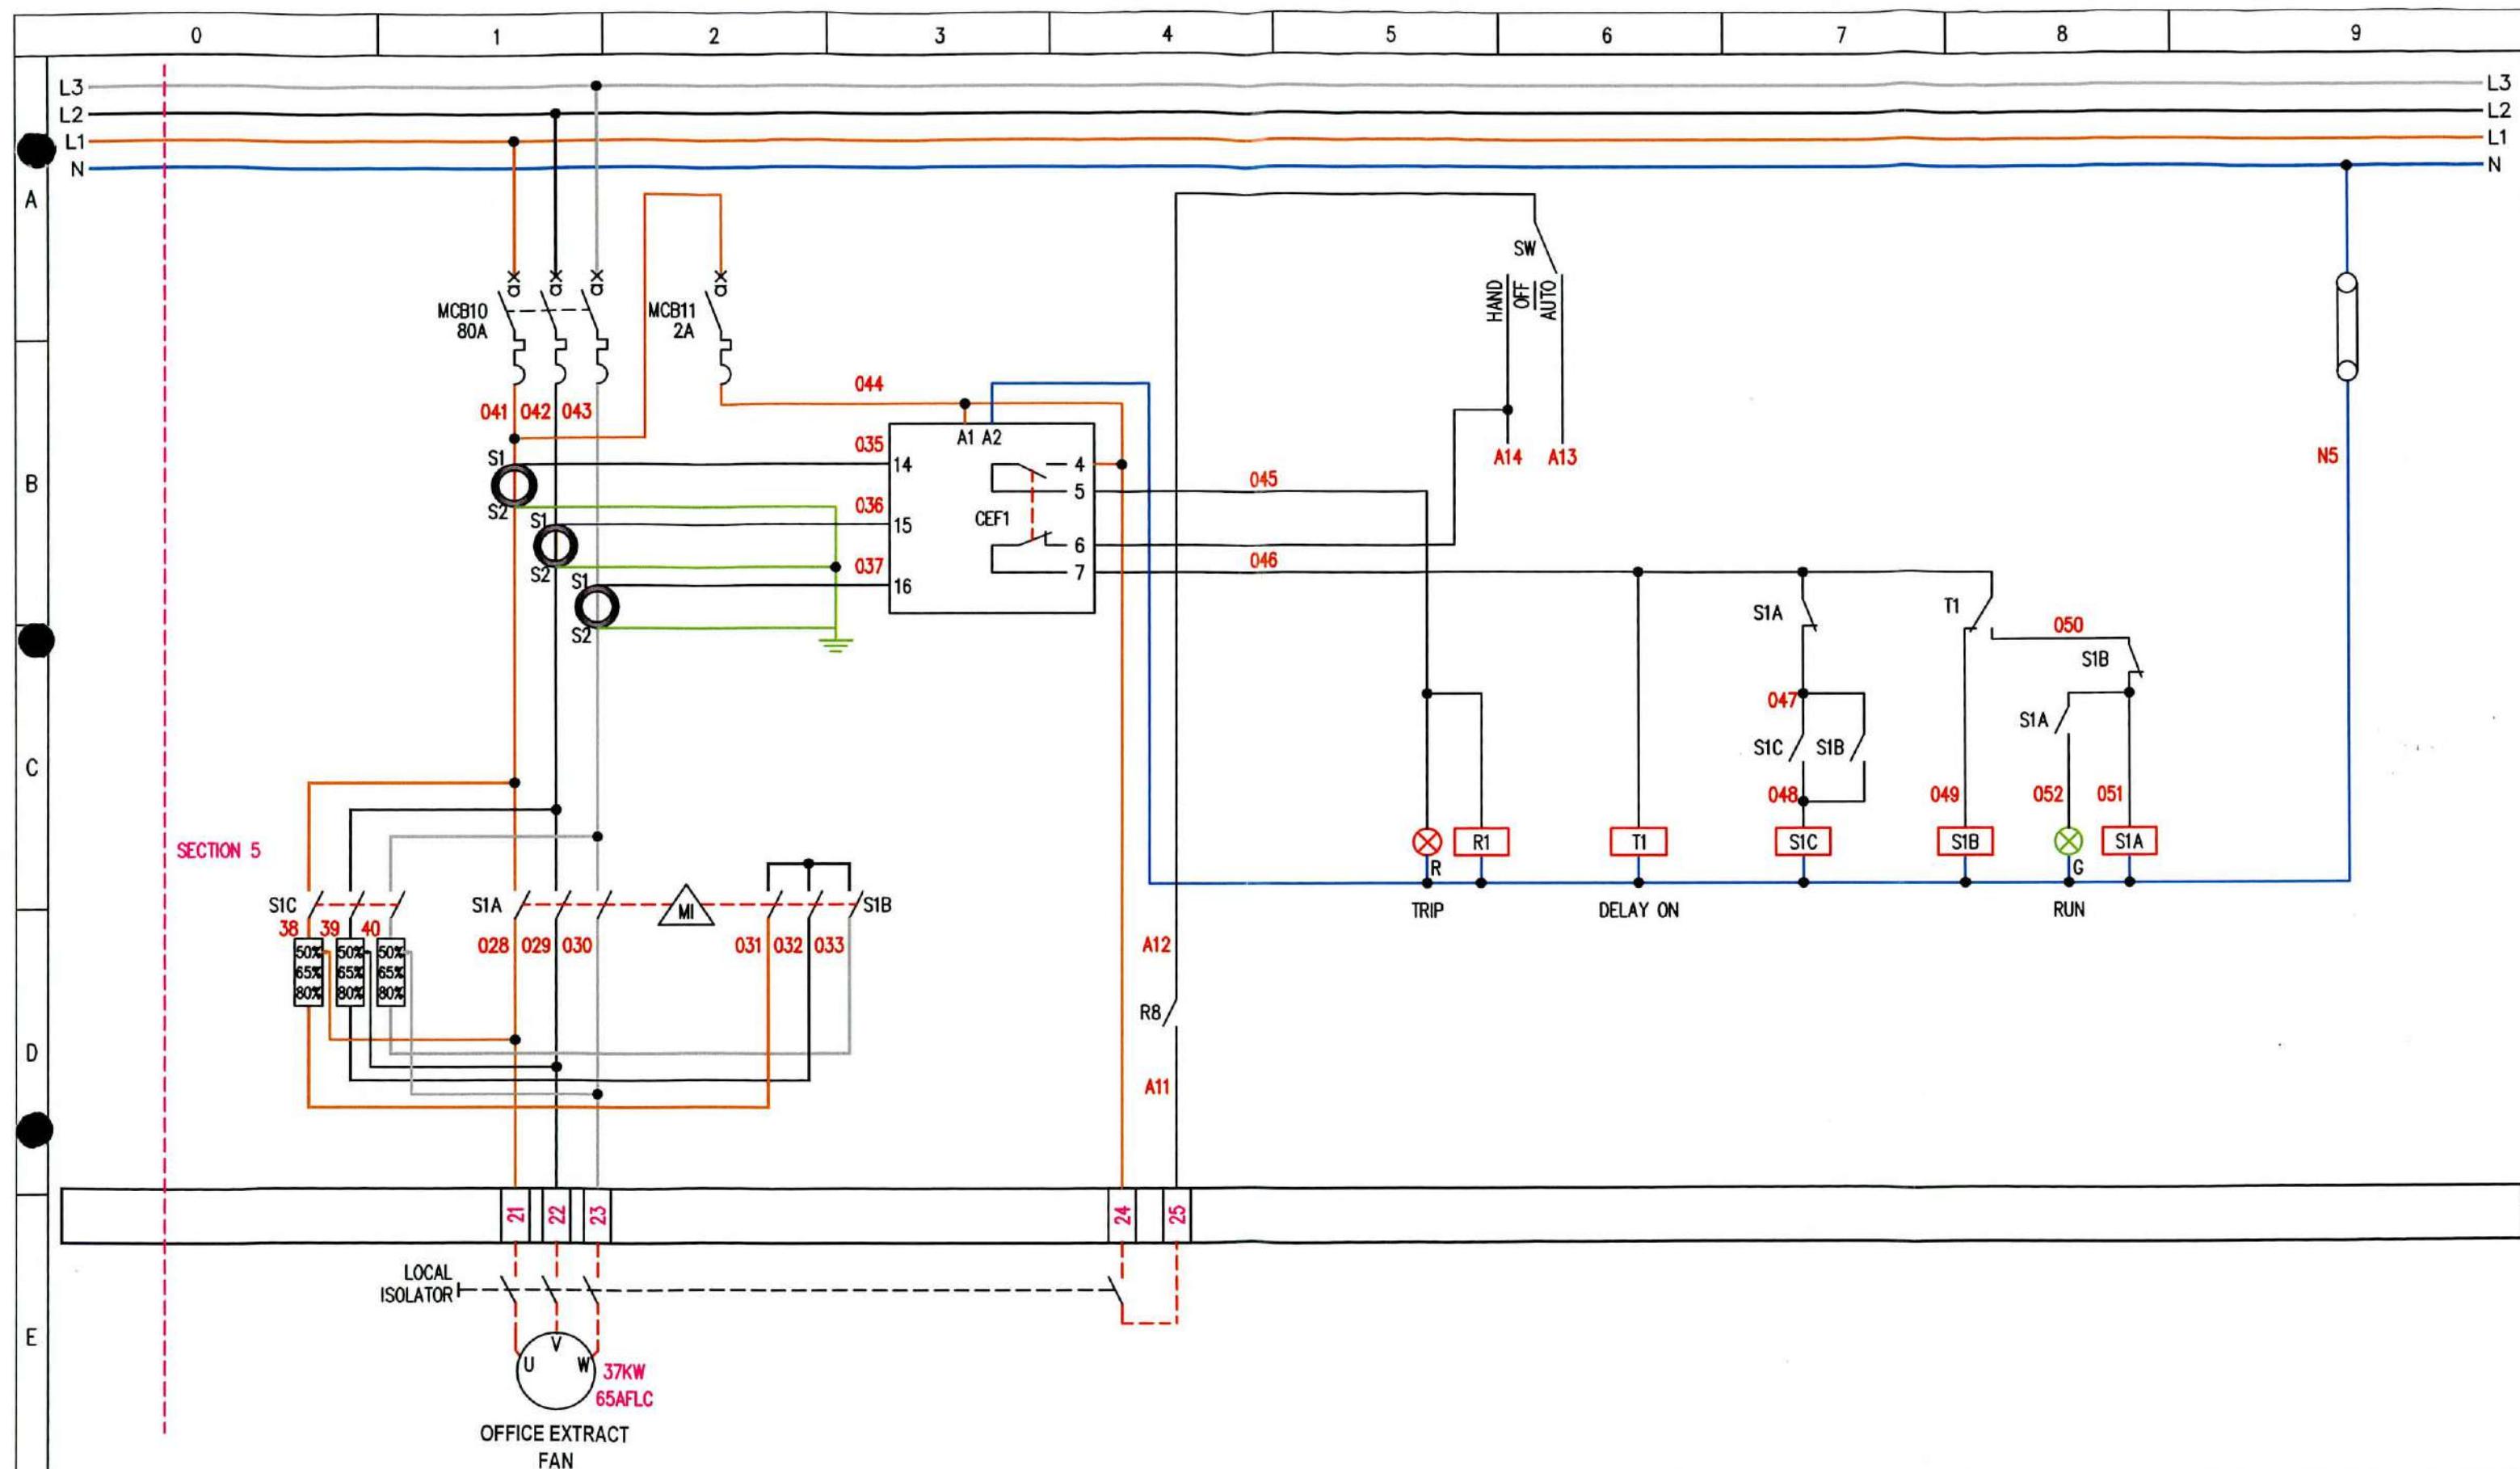


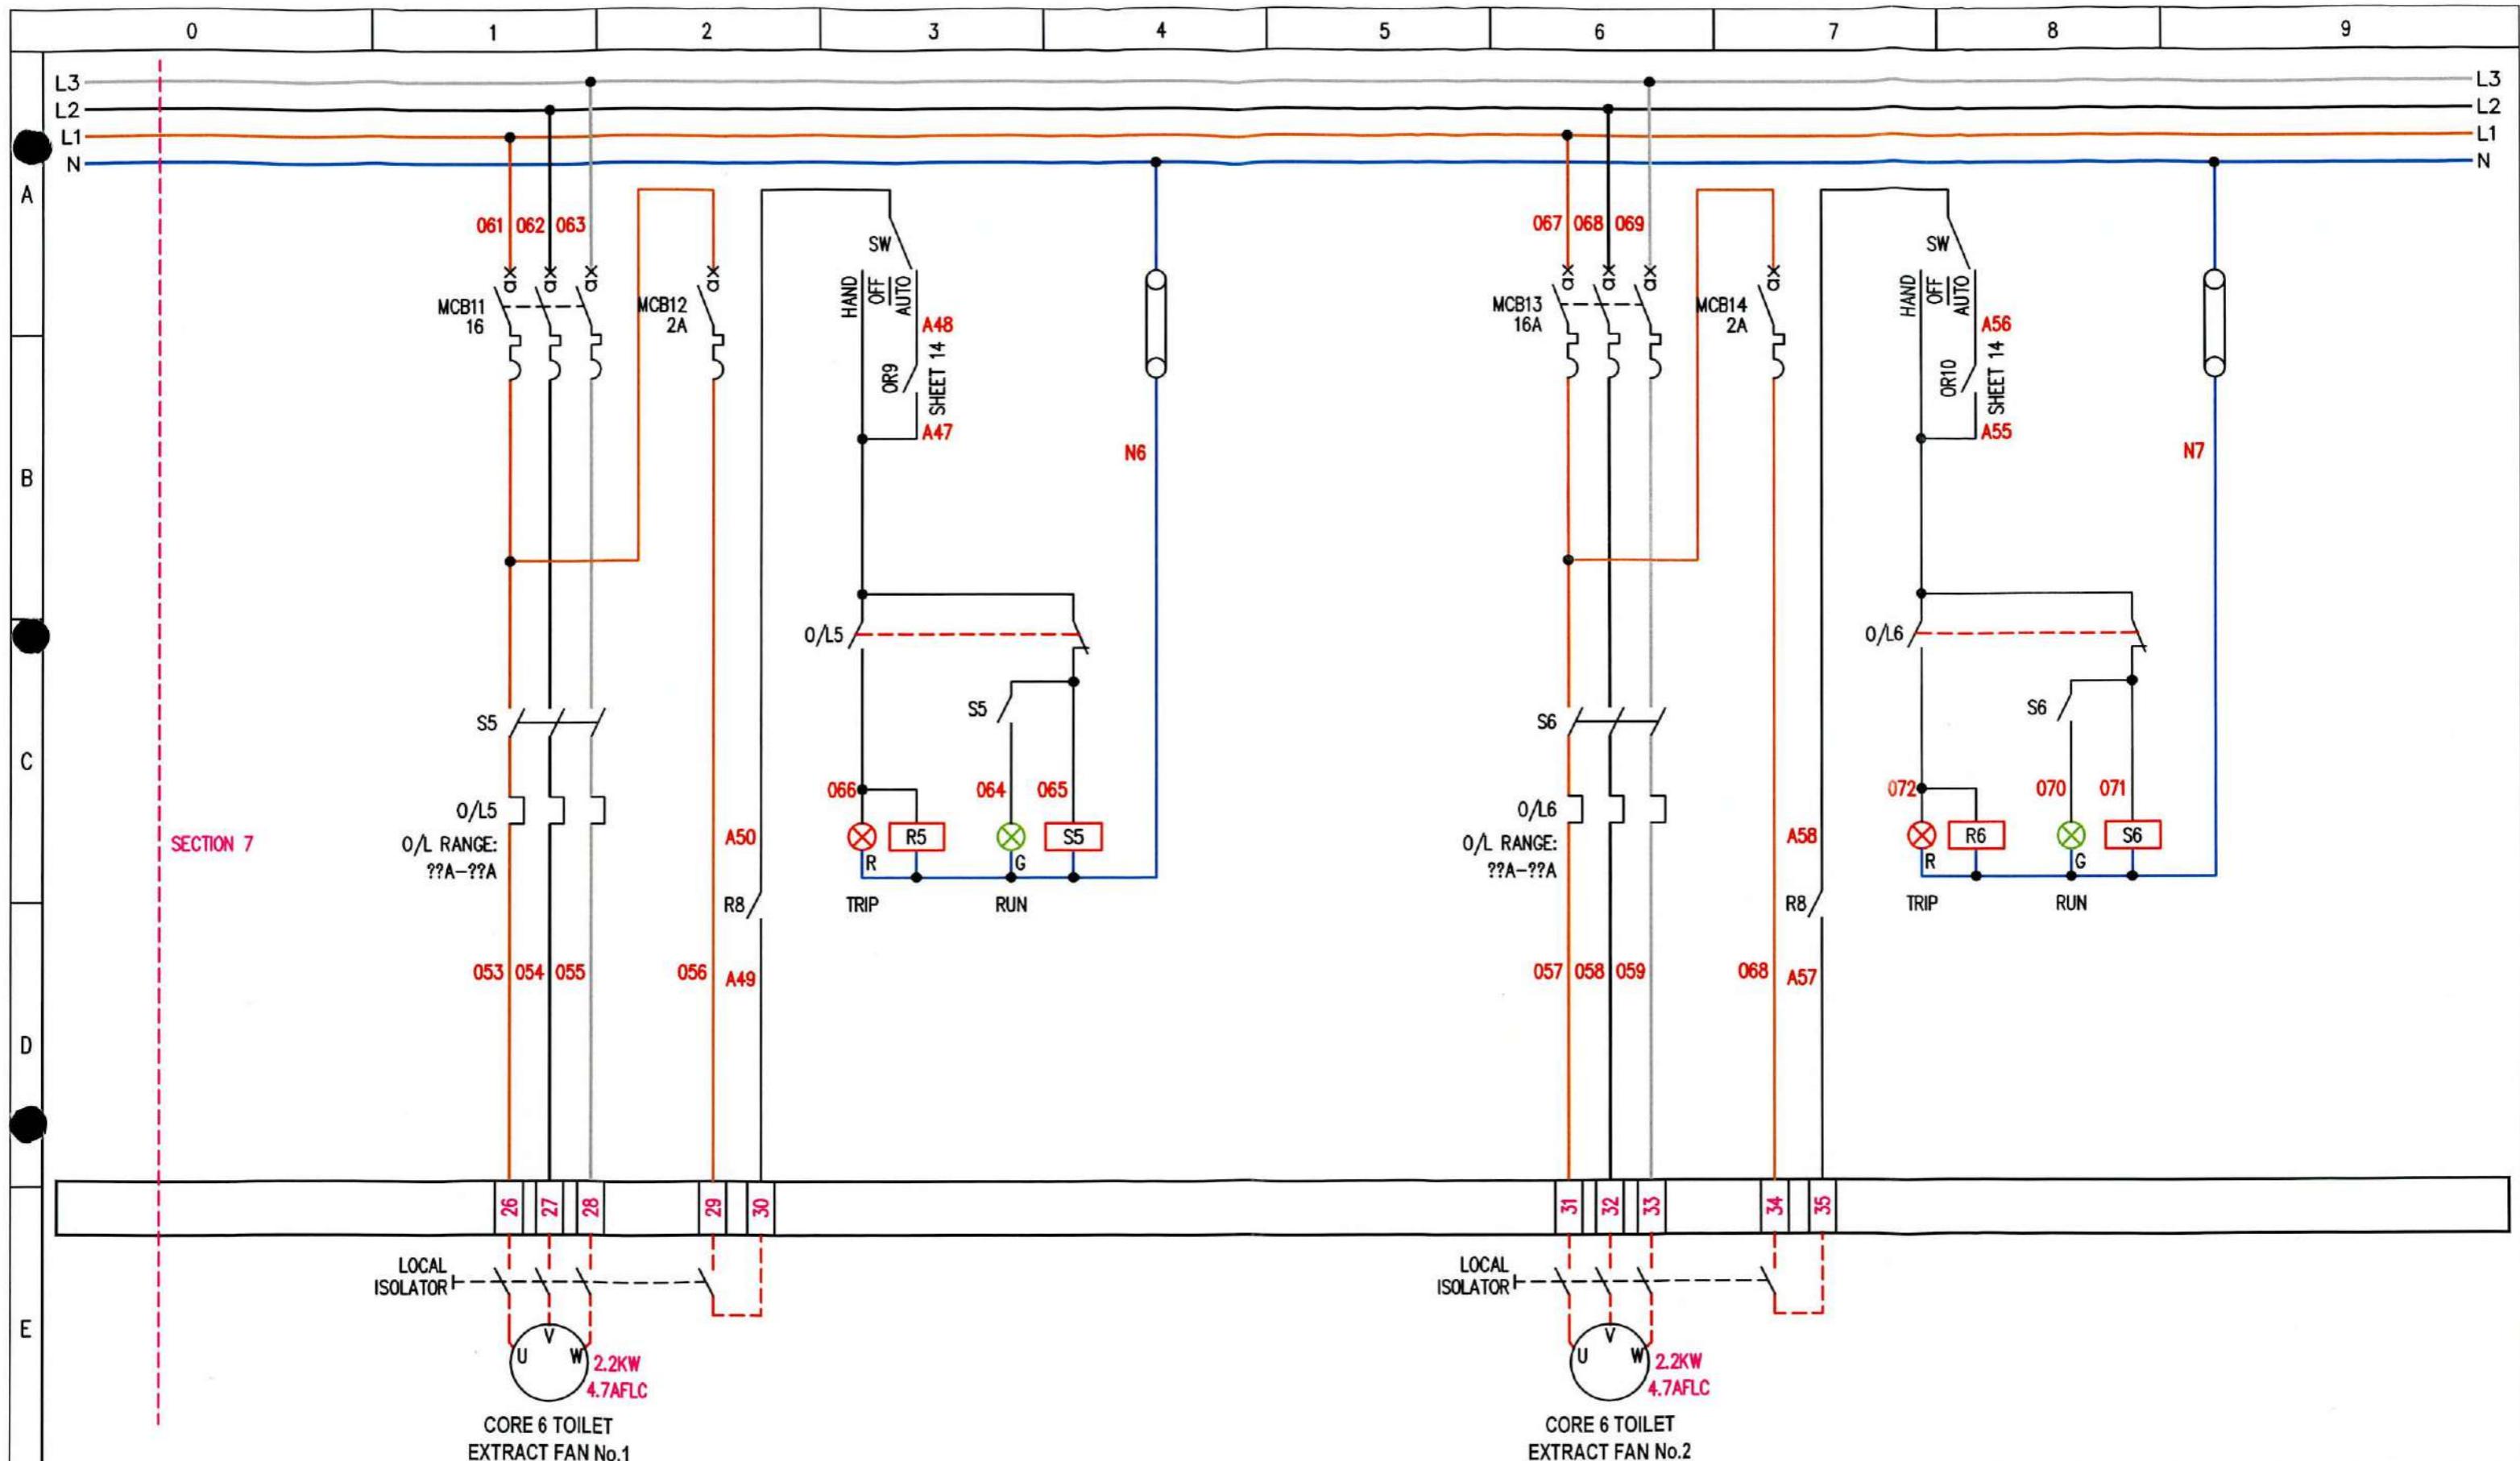


PROVISIONAL FOR APPROVAL ISSUED FOR CONSTRUCTION	AS BUILT AS FITTED	REVISION No	DESCRIPTION OF REVISION	DRAWN BY DATE	CHECKED BY DATE	REVISION No	DESCRIPTION OF REVISION	STATUS	DRAWN BY DATE	CHECKED BY DATE	DRG No.6082-17 PROJECT No.6085	SHT. 7 of 26	REV 1 ©
		0	PROVISIONAL	RFD 14/05/21		4							
		1	AS COMMISSIONED	RFD 19/05/21		5							
		2				6							
		3				7							
bges group			TITLE		EXCHEQUER COURT		PANEL TITLE		ROOF NORTH PLANTROOM CONTROL PANEL		CLIENT		

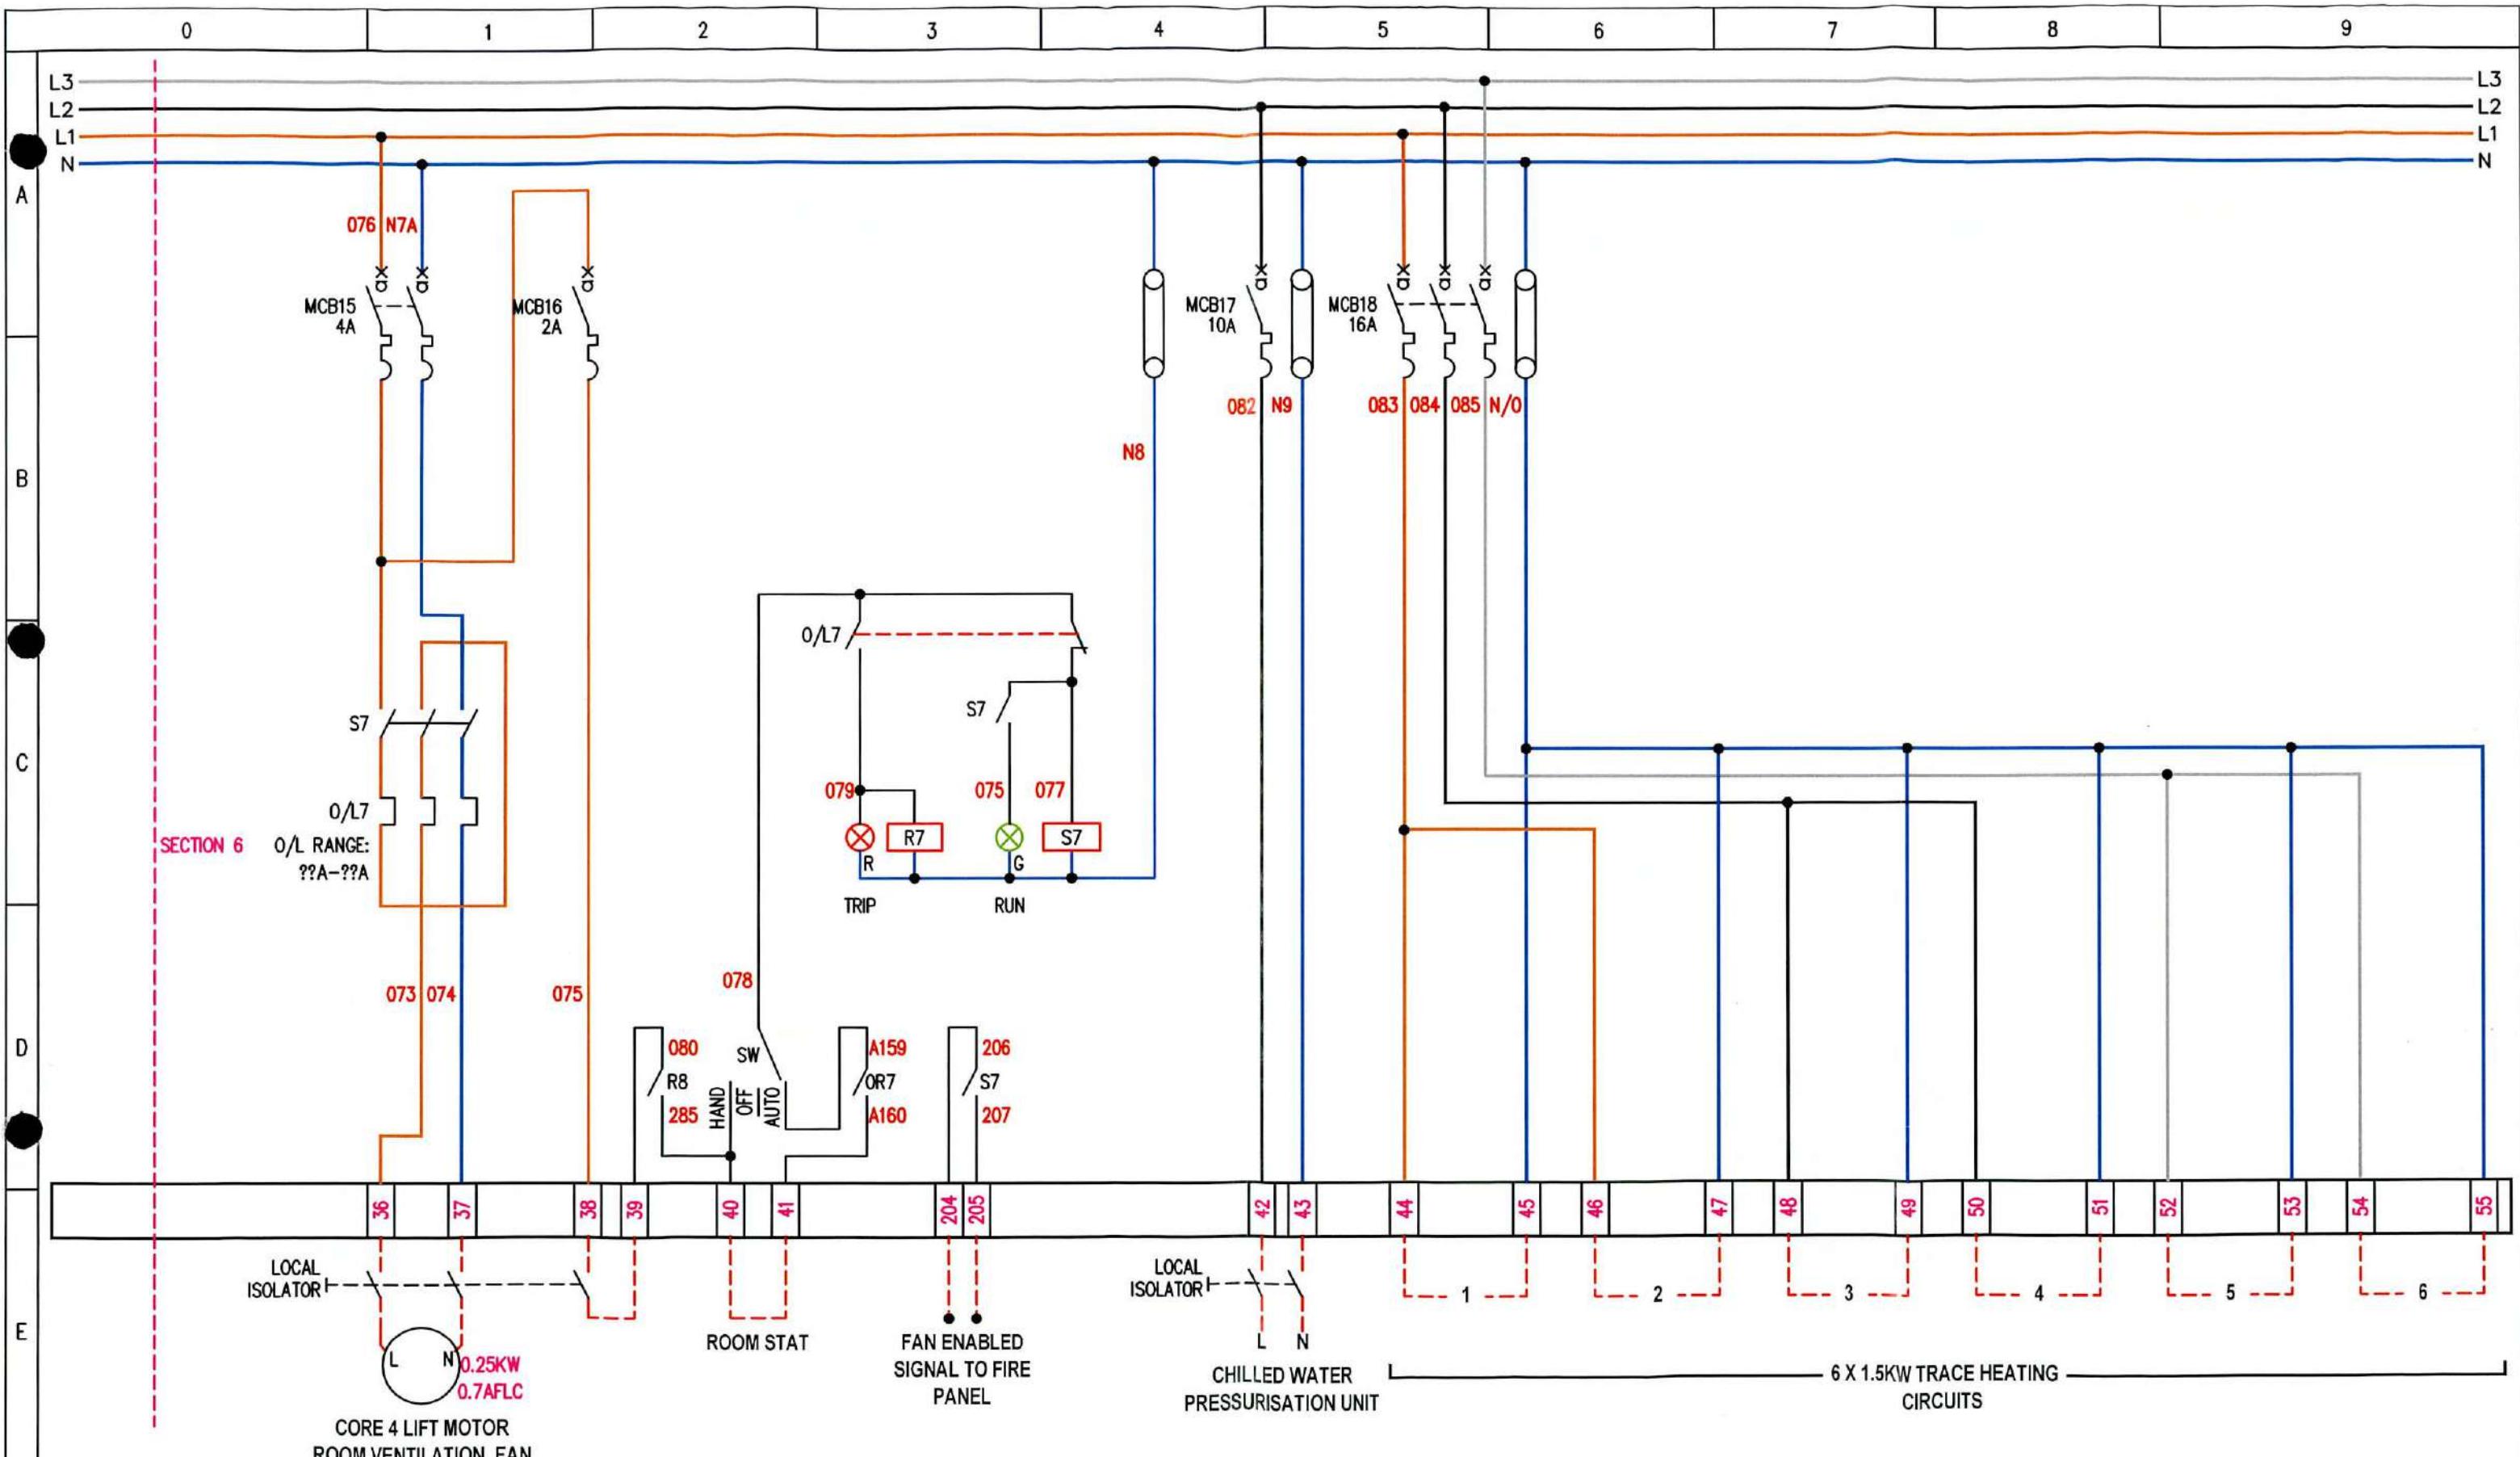


PROVISIONAL FOR APPROVAL ISSUED FOR CONSTRUCTION	AS BUILT AS FITTED	REVISION No	DESCRIPTION OF REVISION	DRAWN BY DATE	CHECKED BY DATE	REVISION No	DESCRIPTION OF REVISION	STATUS	DRAWN BY DATE	CHECKED BY DATE	DRG No.6082-17 PROJECT No.6085	SHT. 8 of 26	REV 1 ©
		0	PROVISIONAL	RFD 14/05/21		4							
		1	AS COMMISSIONED	RFD 19/05/21		5							
		2				6							
		3				7							
bges group			TITLE		EXCHEQUER COURT		PANEL TITLE		ROOF NORTH PLANTROOM CONTROL PANEL		CLIENT		

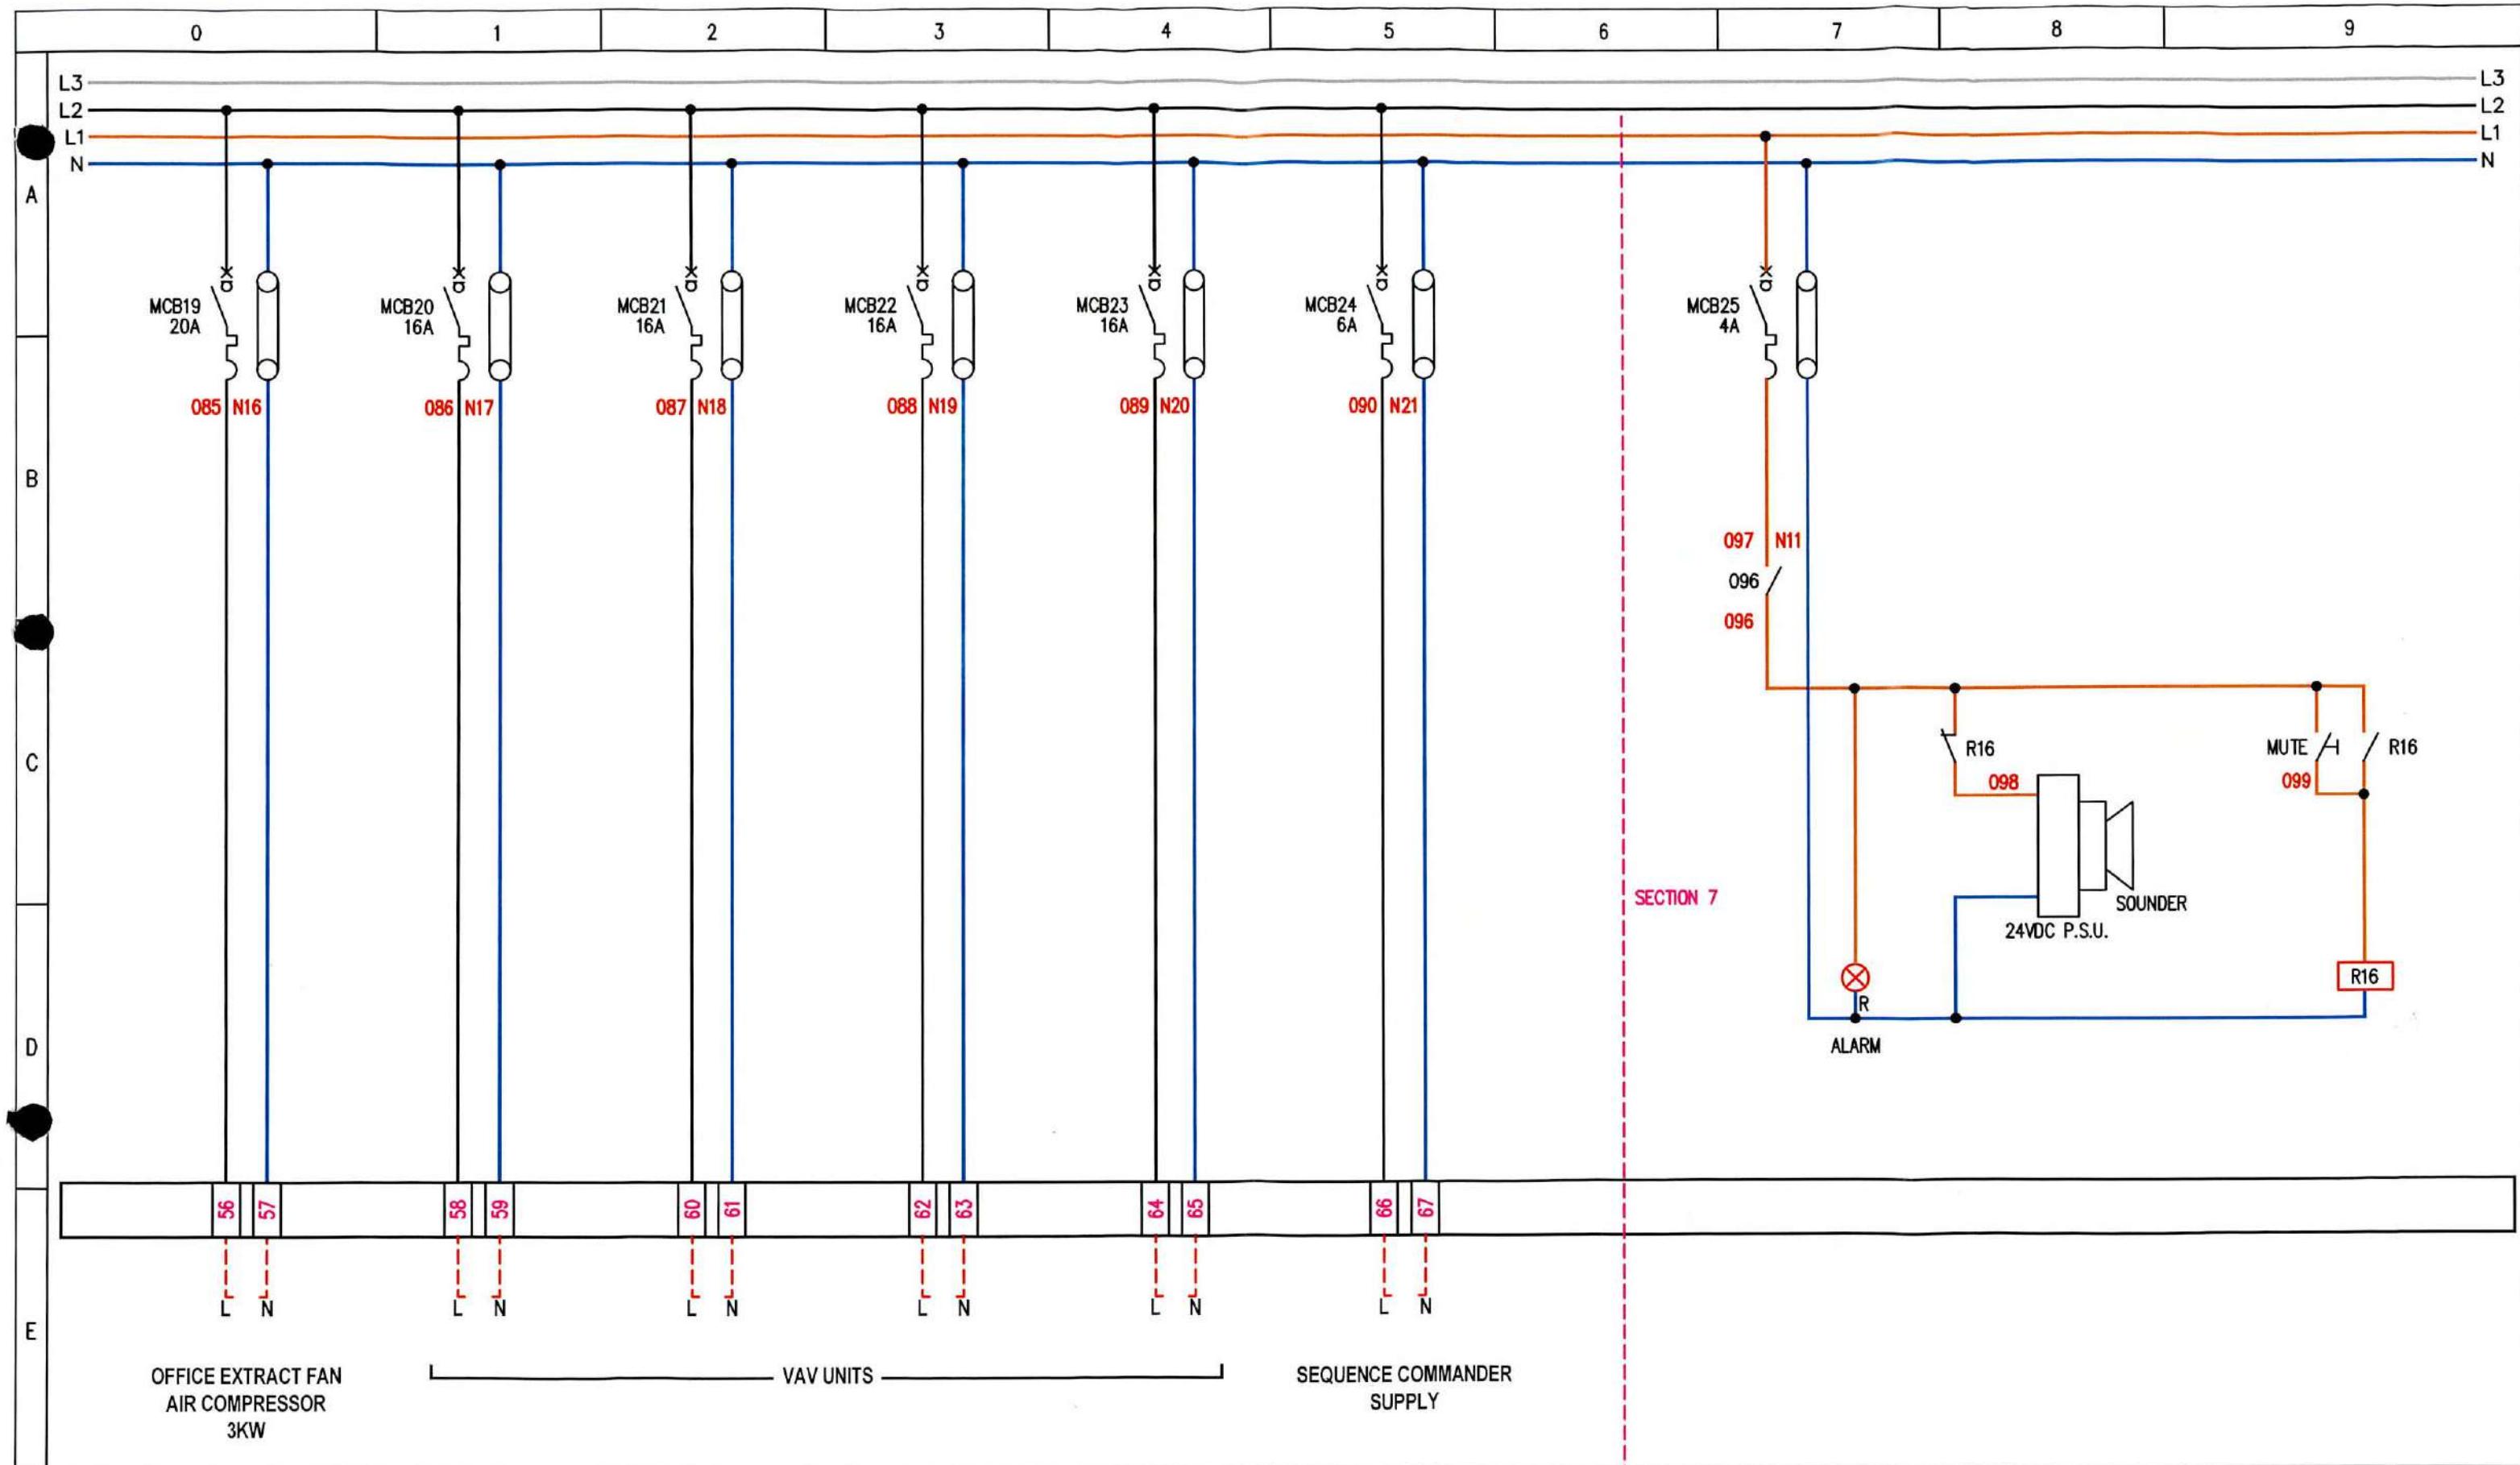


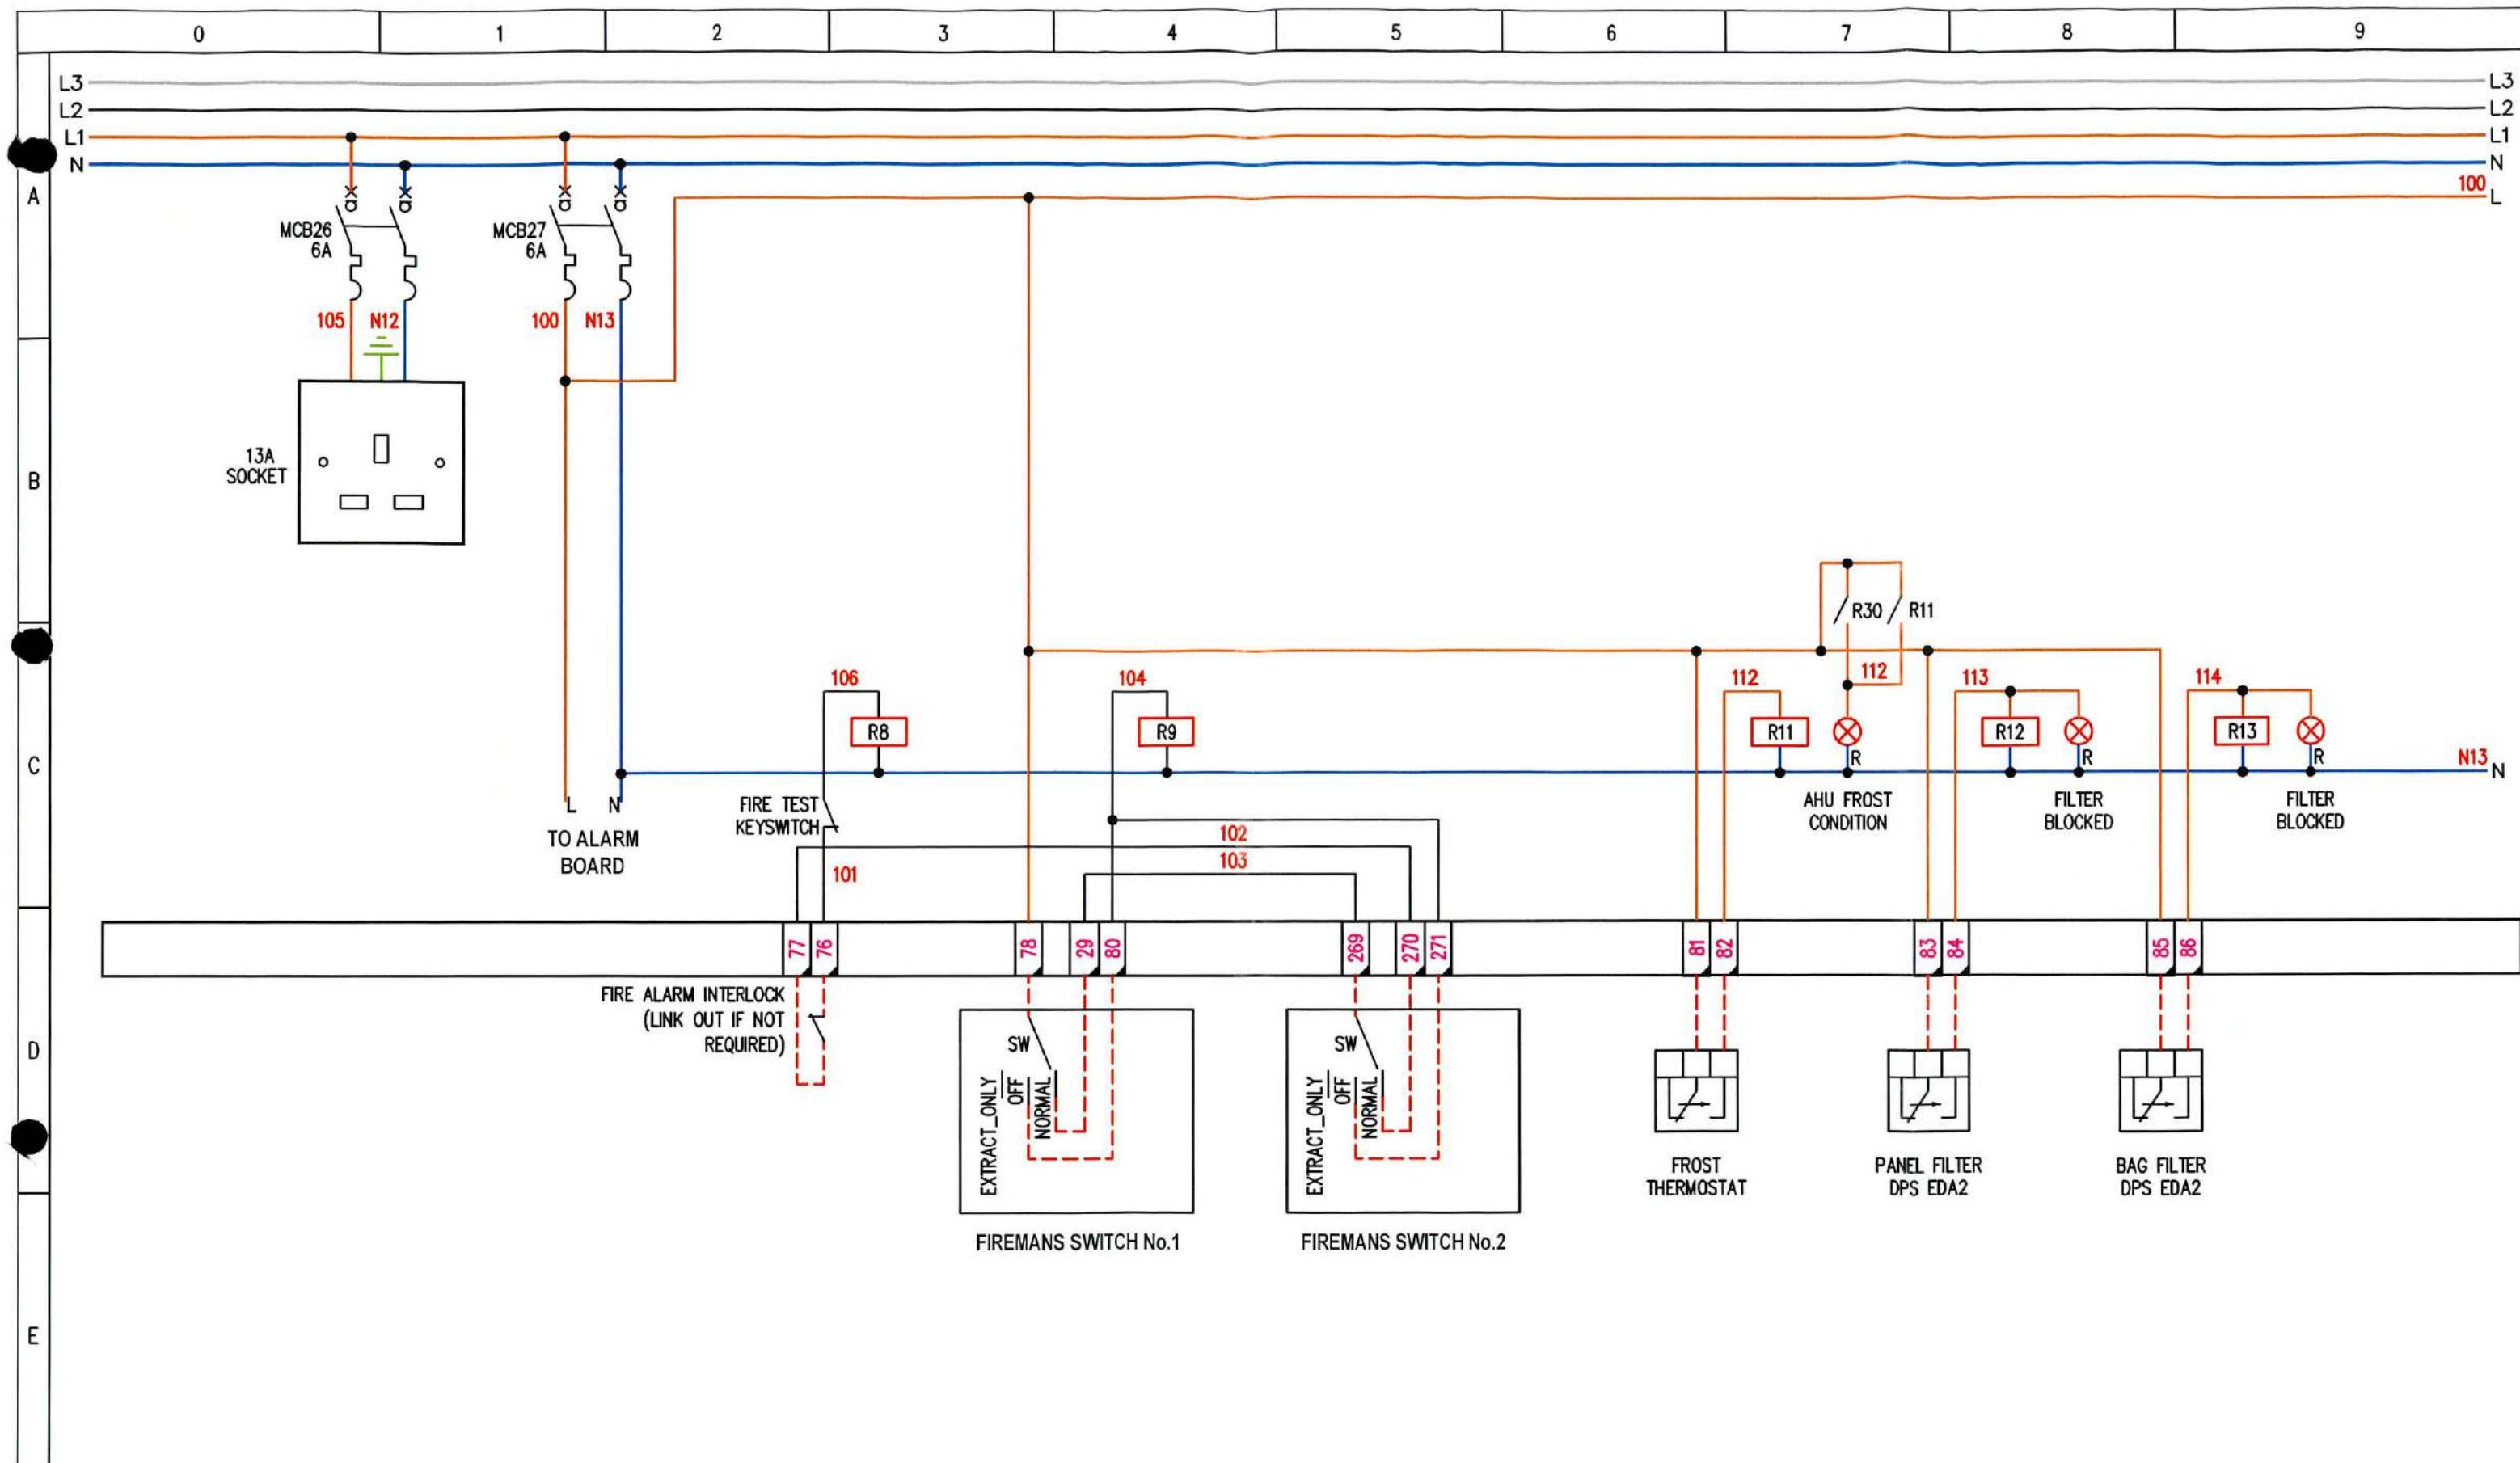


<input checked="" type="radio"/> PROVISIONAL	<input checked="" type="radio"/> AS BUILT	REVISION No	DESCRIPTION OF REVISION	DRAWN BY	CHECKED BY	REVISION No	DESCRIPTION OF REVISION	STATUS	DRAWN BY	CHECKED BY	DRG No.6082-17 PROJECT No.6085	SHT. 10 of 26	REV 1 ©
<input checked="" type="radio"/> FOR APPROVAL	<input checked="" type="radio"/> AS FITTED			RFD 14/05/21		4							
<input checked="" type="radio"/> ISSUED FOR CONSTRUCTION				RFD 19/05/21		5							
						6							
						7							

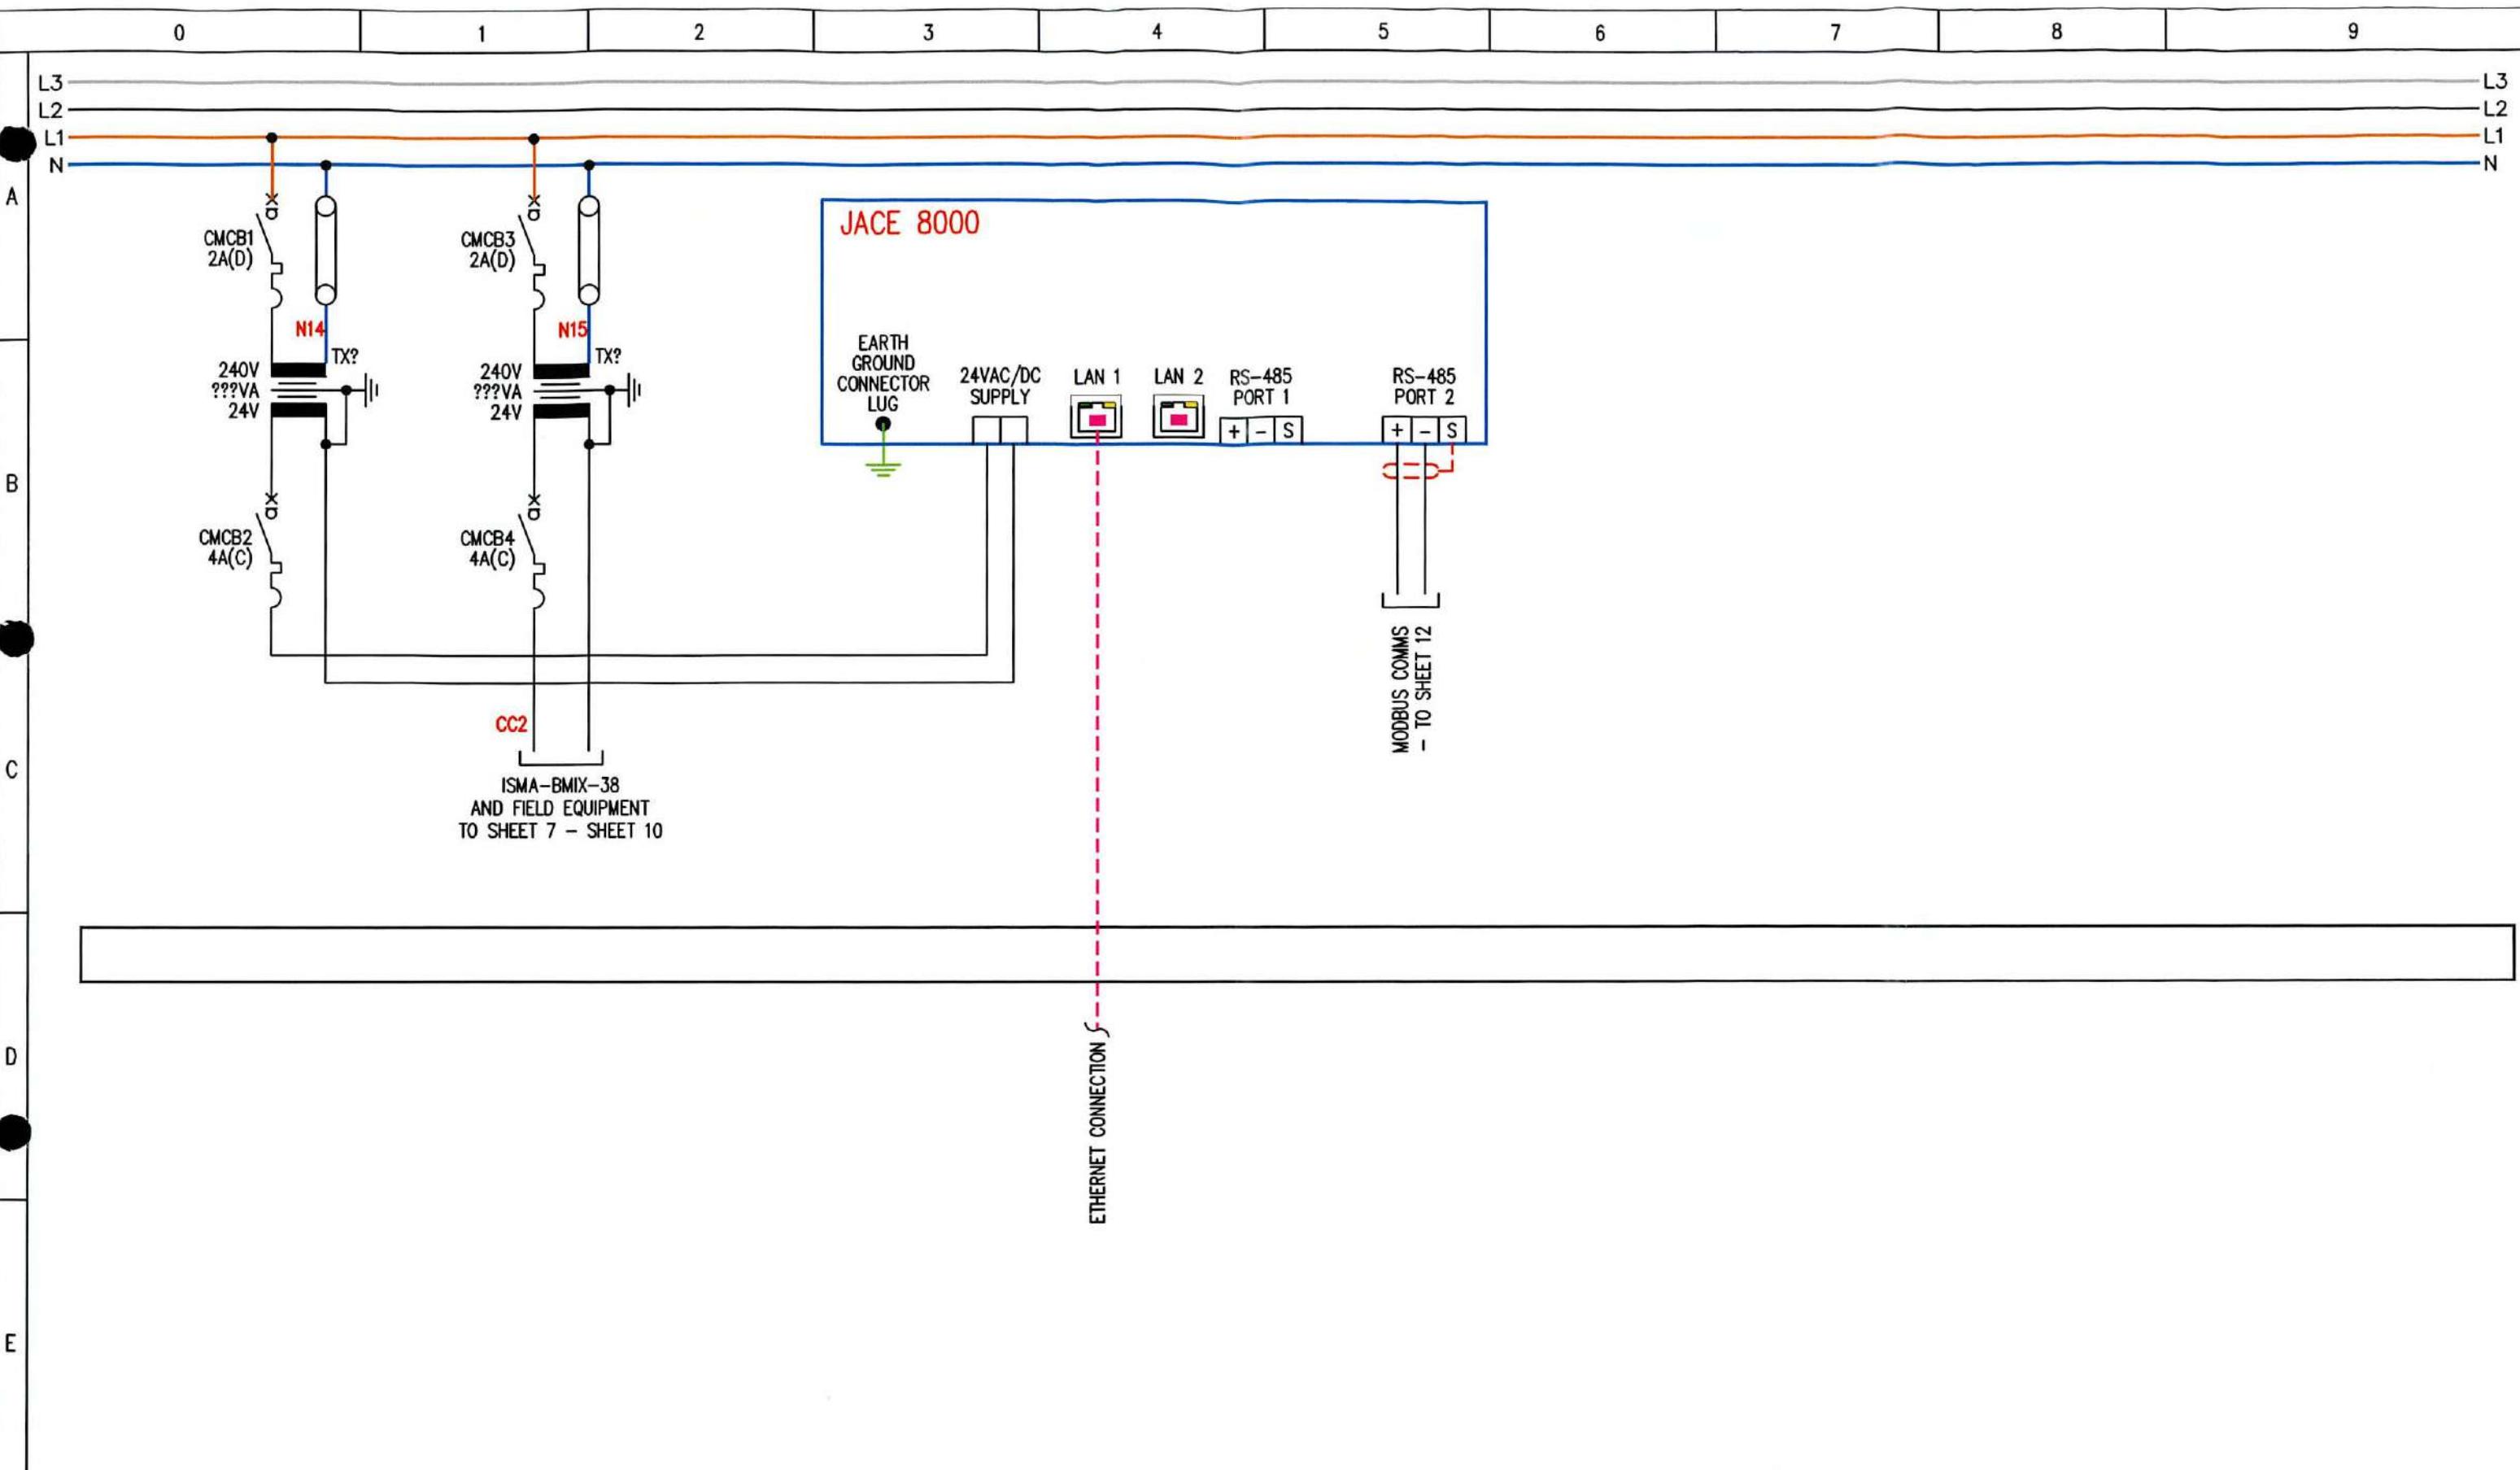

0 1 2 3 4 5 6 7 8 9

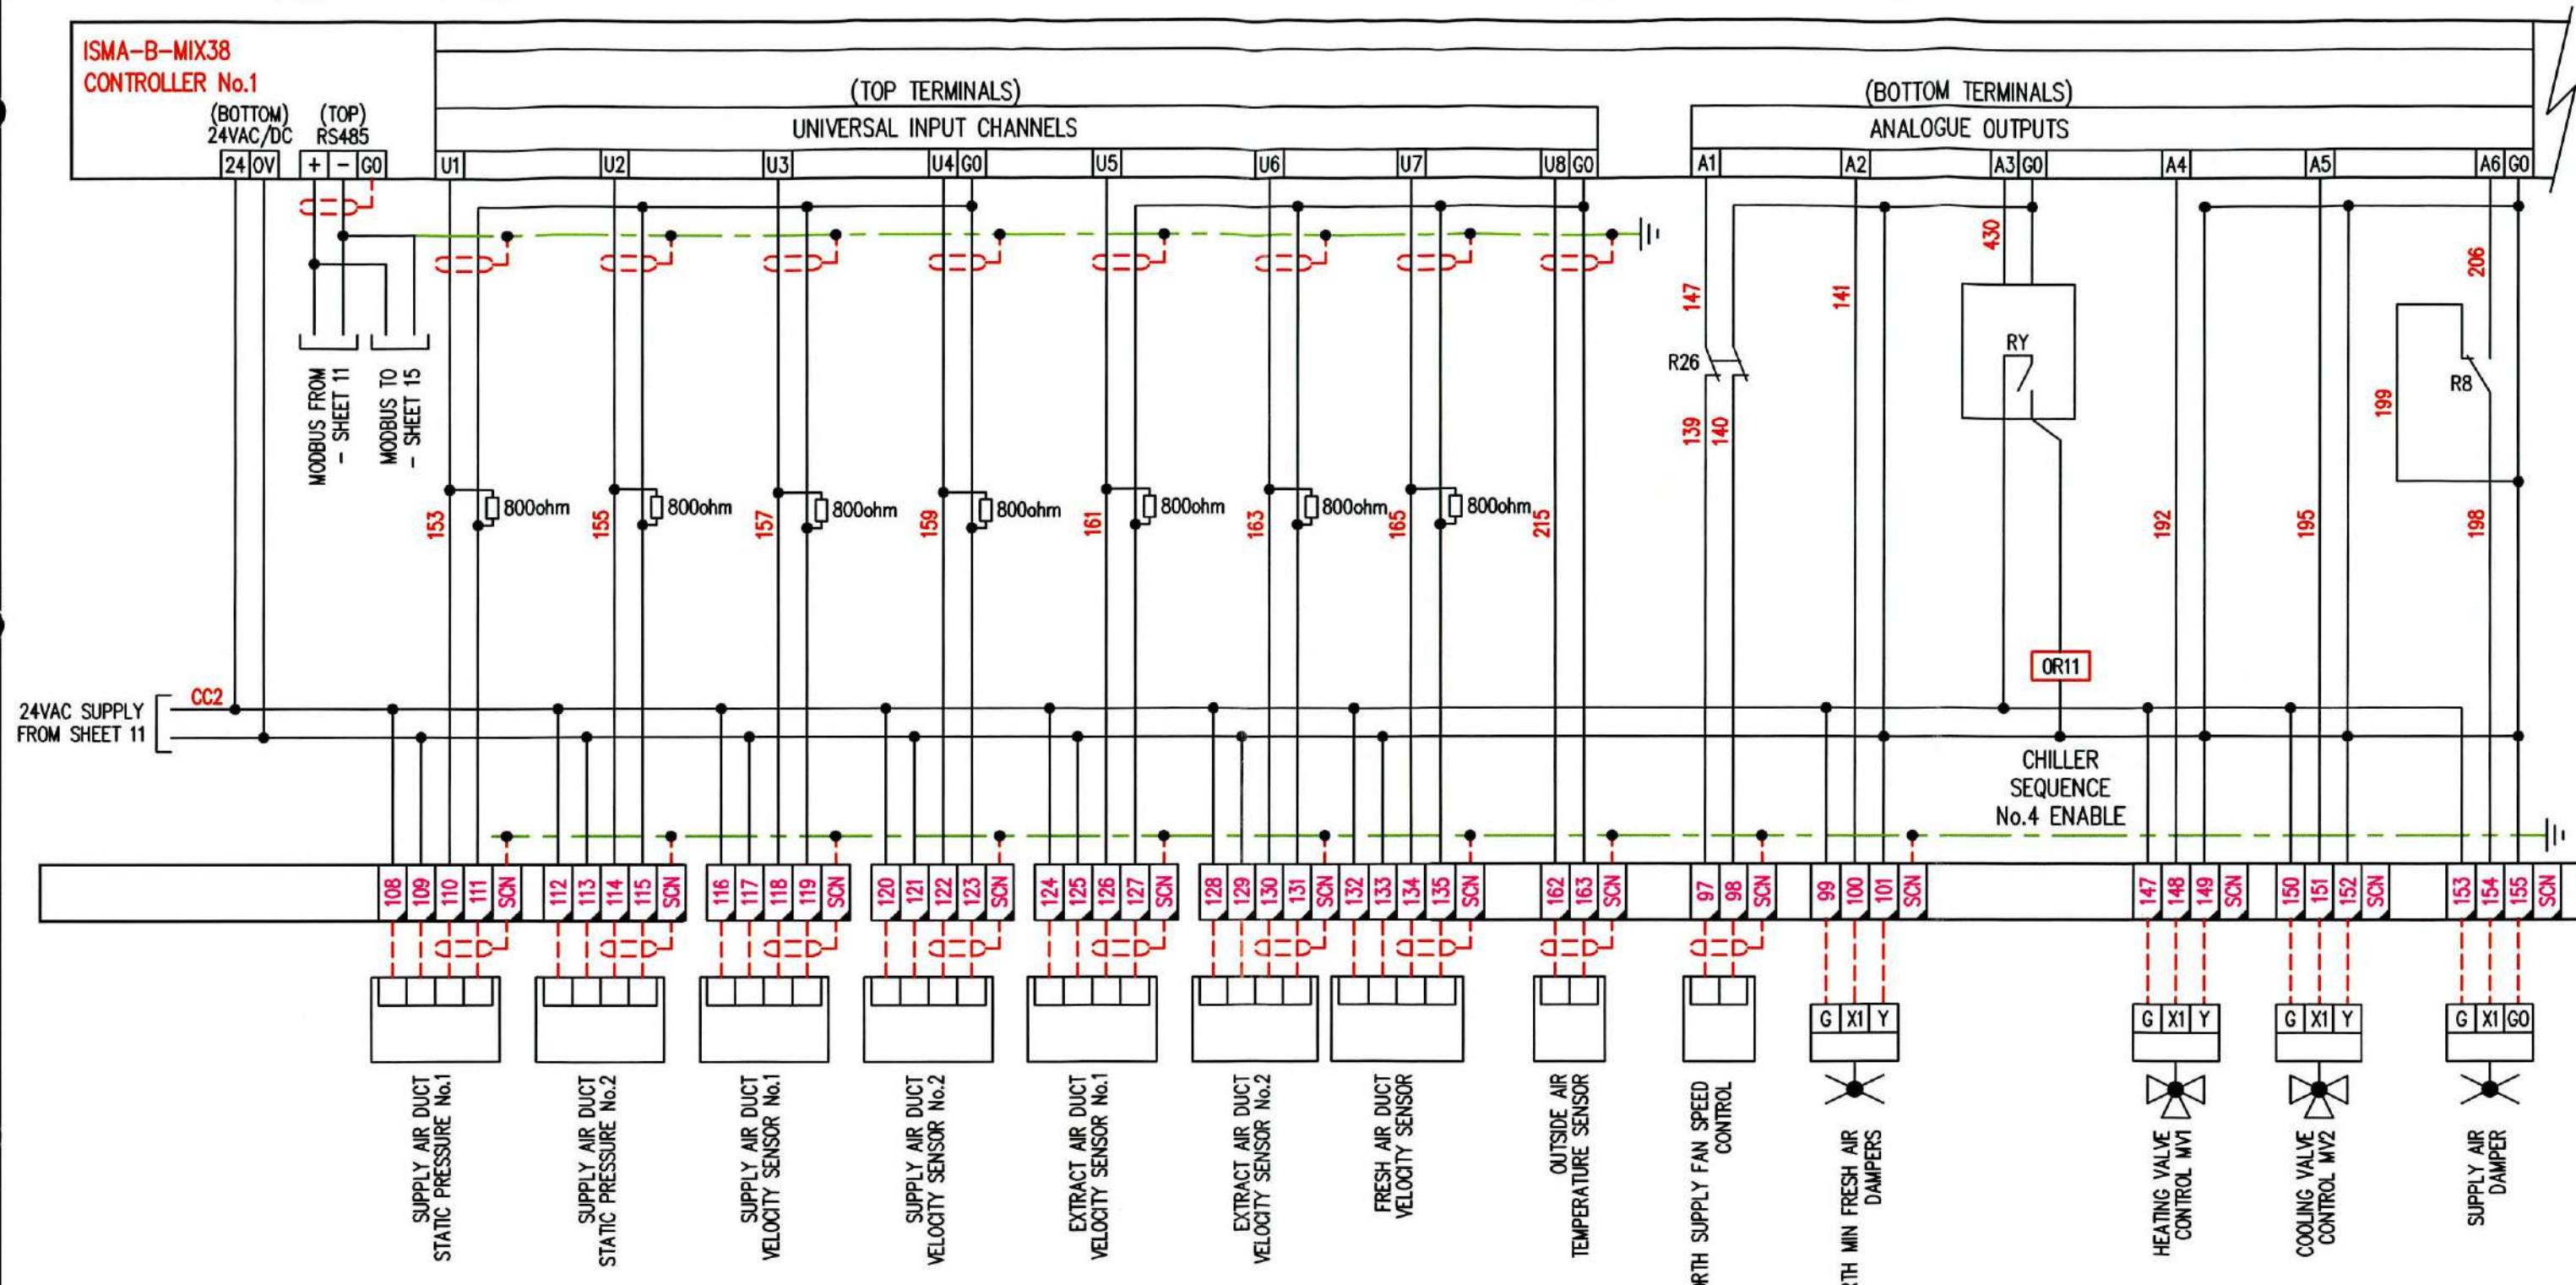

PROVISIONAL FOR APPROVAL ISSUED FOR CONSTRUCTION	AS BUILT AS FITTED	REVISION No	DESCRIPTION OF REVISION	DRAWN BY DATE	CHECKED BY DATE	REVISION No	DESCRIPTION OF REVISION	STATUS	DRAWN BY DATE	CHECKED BY DATE	DRG No.6082-17 PROJECT No.6085	SHT. 12 of 26	REV 1 ©
		0	PROVISIONAL	RFD 14/05/21		4					TITLE	EXCHEQUER COURT	
		1	AS COMMISSIONED	RFD 19/05/21		5					PANEL TITLE	ROOF NORTH PLANTROOM CONTROL PANEL	
		2				6					CLIENT		
		3				7							

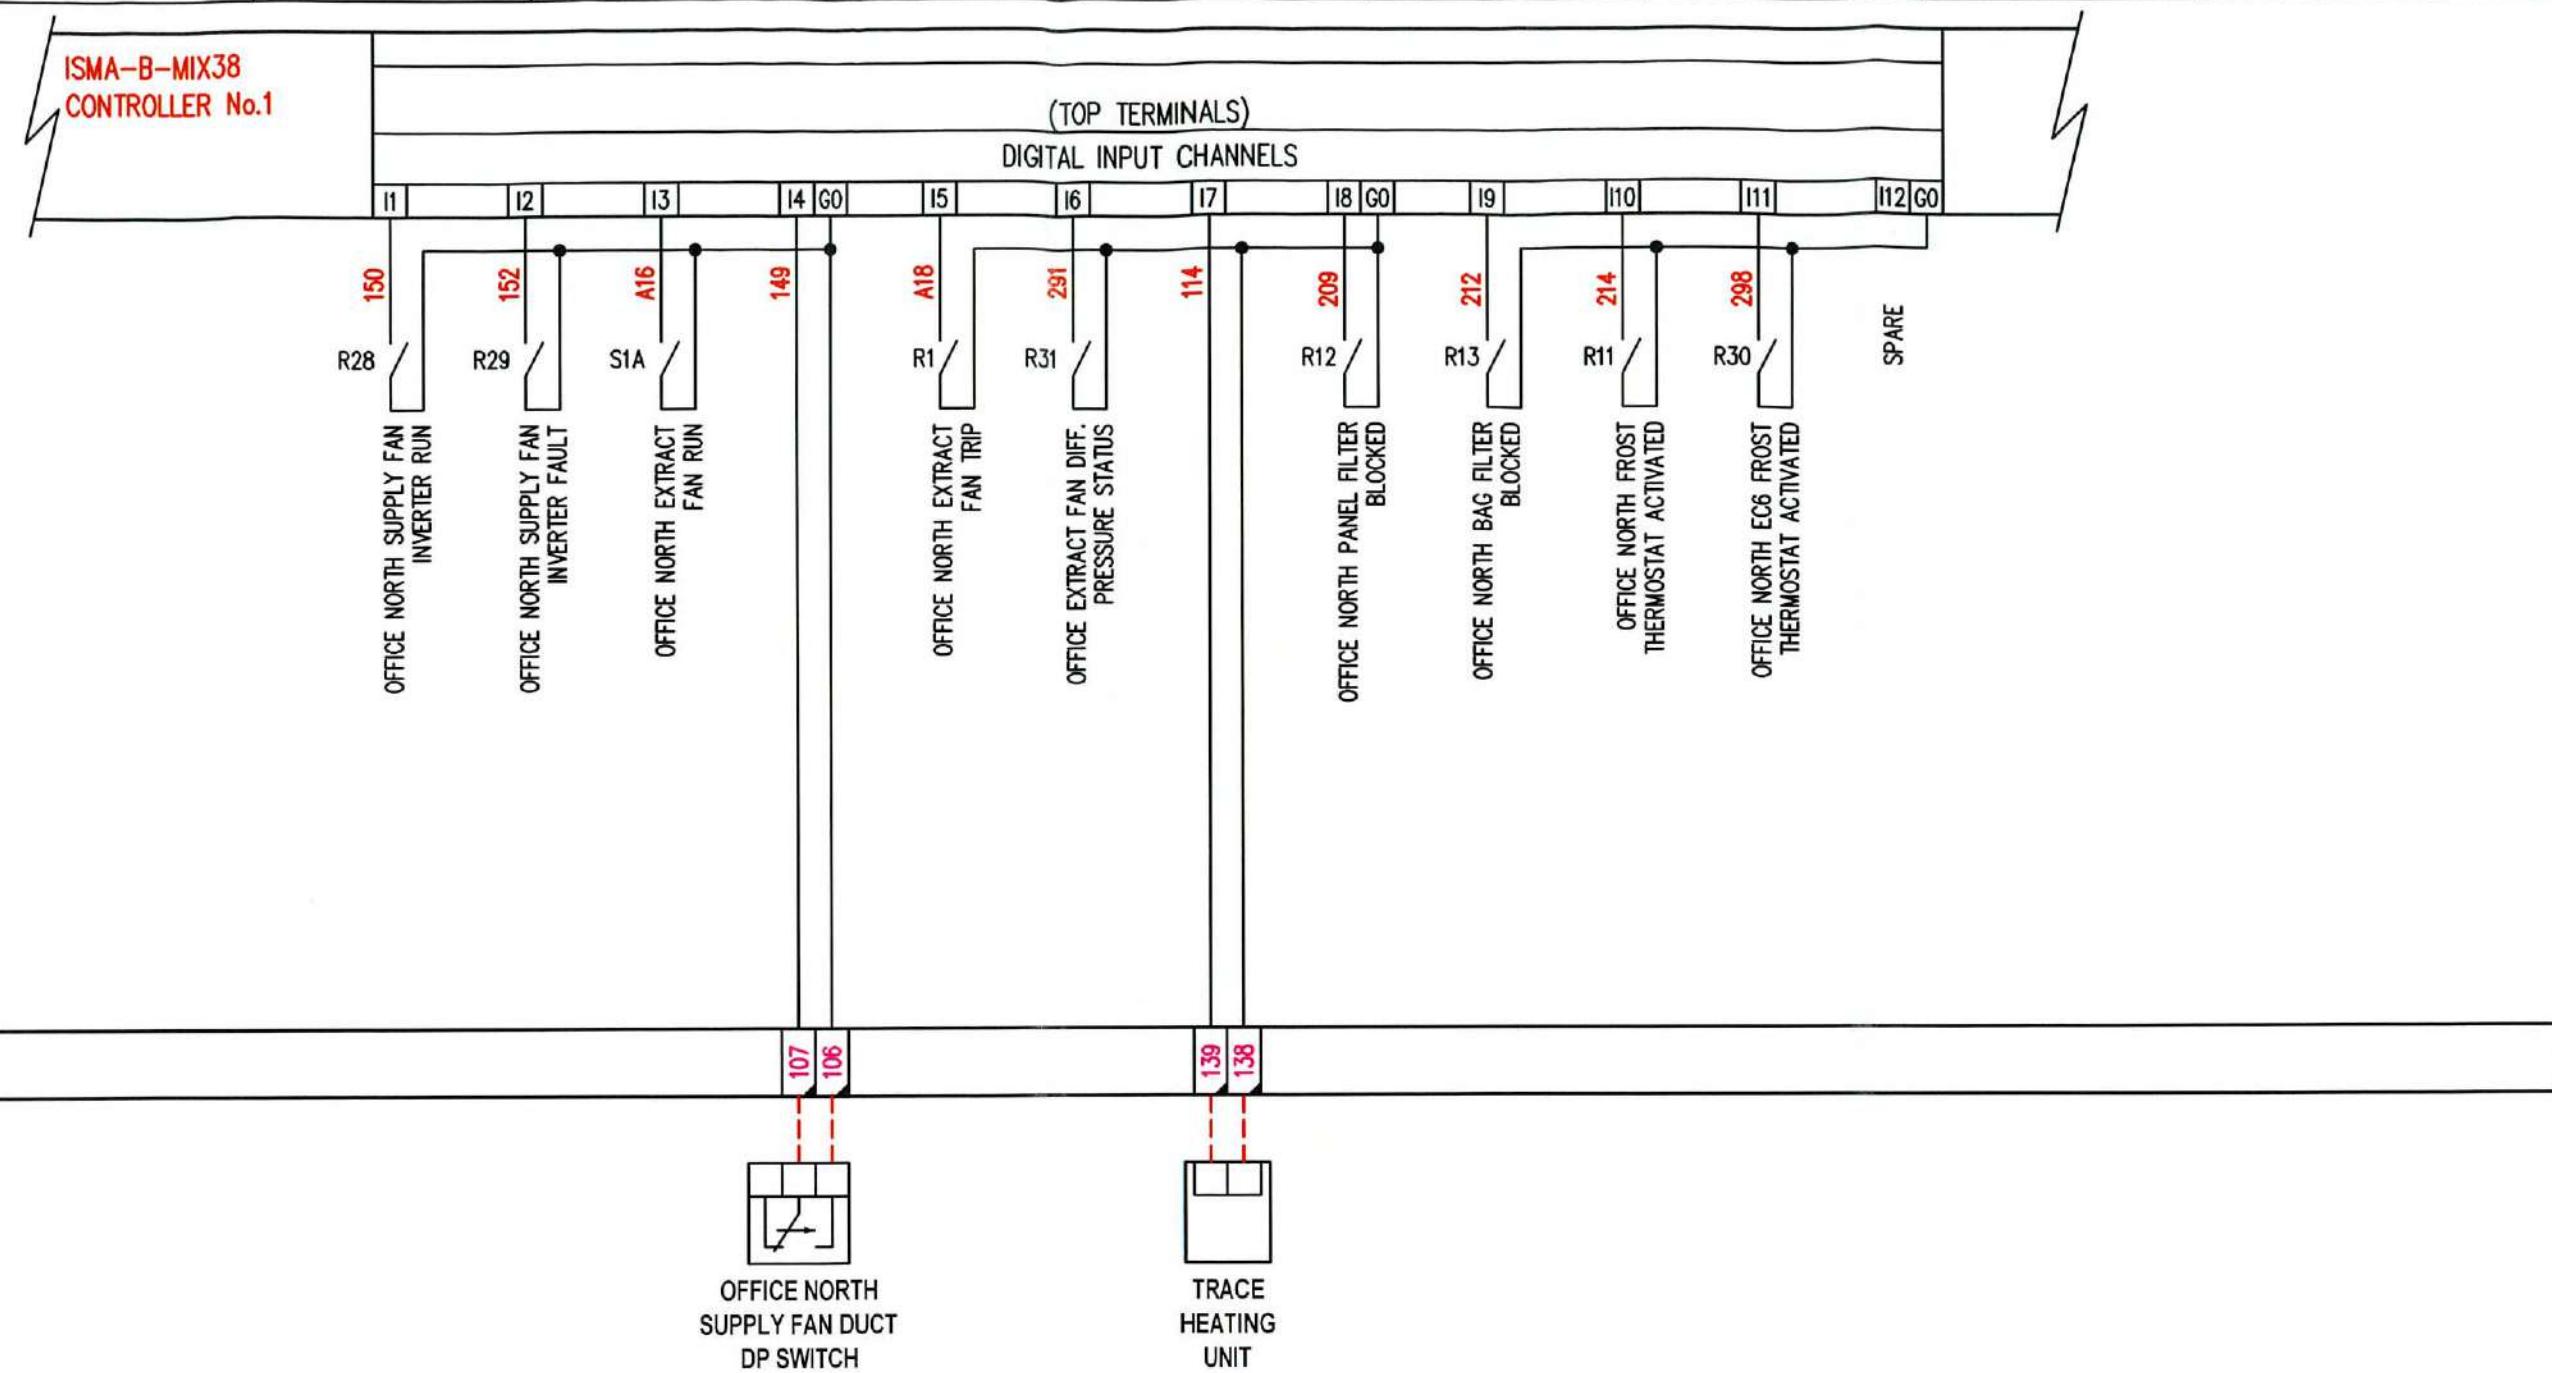

0 1 2 3 4 5 6 7 8 9

**ISMA-B-MIX38
CONTROLLER No.1**

(BOTTOM TERMINALS)

DIGITAL OUTPUT CHANNELS

01 02 C1 03 04 C2 05 06 C3 07 08 C4 09 010 C5 011 012 C6

179 181 183 185 187 189 239 241 330 389 391 393

24VAC SUPPLY
FROM SHEET 11

CC2
???

LIFT FAN
CORE 4
ENABLE

SPARE

CORE 6
TOILET EF
No.1
ENABLE

CORE 6
TOILET EF
No.2
ENABLE

TRACE
HEATING
ENABLE

SPARE

CHILLER
No.1
ENABLE

CHILLER
No.2
ENABLE

CHILLER
No.3
ENABLE

PRI. CHW
PUMP
No.1
ENABLE

PRI. CHW
PUMP
No.2
ENABLE

PRI. CHW
PUMP
No.3
ENABLE

OR7 OR8 OR9 OR10 OR11 OR12 OR13 OR14 OR15 OR16 OR17 OR18

● PROVISIONAL
● FOR APPROVAL
● ISSUED FOR
CONSTRUCTION

● AS BUILT
● AS FITTED

REVISION

No

DESCRIPTION OF REVISION

DRAWN

BY

DATE

CHECKED

BY

DATE

REVISION

No

DESCRIPTION OF REVISION

STATUS

DRAWN

BY

DATE

CHECKED

BY

DATE

DRG No.6082-17 SHT. 14 of 26
PROJECT No.6085

REV 1



C

TITLE EXCHEQUER COURT

PANEL
TITLE ROOF NORTH PLANTROOM
CONTROL PANEL

CLIENT




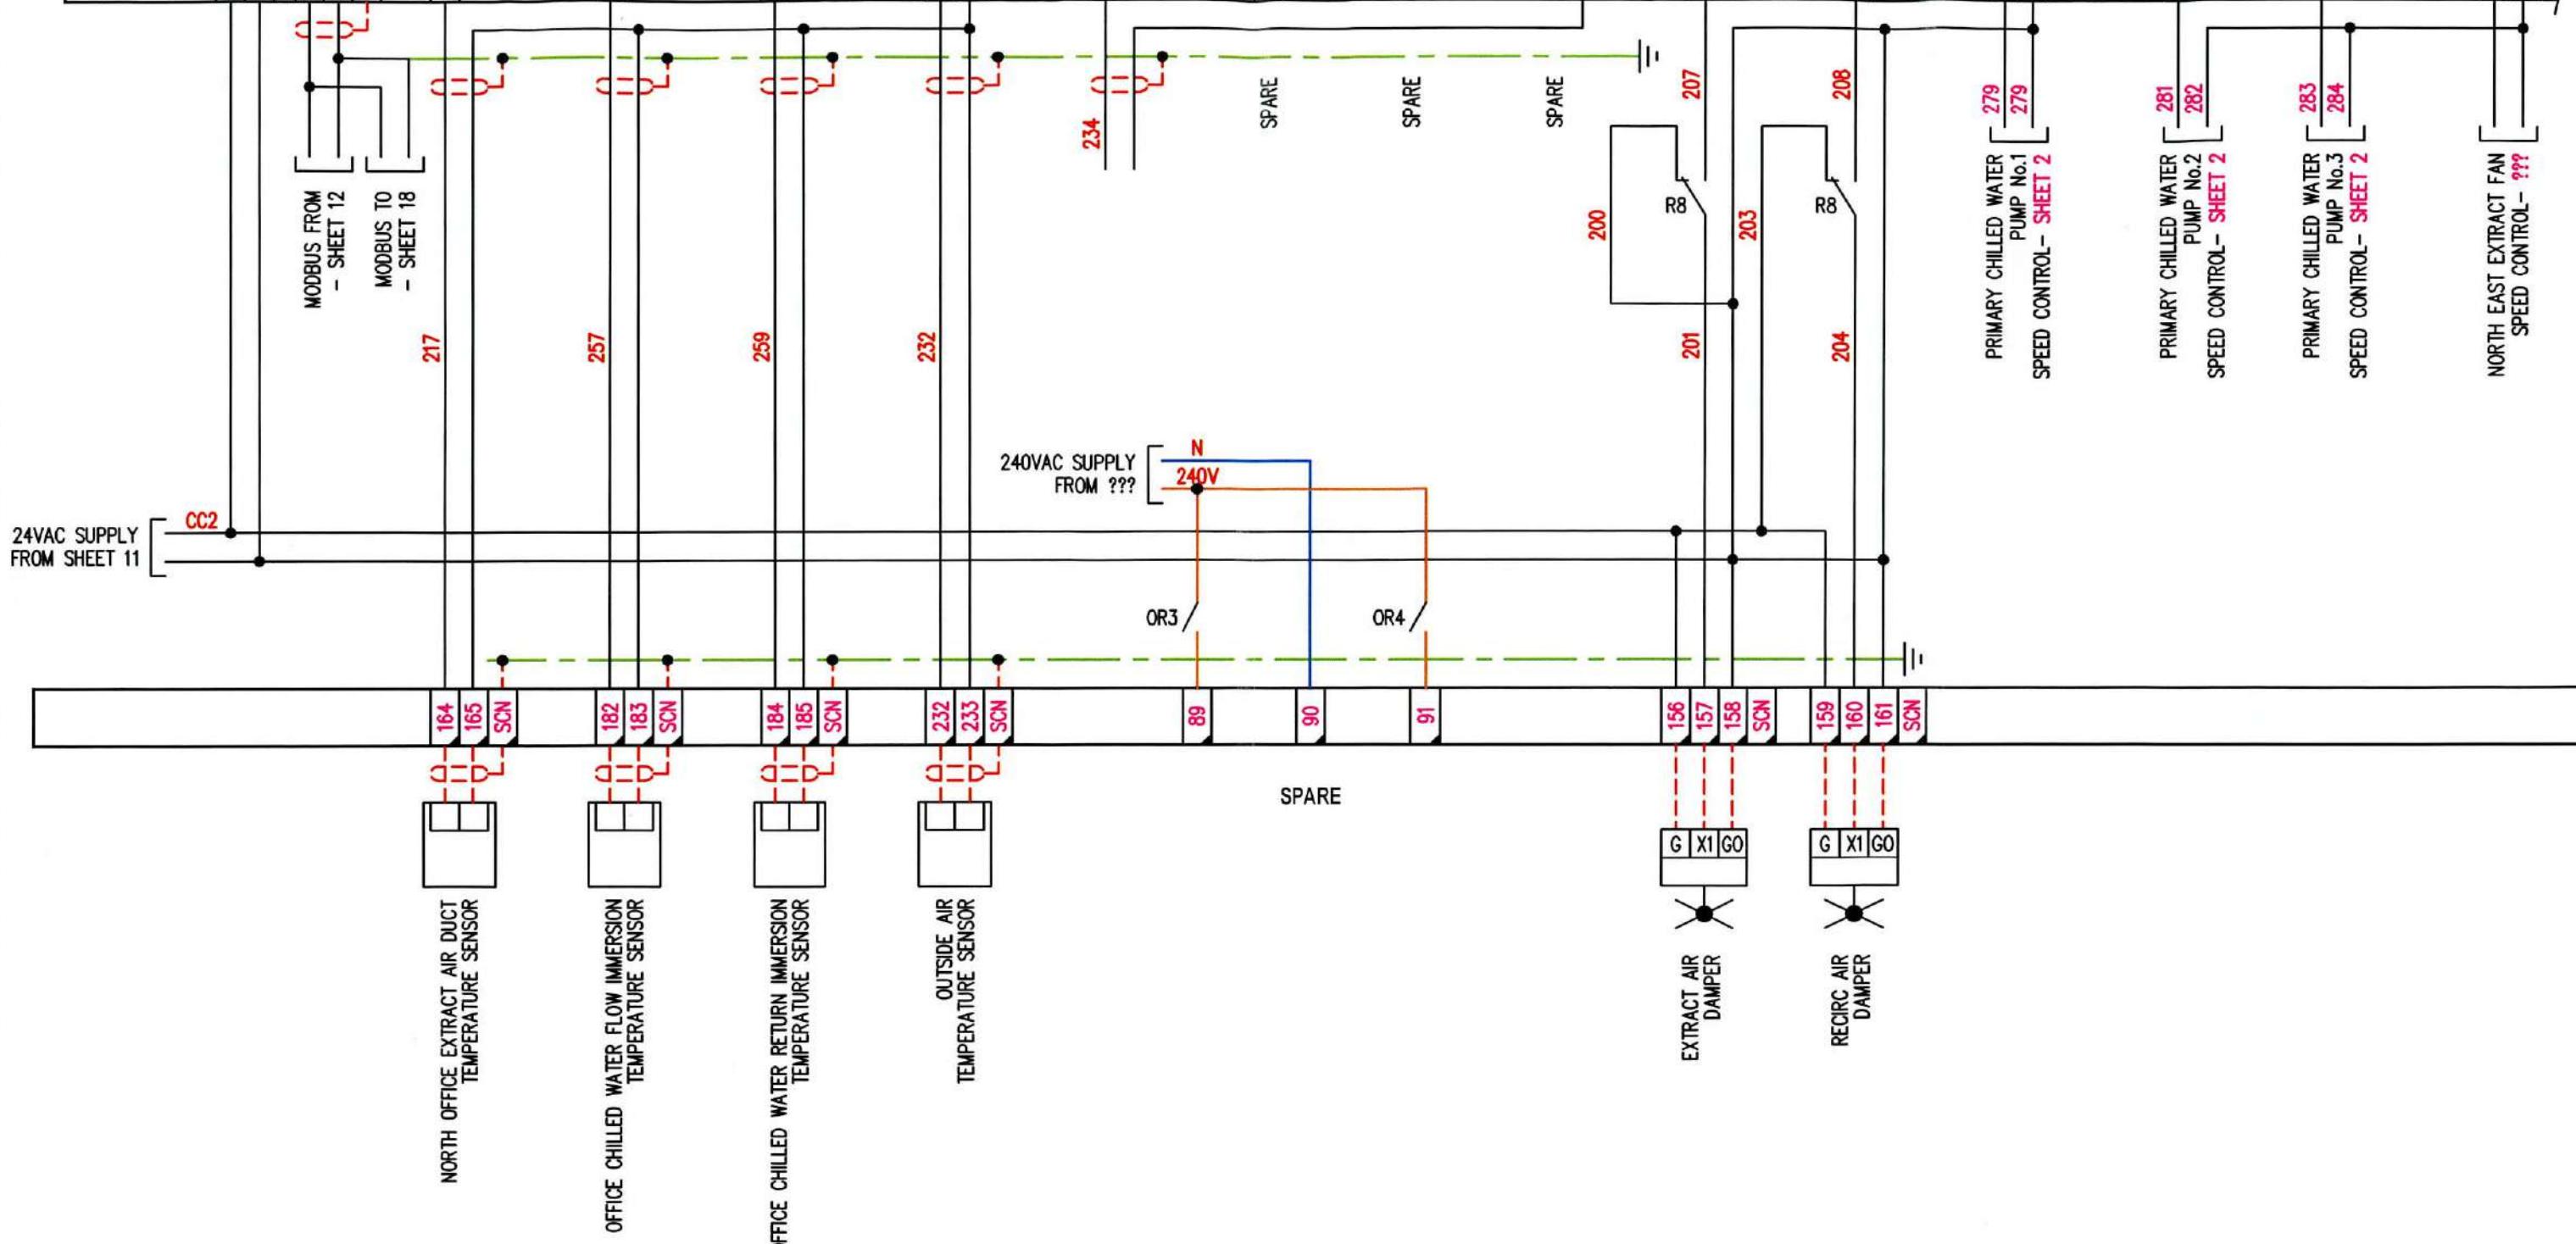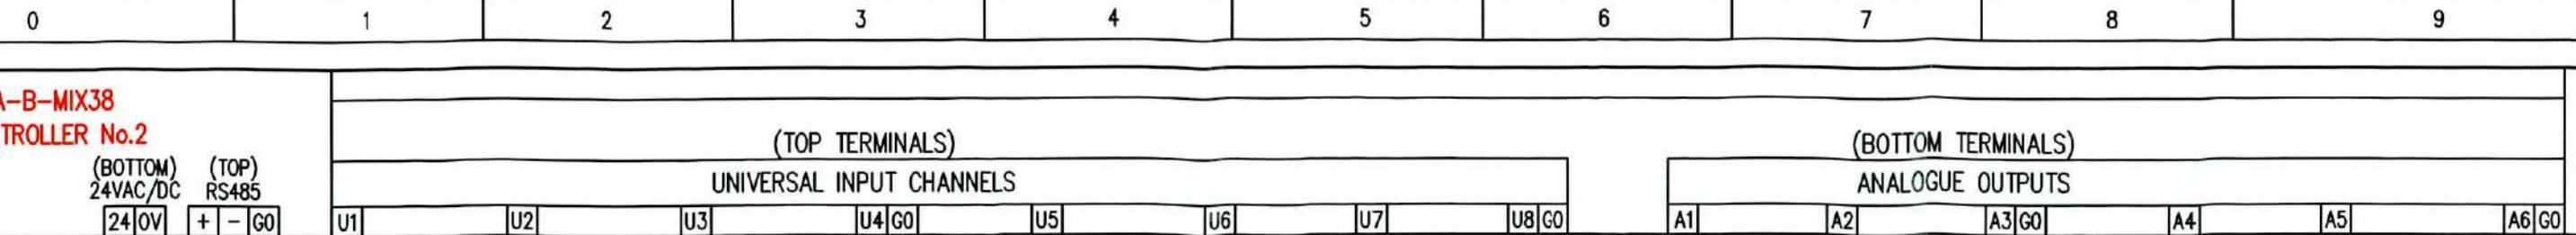

PROVISIONAL FOR APPROVAL ISSUED FOR CONSTRUCTION	AS BUILT AS FITTED	REVISION No	DESCRIPTION OF REVISION	DRAWN BY DATE	CHECKED BY DATE	REVISION No	DESCRIPTION OF REVISION	STATUS	DRAWN BY DATE	CHECKED BY DATE	DRG No.6082-17 PROJECT No.6085	SHT. 15 of 26	REV 1 ©
		0	PROVISIONAL	RFD 14/05/21		4					TITLE	EXCHEQUER COURT	
		1	AS COMMISSIONED	RFD 19/05/21		5					PANEL TITLE	ROOF NORTH PLANTROOM CONTROL PANEL	
		2				6					CLIENT		
		3				7							


bges group

0 1 2 3 4 5 6 7 8 9

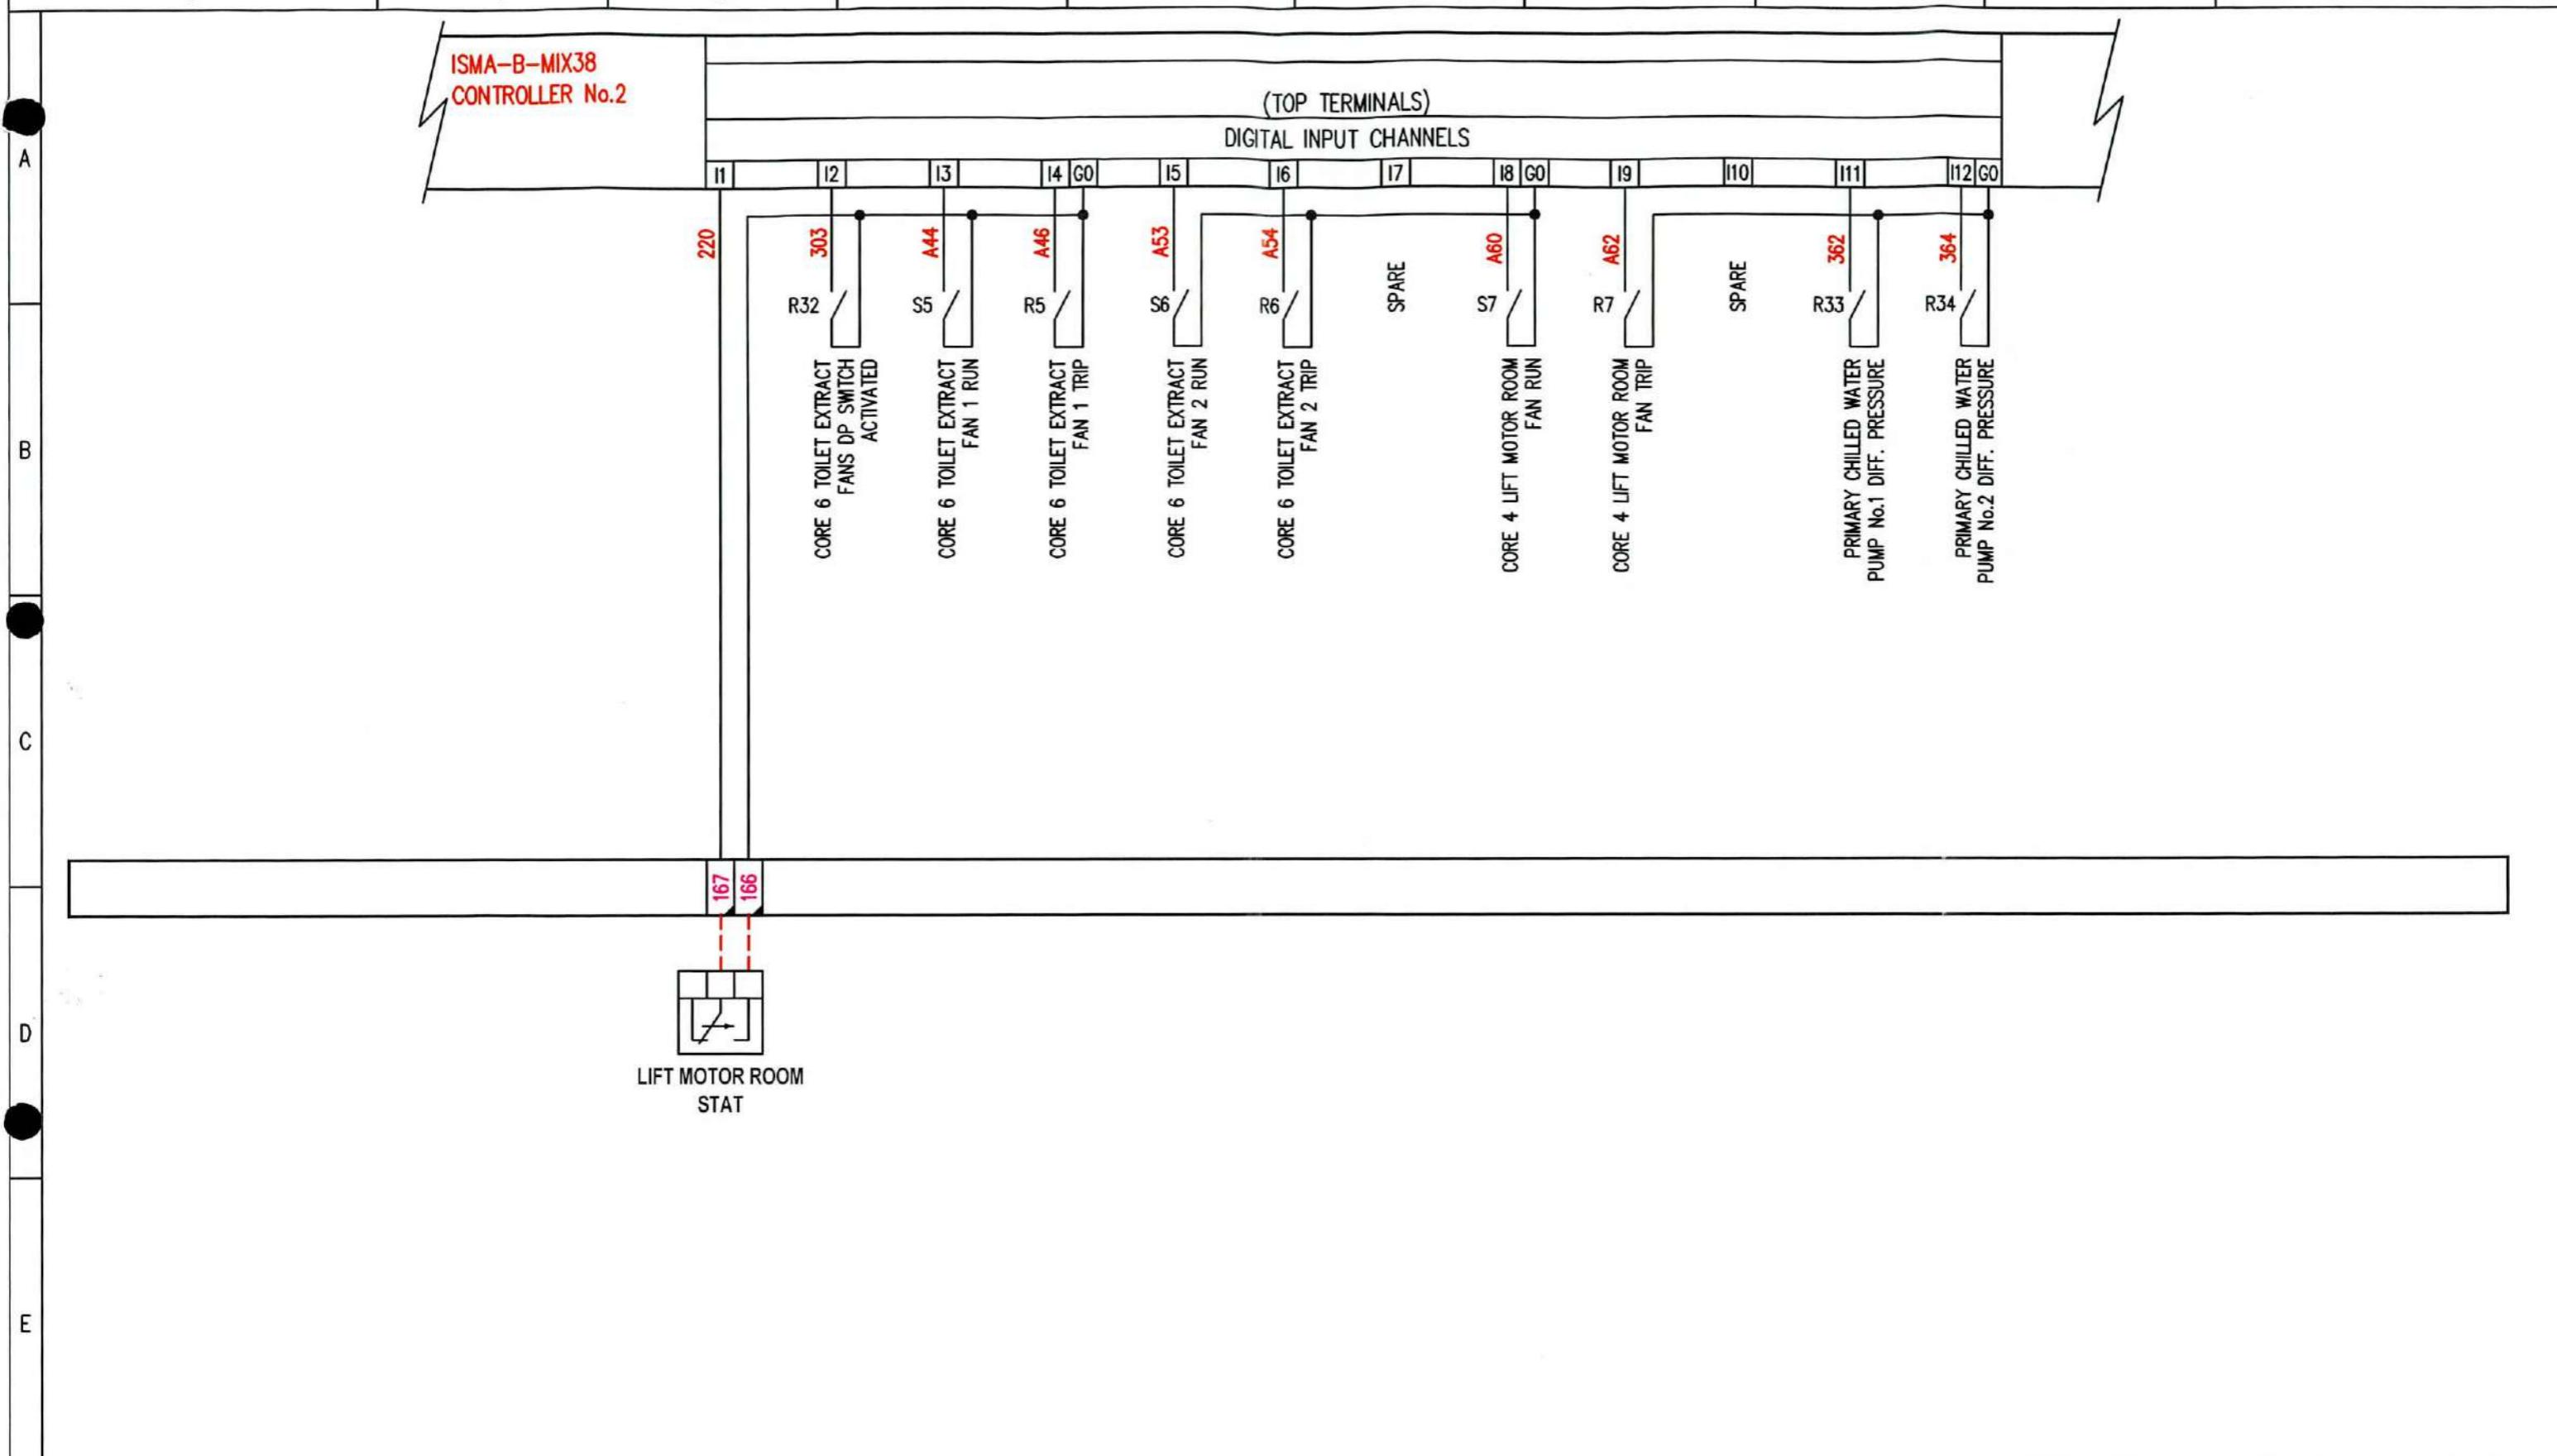


PROVISIONAL FOR APPROVAL ISSUED FOR CONSTRUCTION	AS BUILT AS FITTED	REVISION No	DESCRIPTION OF REVISION	DRAWN BY DATE	CHECKED BY DATE	REVISION No	DESCRIPTION OF REVISION	STATUS	DRAWN BY DATE	CHECKED BY DATE	DRG No.6082-17 SHT. 16 of 26 PROJECT No.6085	REV 1 ©
		0	PROVISIONAL	RFD 14/05/21		4					TITLE	EXCHEQUER COURT
		1	AS COMMISSIONED	RFD 19/05/21		5					PANEL TITLE	ROOF NORTH PLANTROOM CONTROL PANEL
		2				6					CLIENT	
		3				7						

0 1 2 3 4 5 6 7 8 9

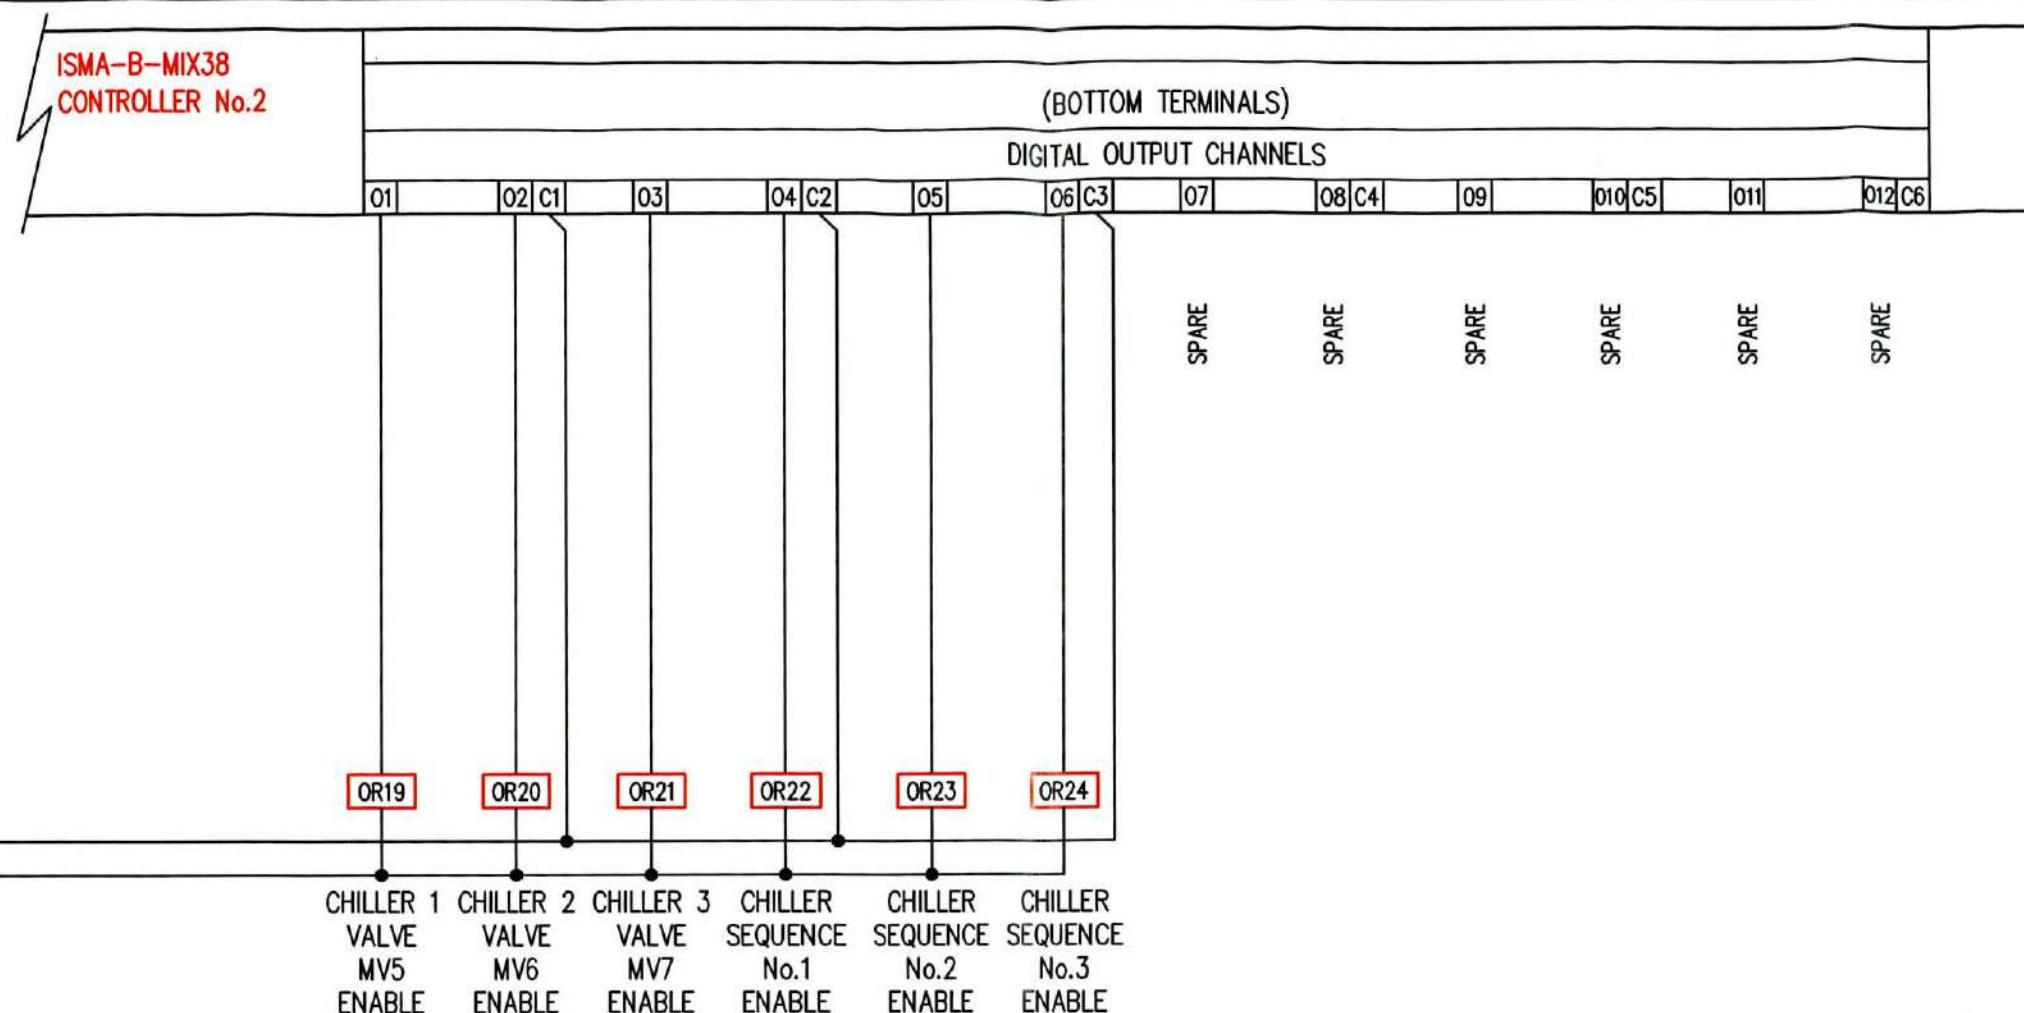

● PROVISIONAL ● FOR APPROVAL ● ISSUED FOR CONSTRUCTION	● AS BUILT ● AS FITTED	REVISION No	DESCRIPTION OF REVISION	DRAWN BY DATE	CHECKED BY DATE	REVISION No	DESCRIPTION OF REVISION	STATUS	DRAWN BY DATE	CHECKED BY DATE	DRG No.6082-17 PROJECT No.6085	SHT. 17 of 26	REV 1 ©
		0	PROVISIONAL	RFD 14/05/21		4					TITLE	EXCHEQUER COURT	
		1	AS COMMISSIONED	RFD 19/05/21		5					PANEL TITLE	ROOF NORTH PLANTROOM CONTROL PANEL	
		2				6					CLIENT		
		3				7							



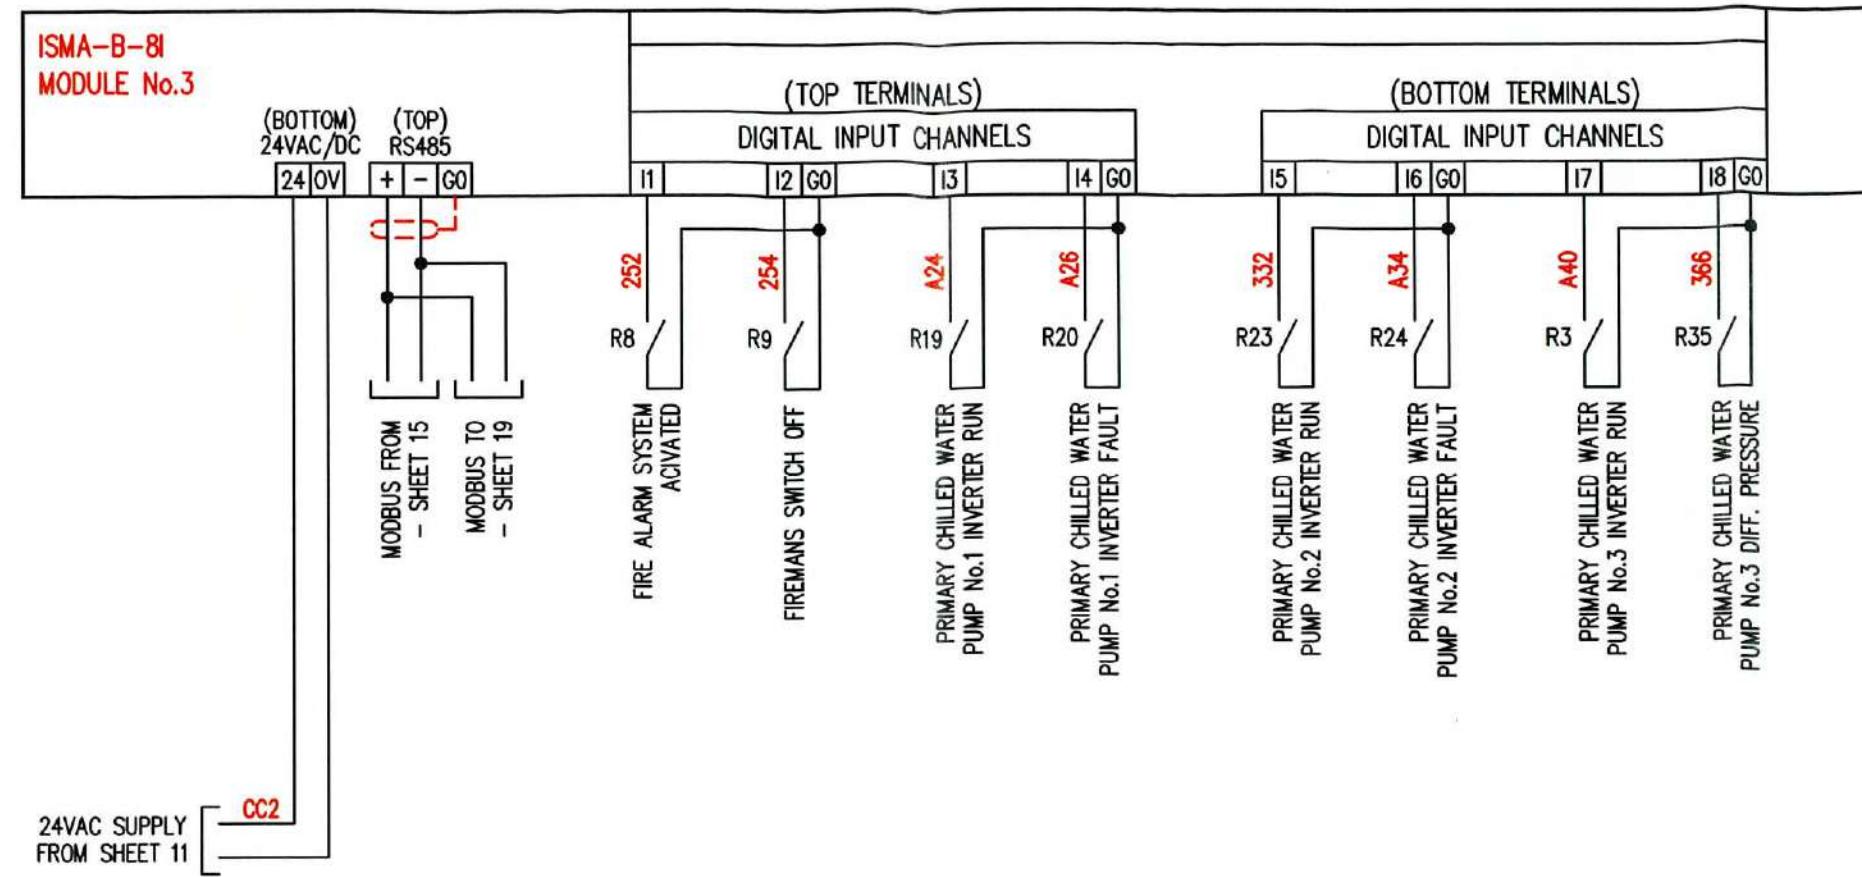

C

D

E


PROVISIONAL
 FOR APPROVAL
 ISSUED FOR CONSTRUCTION

AS BUILT
 AS FITTED


REVISION No	DESCRIPTION OF REVISION	DRAWN BY DATE	CHECKED BY DATE	REVISION No
0	PROVISIONAL	RFD 14/05/21		4
1	AS COMMISSIONED	RFD 19/05/21		5
2				6
3				7

DESCRIPTION OF REVISION	STATUS	DRAWN BY DATE	CHECKED BY DATE


DRG No.6082-17	SHT. 18 of 26	REV 1
PROJECT No.6085		©
TITLE	EXCHEQUER COURT	
PANEL TITLE	ROOF NORTH PLANTROOM CONTROL PANEL	
CLIENT		

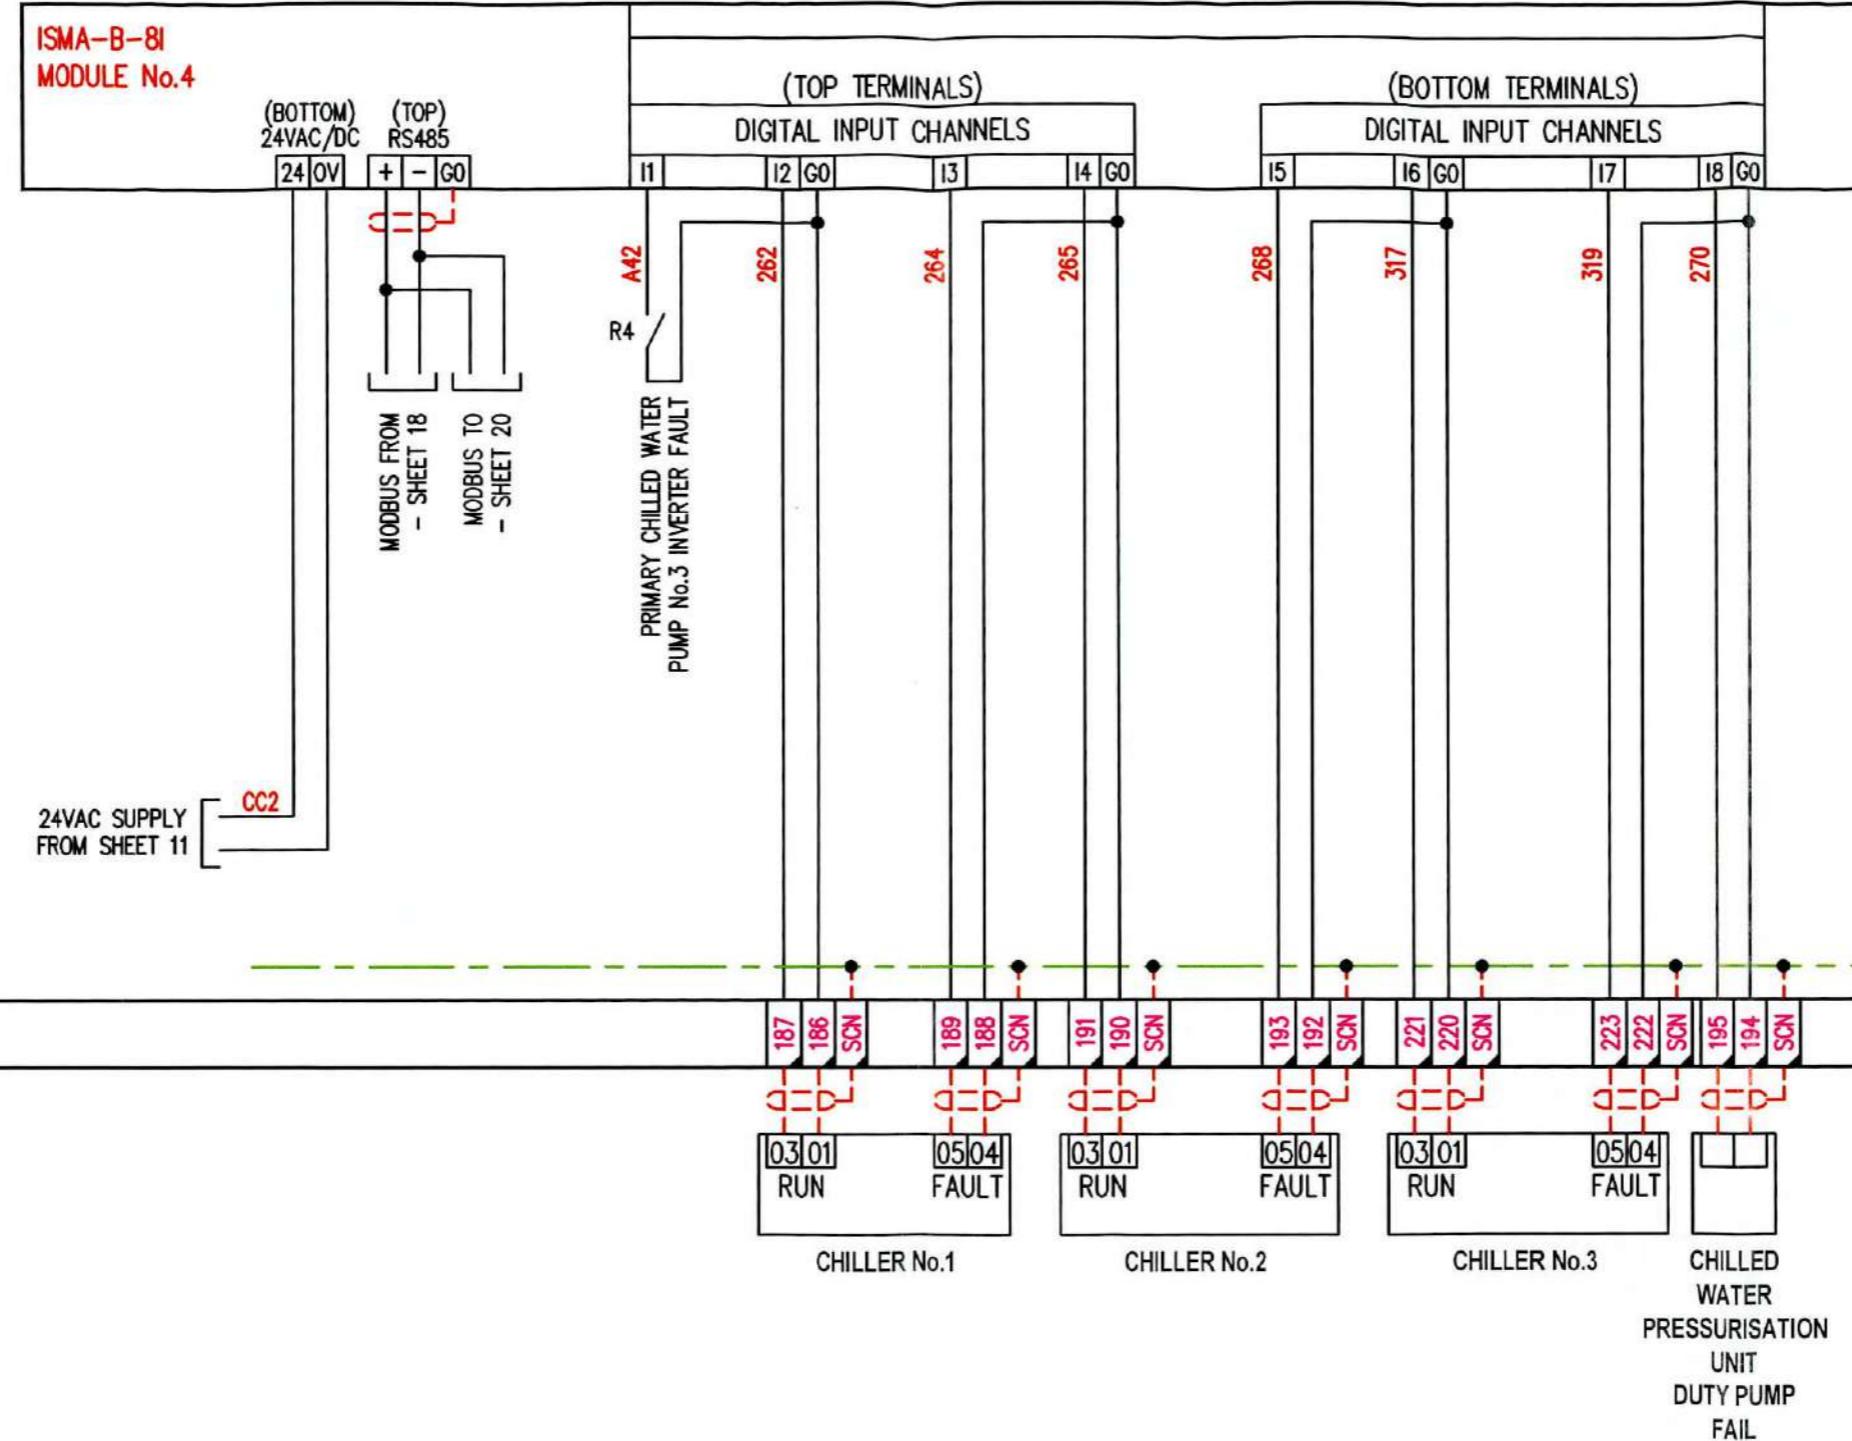

PROVISIONAL FOR APPROVAL ISSUED FOR CONSTRUCTION	AS BUILT AS FITTED	REVISION No	DESCRIPTION OF REVISION	DRAWN BY DATE	CHECKED BY DATE	REVISION No	DESCRIPTION OF REVISION	STATUS	DRAWN BY DATE	CHECKED BY DATE	DRG No.6082-17 PROJECT No.6085	SHT. 19 of 26	REV 1 ©
		0	PROVISIONAL	RFD 14/05/21		4					TITLE	EXCHEQUER COURT	
		1	AS COMMISSIONED	RFD 19/05/21		5					PANEL TITLE	ROOF NORTH PLANTROOM CONTROL PANEL	
		2				6					CLIENT		
		3				7							

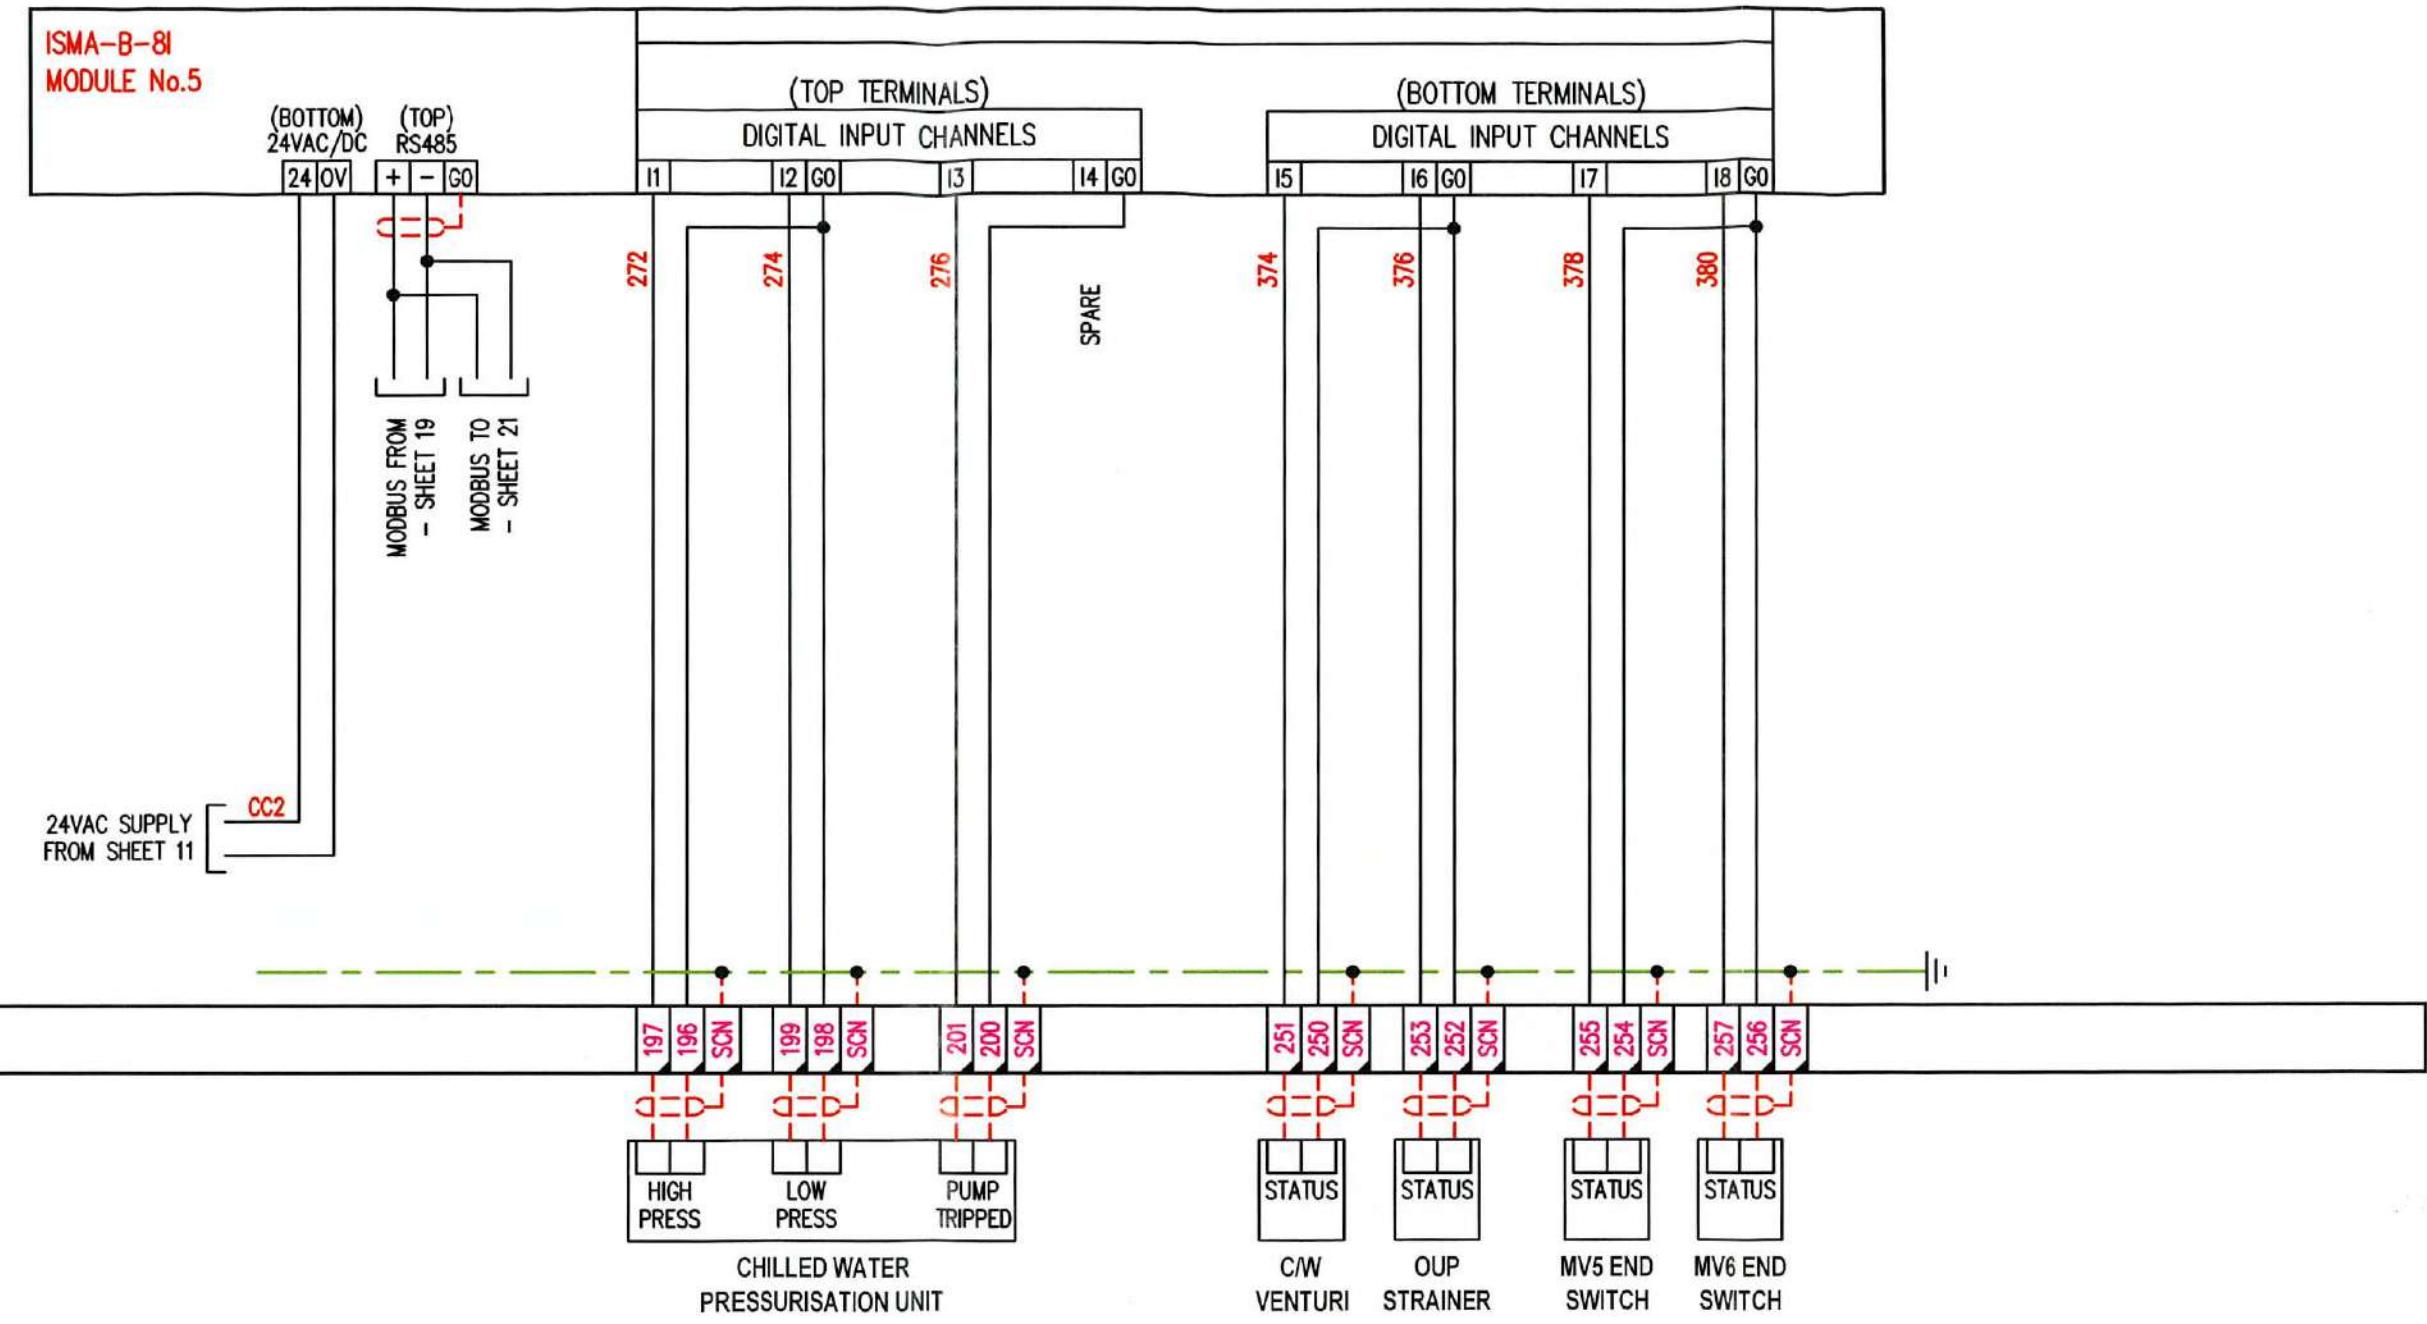

0 1 2 3 4 5 6 7 8 9

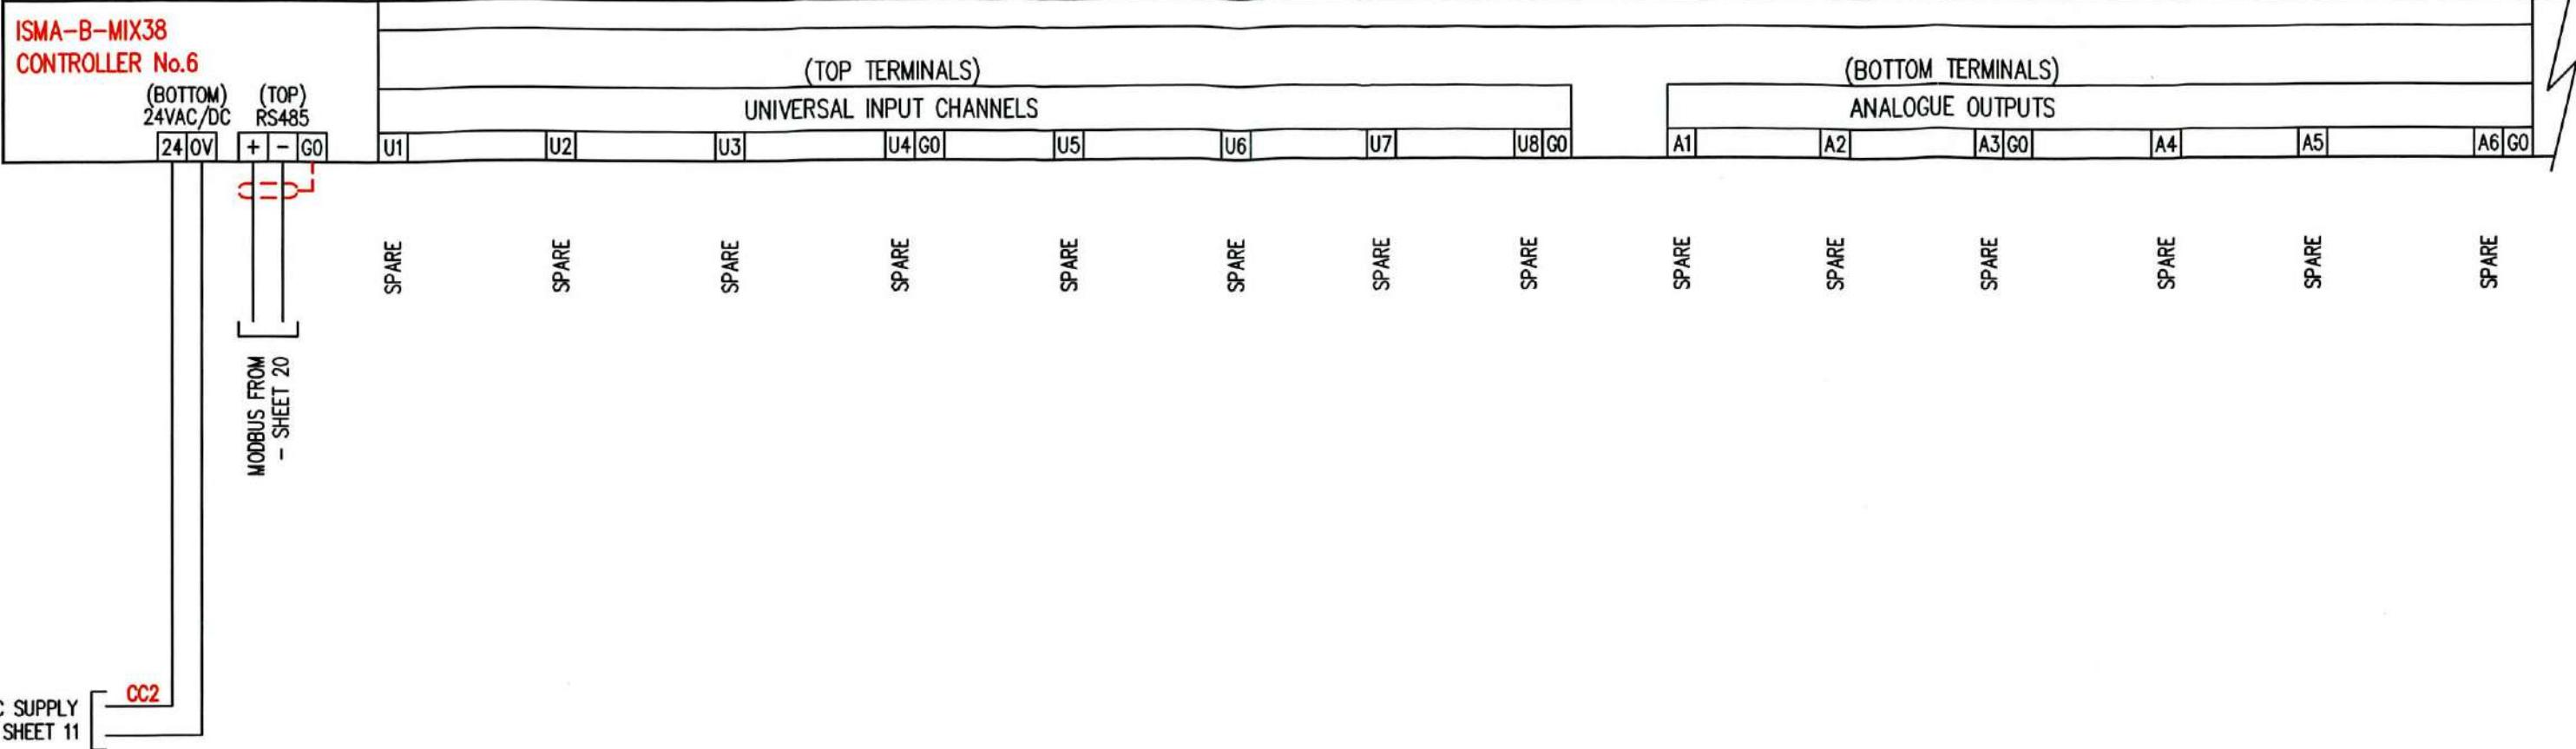

A

B

C

D

E

● PROVISIONAL ● AS BUILT
● FOR APPROVAL ● AS FITTED
● ISSUED FOR CONSTRUCTION



REVISION No	DESCRIPTION OF REVISION	DRAWN BY DATE	CHECKED BY DATE	REVISION No
0	PROVISIONAL	RFD 14/05/21		4
1	AS COMMISSIONED	RFD 19/05/21		5
2				6
3				7

DESCRIPTION OF REVISION	STATUS	DRAWN BY DATE	CHECKED BY DATE

DRG No.6082-17 SHT. 21 of 26
PROJECT No.6085


REV 1
©

TITLE EXCHEQUER COURT

PANEL TITLE ROOF NORTH PLANTROOM
CONTROL PANEL


CLIENT

0 1 2 3 4 5 6 7 8 9

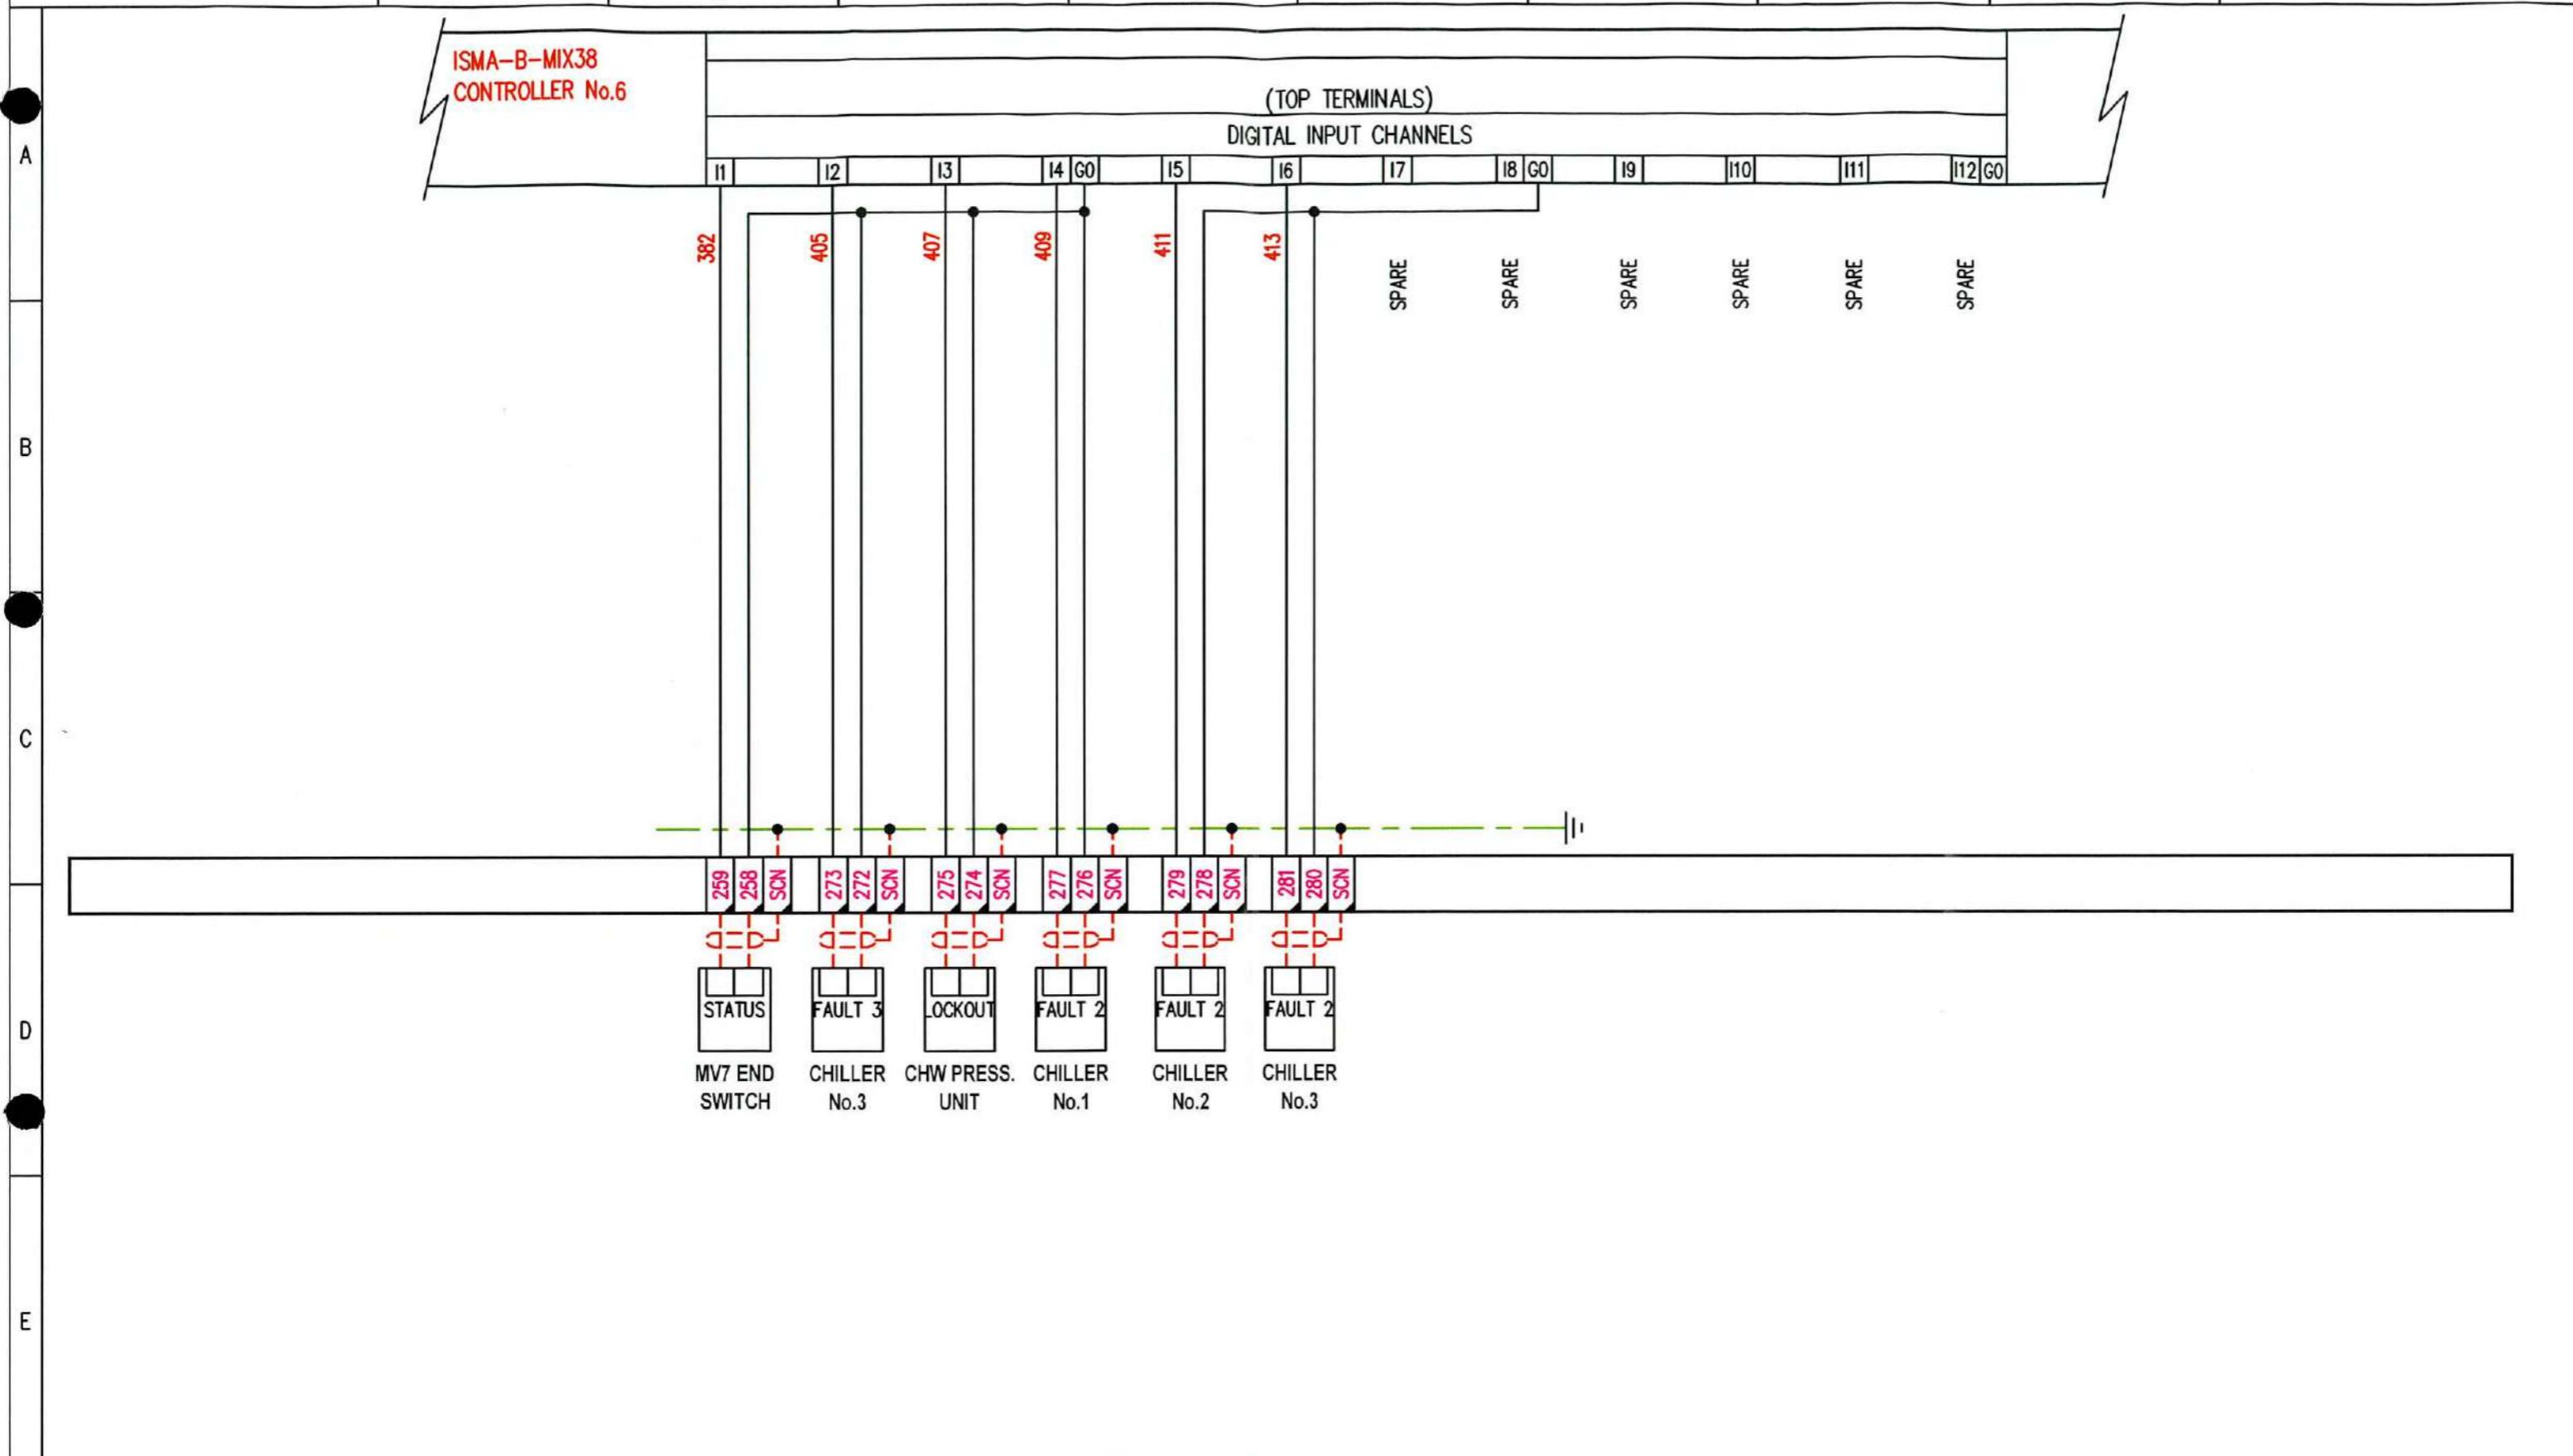


● PROVISIONAL ● FOR APPROVAL ● ISSUED FOR CONSTRUCTION	● AS BUILT ● AS FITTED	REVISION No	DESCRIPTION OF REVISION	DRAWN BY DATE	CHECKED BY DATE	REVISION No	DESCRIPTION OF REVISION	STATUS	DRAWN BY DATE	CHECKED BY DATE	DRG No.6082-17 PROJECT No.6085	SHT. 22 of 26	REV 1 ©
		0	PROVISIONAL	RFD 14/05/21		4					TITLE	EXCHEQUER COURT	
		1	AS COMMISSIONED	RFD 19/05/21		5					PANEL TITLE	ROOF NORTH PLANTROOM CONTROL PANEL	
		2				6					CLIENT		
		3				7							

0 1 2 3 4 5 6 7 8 9

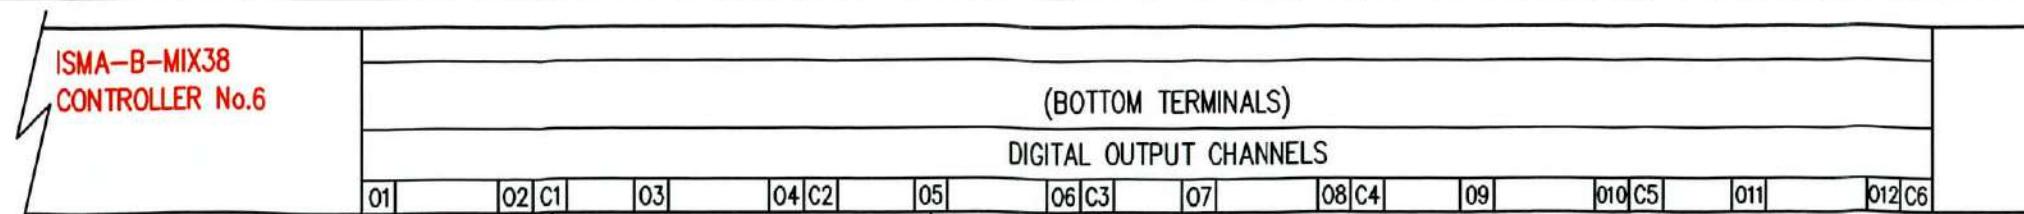


01 02 C1 03 04 C2 05 06 C3 07 08 C4 09 010 C5 011 012 C6

01 02 SPARE 05 06 SPARE SPARE SPARE SPARE SPARE SPARE

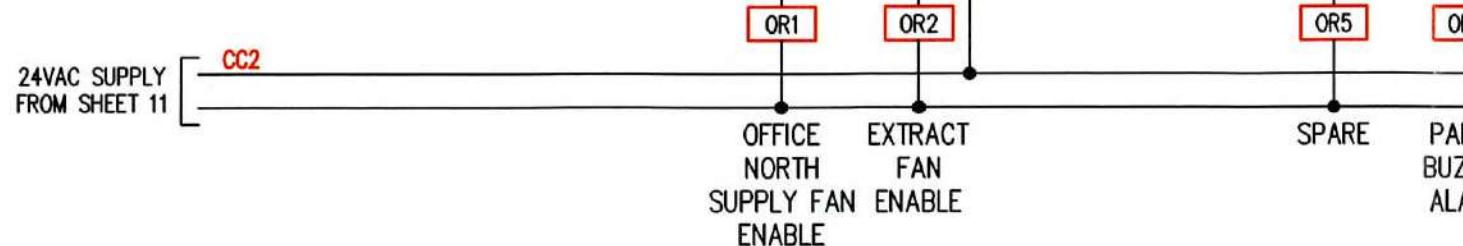

PROVISIONAL FOR APPROVAL ISSUED FOR CONSTRUCTION		AS BUILT AS FITTED		REVISION No	DESCRIPTION OF REVISION		DRAWN BY DATE	CHECKED BY DATE	REVISION No	DESCRIPTION OF REVISION		STATUS	DRAWN BY DATE	CHECKED BY DATE	
0	PROVISIONAL	RFD 14/05/21		4											DRG No.6082-17 PROJECT No.6085
1	AS COMMISSIONED	RFD 19/05/21		5											TITLE EXCHEQUER COURT
2				6											PANEL TITLE ROOF NORTH PLANTROOM CONTROL PANEL
3				7											CLIENT

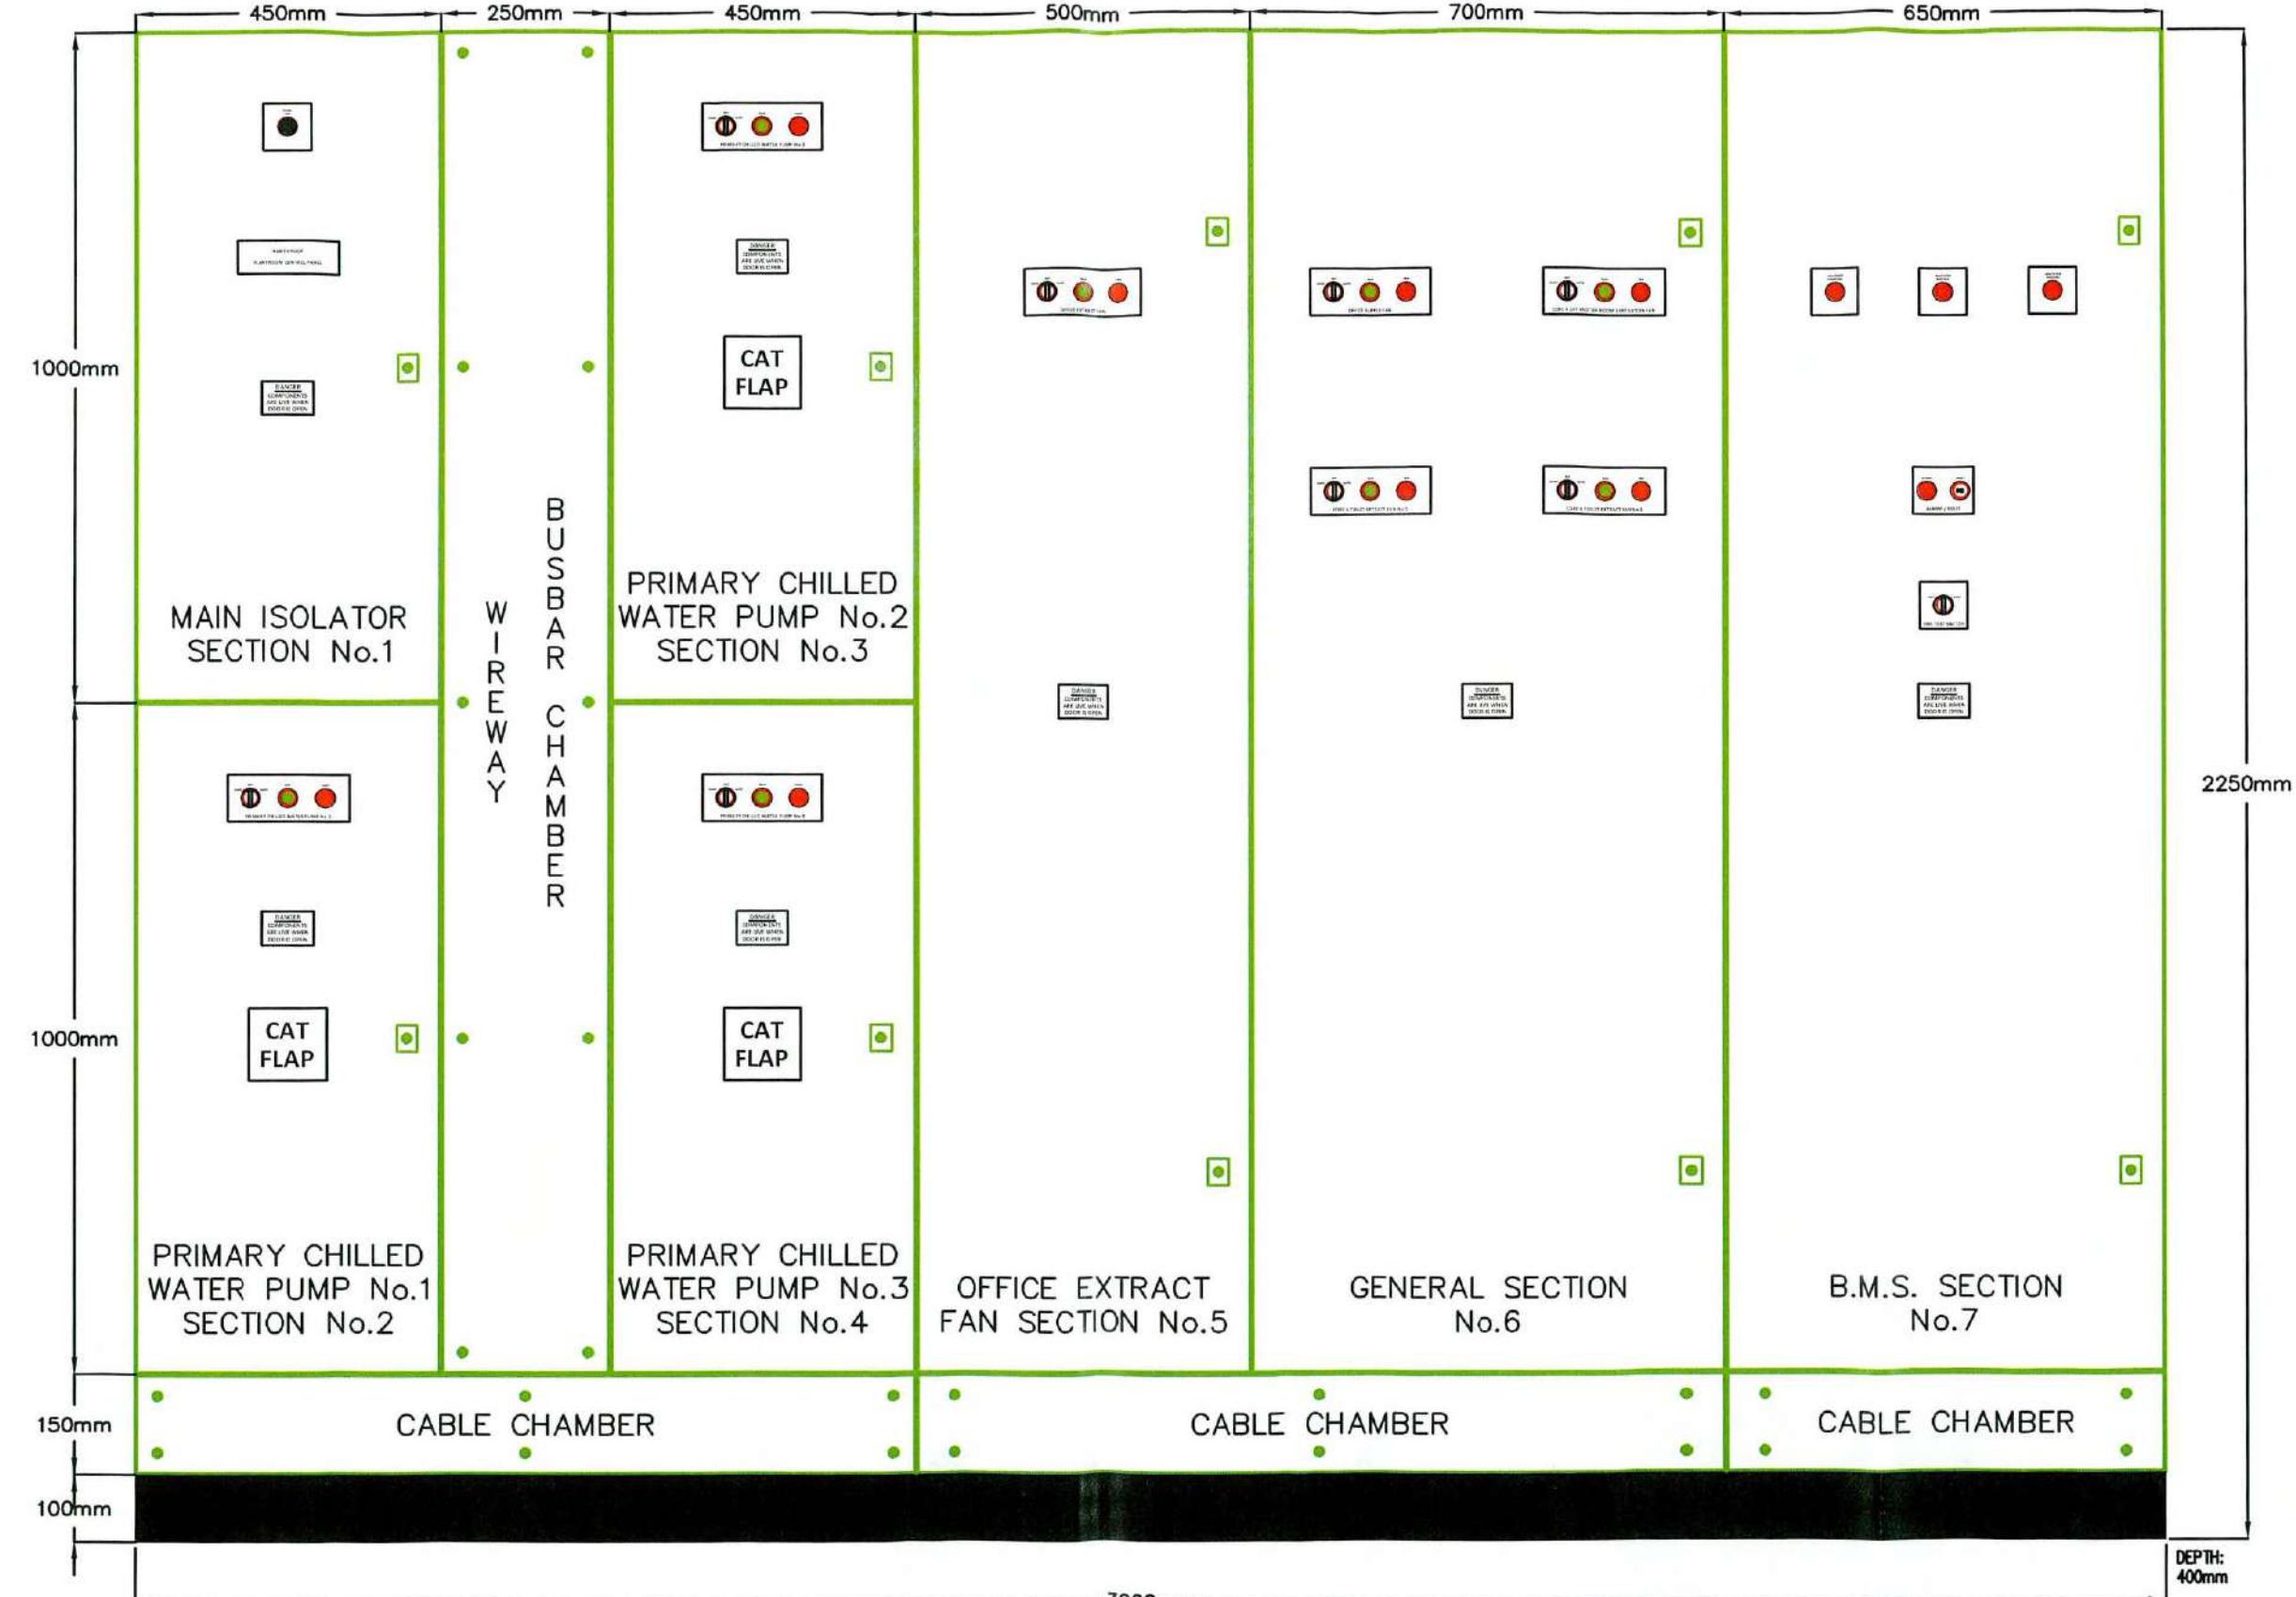


A

B


C

D

E

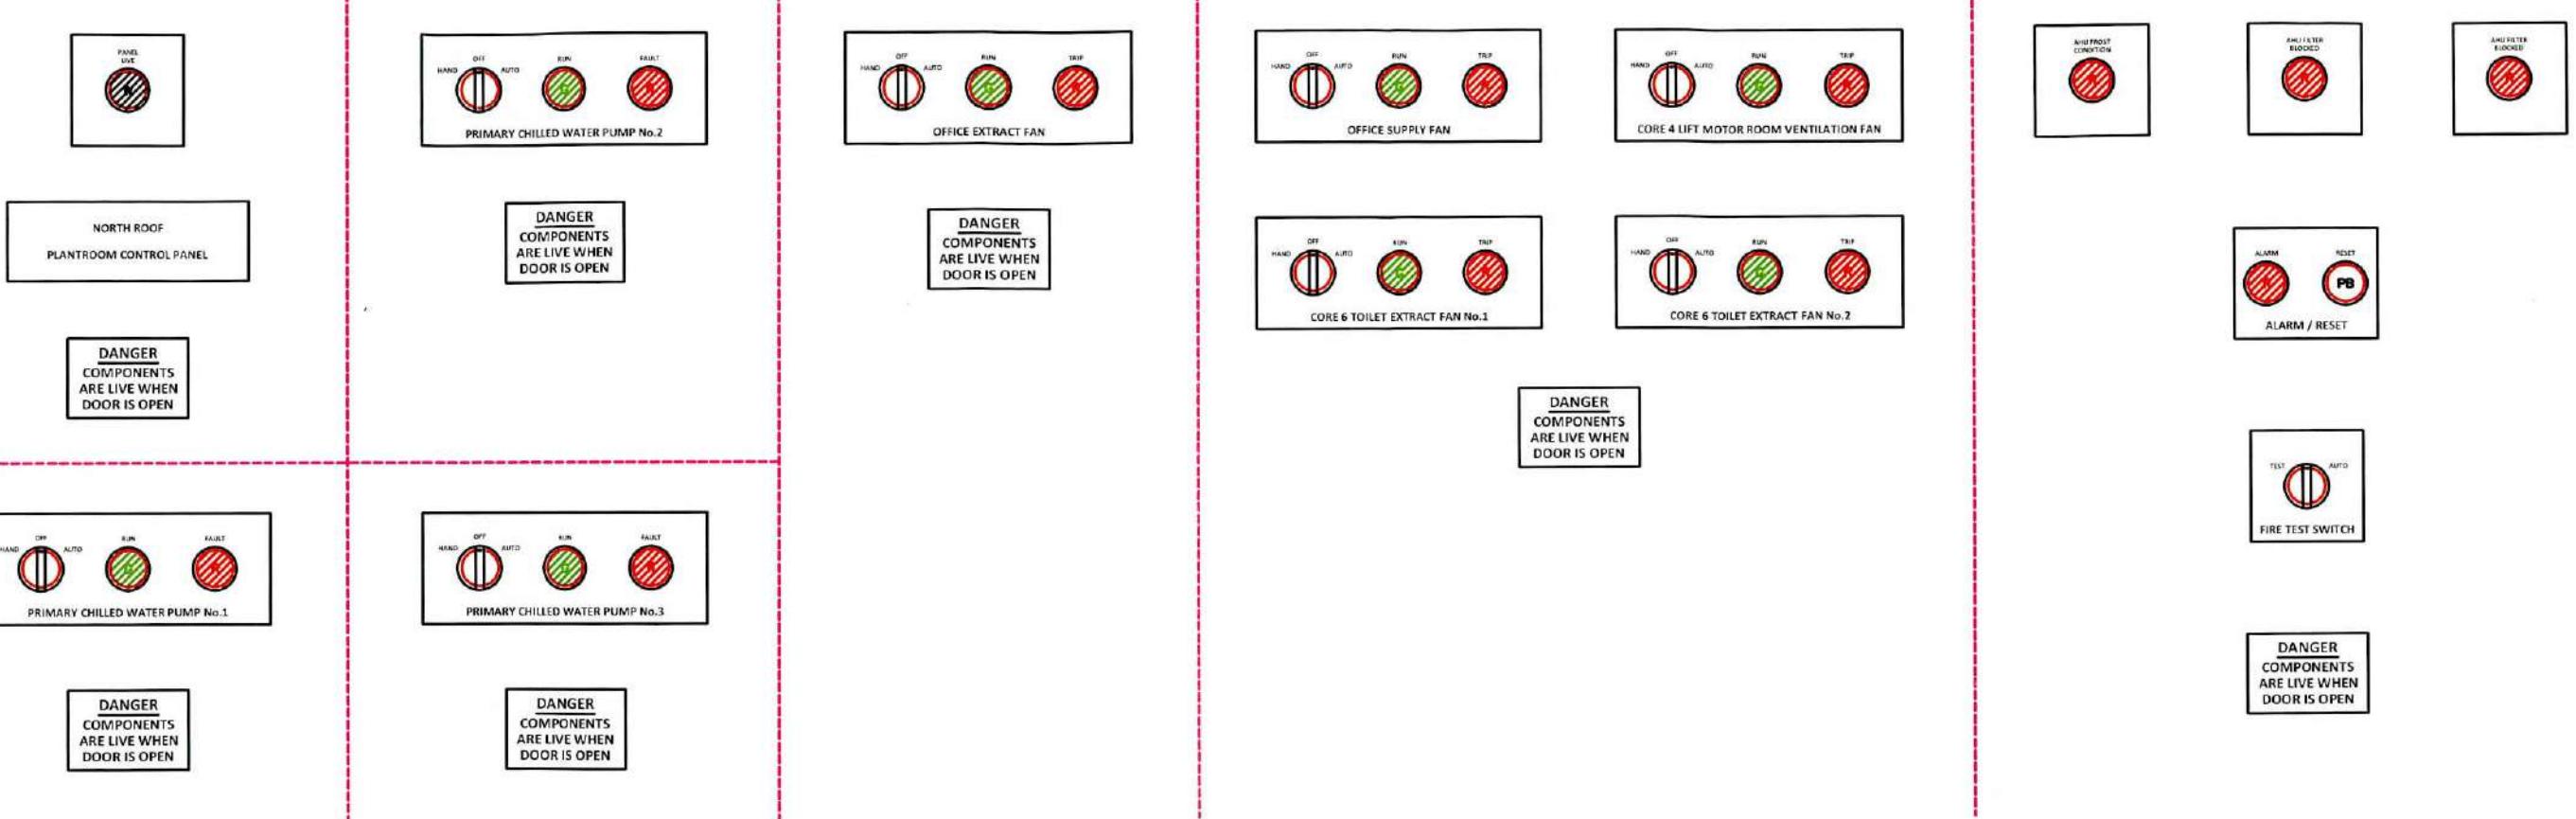



● PROVISIONAL ● FOR APPROVAL ● ISSUED FOR CONSTRUCTION		● AS BUILT ● AS FITTED		REVISION No			DESCRIPTION OF REVISION			DRAWN BY DATE	CHECKED BY DATE	REVISION No	DESCRIPTION OF REVISION			STATUS	DRAWN BY DATE	CHECKED BY DATE	DRG No.6082-17 PROJECT No.6085		
0	PROVISIONAL	RFD 14/05/21		4													TITLE EXCHEQUER COURT				
1	AS COMMISSIONED	RFD 19/05/21		5													PANEL TITLE ROOF NORTH PLANTROOM CONTROL PANEL				
2				6													CLIENT				
3				7																	

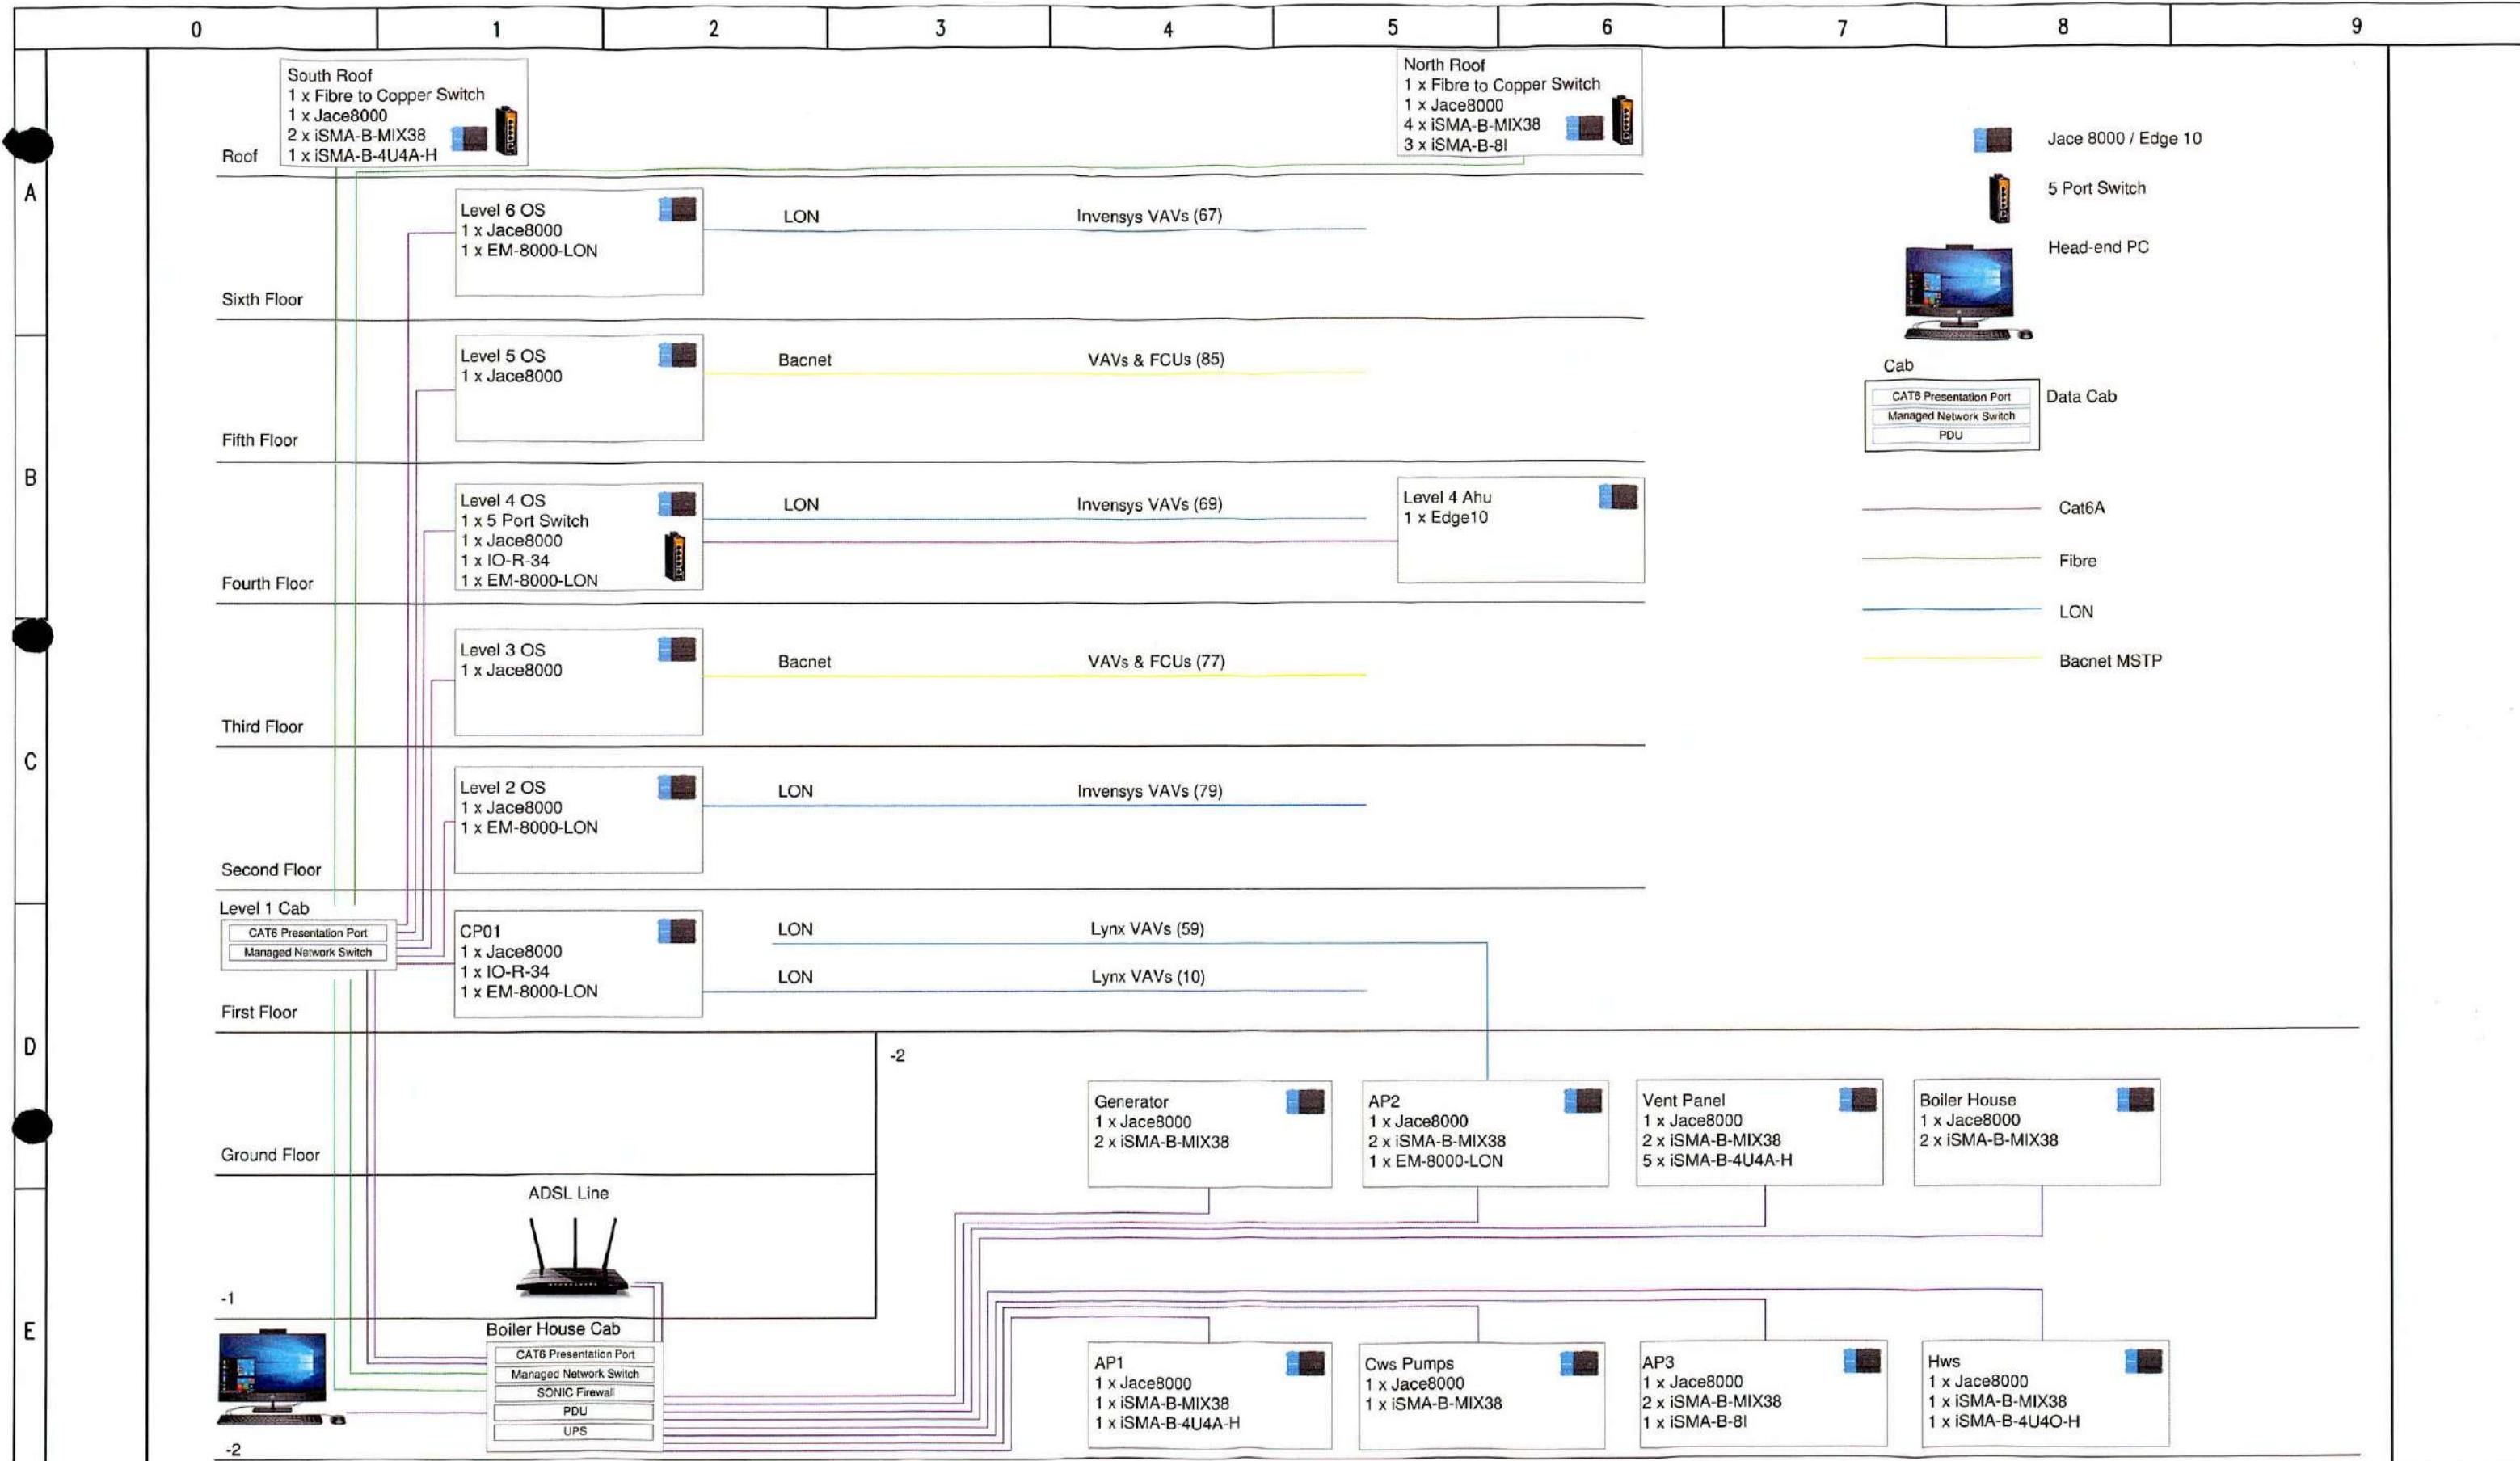





● PROVISIONAL ● FOR APPROVAL ● ISSUED FOR CONSTRUCTION	● AS BUILT ● AS FITTED	REVISION No	DESCRIPTION OF REVISION	DRAWN BY DATE	CHECKED BY DATE	REVISION No	DESCRIPTION OF REVISION	STATUS	DRAWN BY DATE	CHECKED BY DATE	DRG No.6082-17 PROJECT No.6085	SHT. 26 of 26	REV 1 ©
		0	PROVISIONAL	RFD 14/05/21		4					TITLE	EXCHEQUER COURT	
		1	AS COMMISSIONED	RFD 19/05/21		5					PANEL TITLE	ROOF NORTH PLANTROOM CONTROL PANEL	
		2				6					CLIENT		
		3				7							


bges group

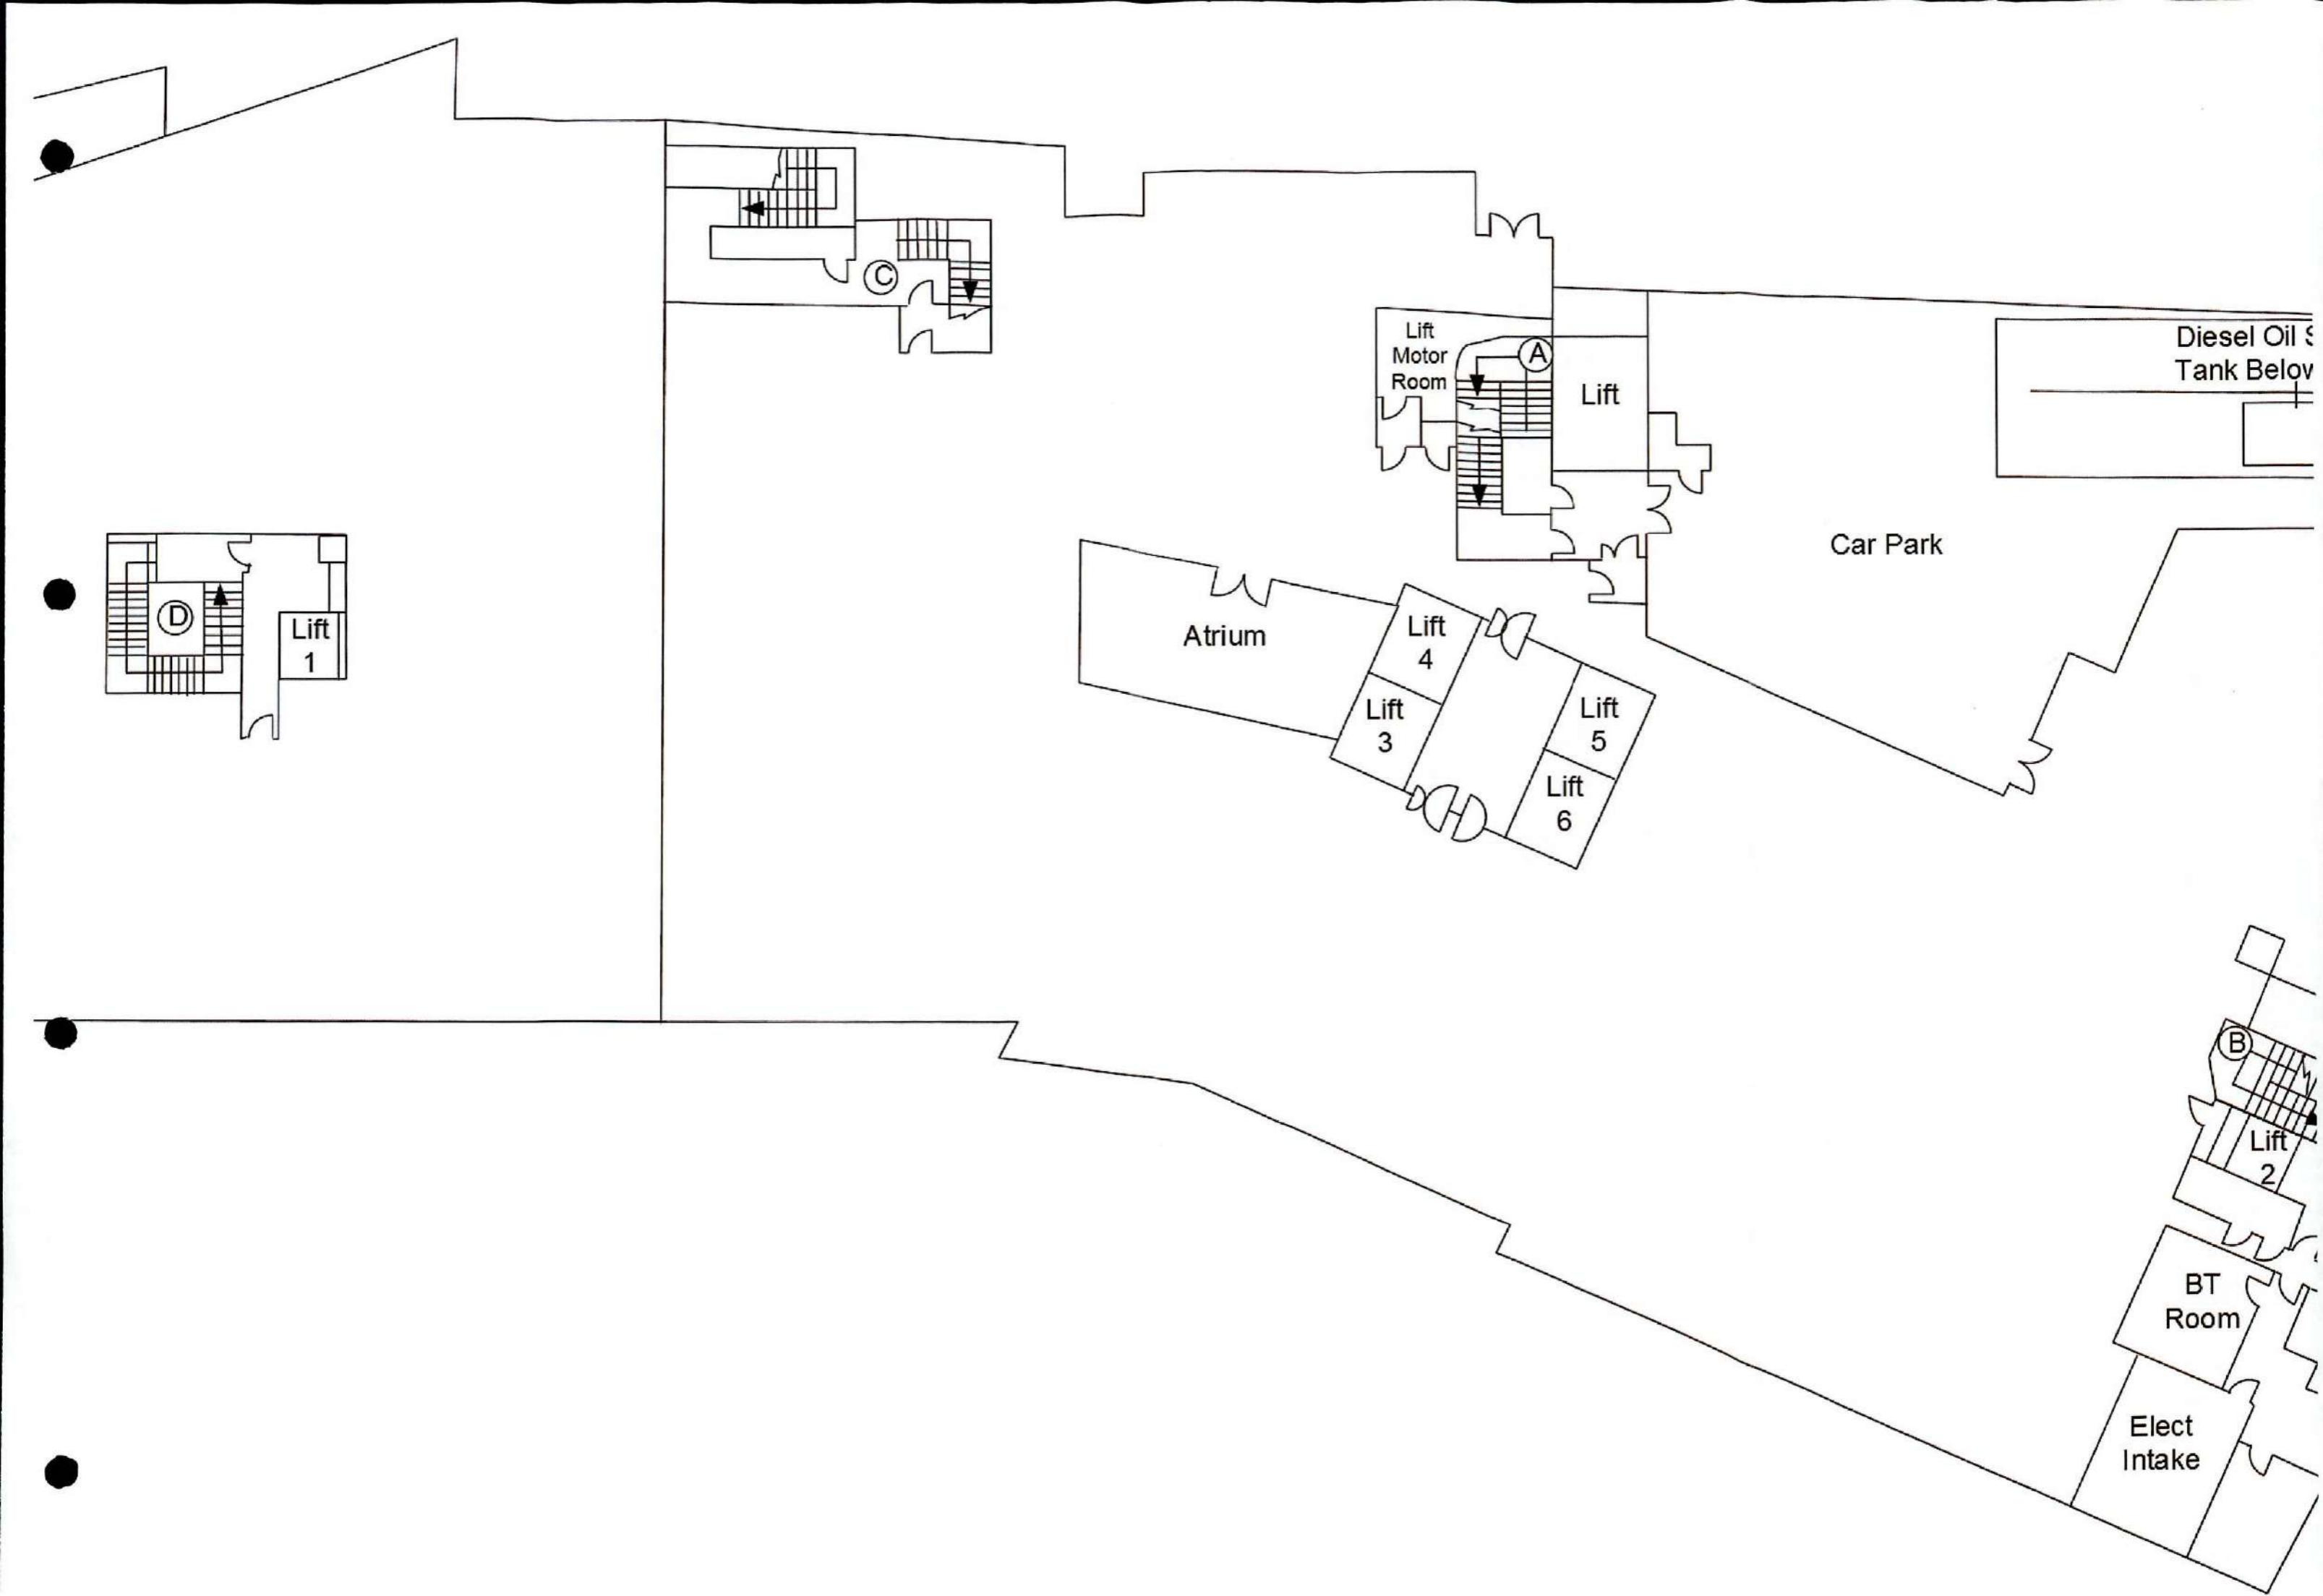


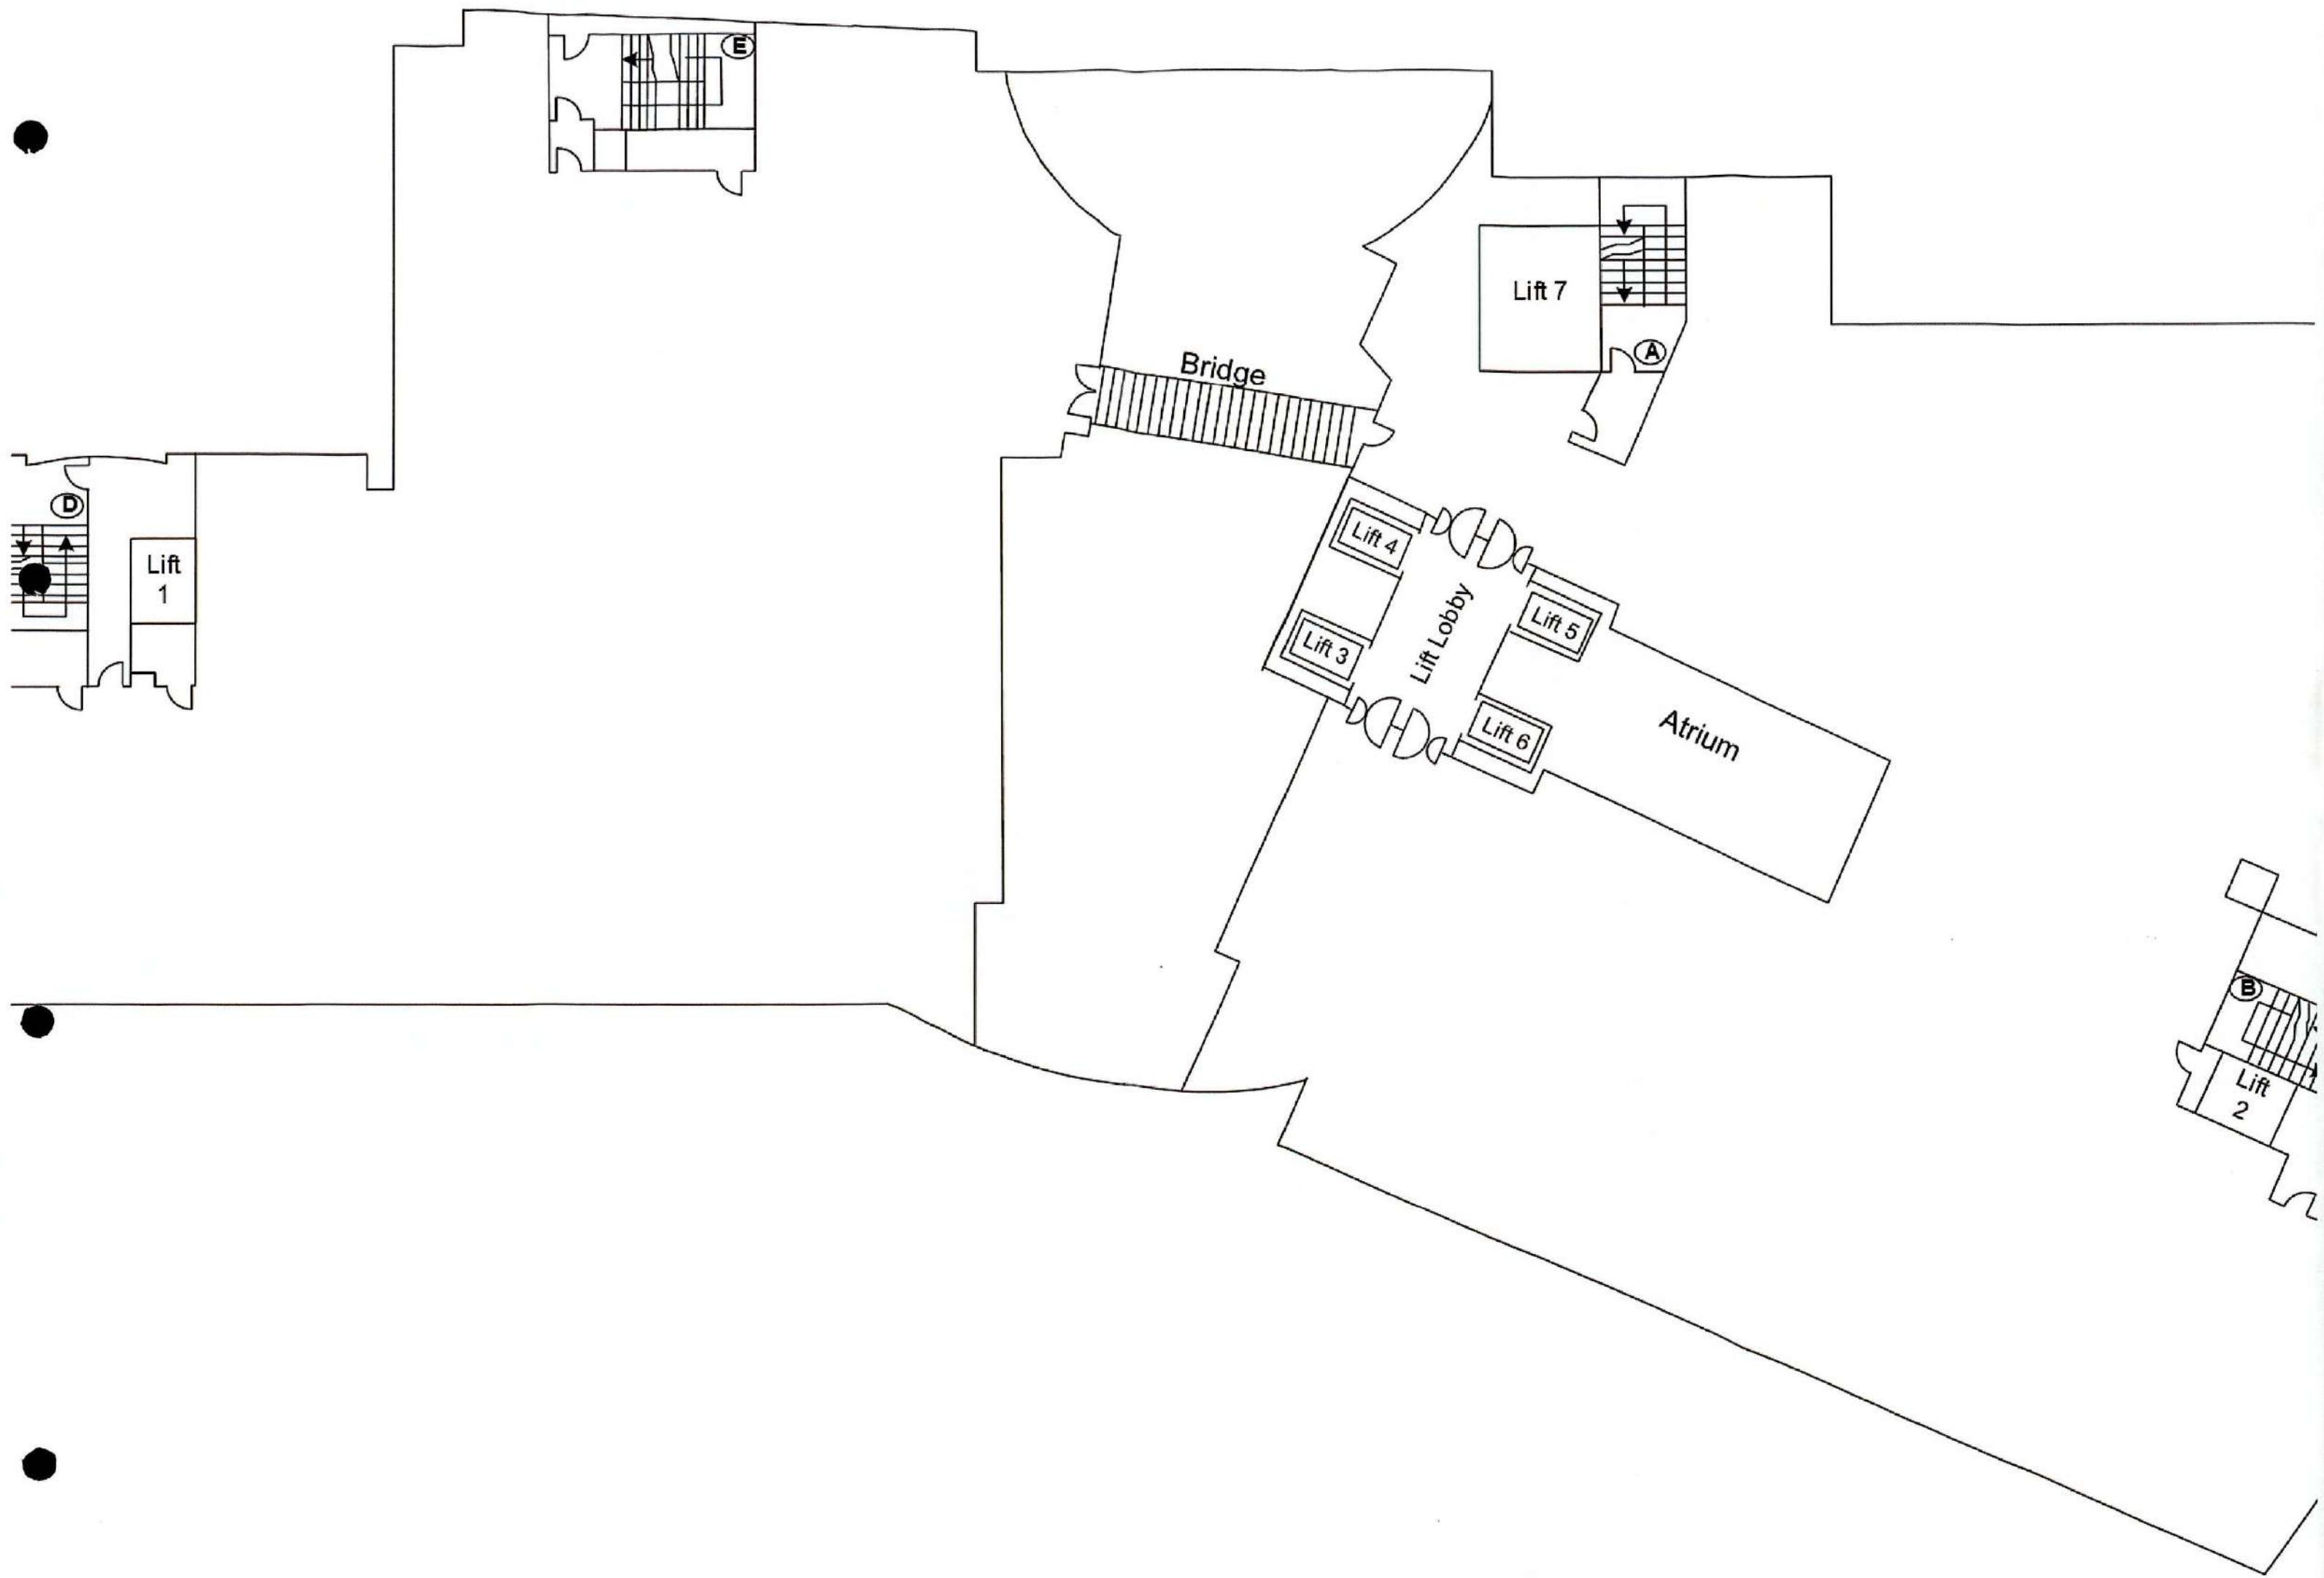





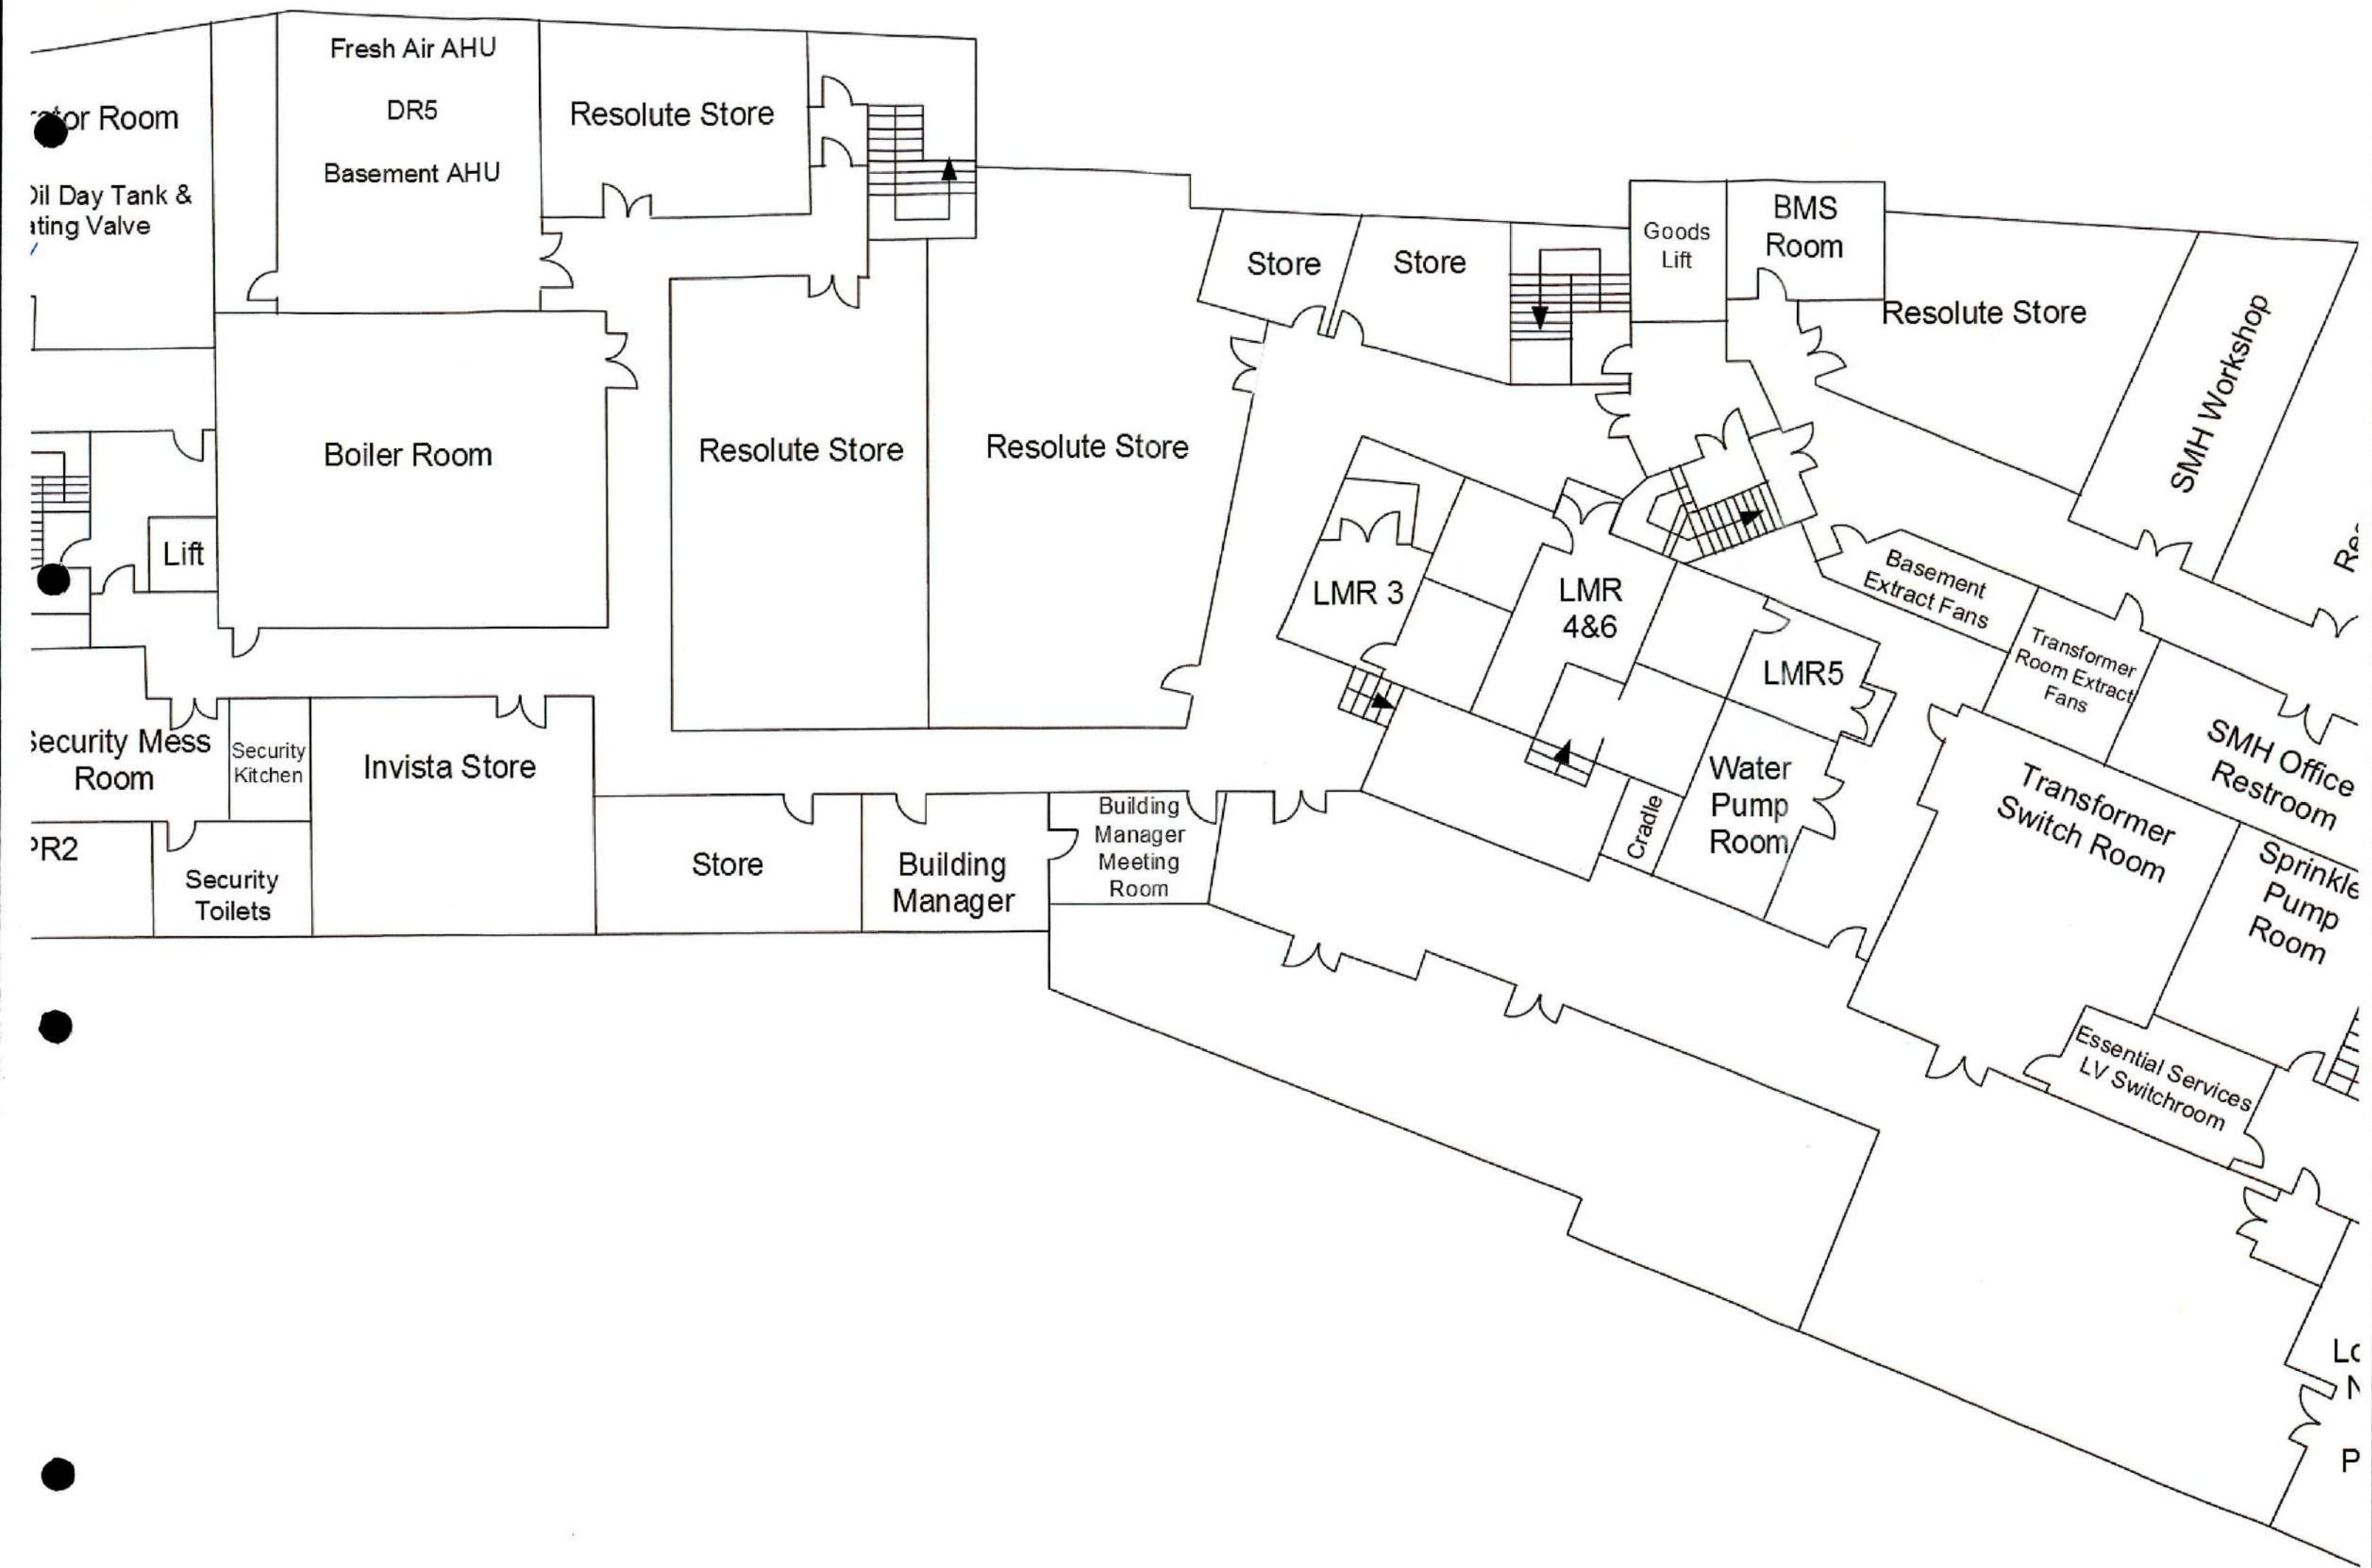


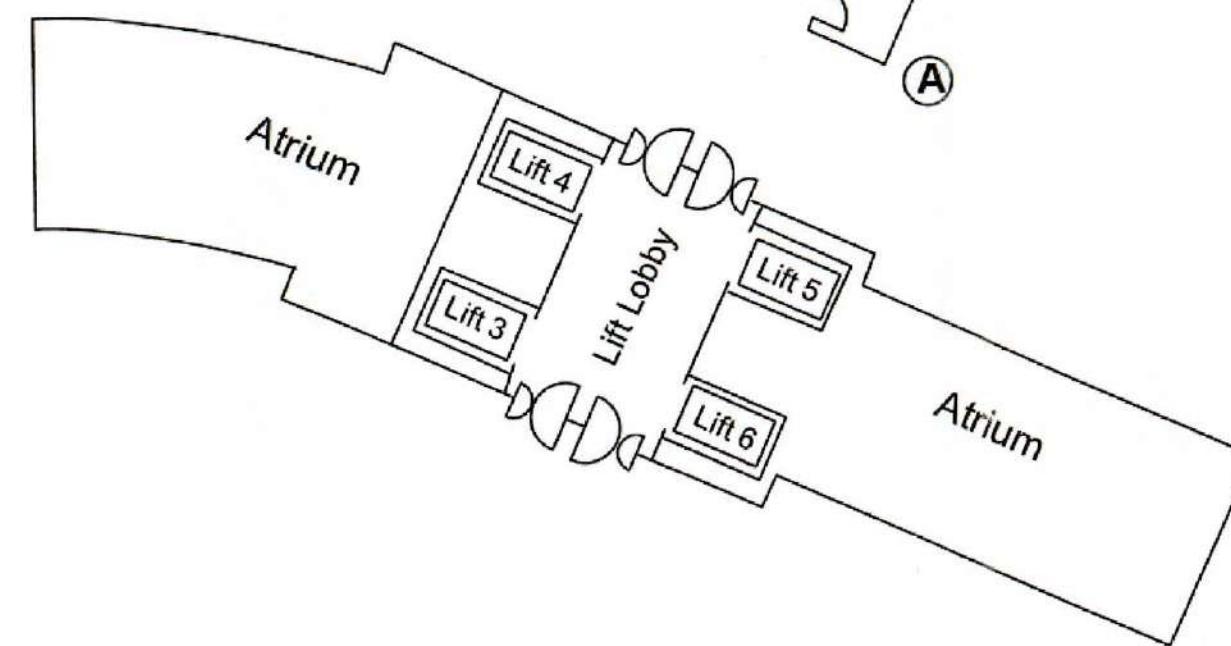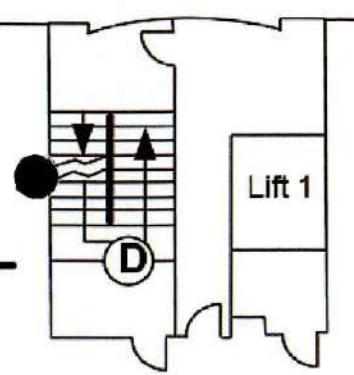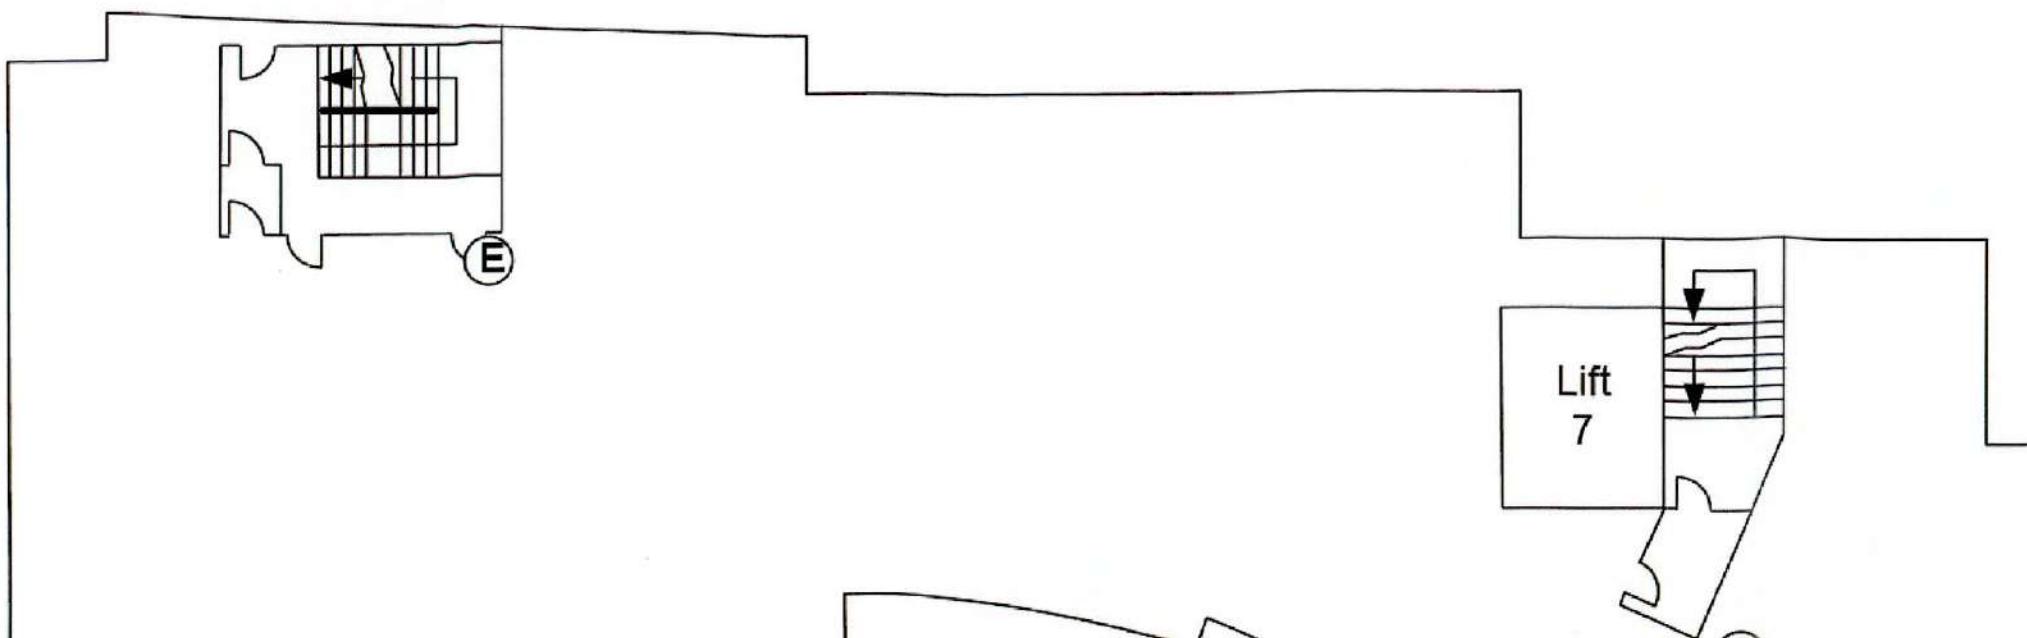


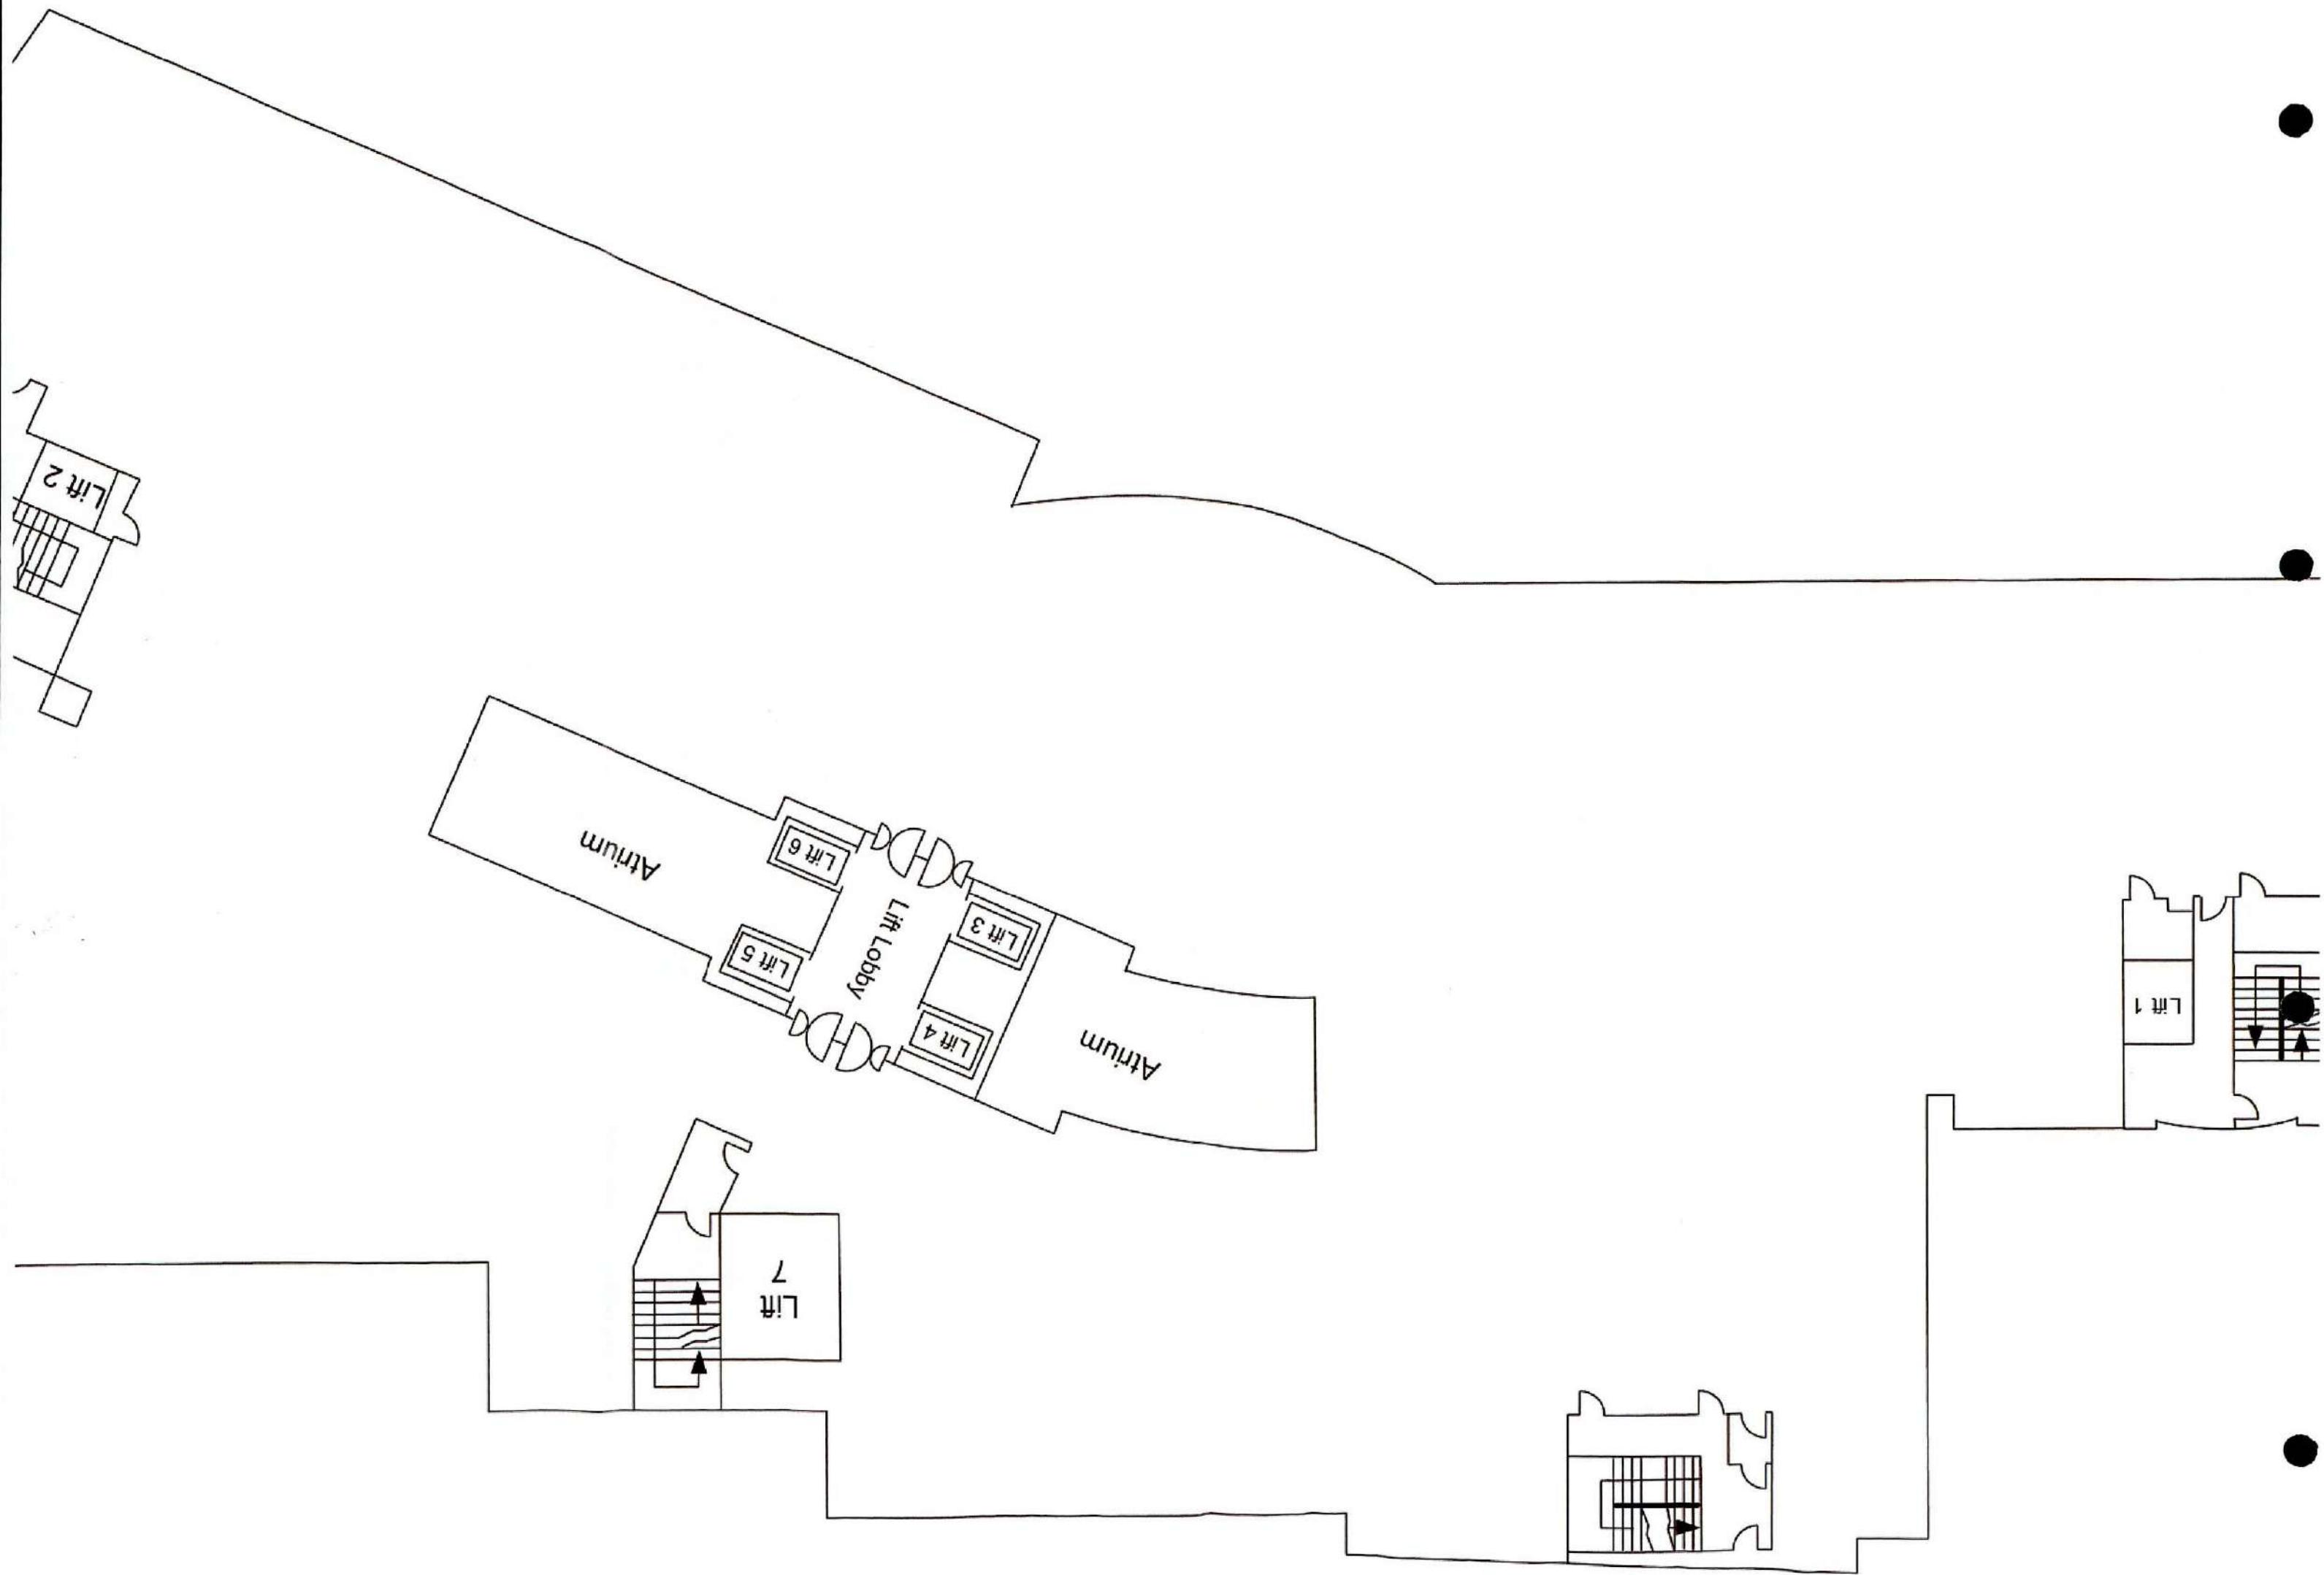


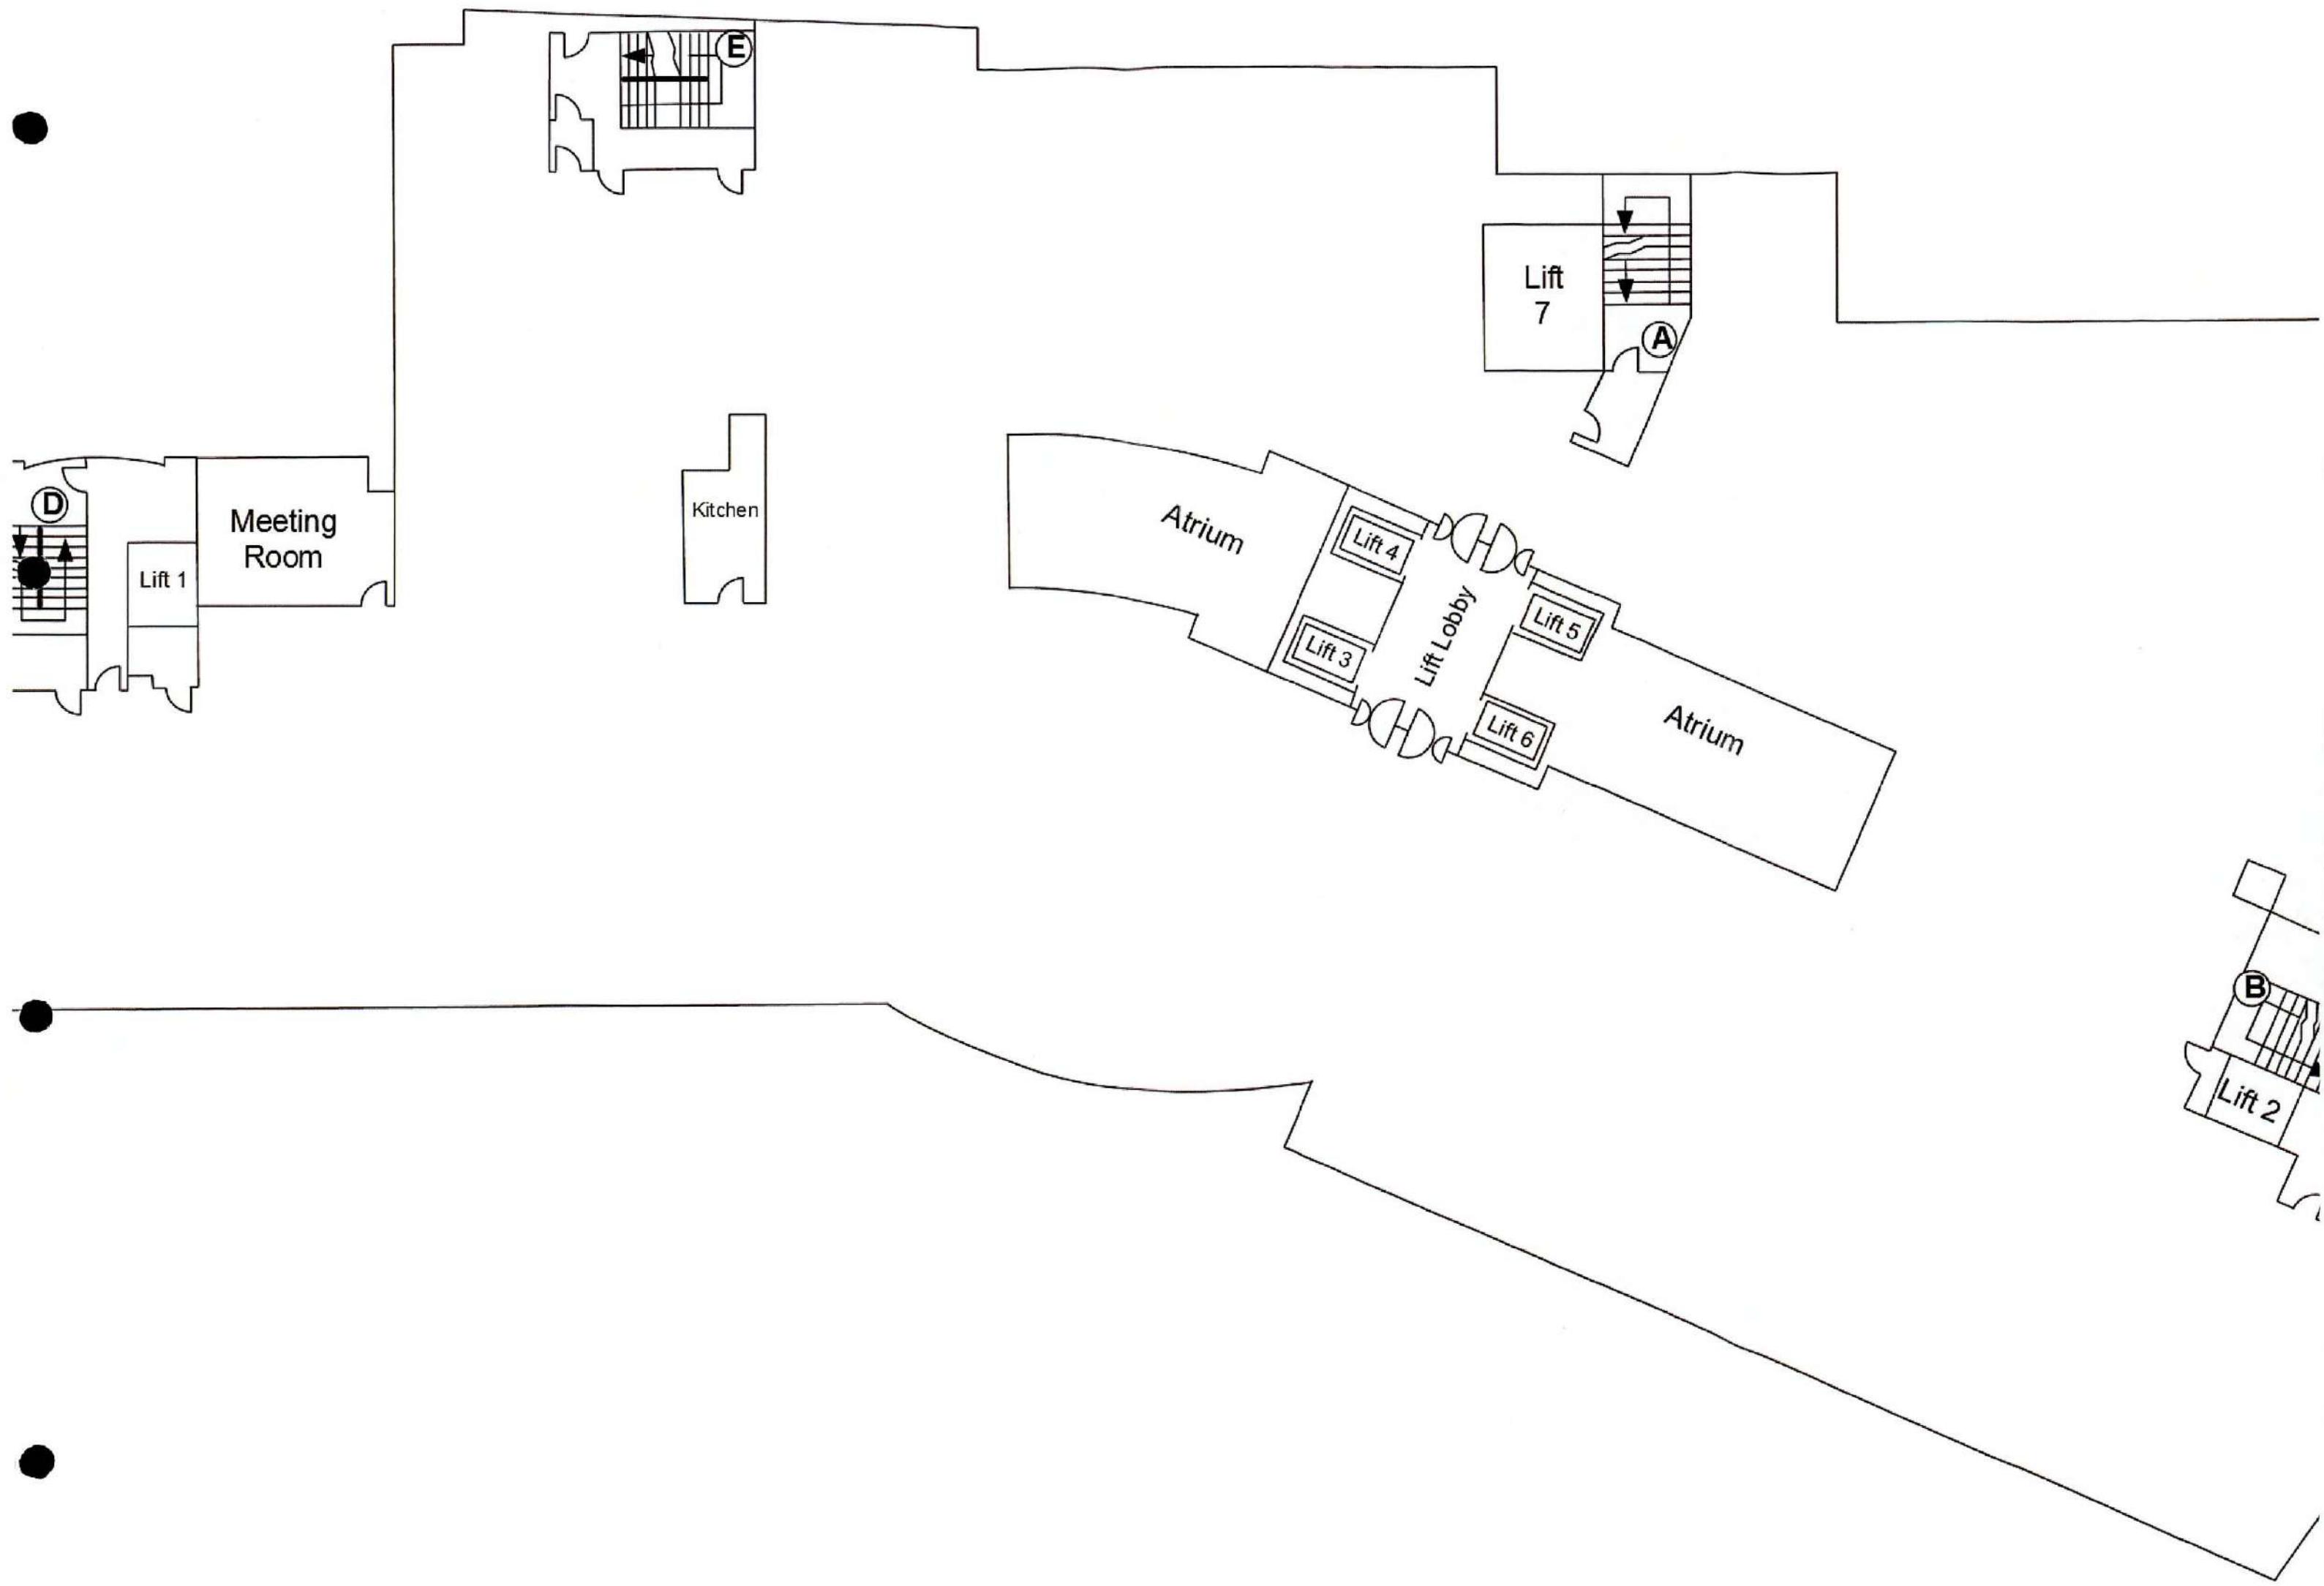

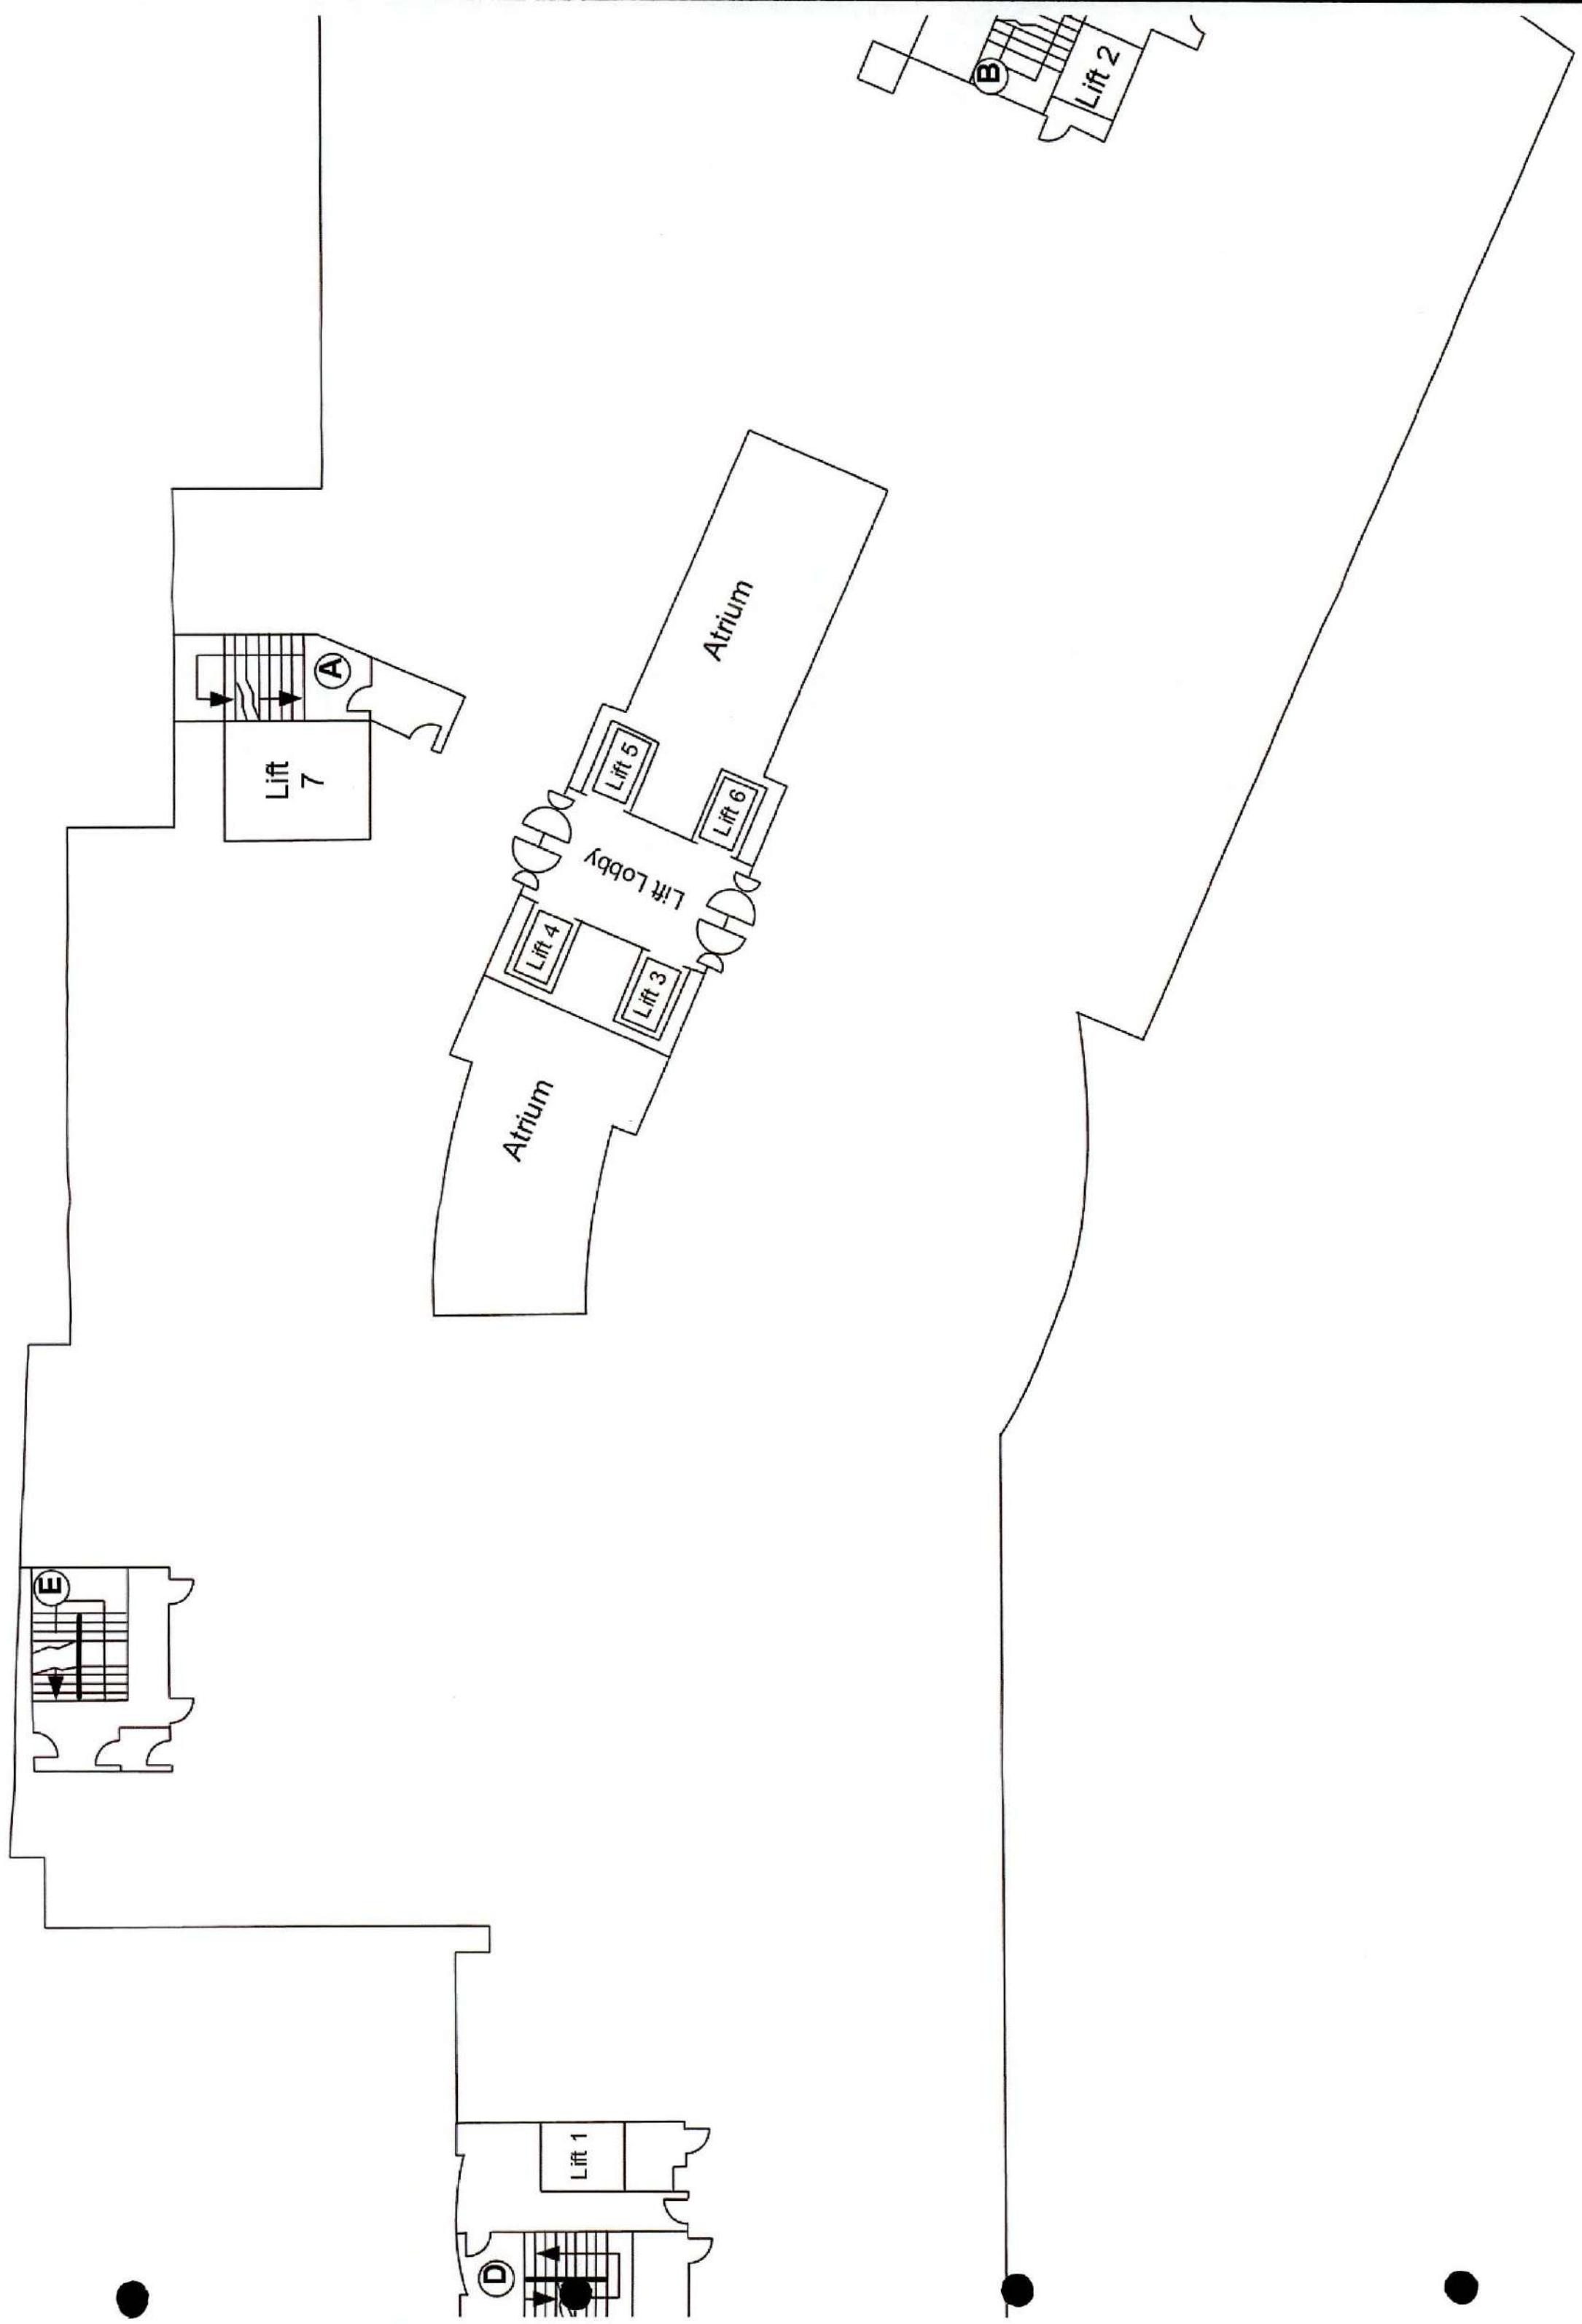

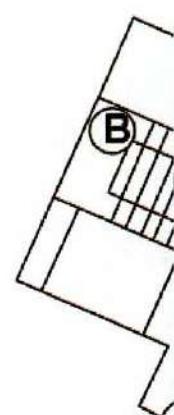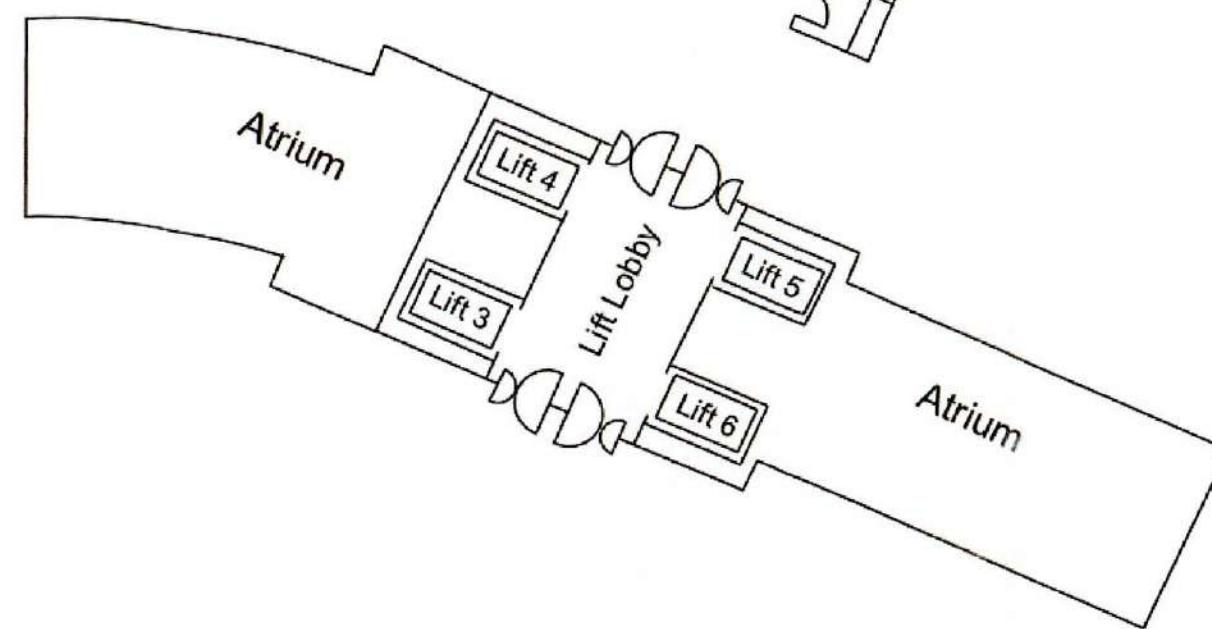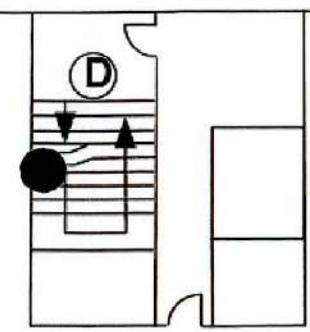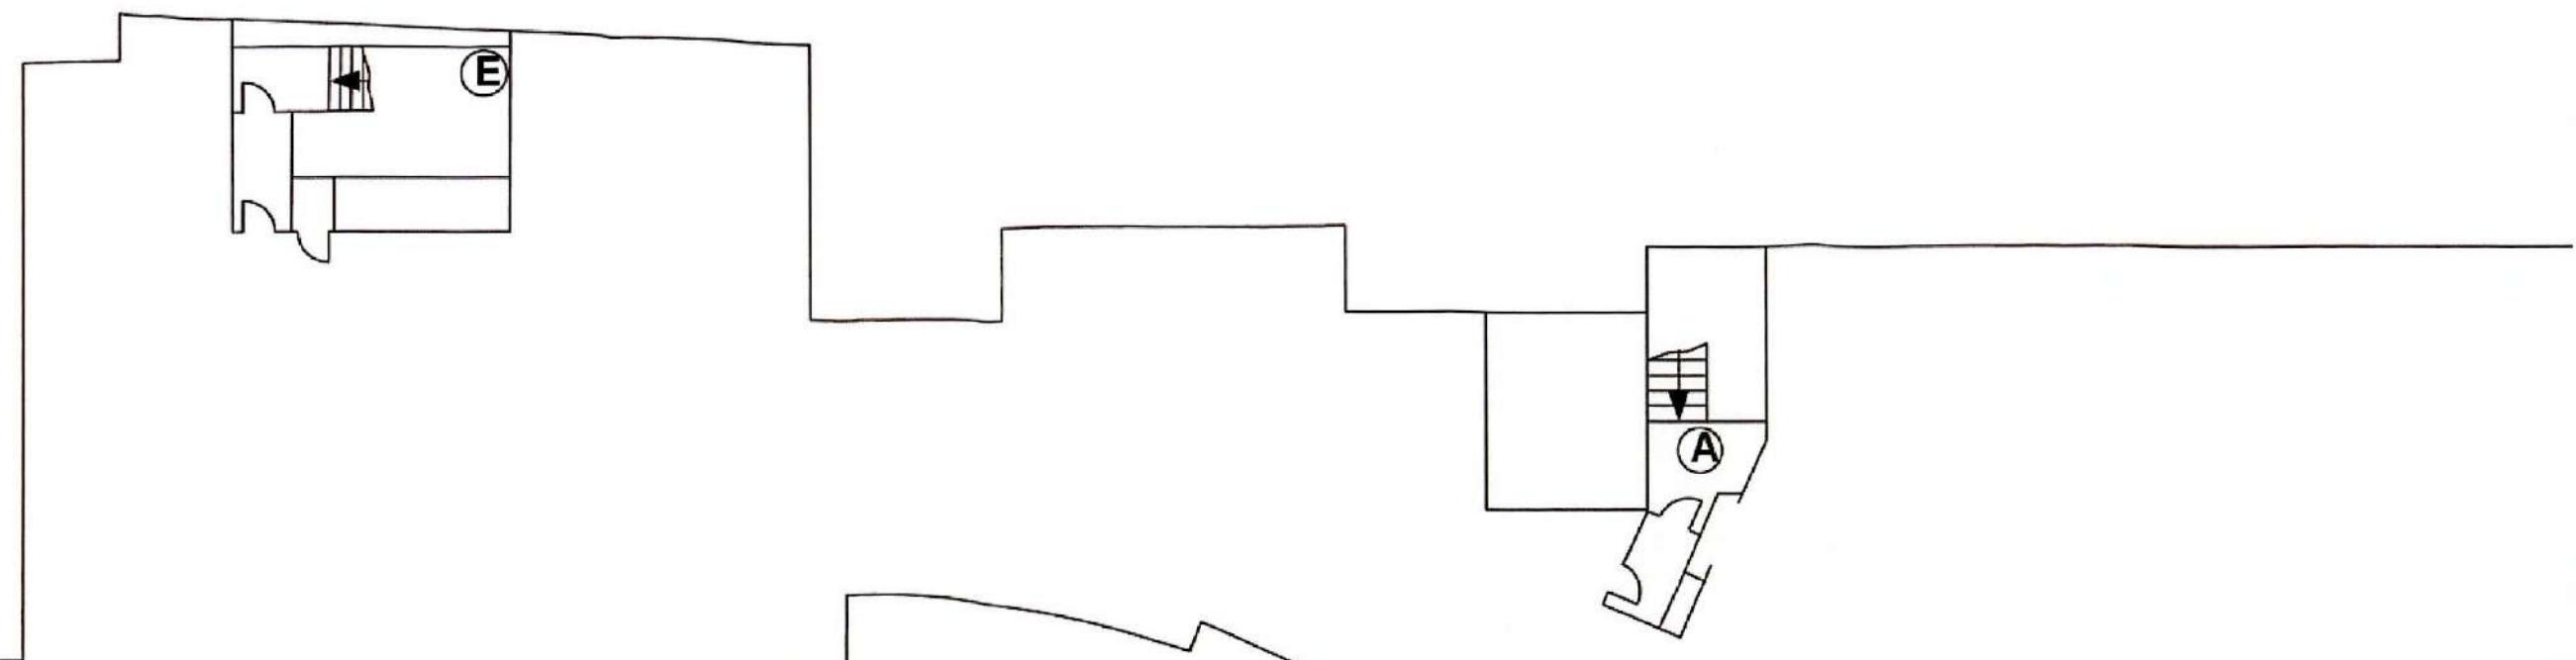

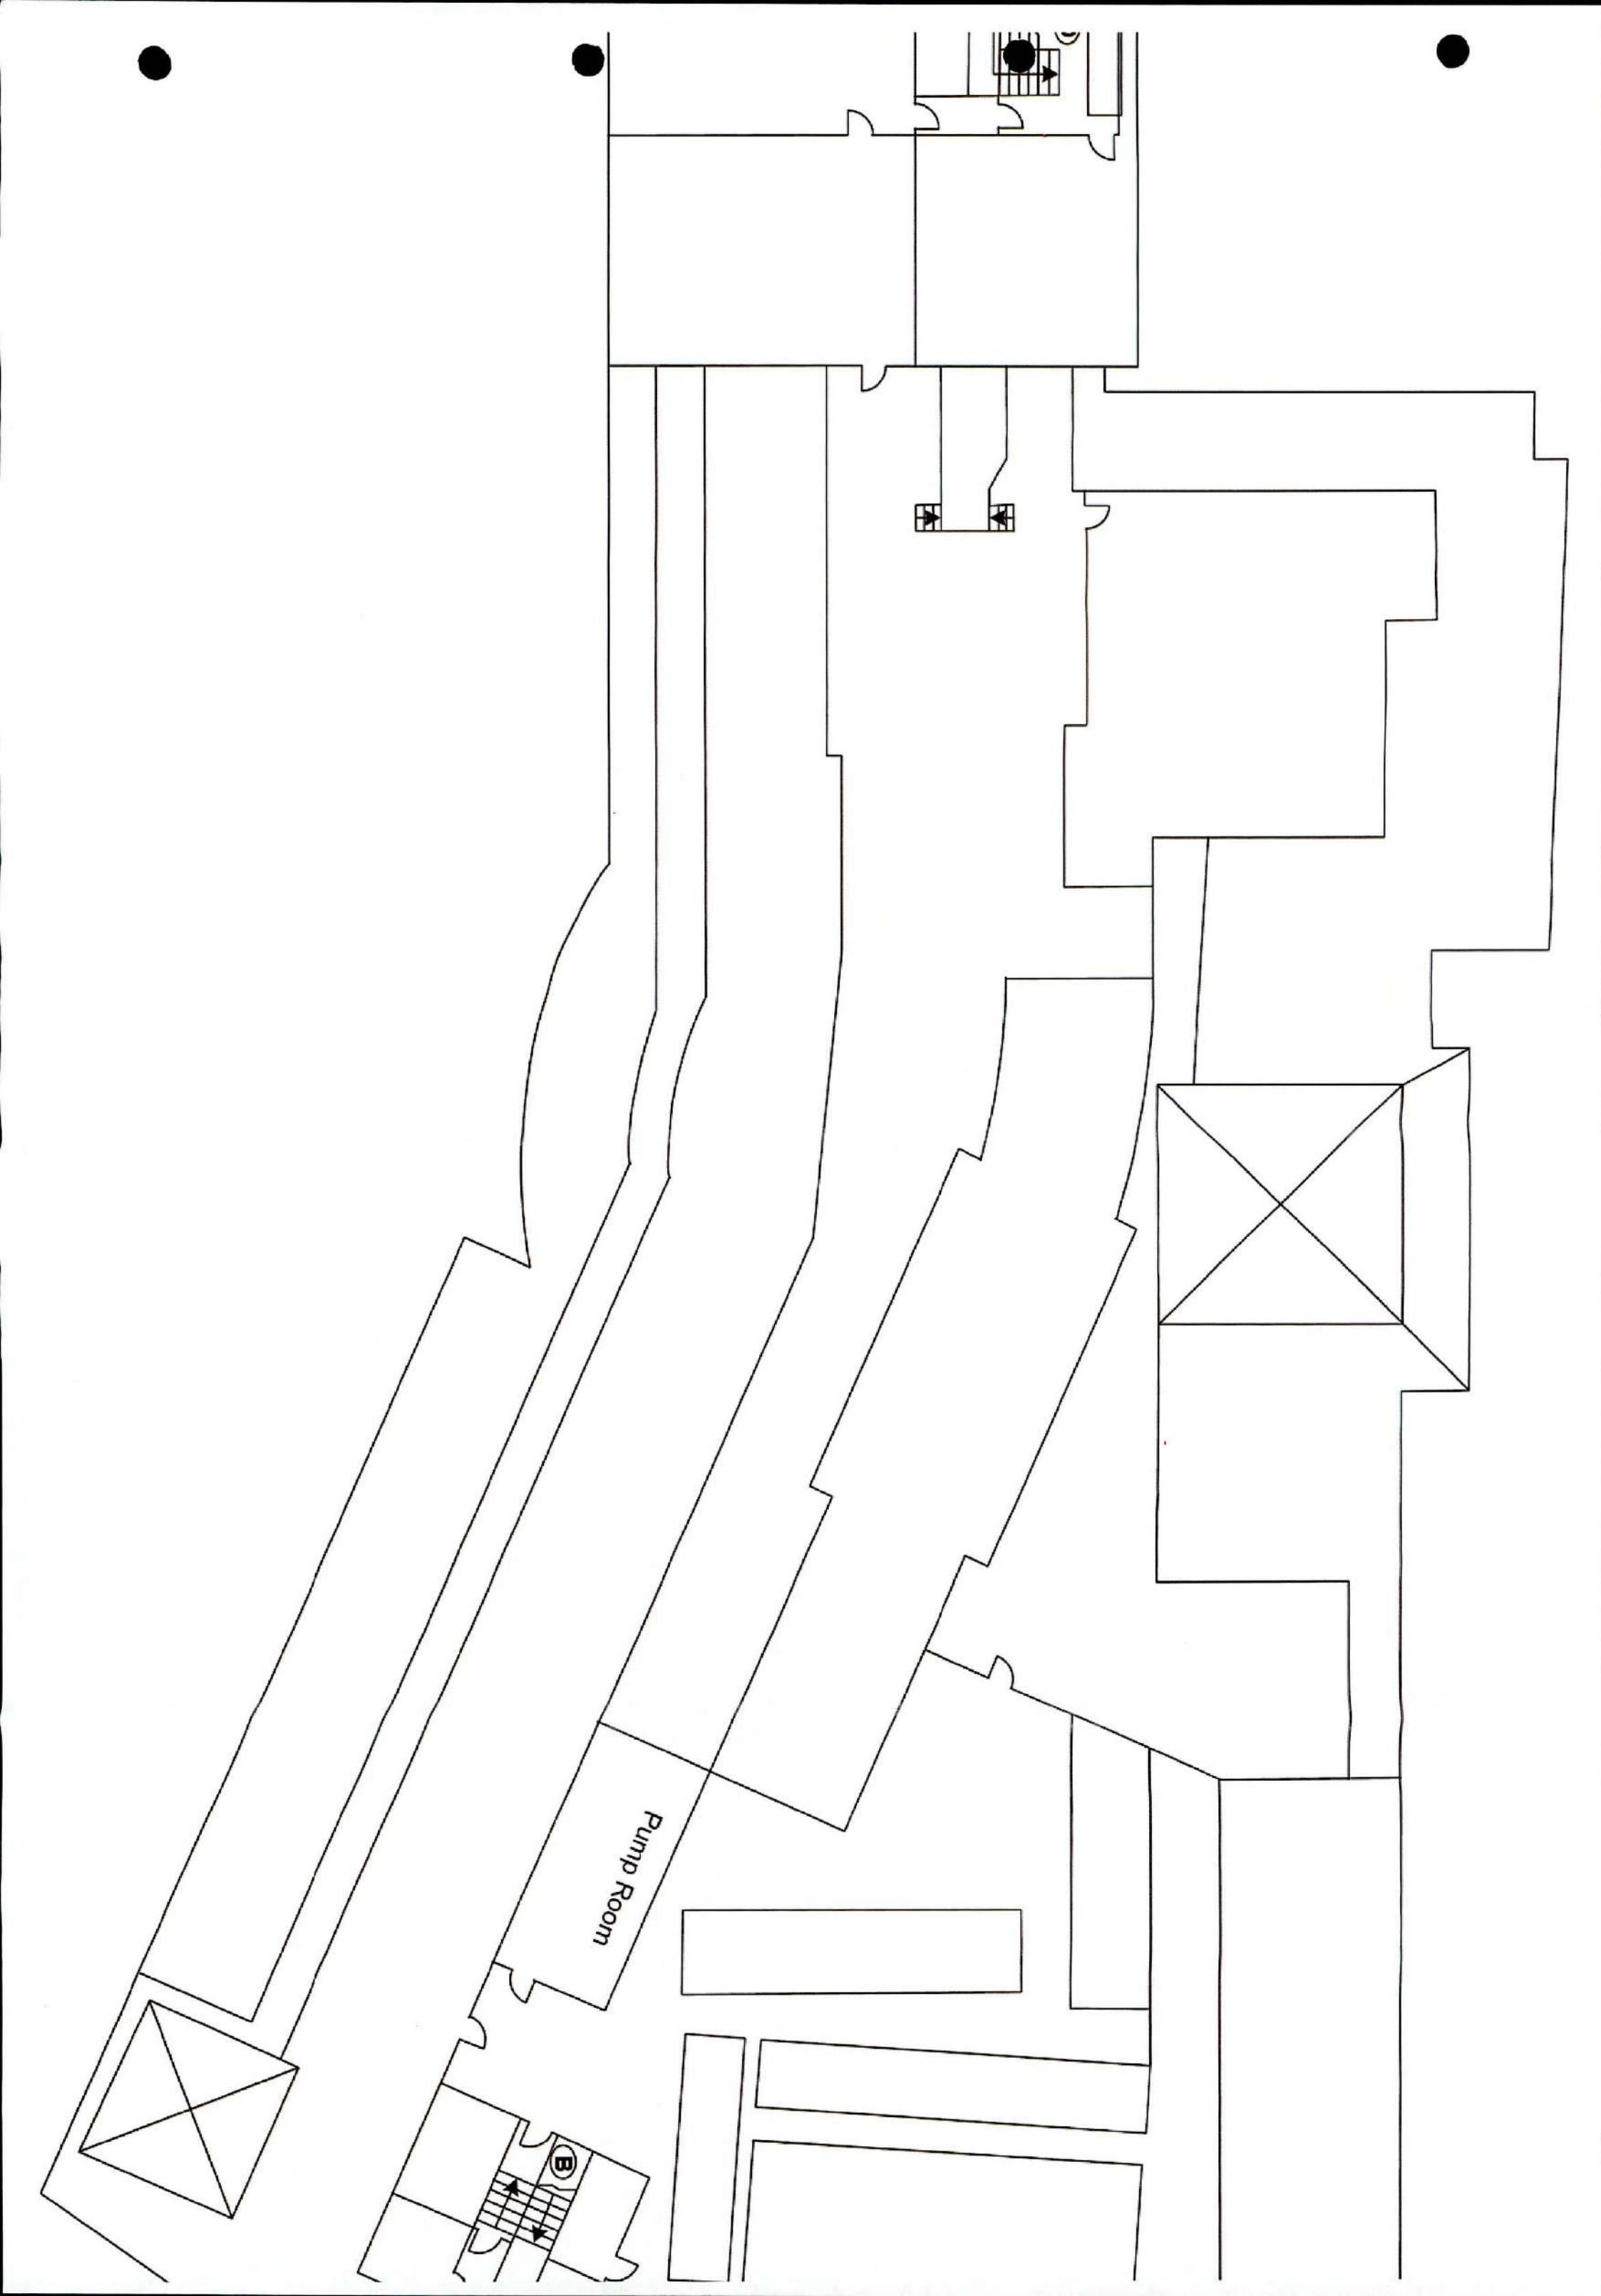

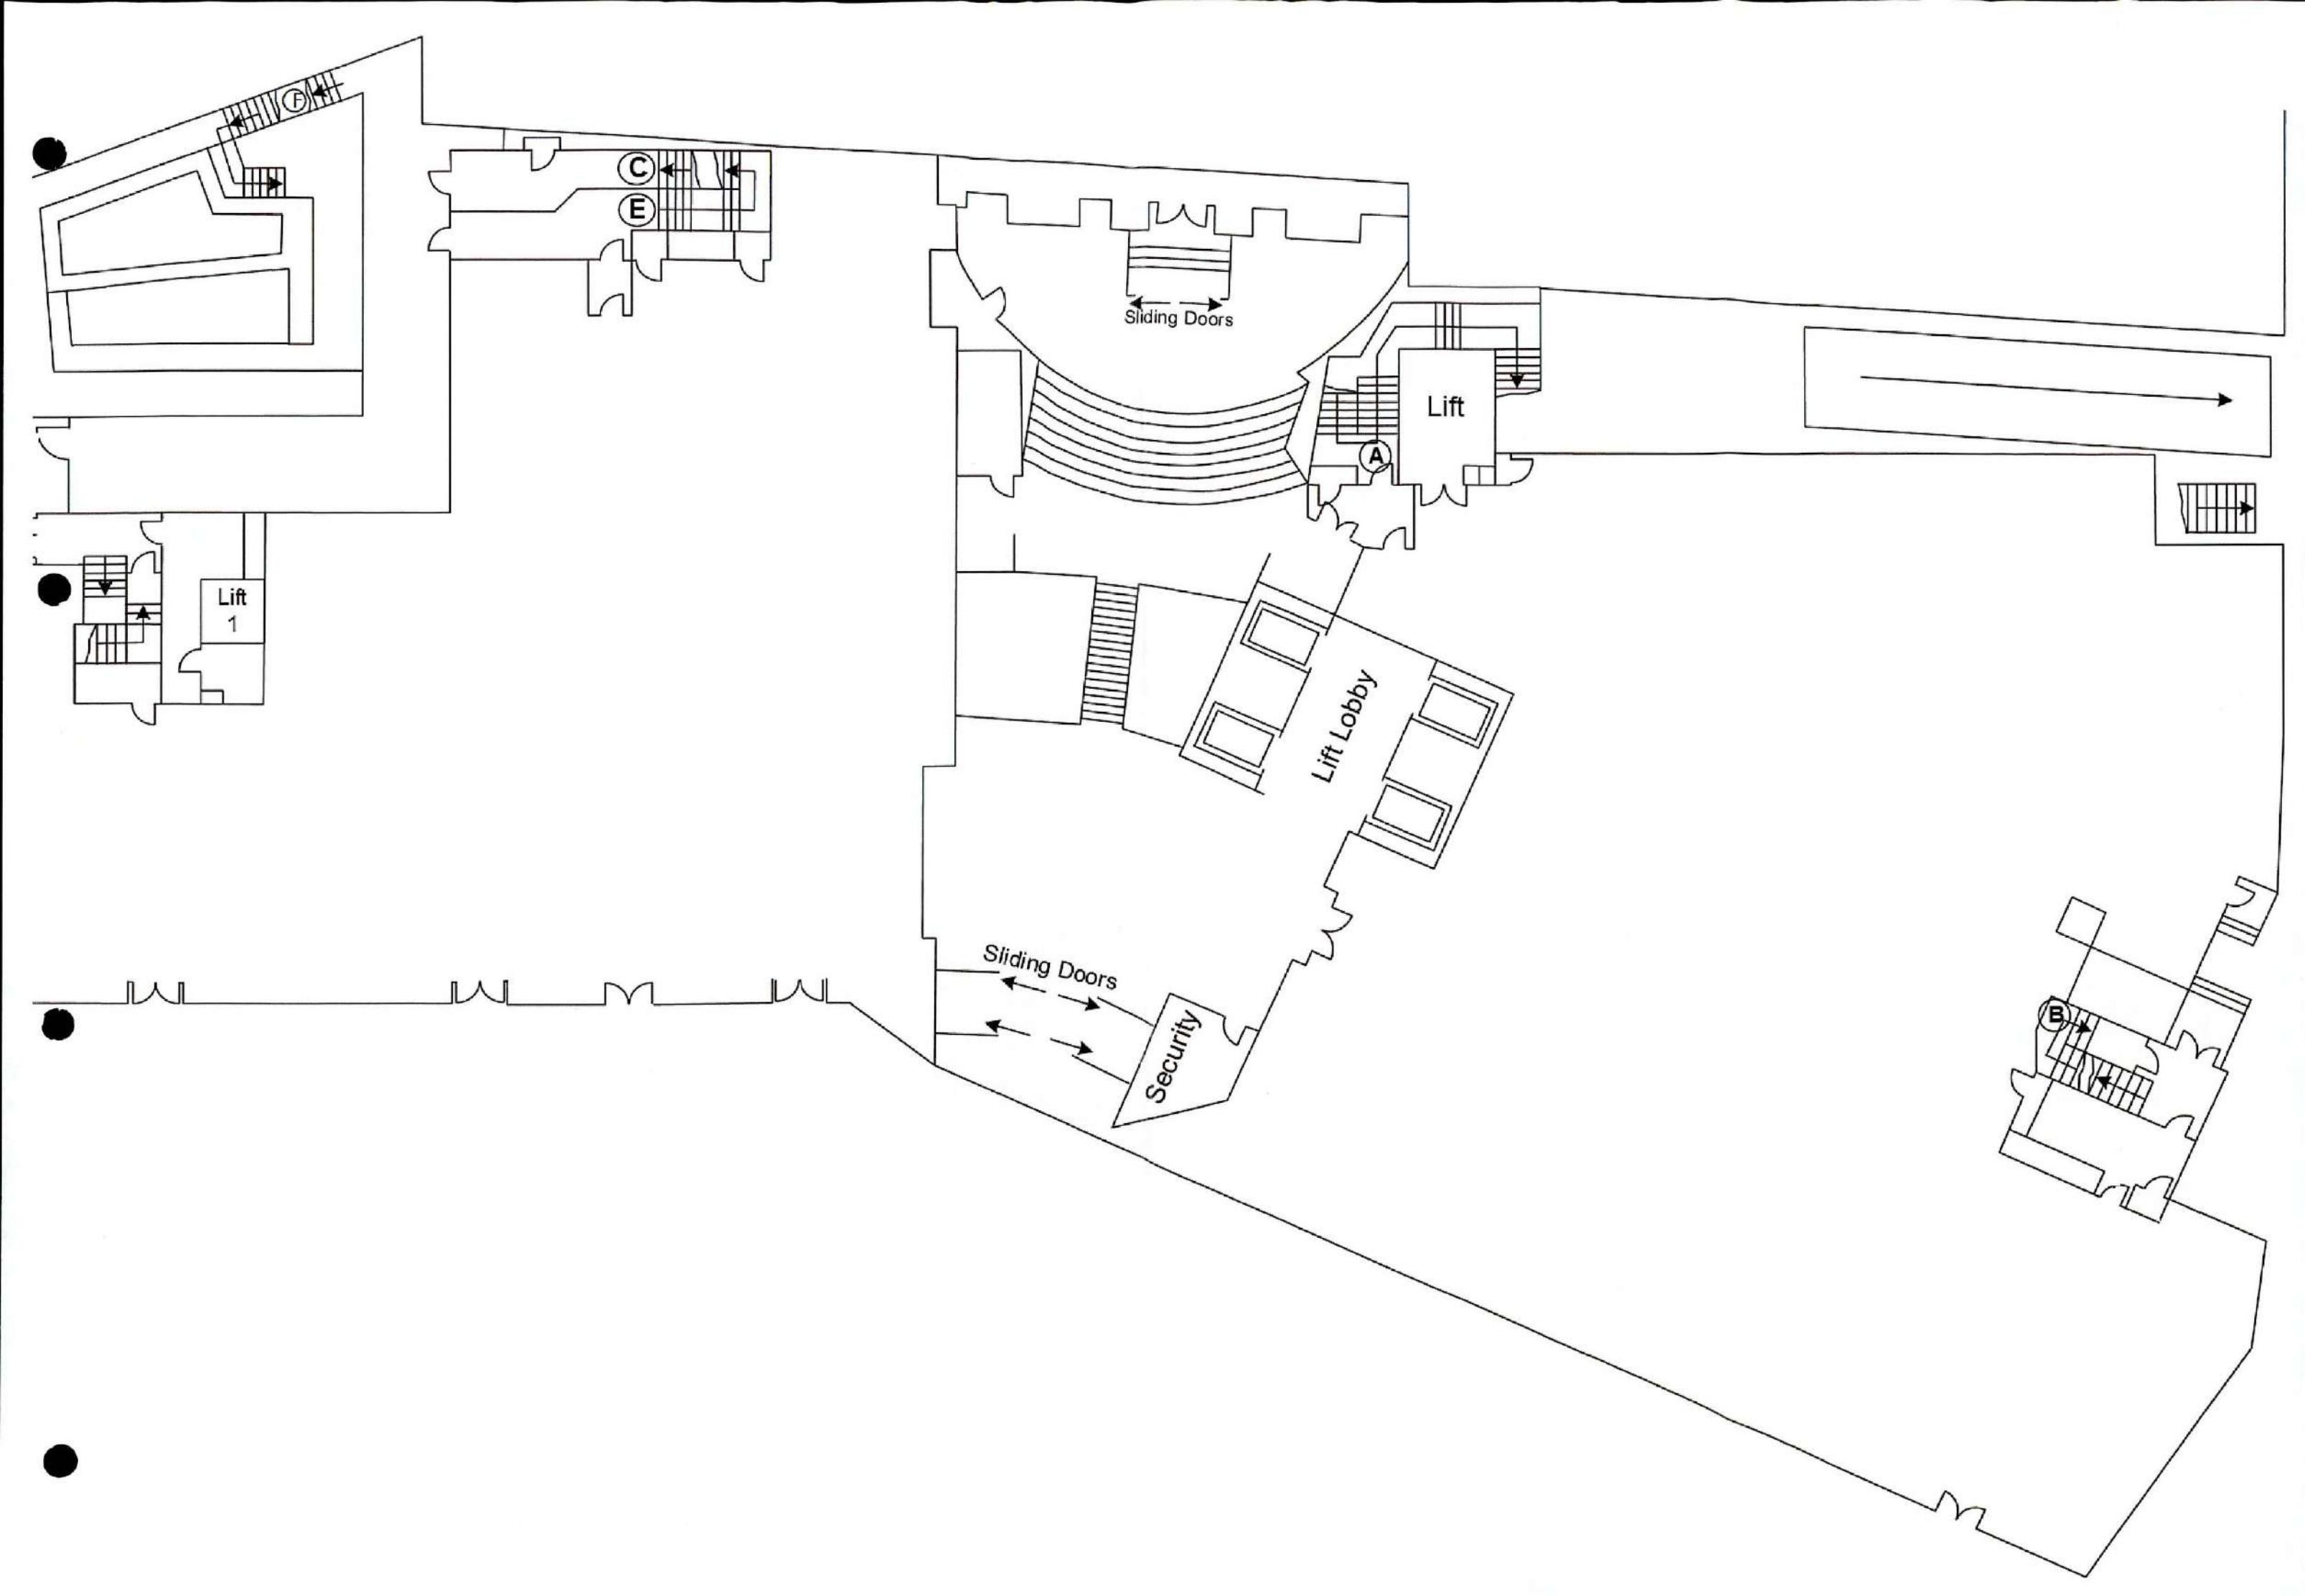

9



9.0 ELECTRICAL INFORMATION

Not Applicable



10.0 OTHER INFORMATION

The following Other O+M Manuals are included:

None Provided